## LAT. 18 - DIS. A. - S.S. #12

B.M. 84.53 On Property Iron 1.6 E. cor. Central & Pershing

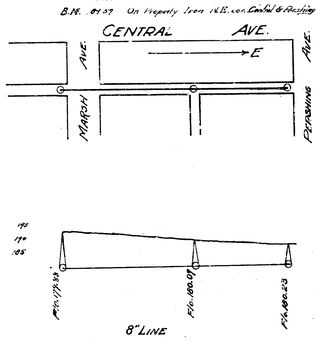


## LAT. 2. - SAN. SEWER No. 20

B.M. 100.21 Std. S.W. cor. Hydraulic & Harry

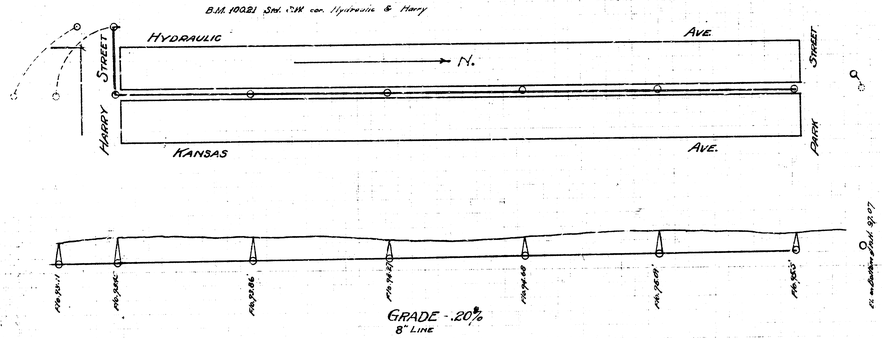


## LAT. 4 - DIS. A. - S.S. #21.

B.M. 111.86 "E" in Blue knob of mich N.E. cor. of Sedgwick & Maple

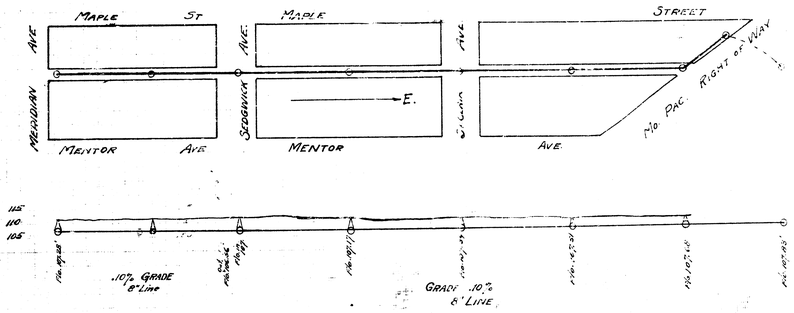


## LAT. "B." SAN. SEWER #8

B.M. 107.12 Std. N.W. cor. of Seneca & McCormick

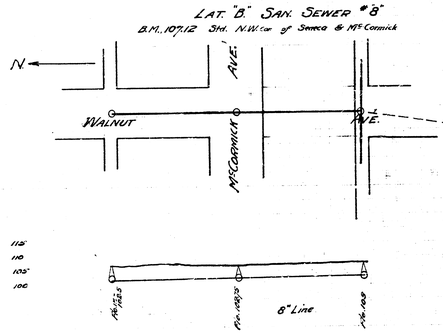


## LAT. "B" SAN. SEWER No. 8"

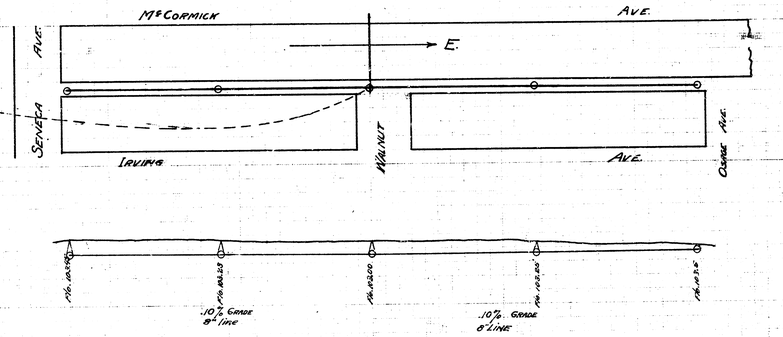

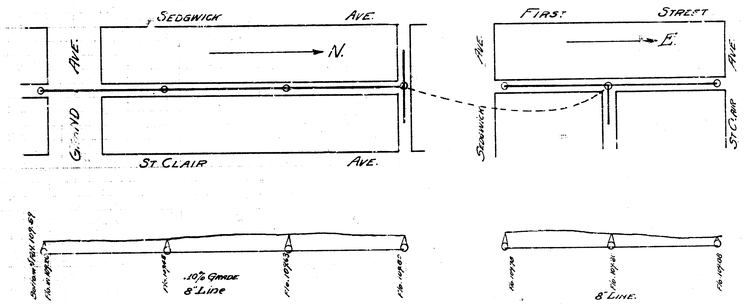
## LAT. "F." SAN. SEWER No. 13