
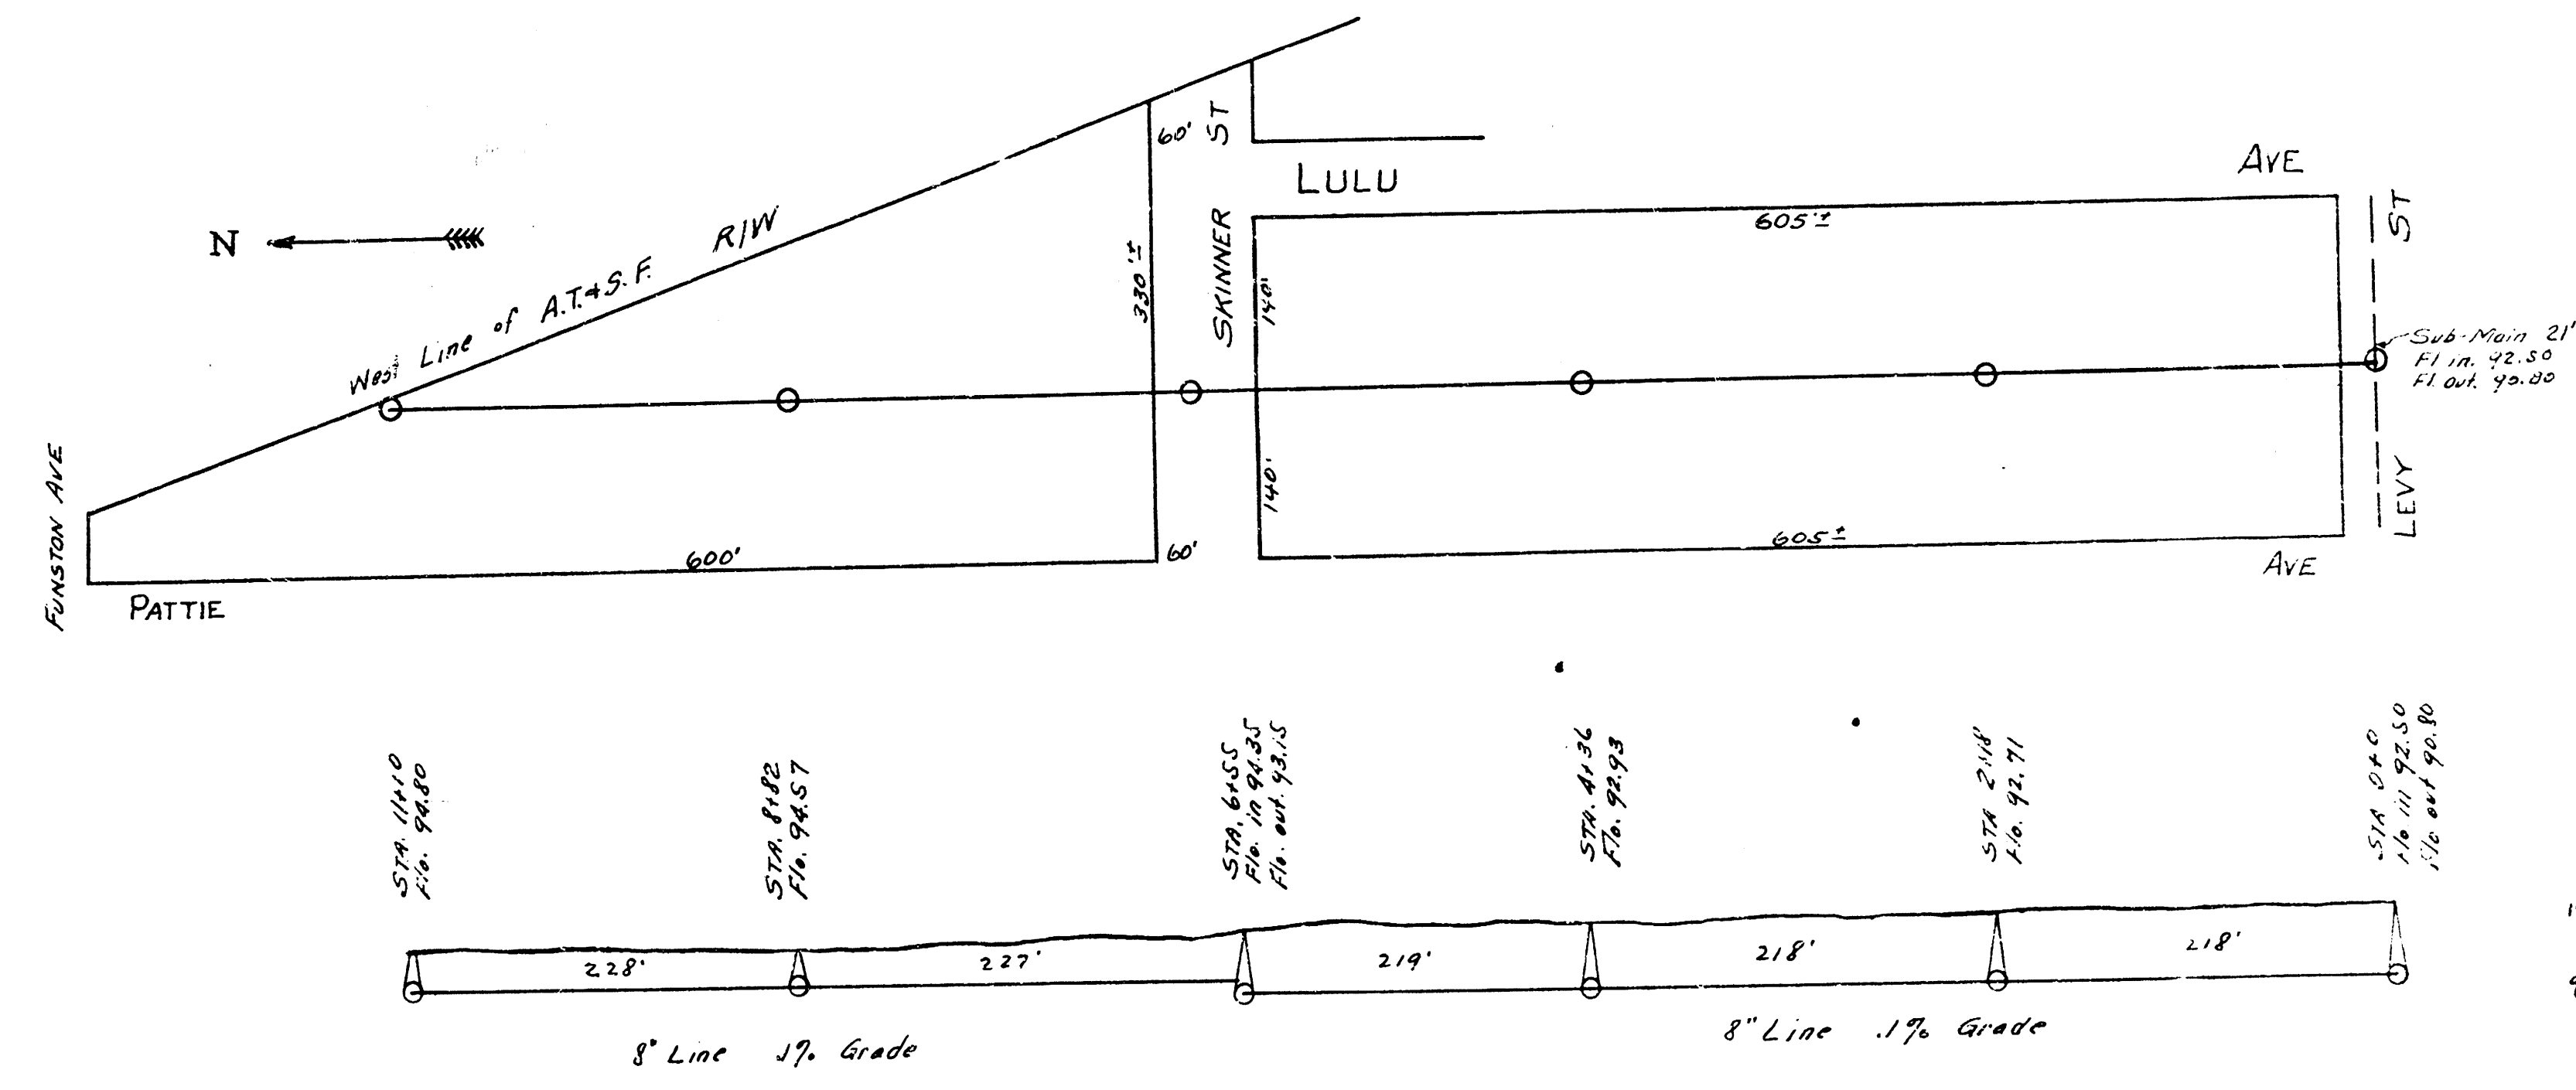
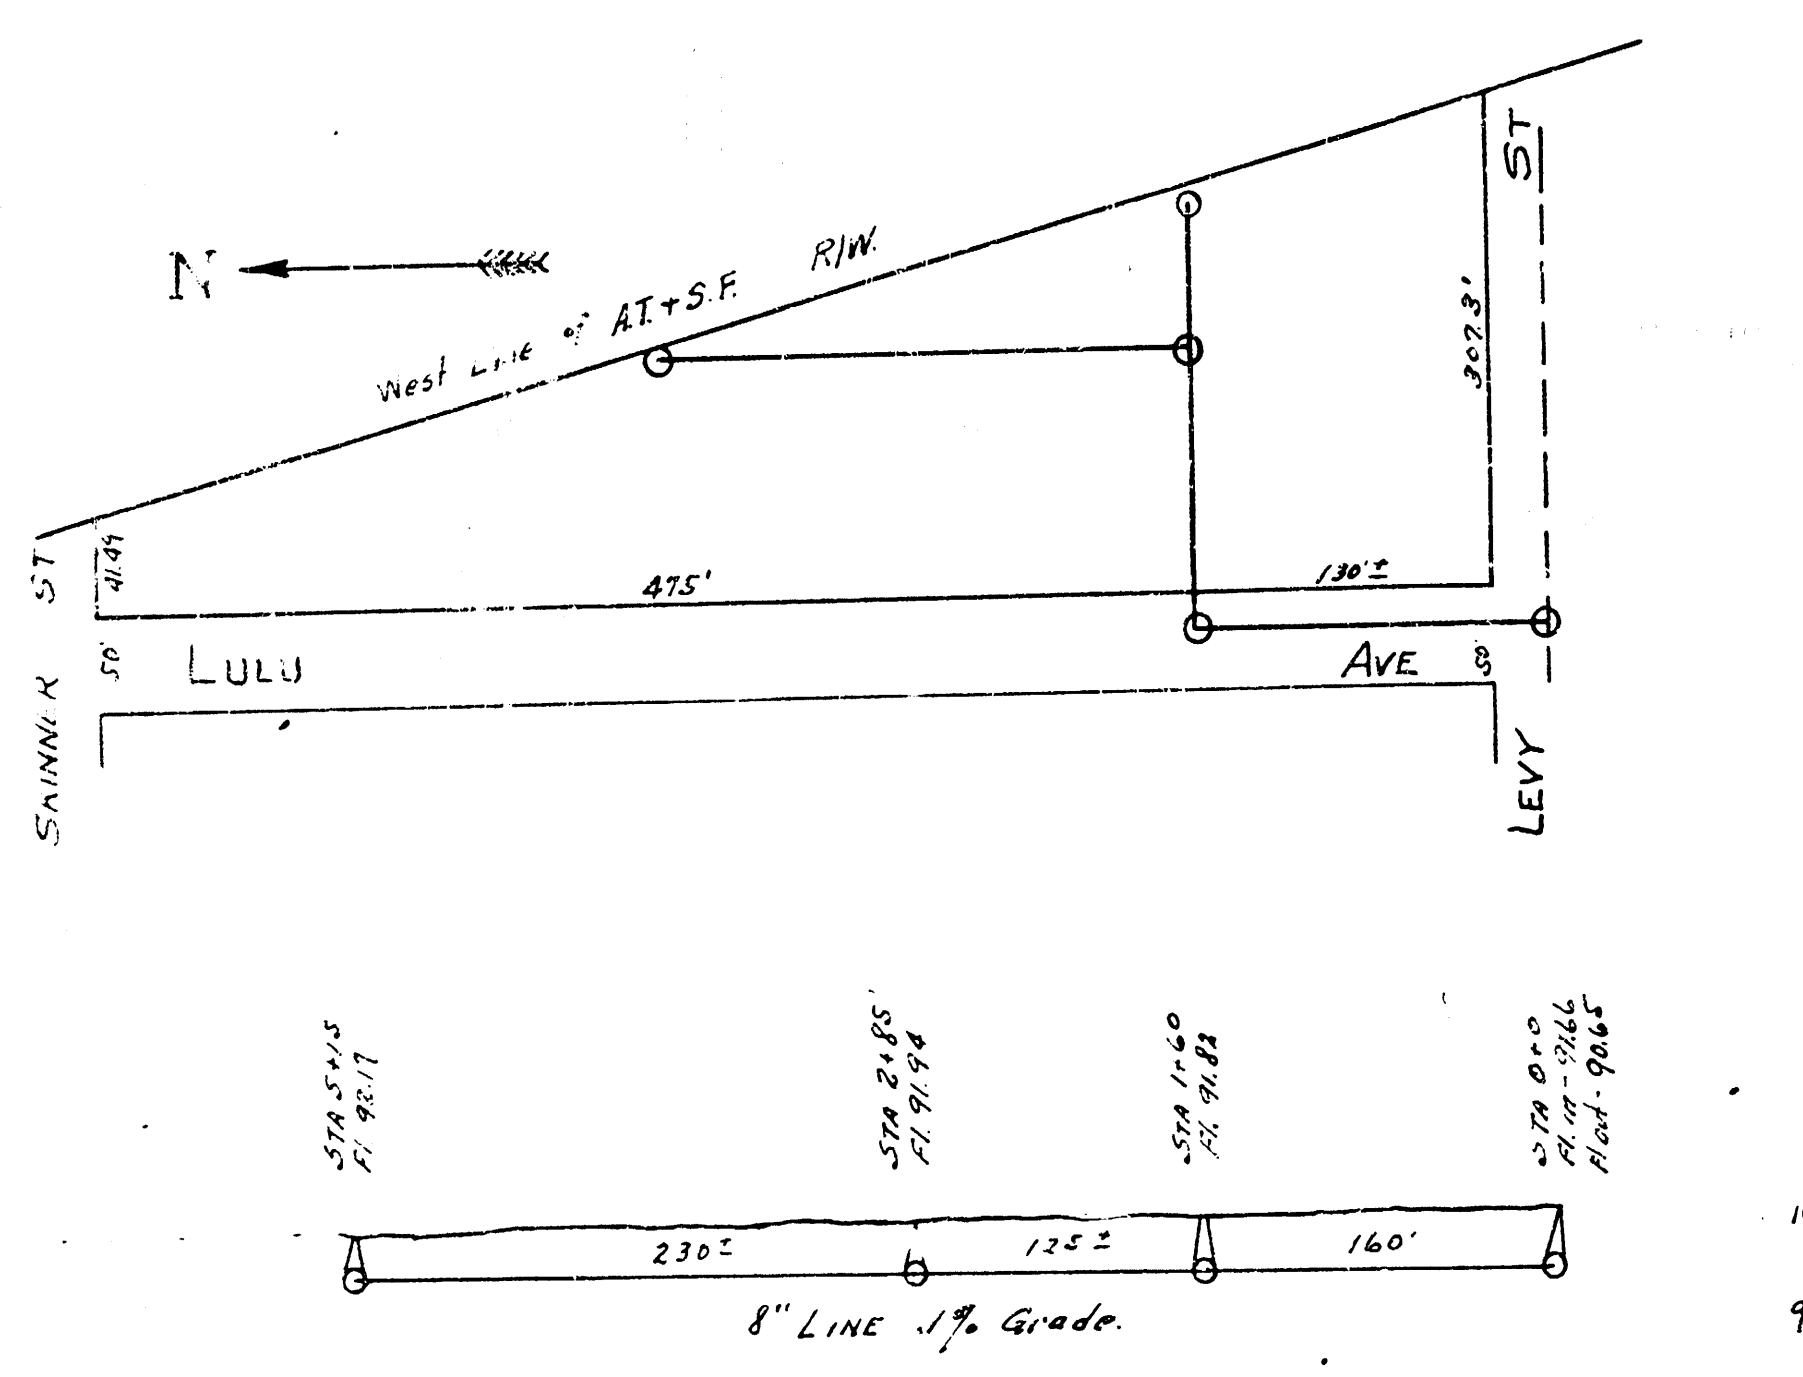
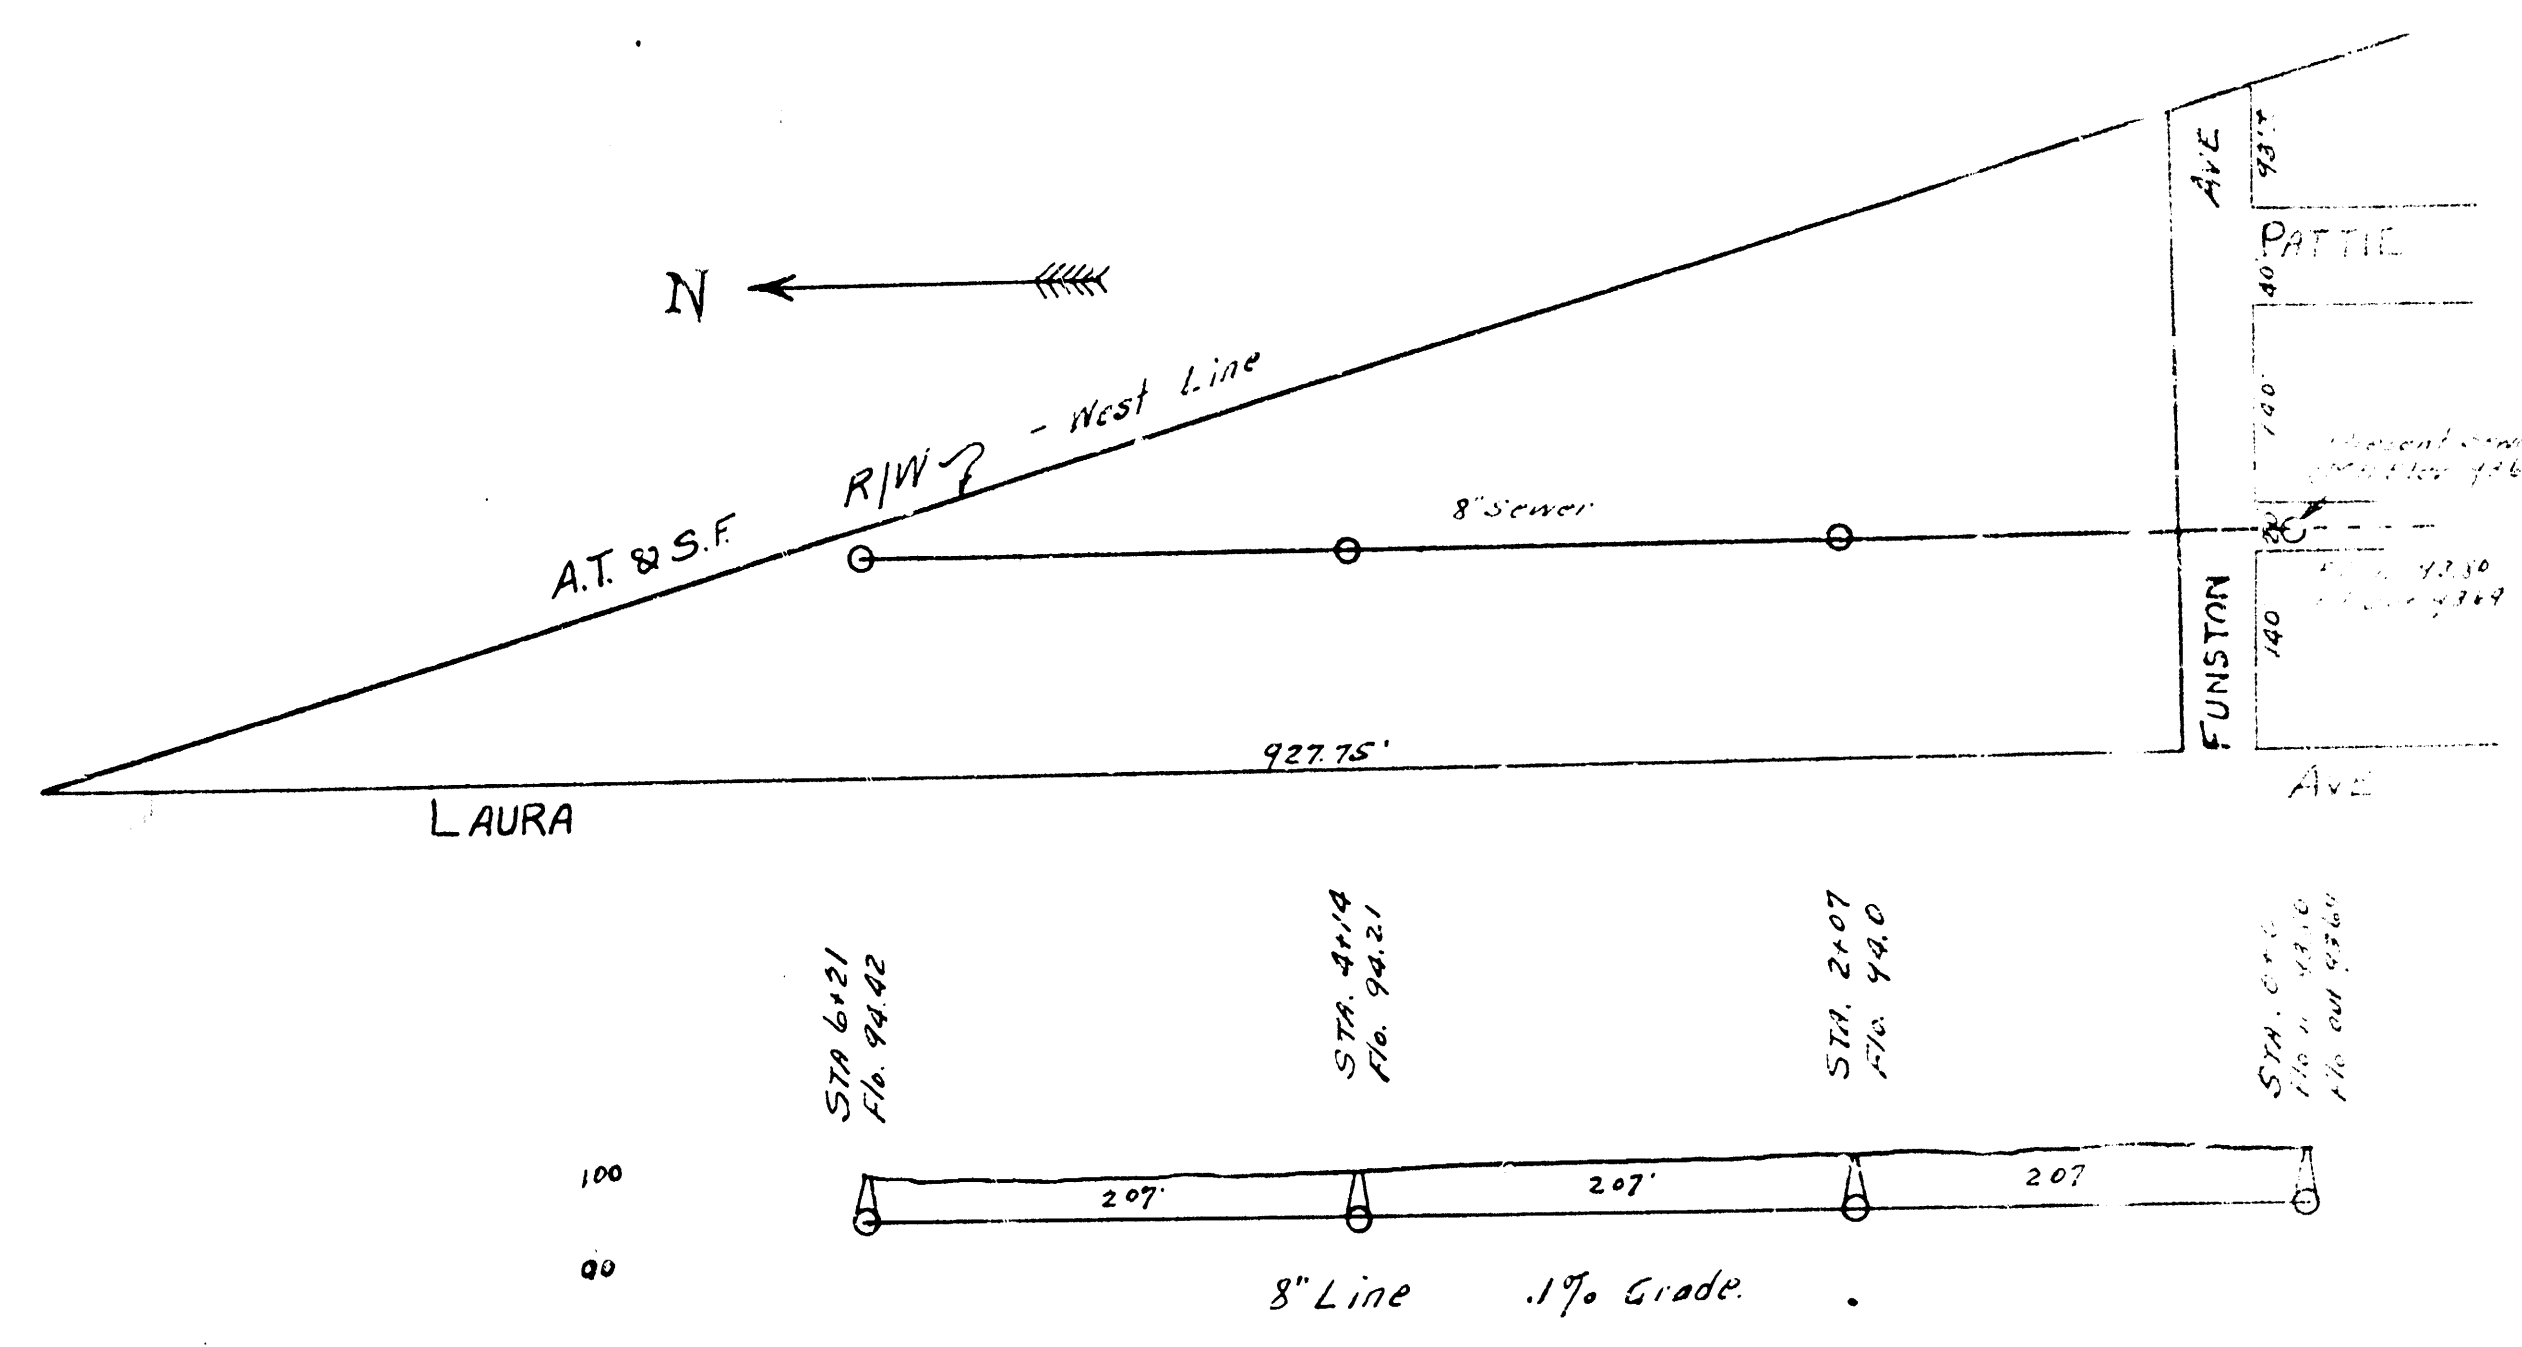


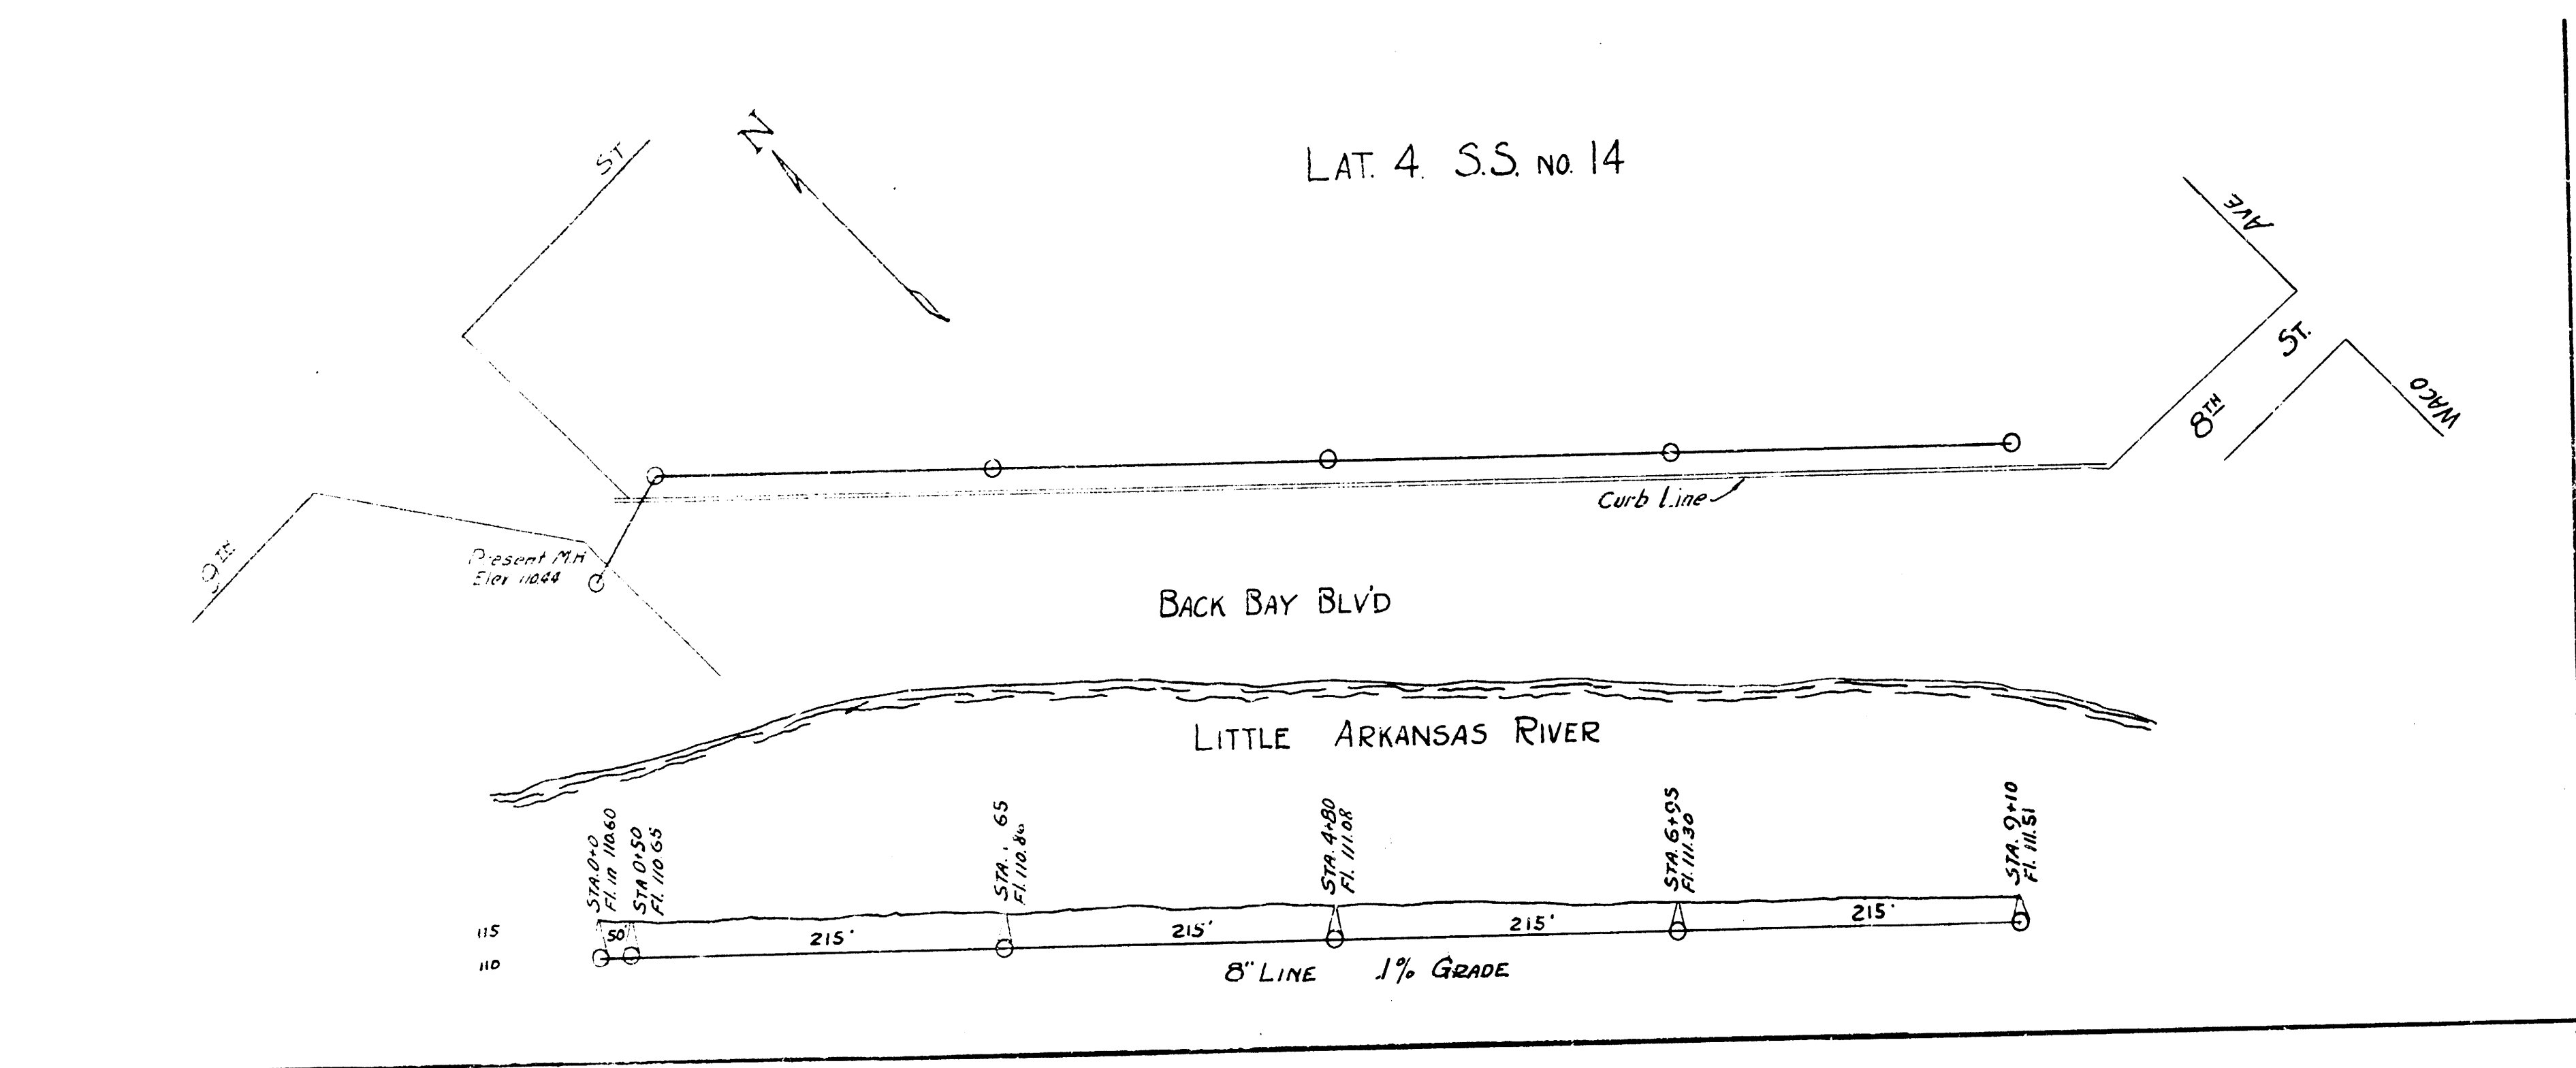

LAT. 19, DIST. C, S.S. 20.