

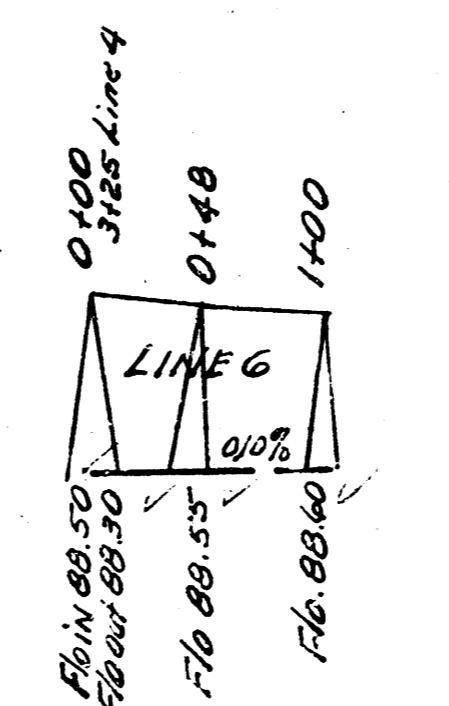
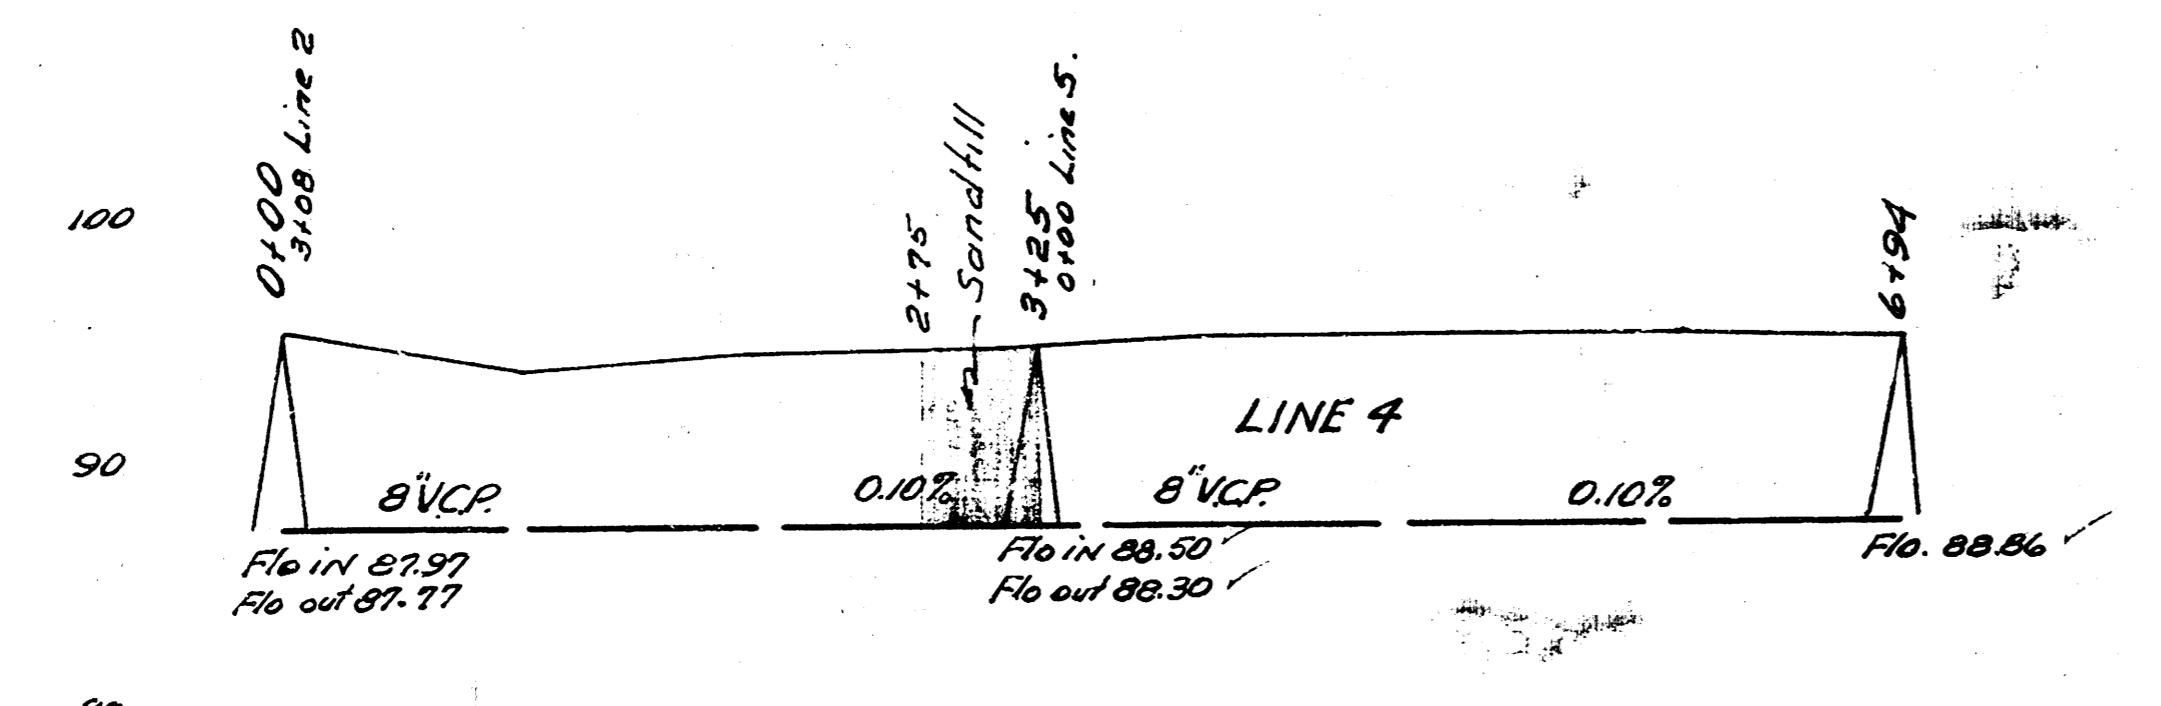
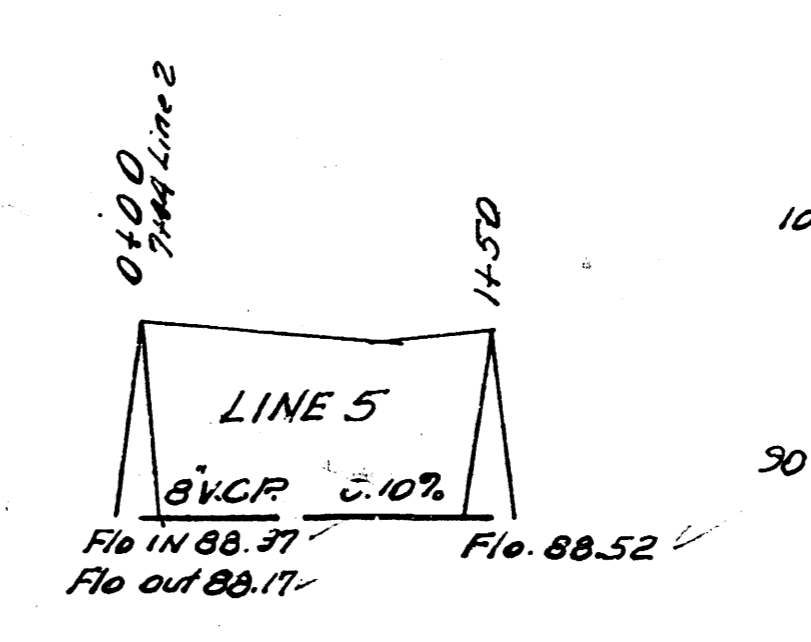
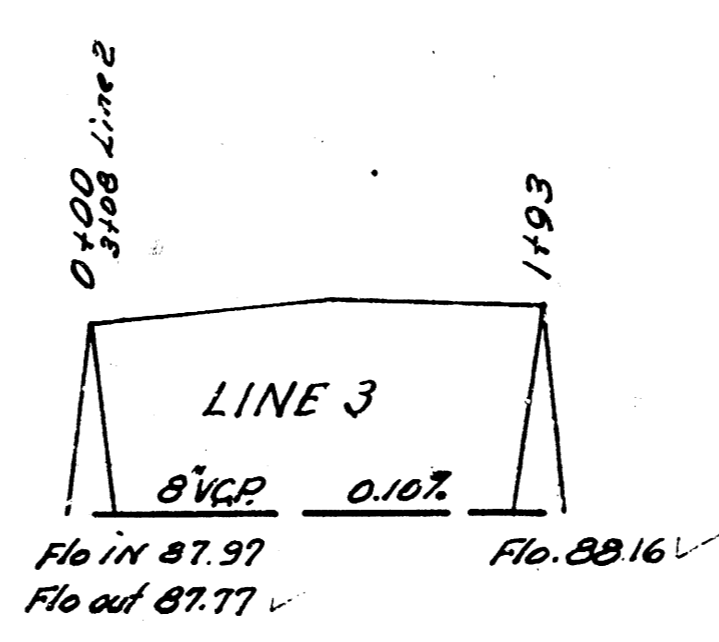


10-1-52
 Done by
 McClure
 Chaschley
 Book No. 23-17

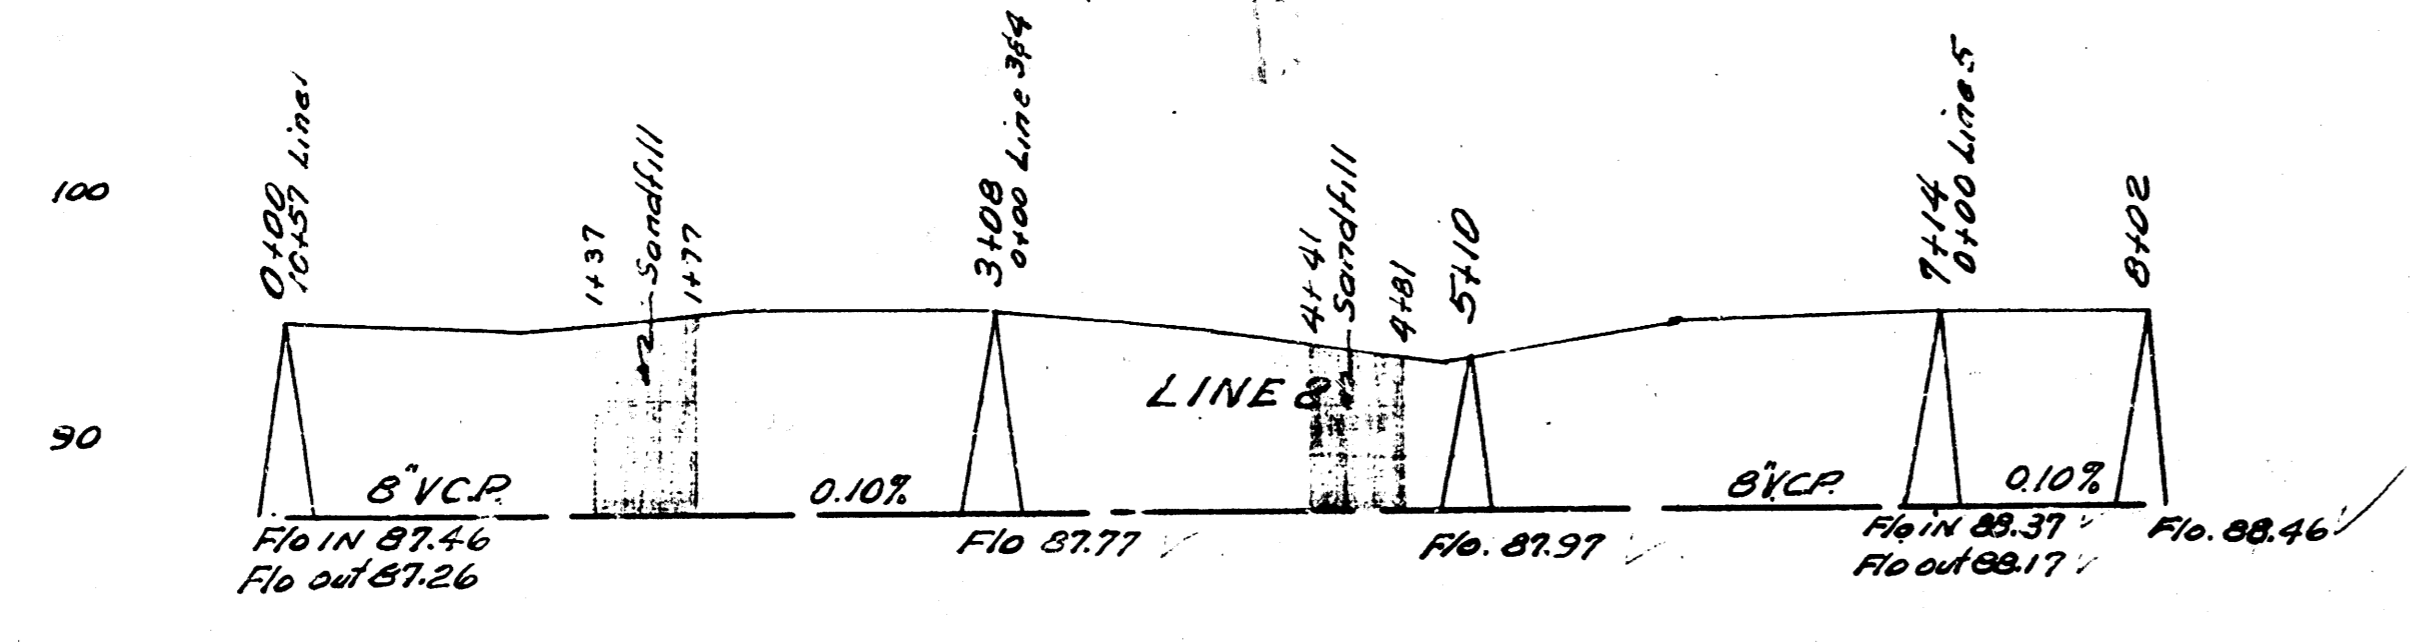

LAT 37 55.20
 CITY OF WICHITA KANSAS
 L.K. WHITE CITY ENGINEER
 Proj No. C-22-80

B.M. 34.11 60' Spike N.S. K.G. & E. Pole near House 2612 Classen Ave
 99.32 S.E. Corner Conc porch 2541 So Hydraulic

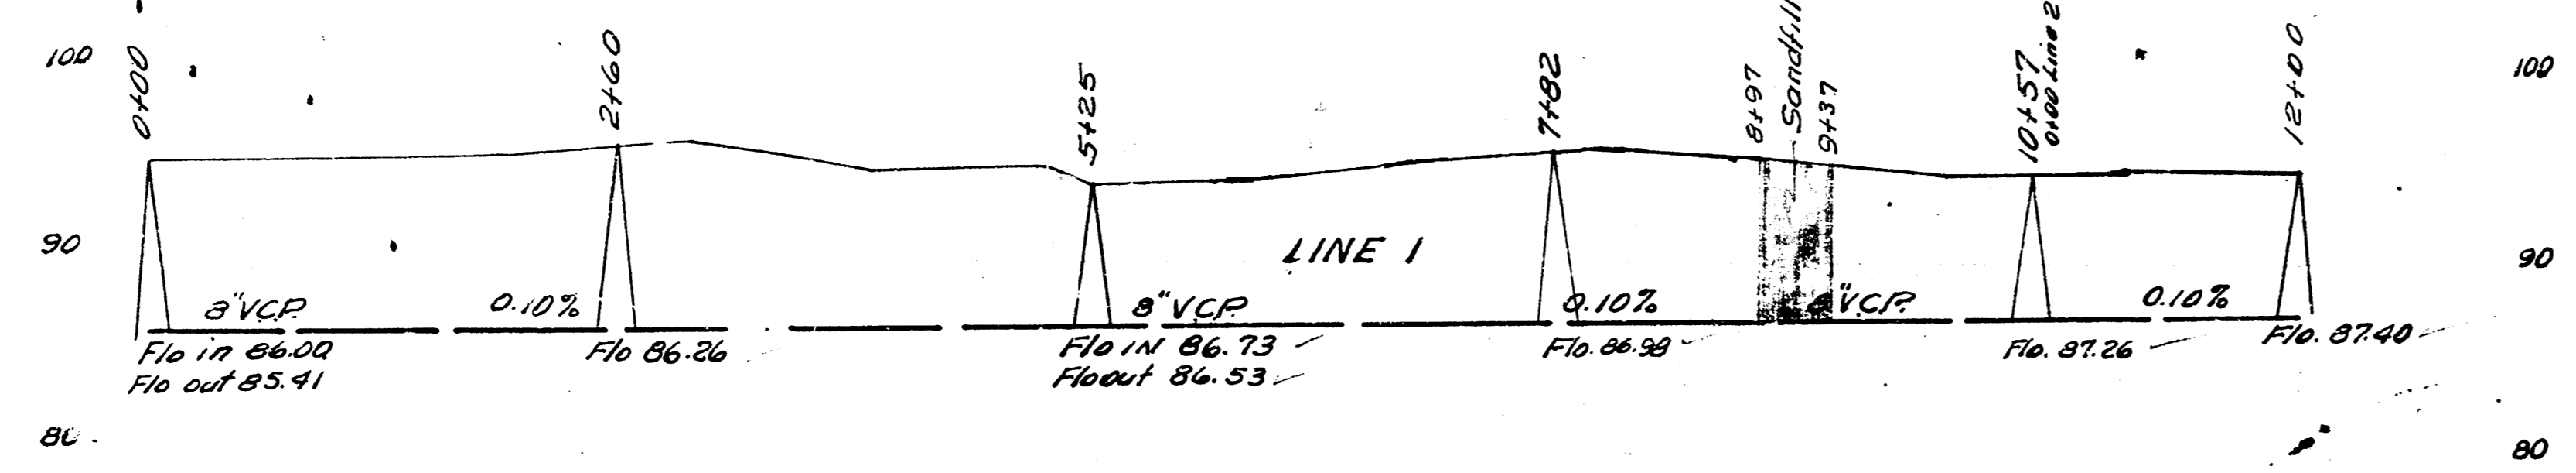

Date: 10-2-82
 Drawn by: M. J. ...
 Checked by: ...
 Sheet No. 63 Y

LAT 37 5520
 CITY OF WICHITA KANSAS
 LK WHITE CITY ENGINEERS
 Proj. No. C-22-80