



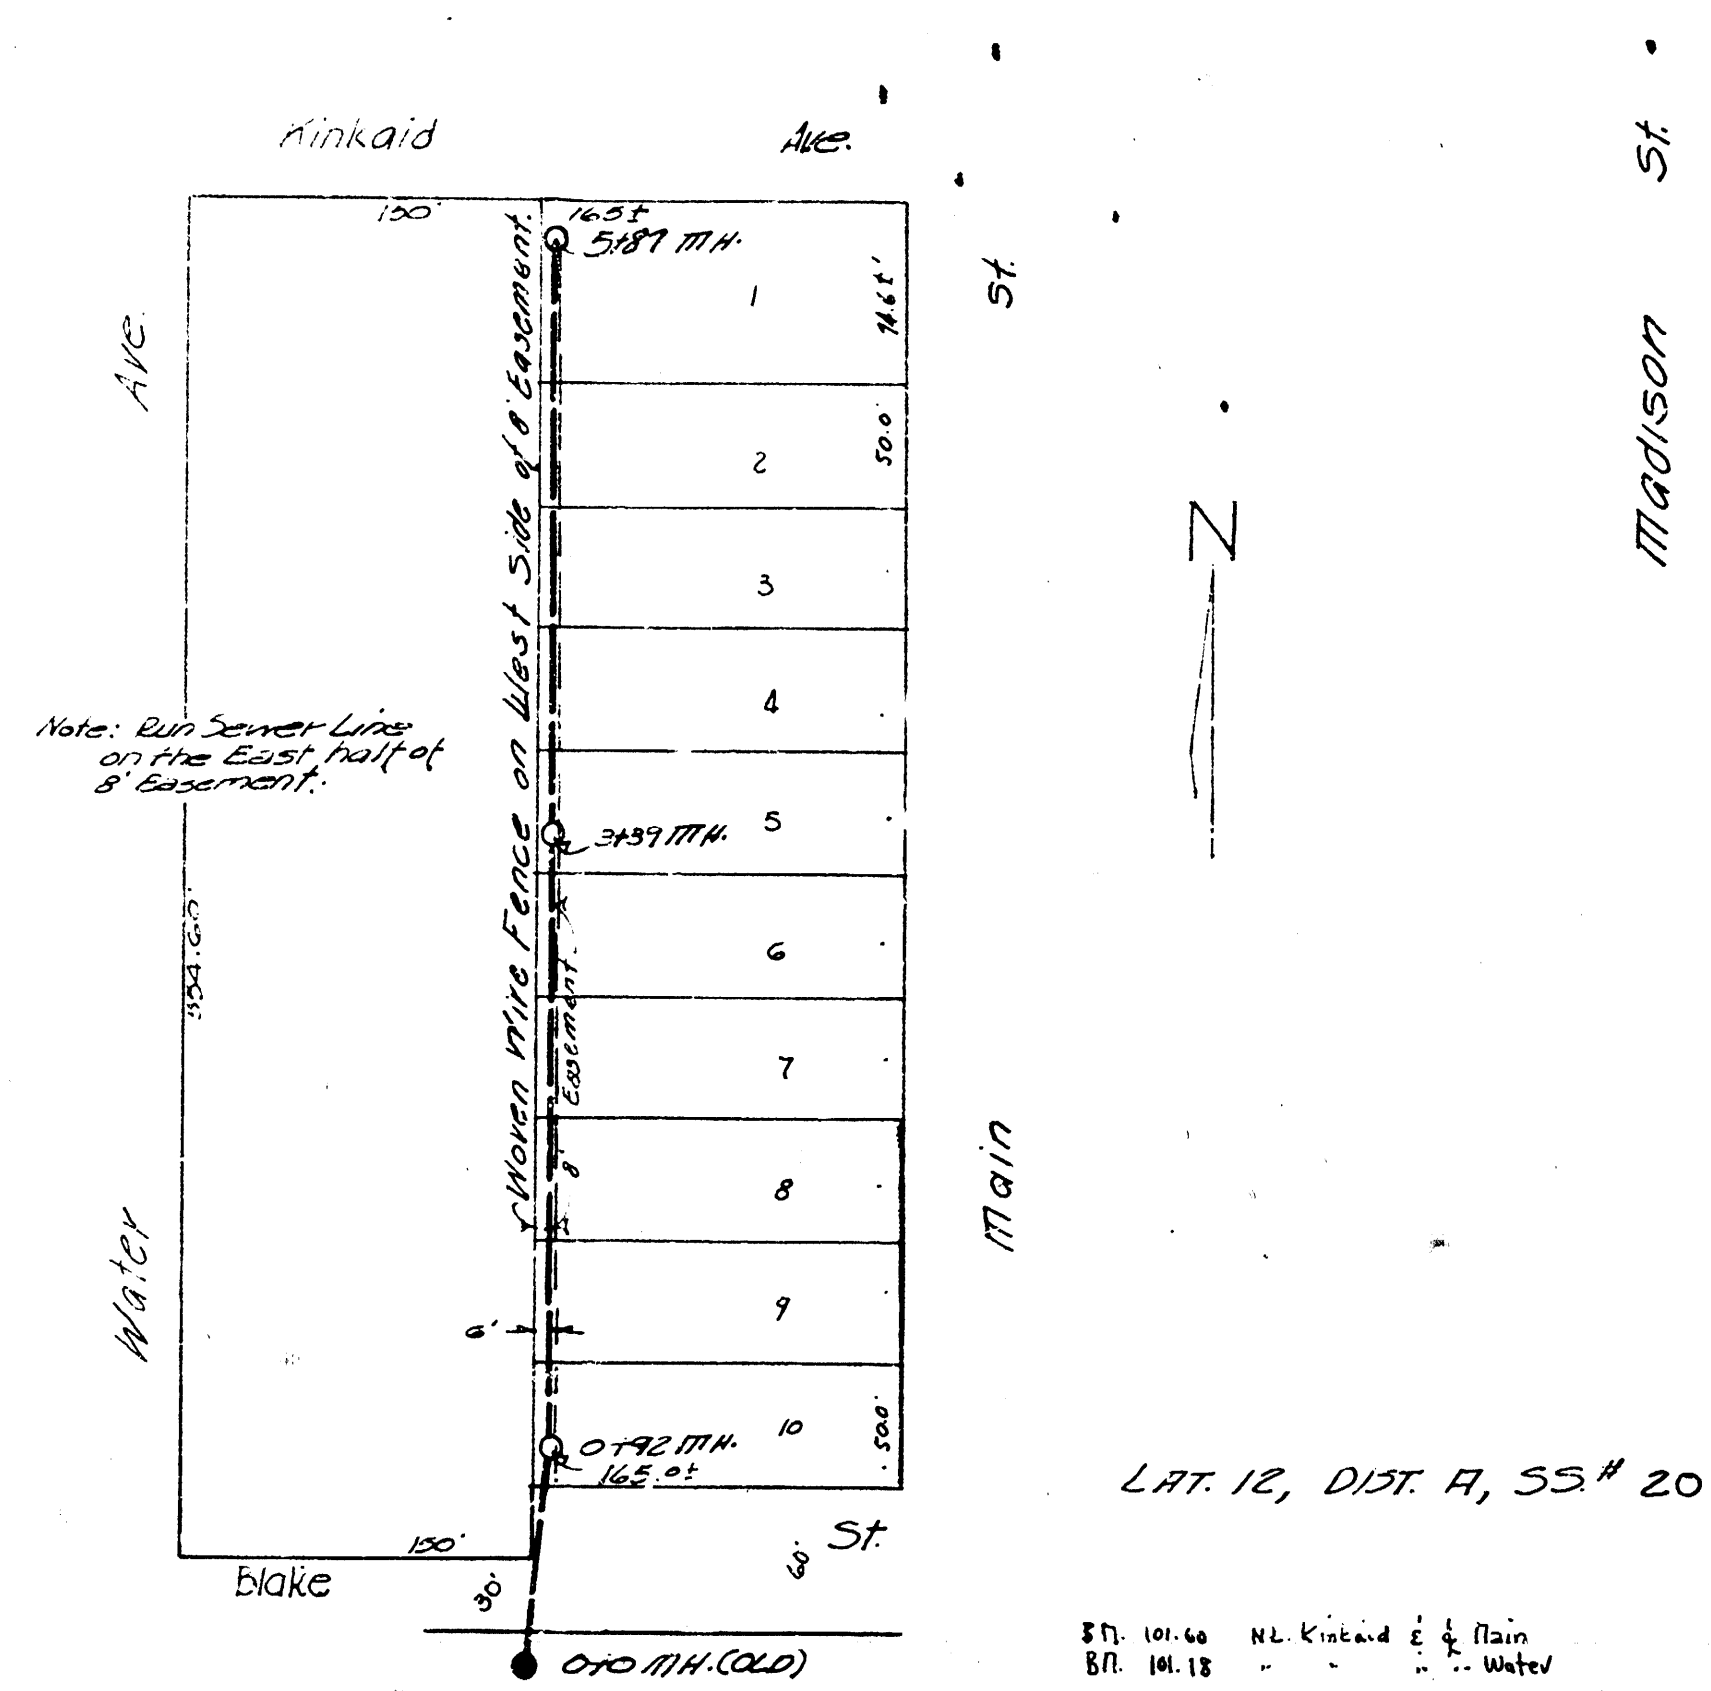


Lot 12, Dist. A, SS#20


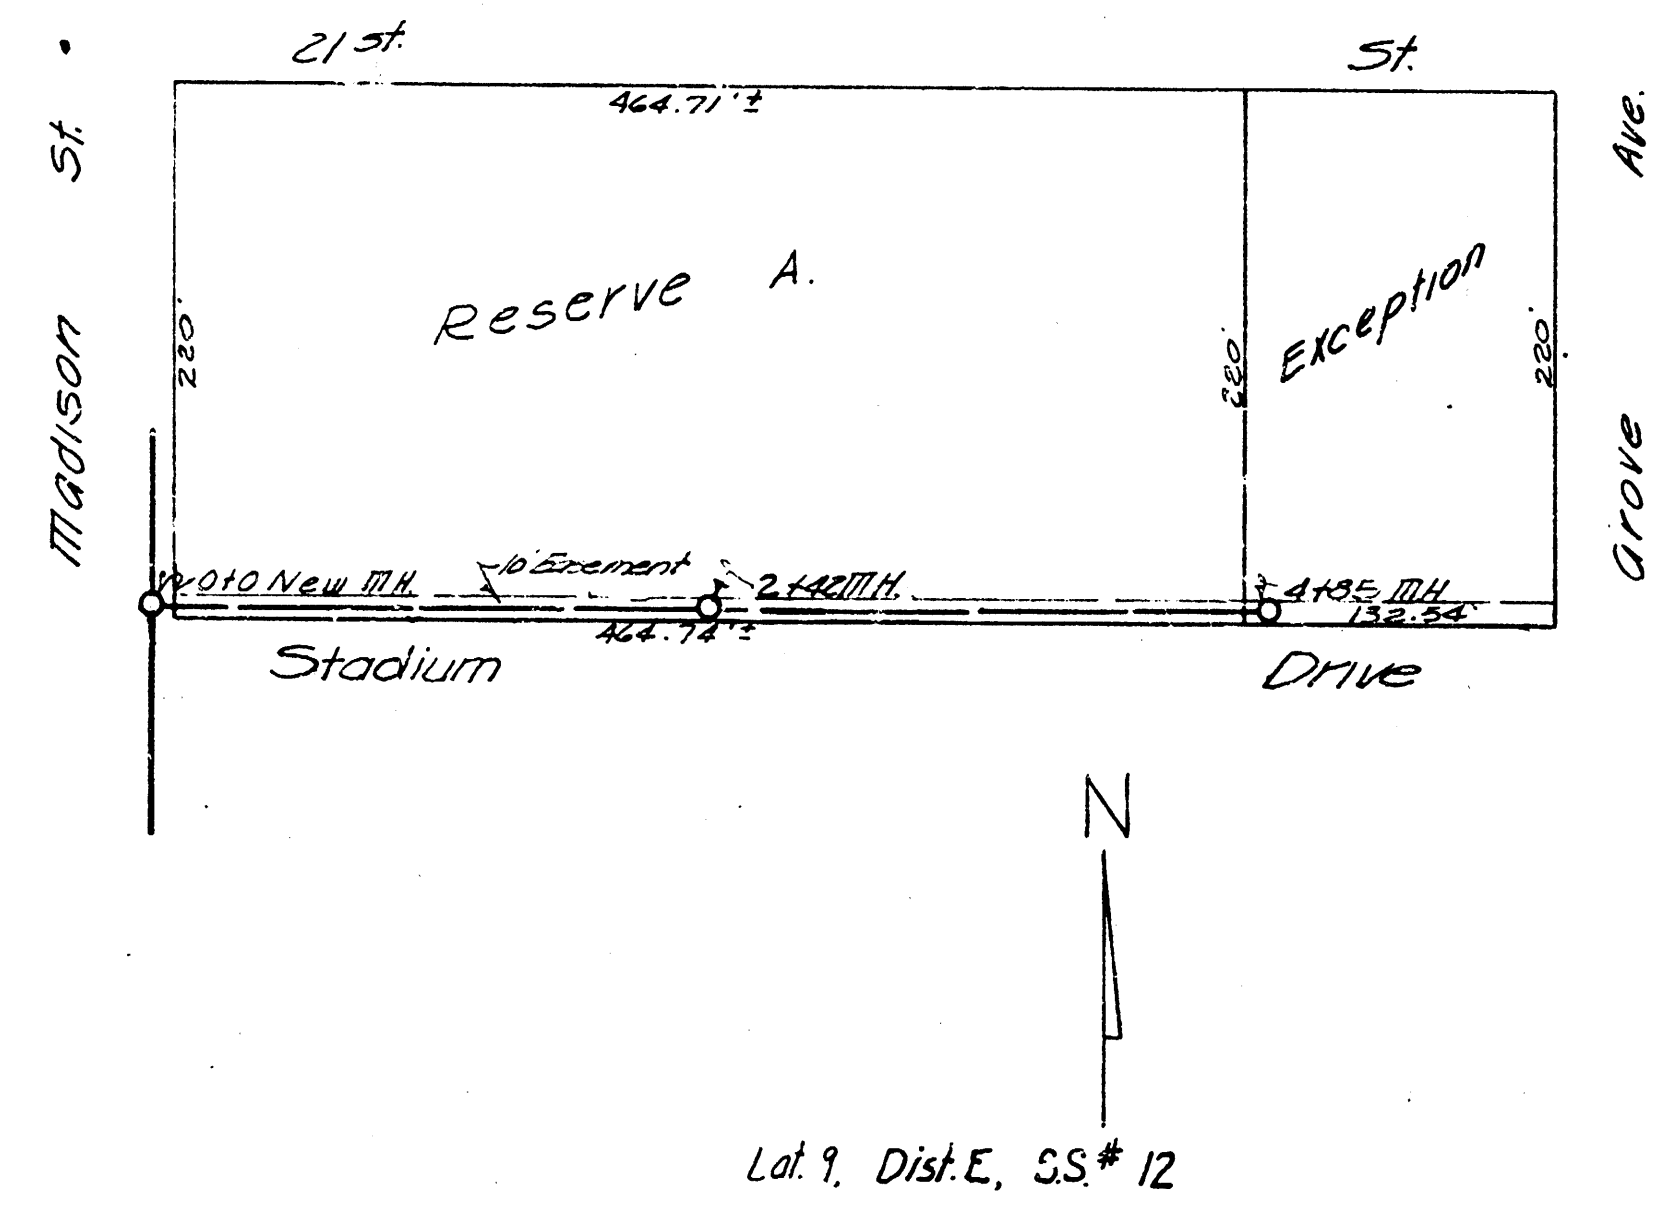


Lot 9, Dist. E, SS#12



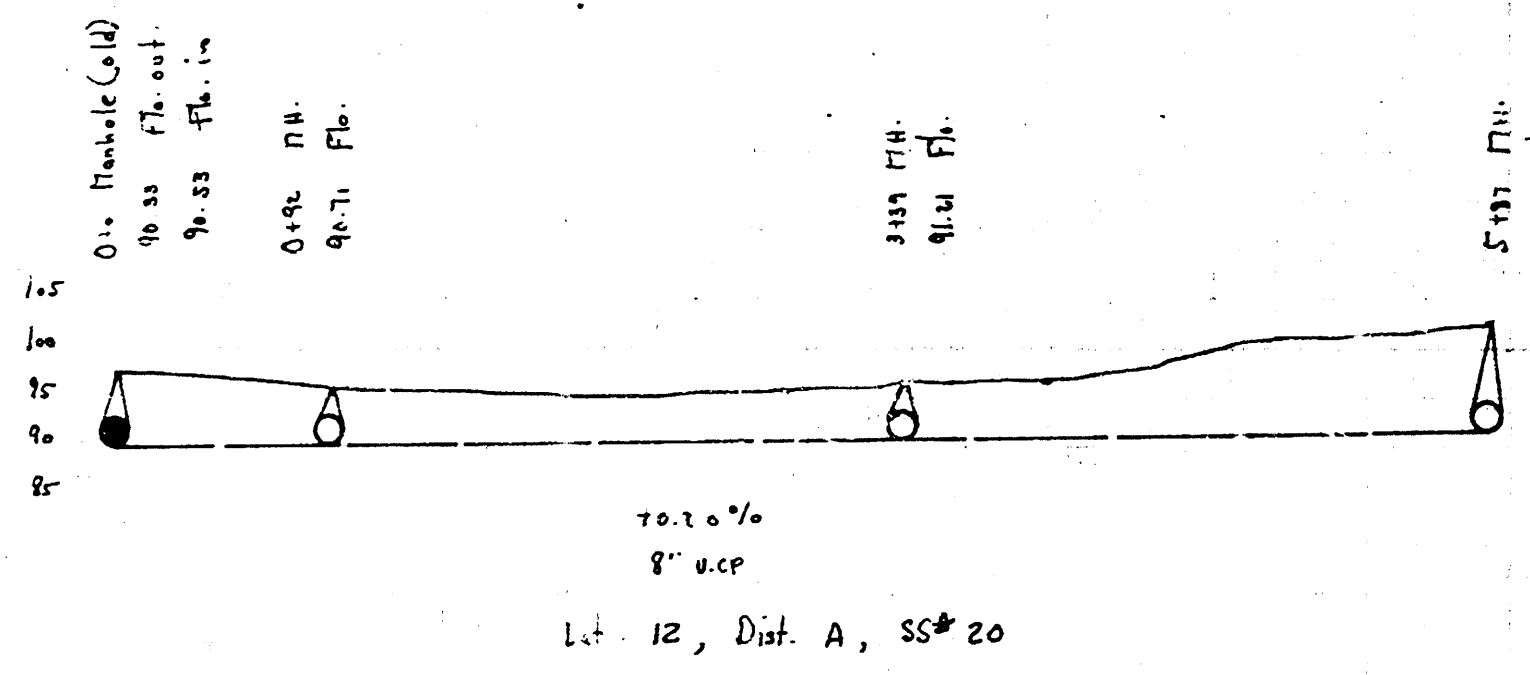


Lot 12, Dist. A, SS#20

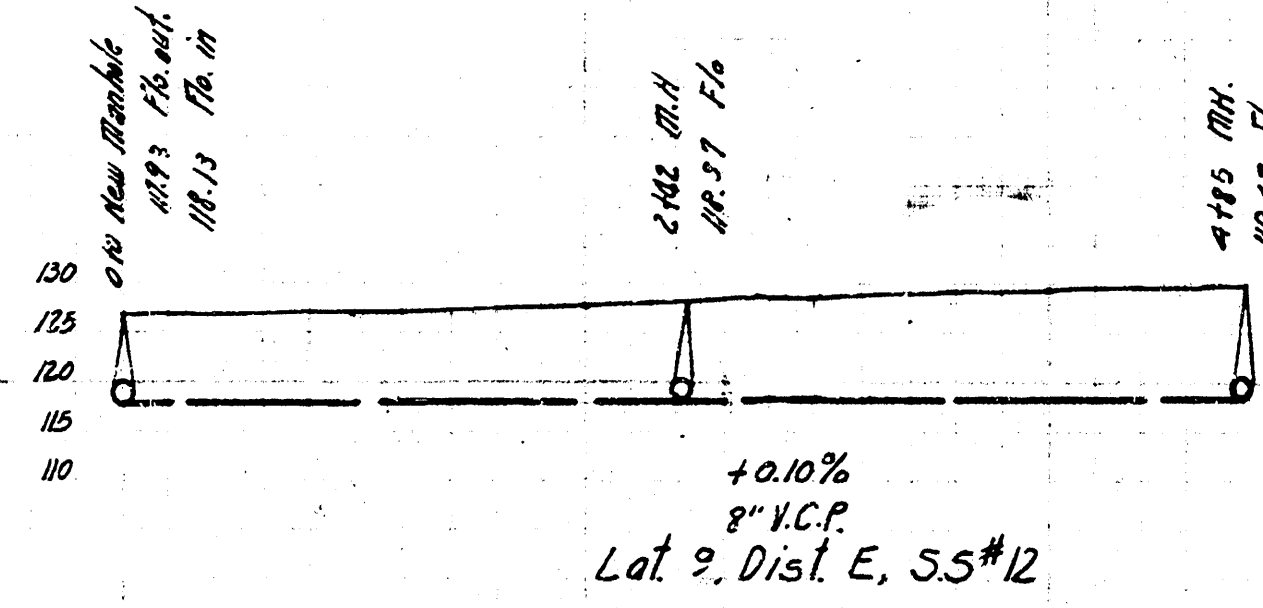

Lot 9, Dist. E, SS#12

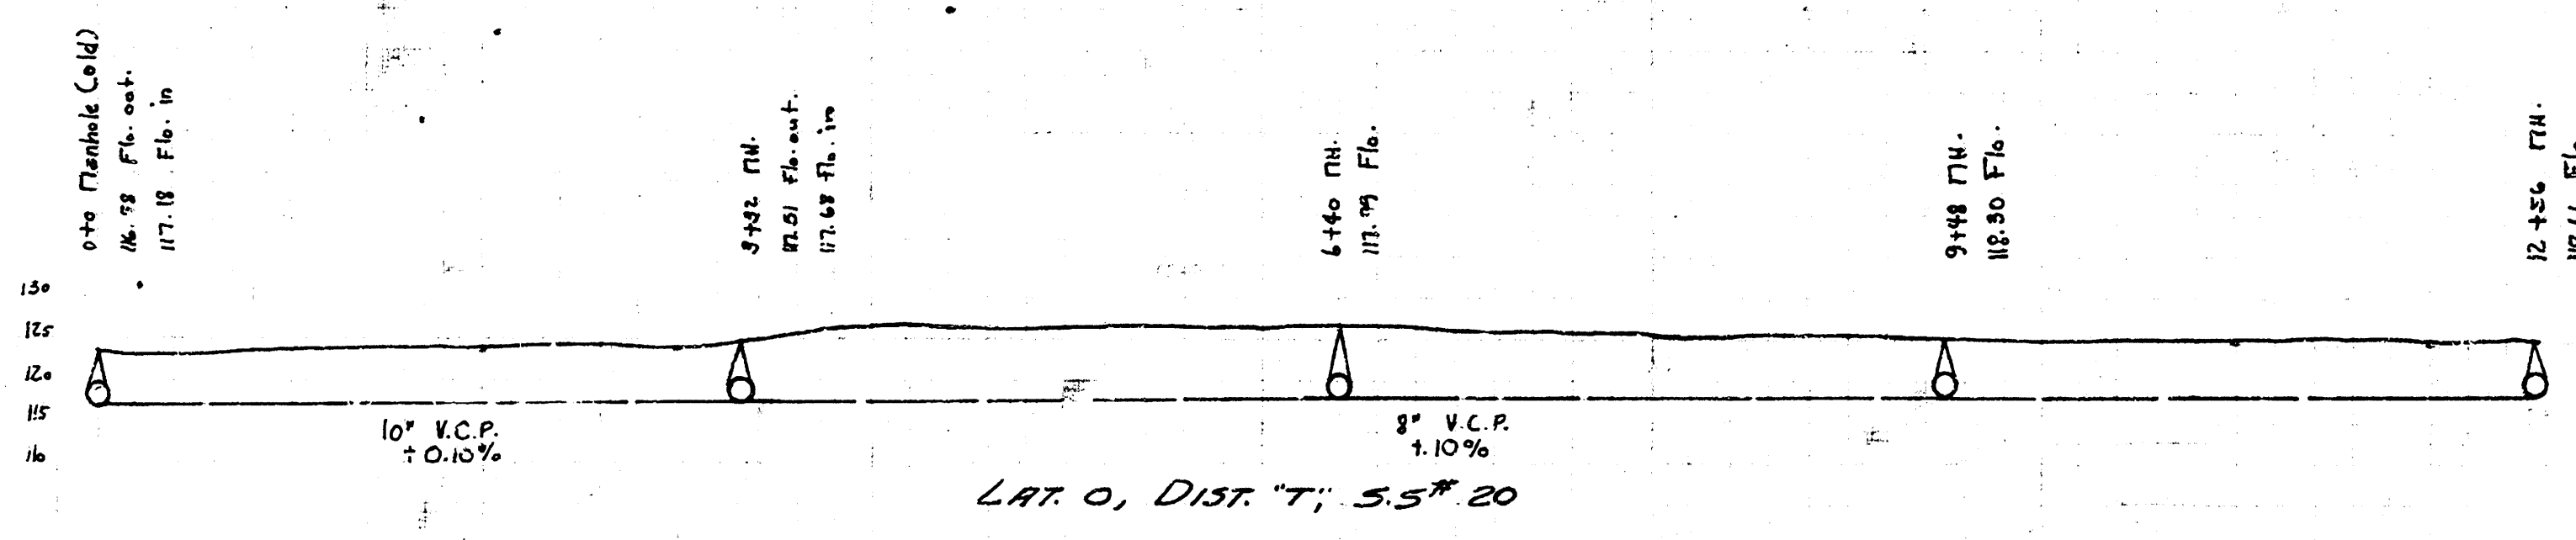

Lot 0, Dist. T, SS#20

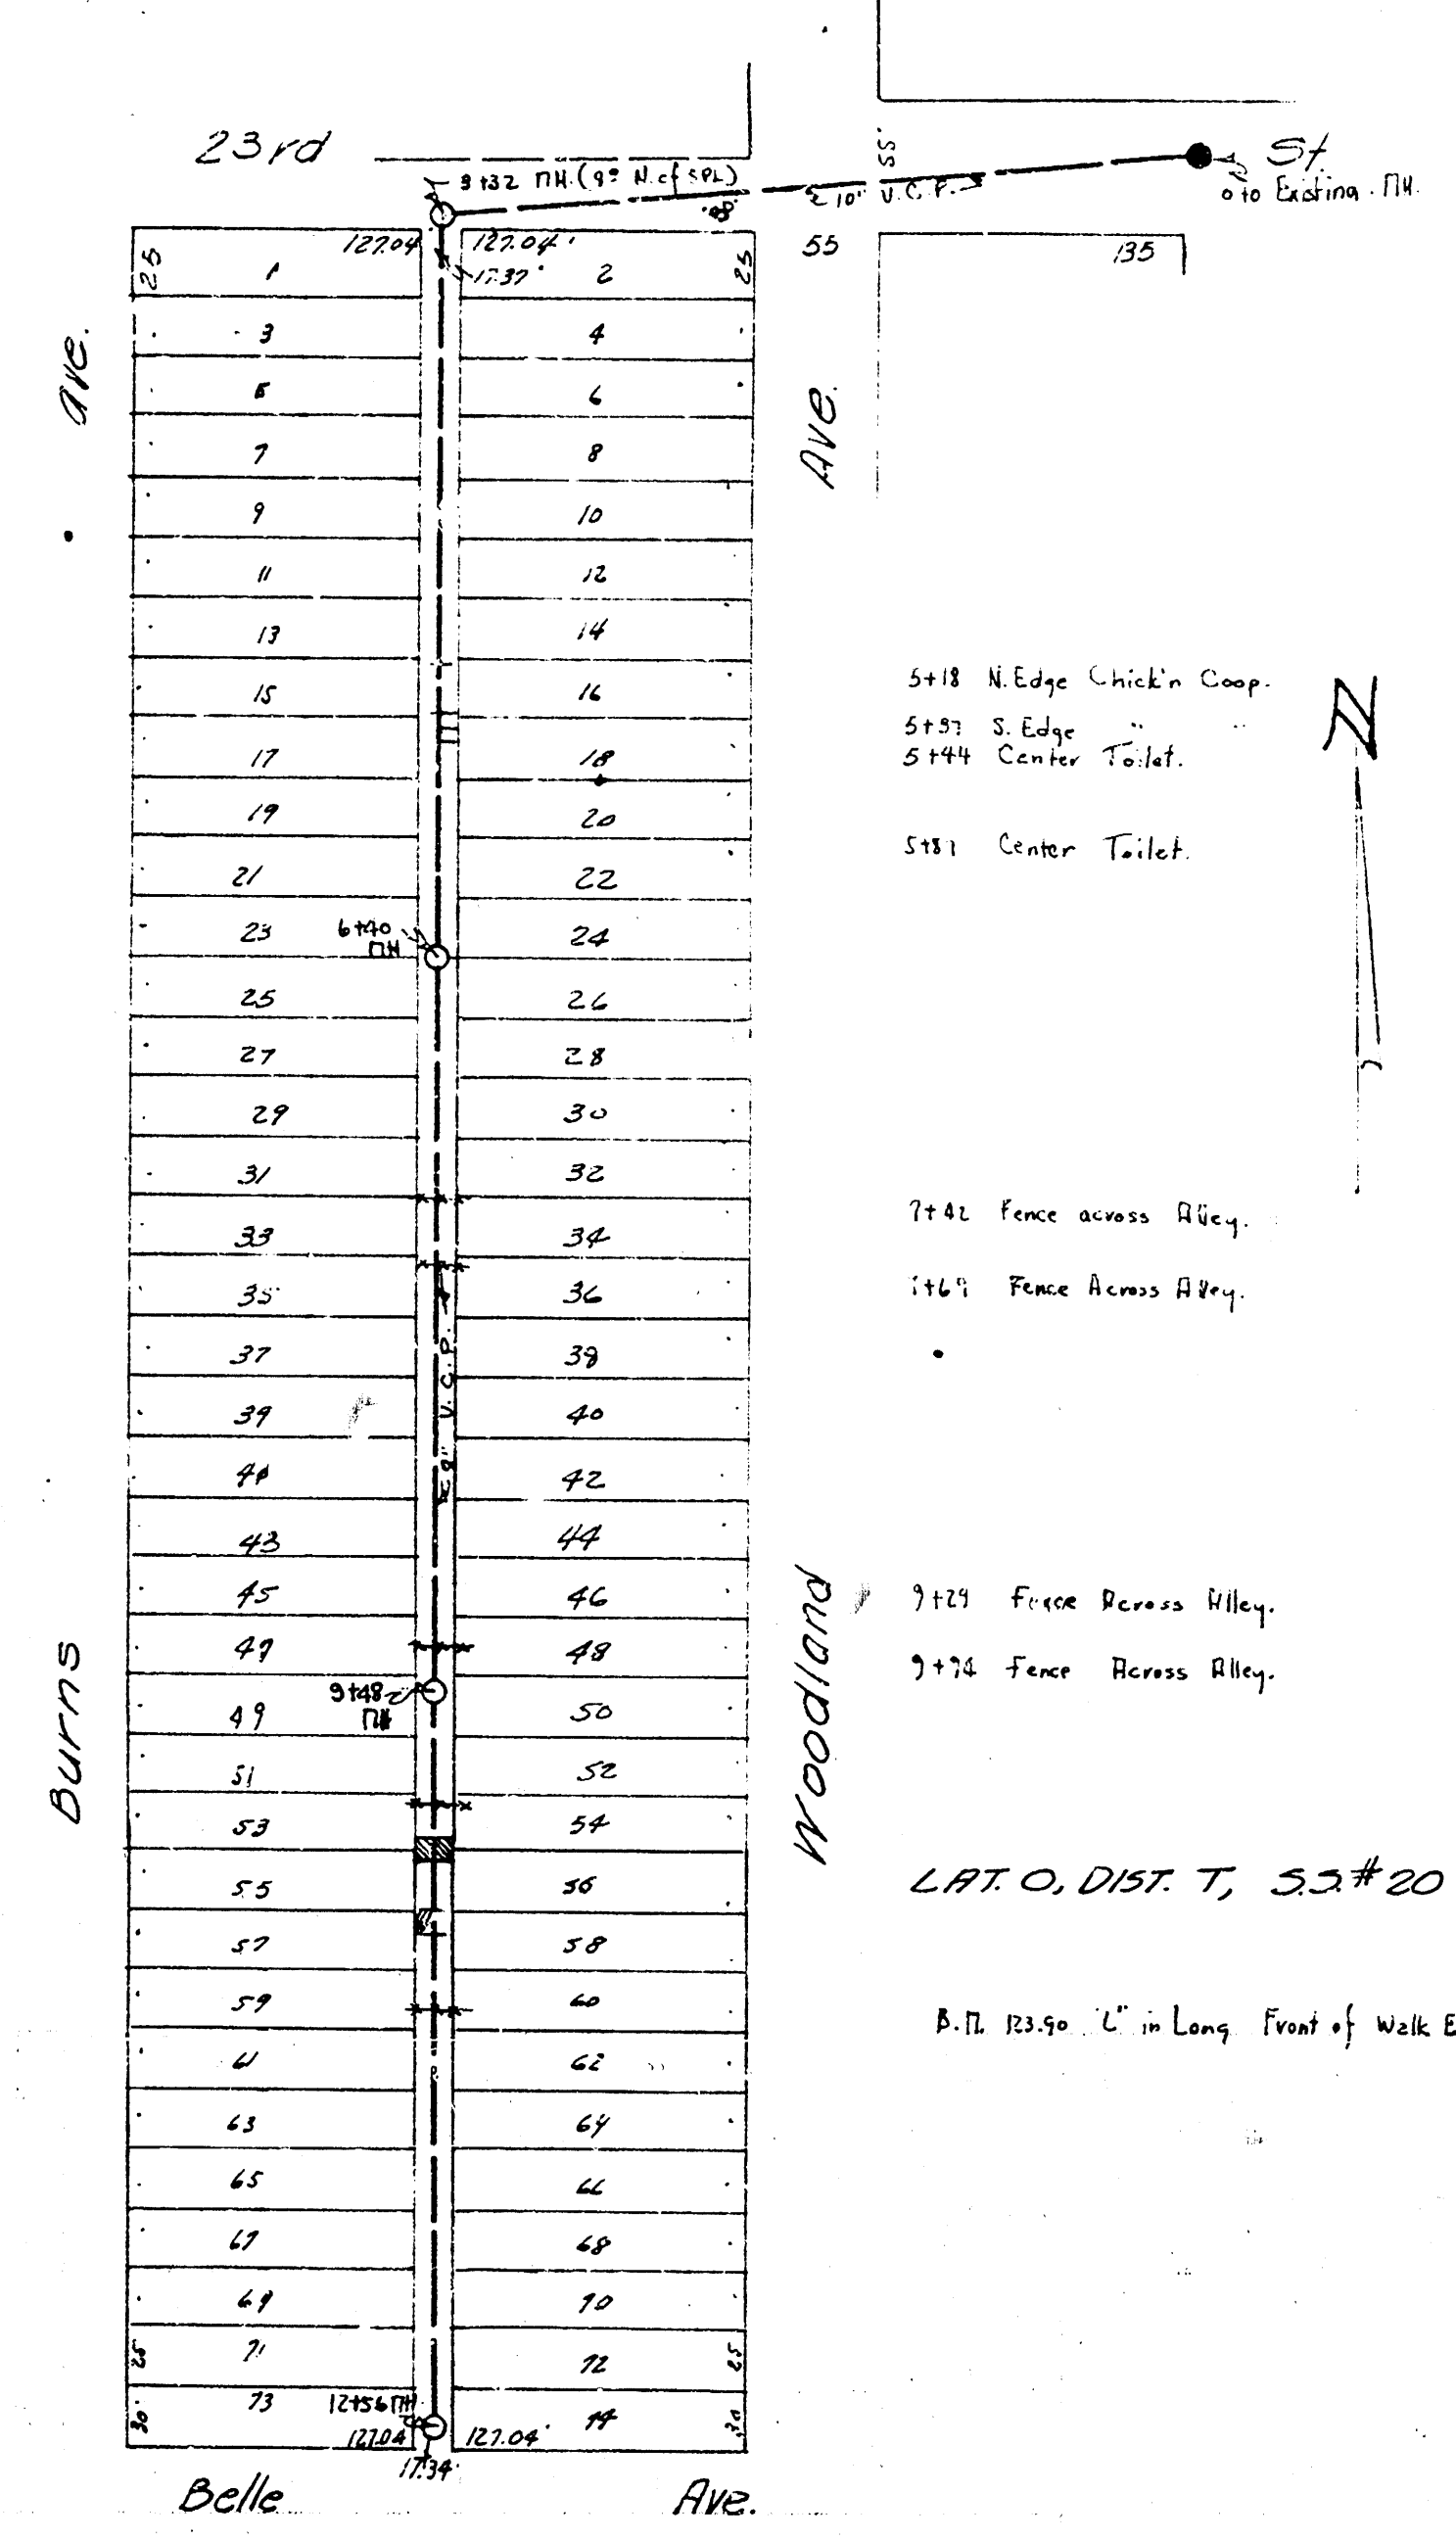

Lot 0, Dist. T, SS#20



City of Wichita, Kansas
L.R. White City Engineer
177th 1949

