
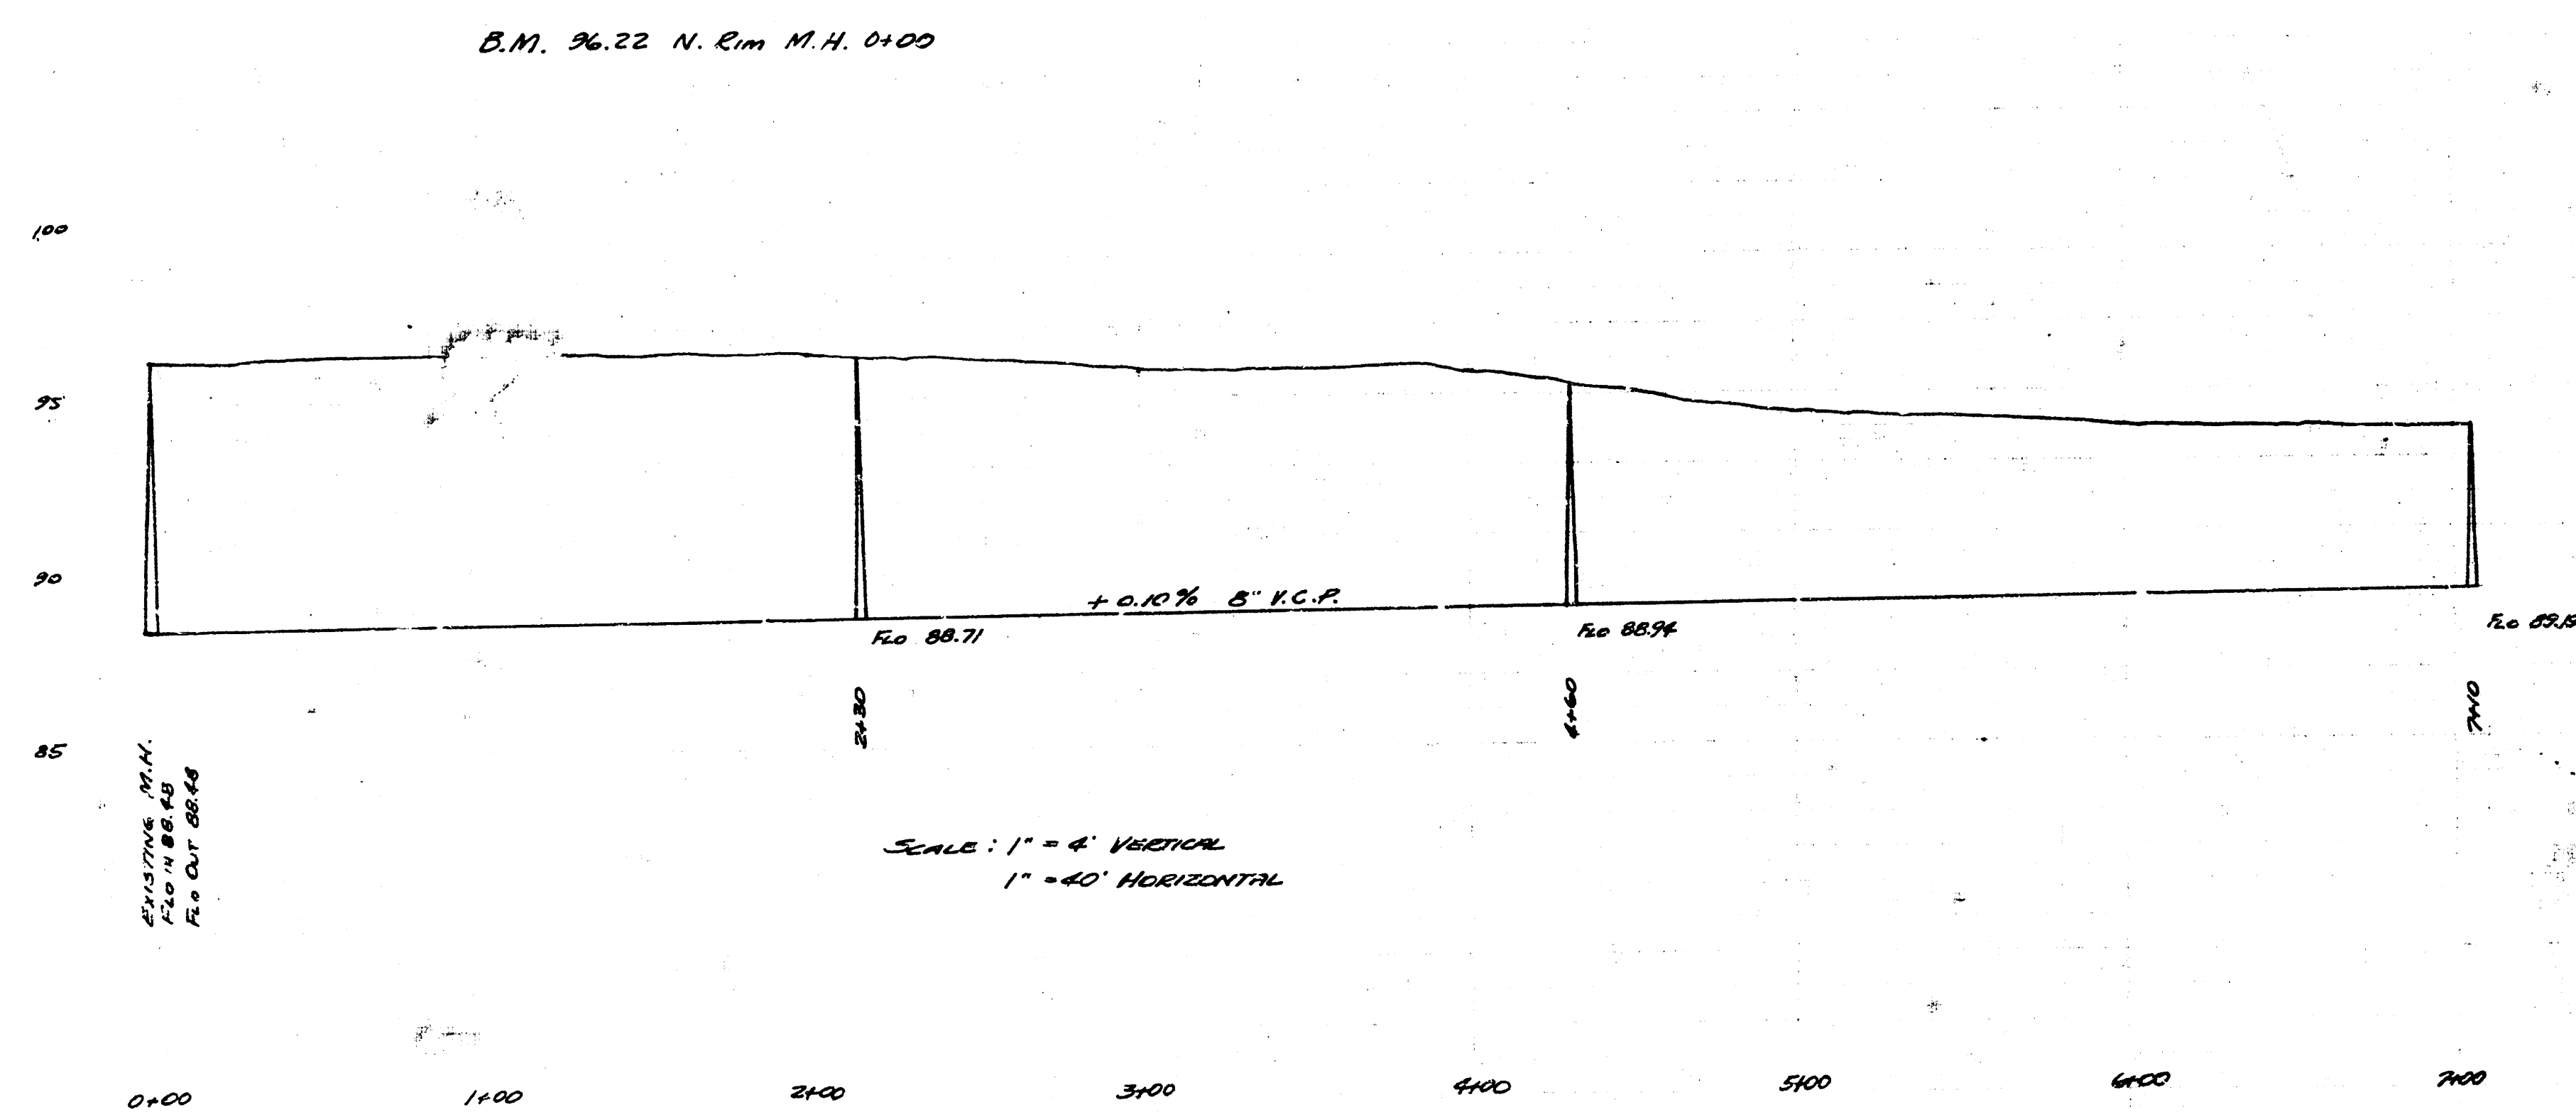


LAT. 17, DIST. A, S.S. 20
CITY OF WICHITA, KANSAS
L.K. WHITE - CITY ENGINEER
JULY, 1951 PROJ. C20-50

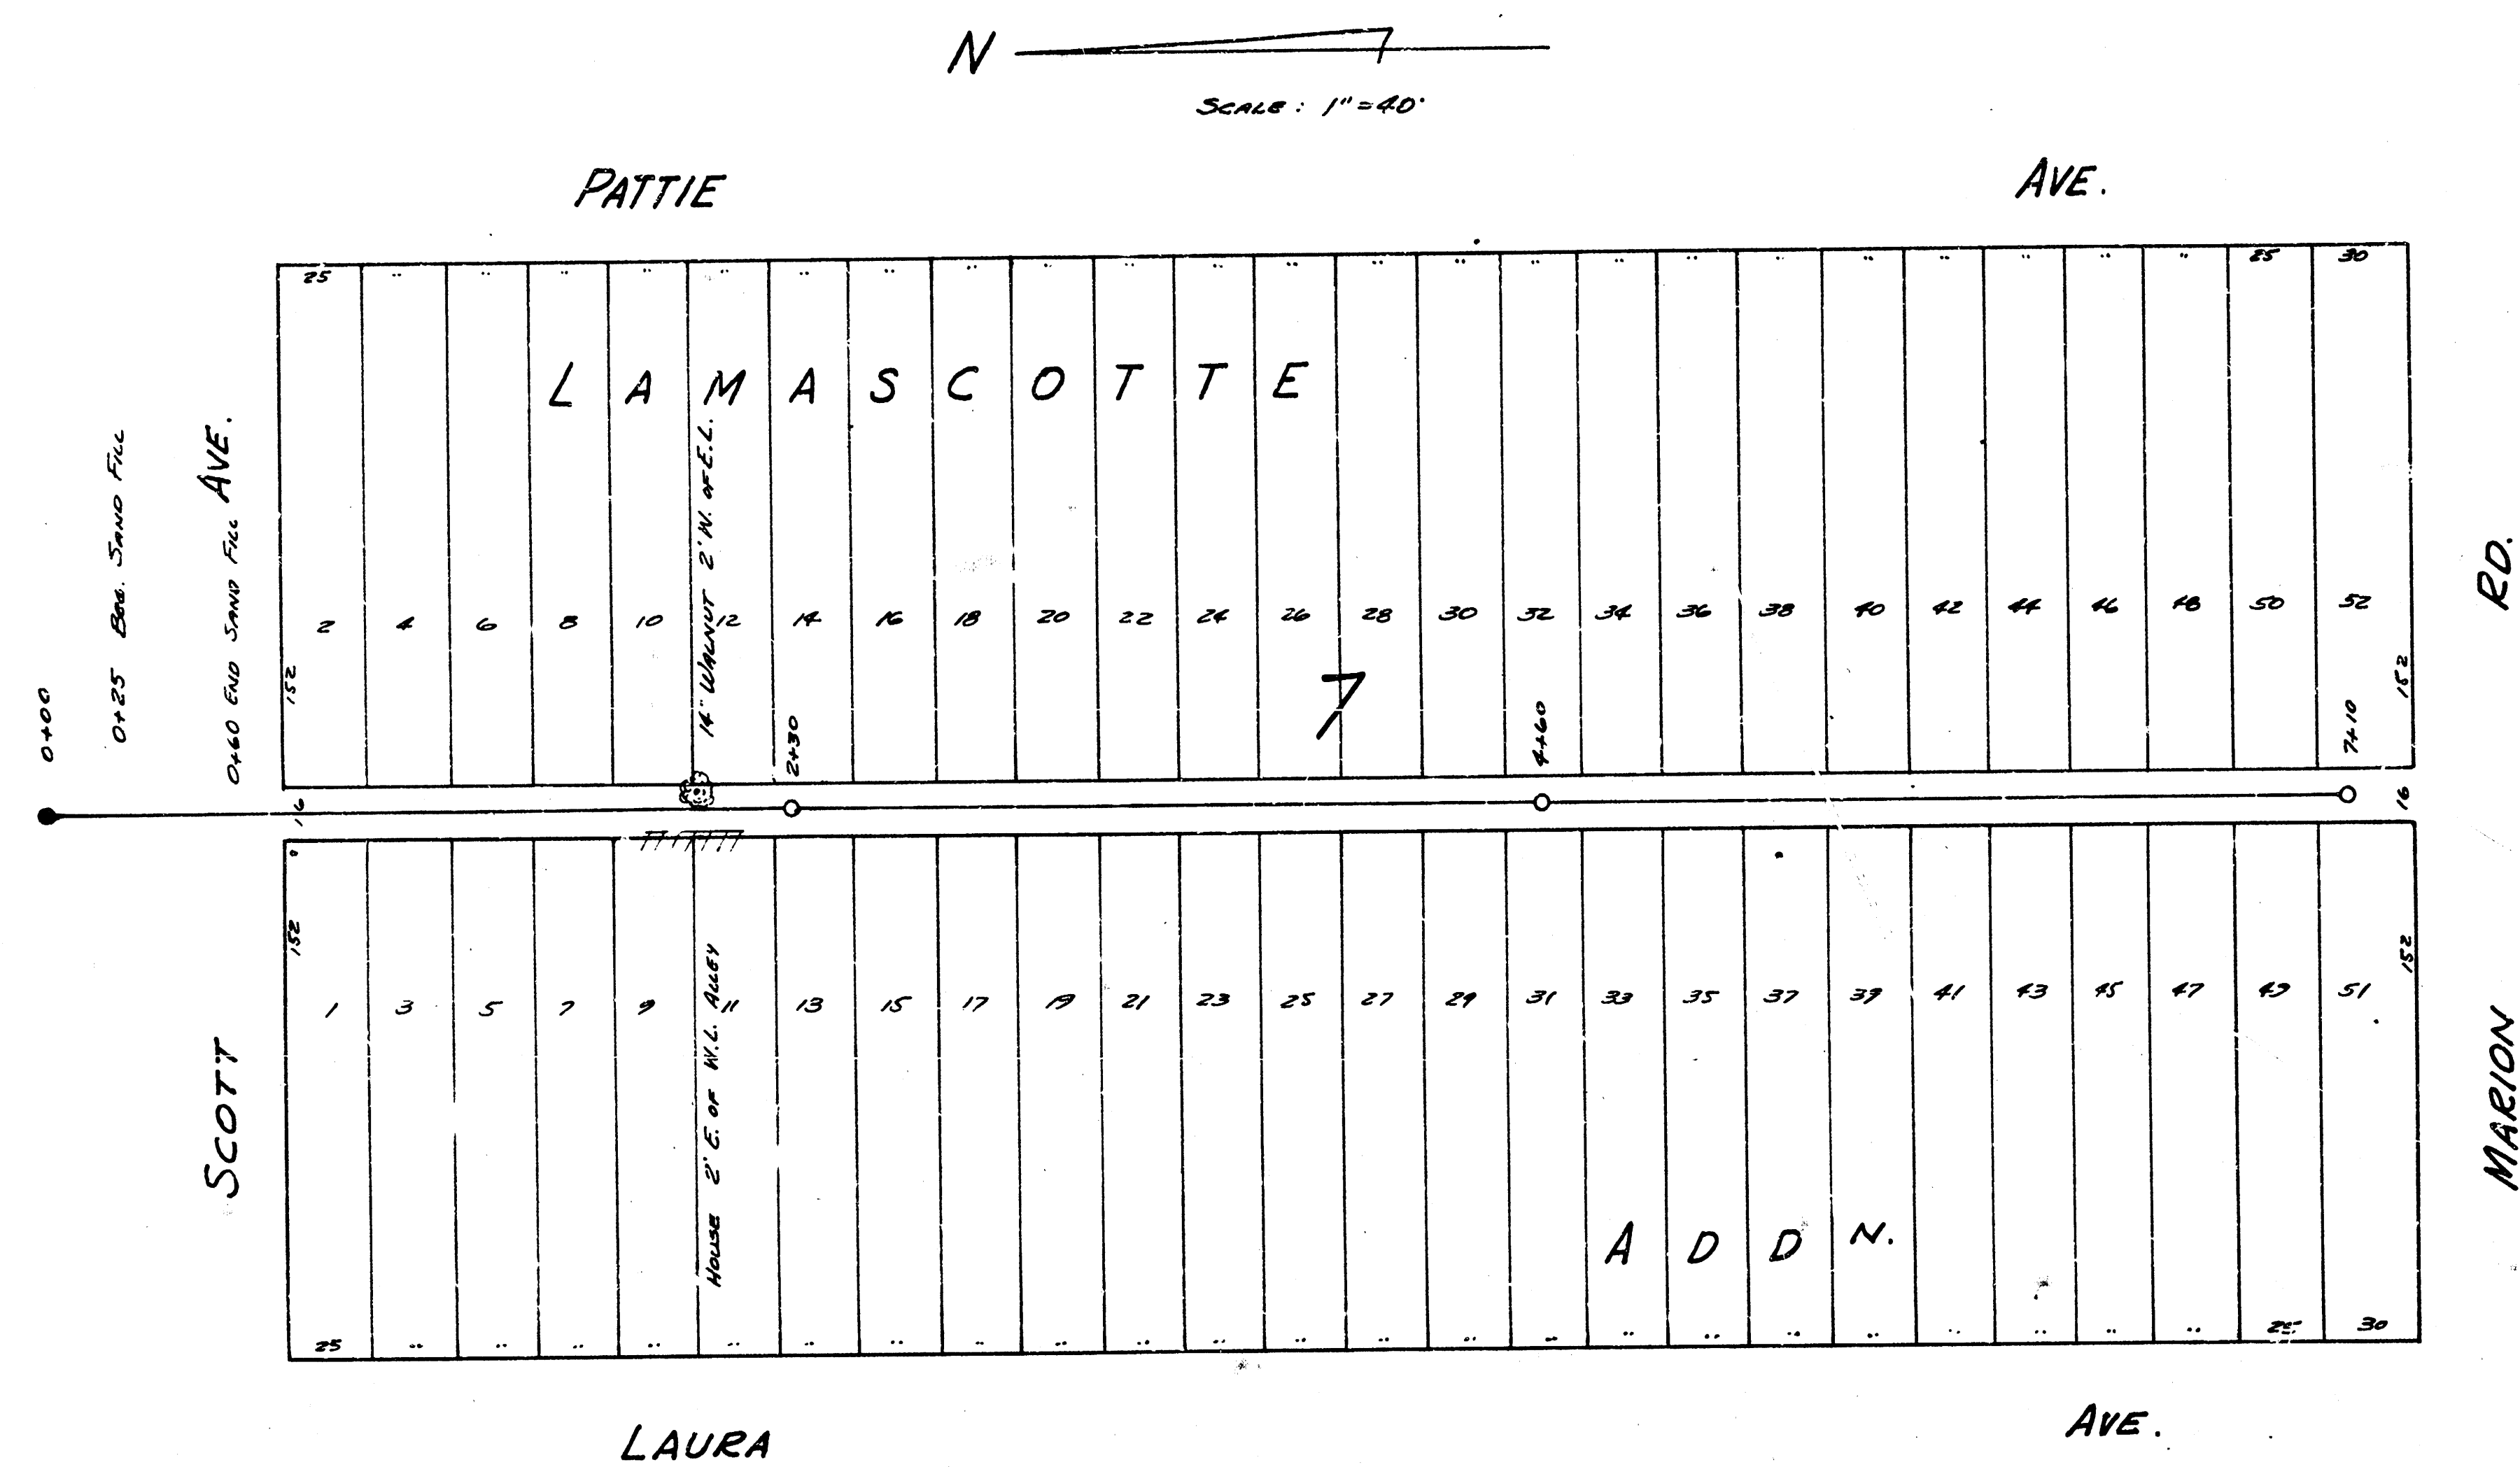