

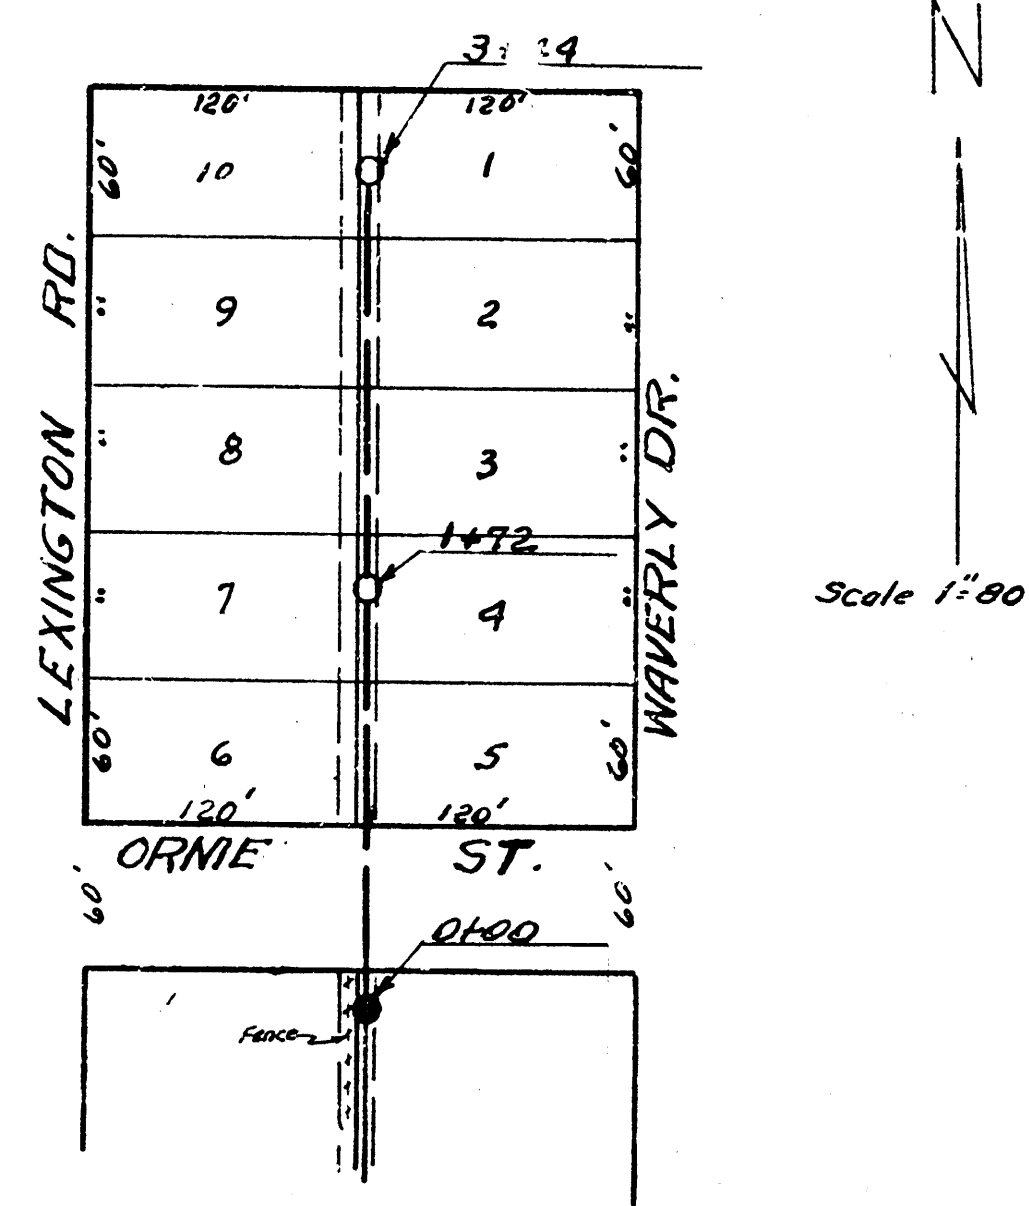
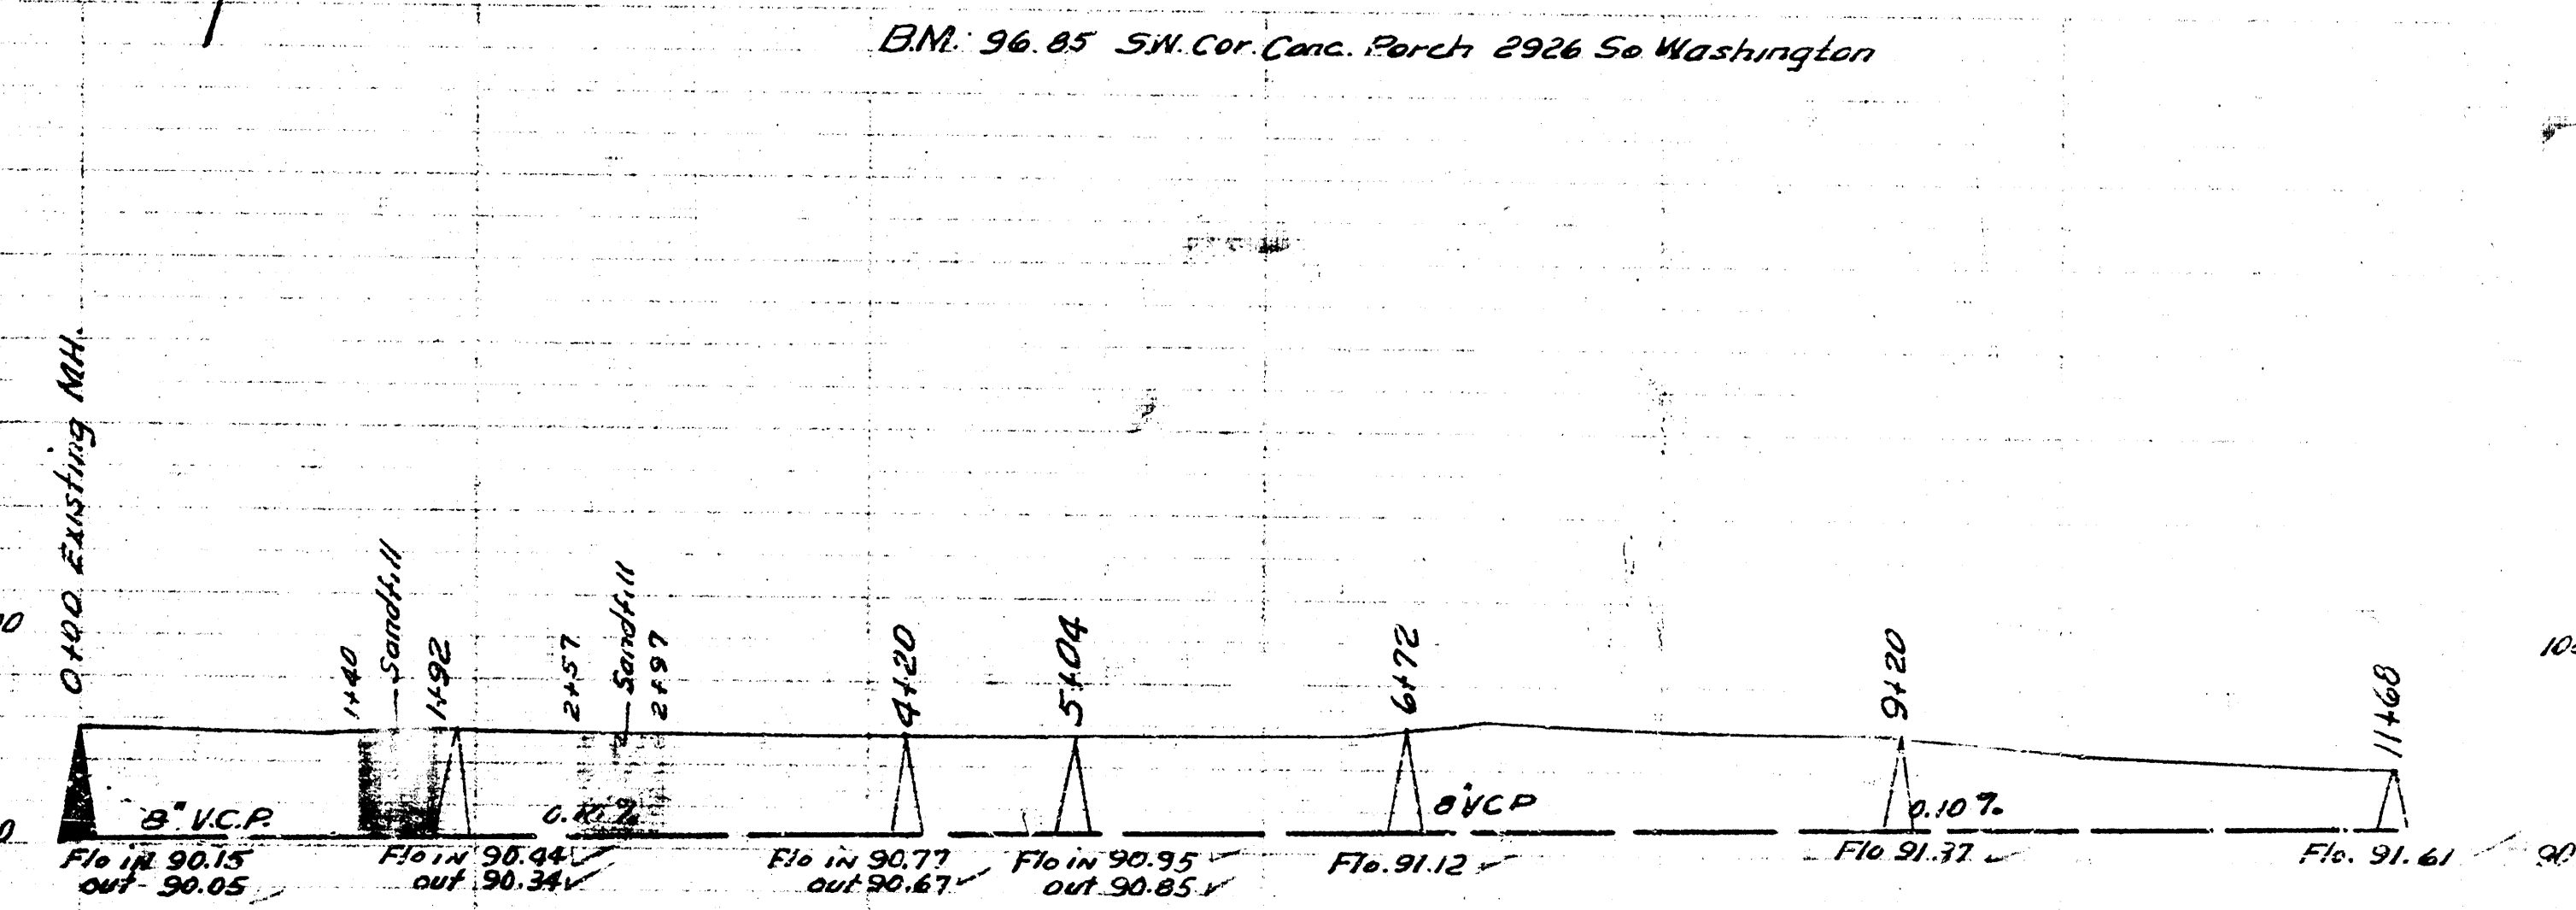


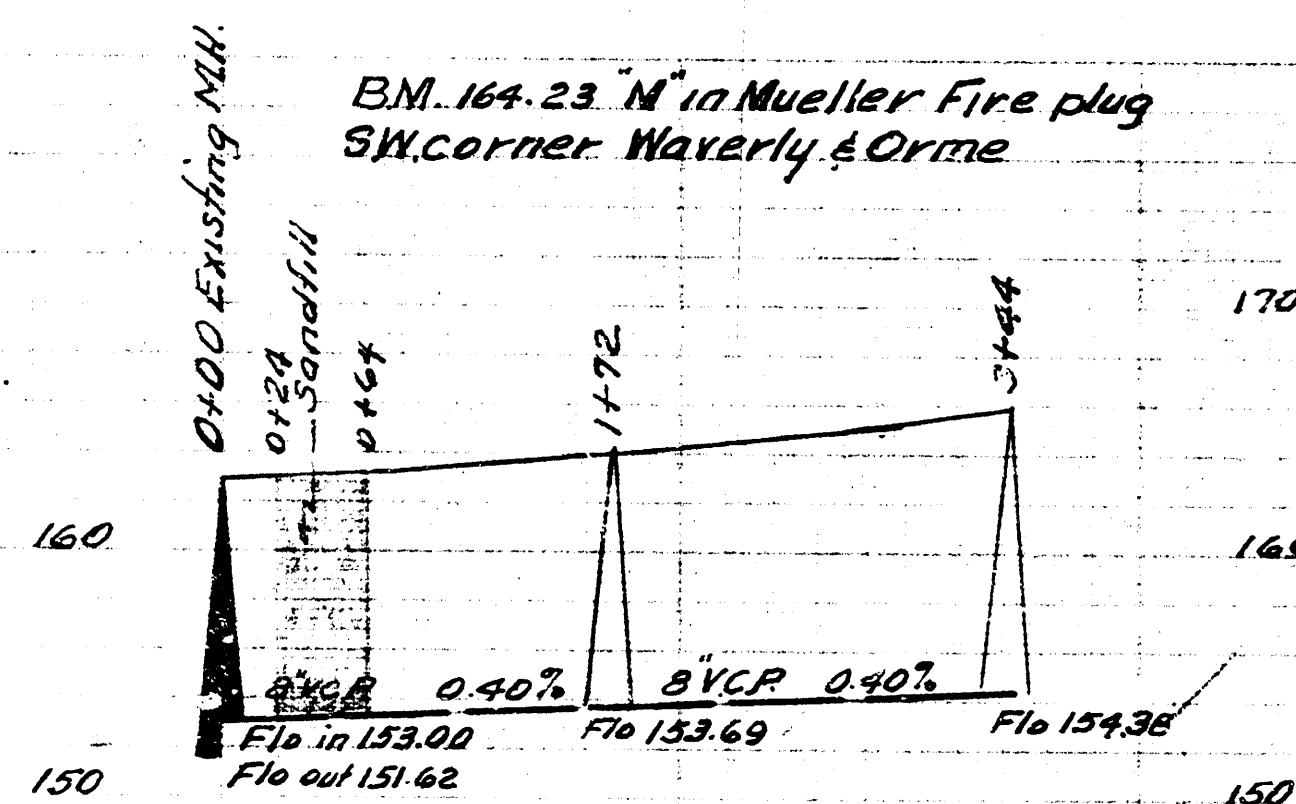

Note: An 8" VCP has been laid across Washington. Engineer to check all flow lines before setting grades.

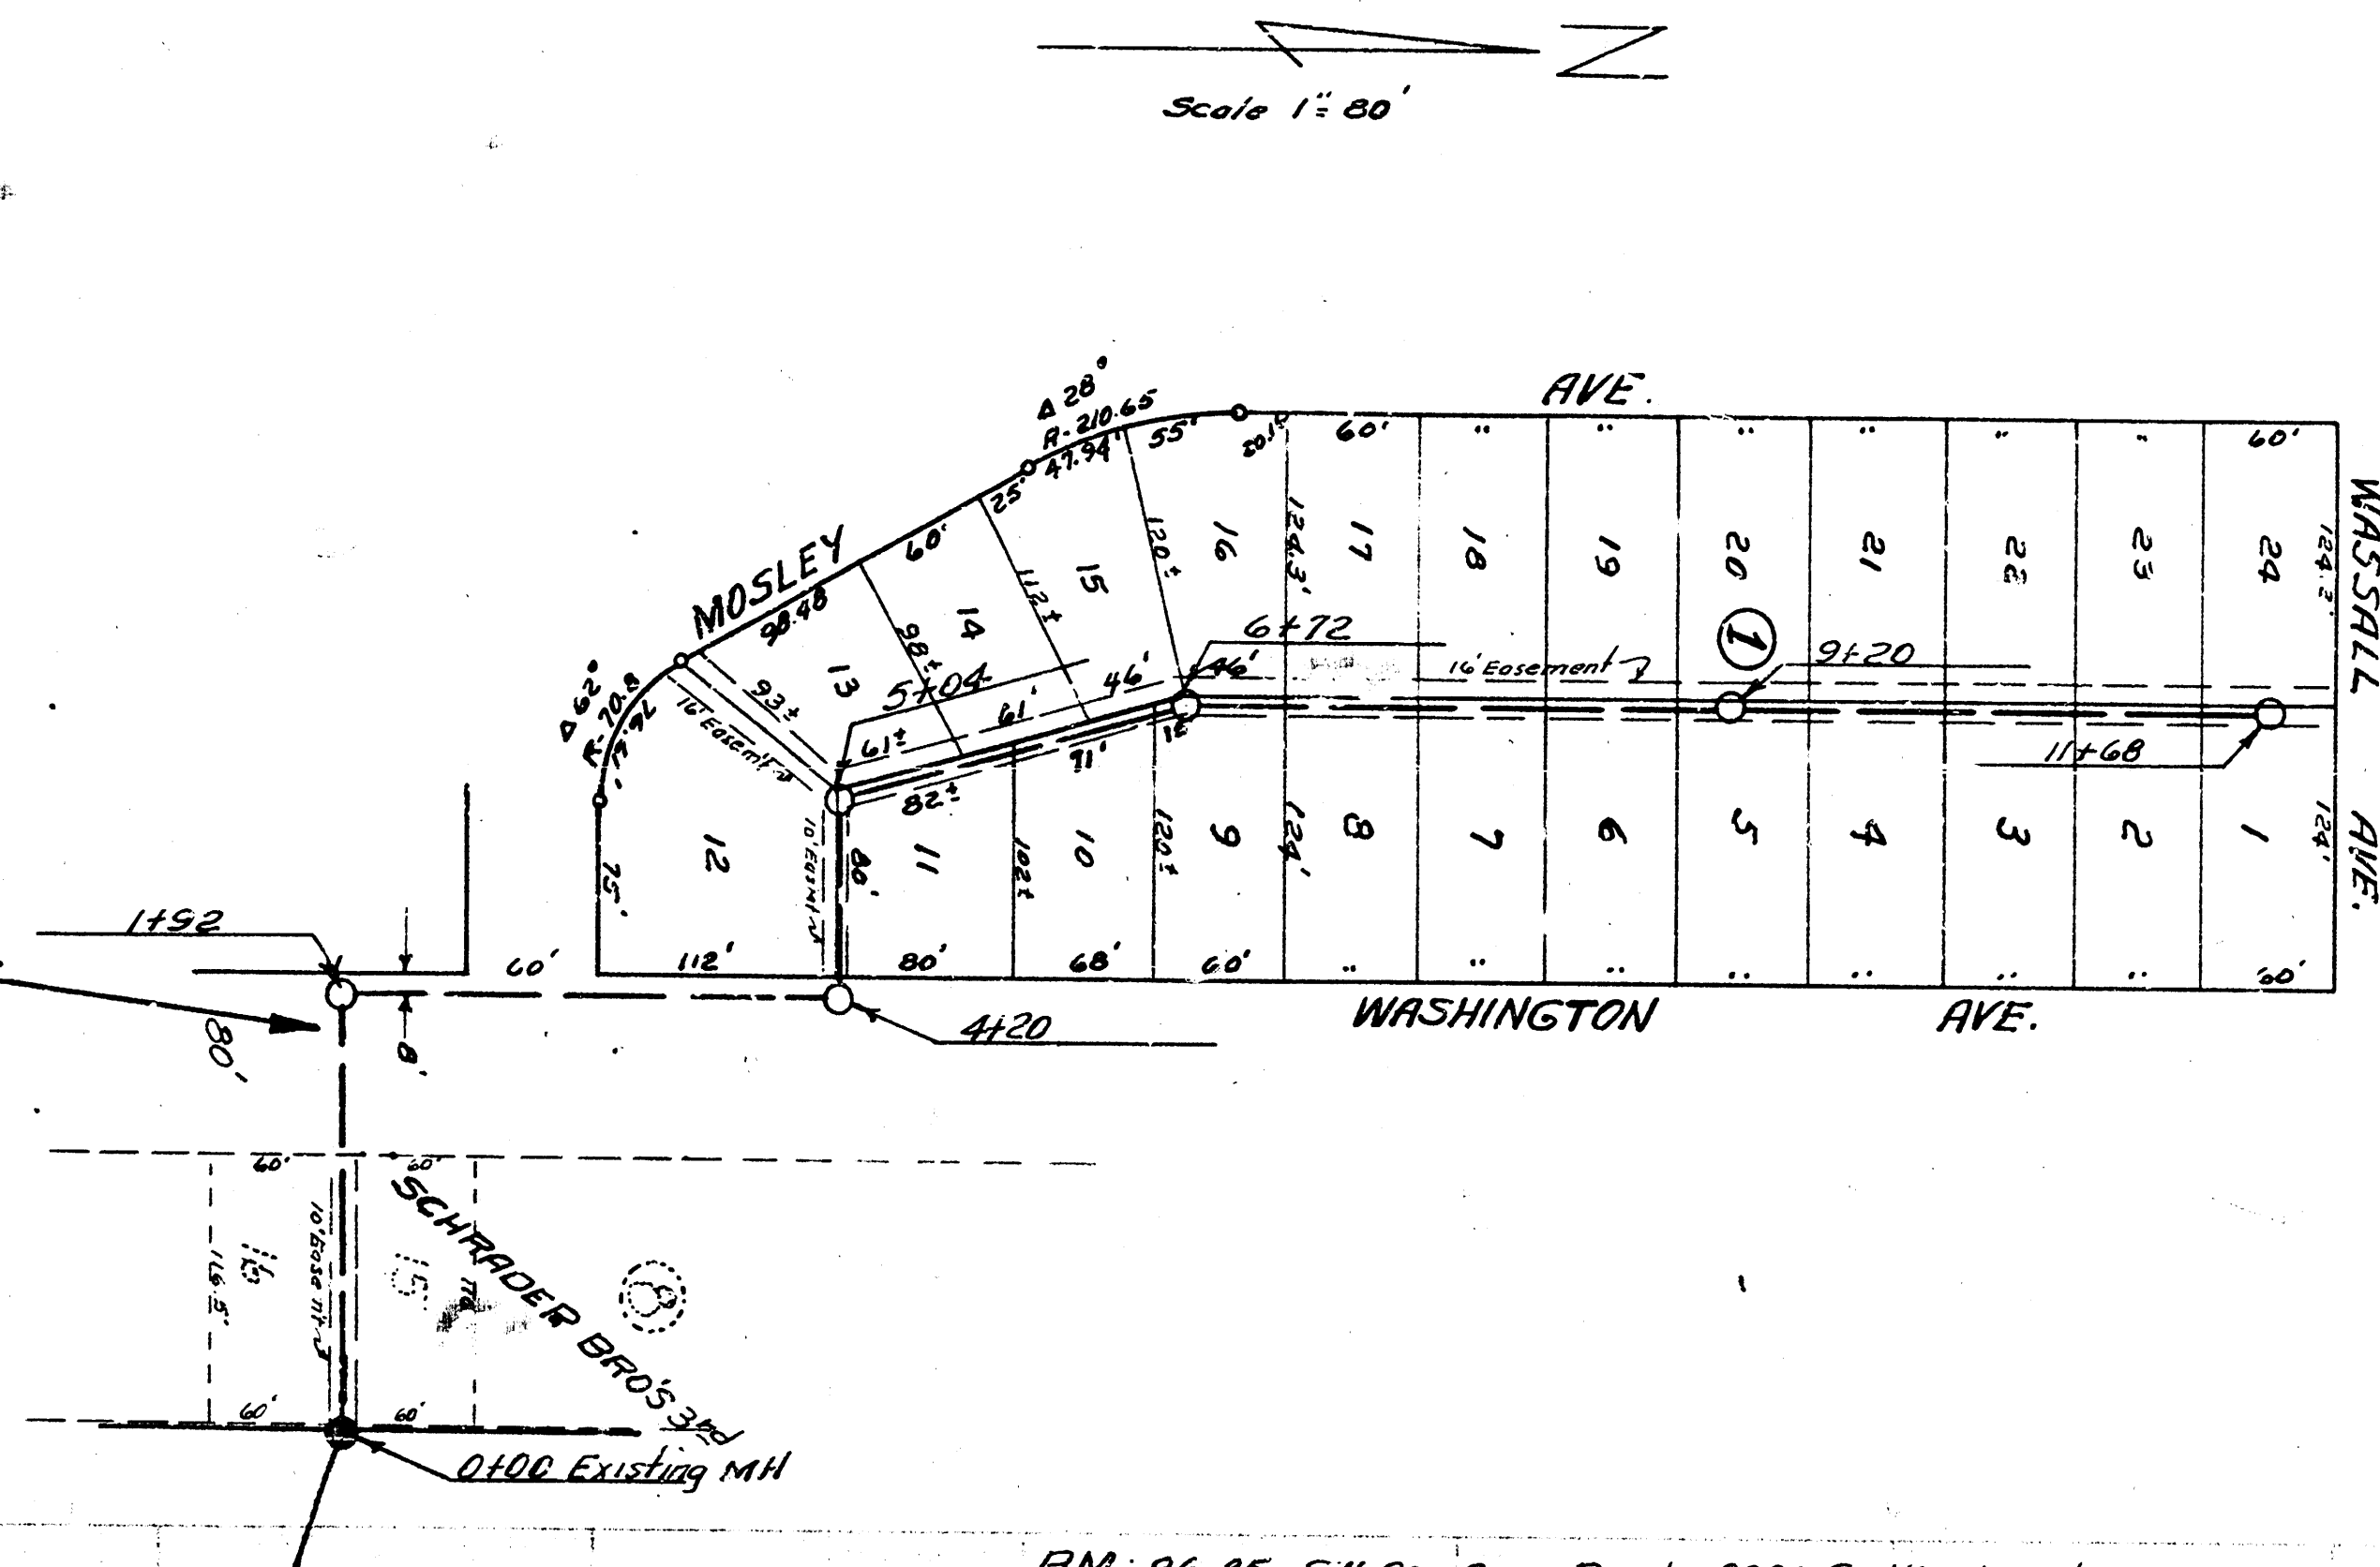

Note: All line with less than 30" of cover shall be encased.

LAT. 12 SUB. 3, W.15.
CITY OF WICHITA, KANSAS
B.F. SMITH CITY ENGINEER
Proj. No. C-23-15

LAT. 20, DIST. A 55.20
CITY OF WICHITA, KANSAS
B.F. SMITH CITY ENGINEER
Proj. No. C-23-16