



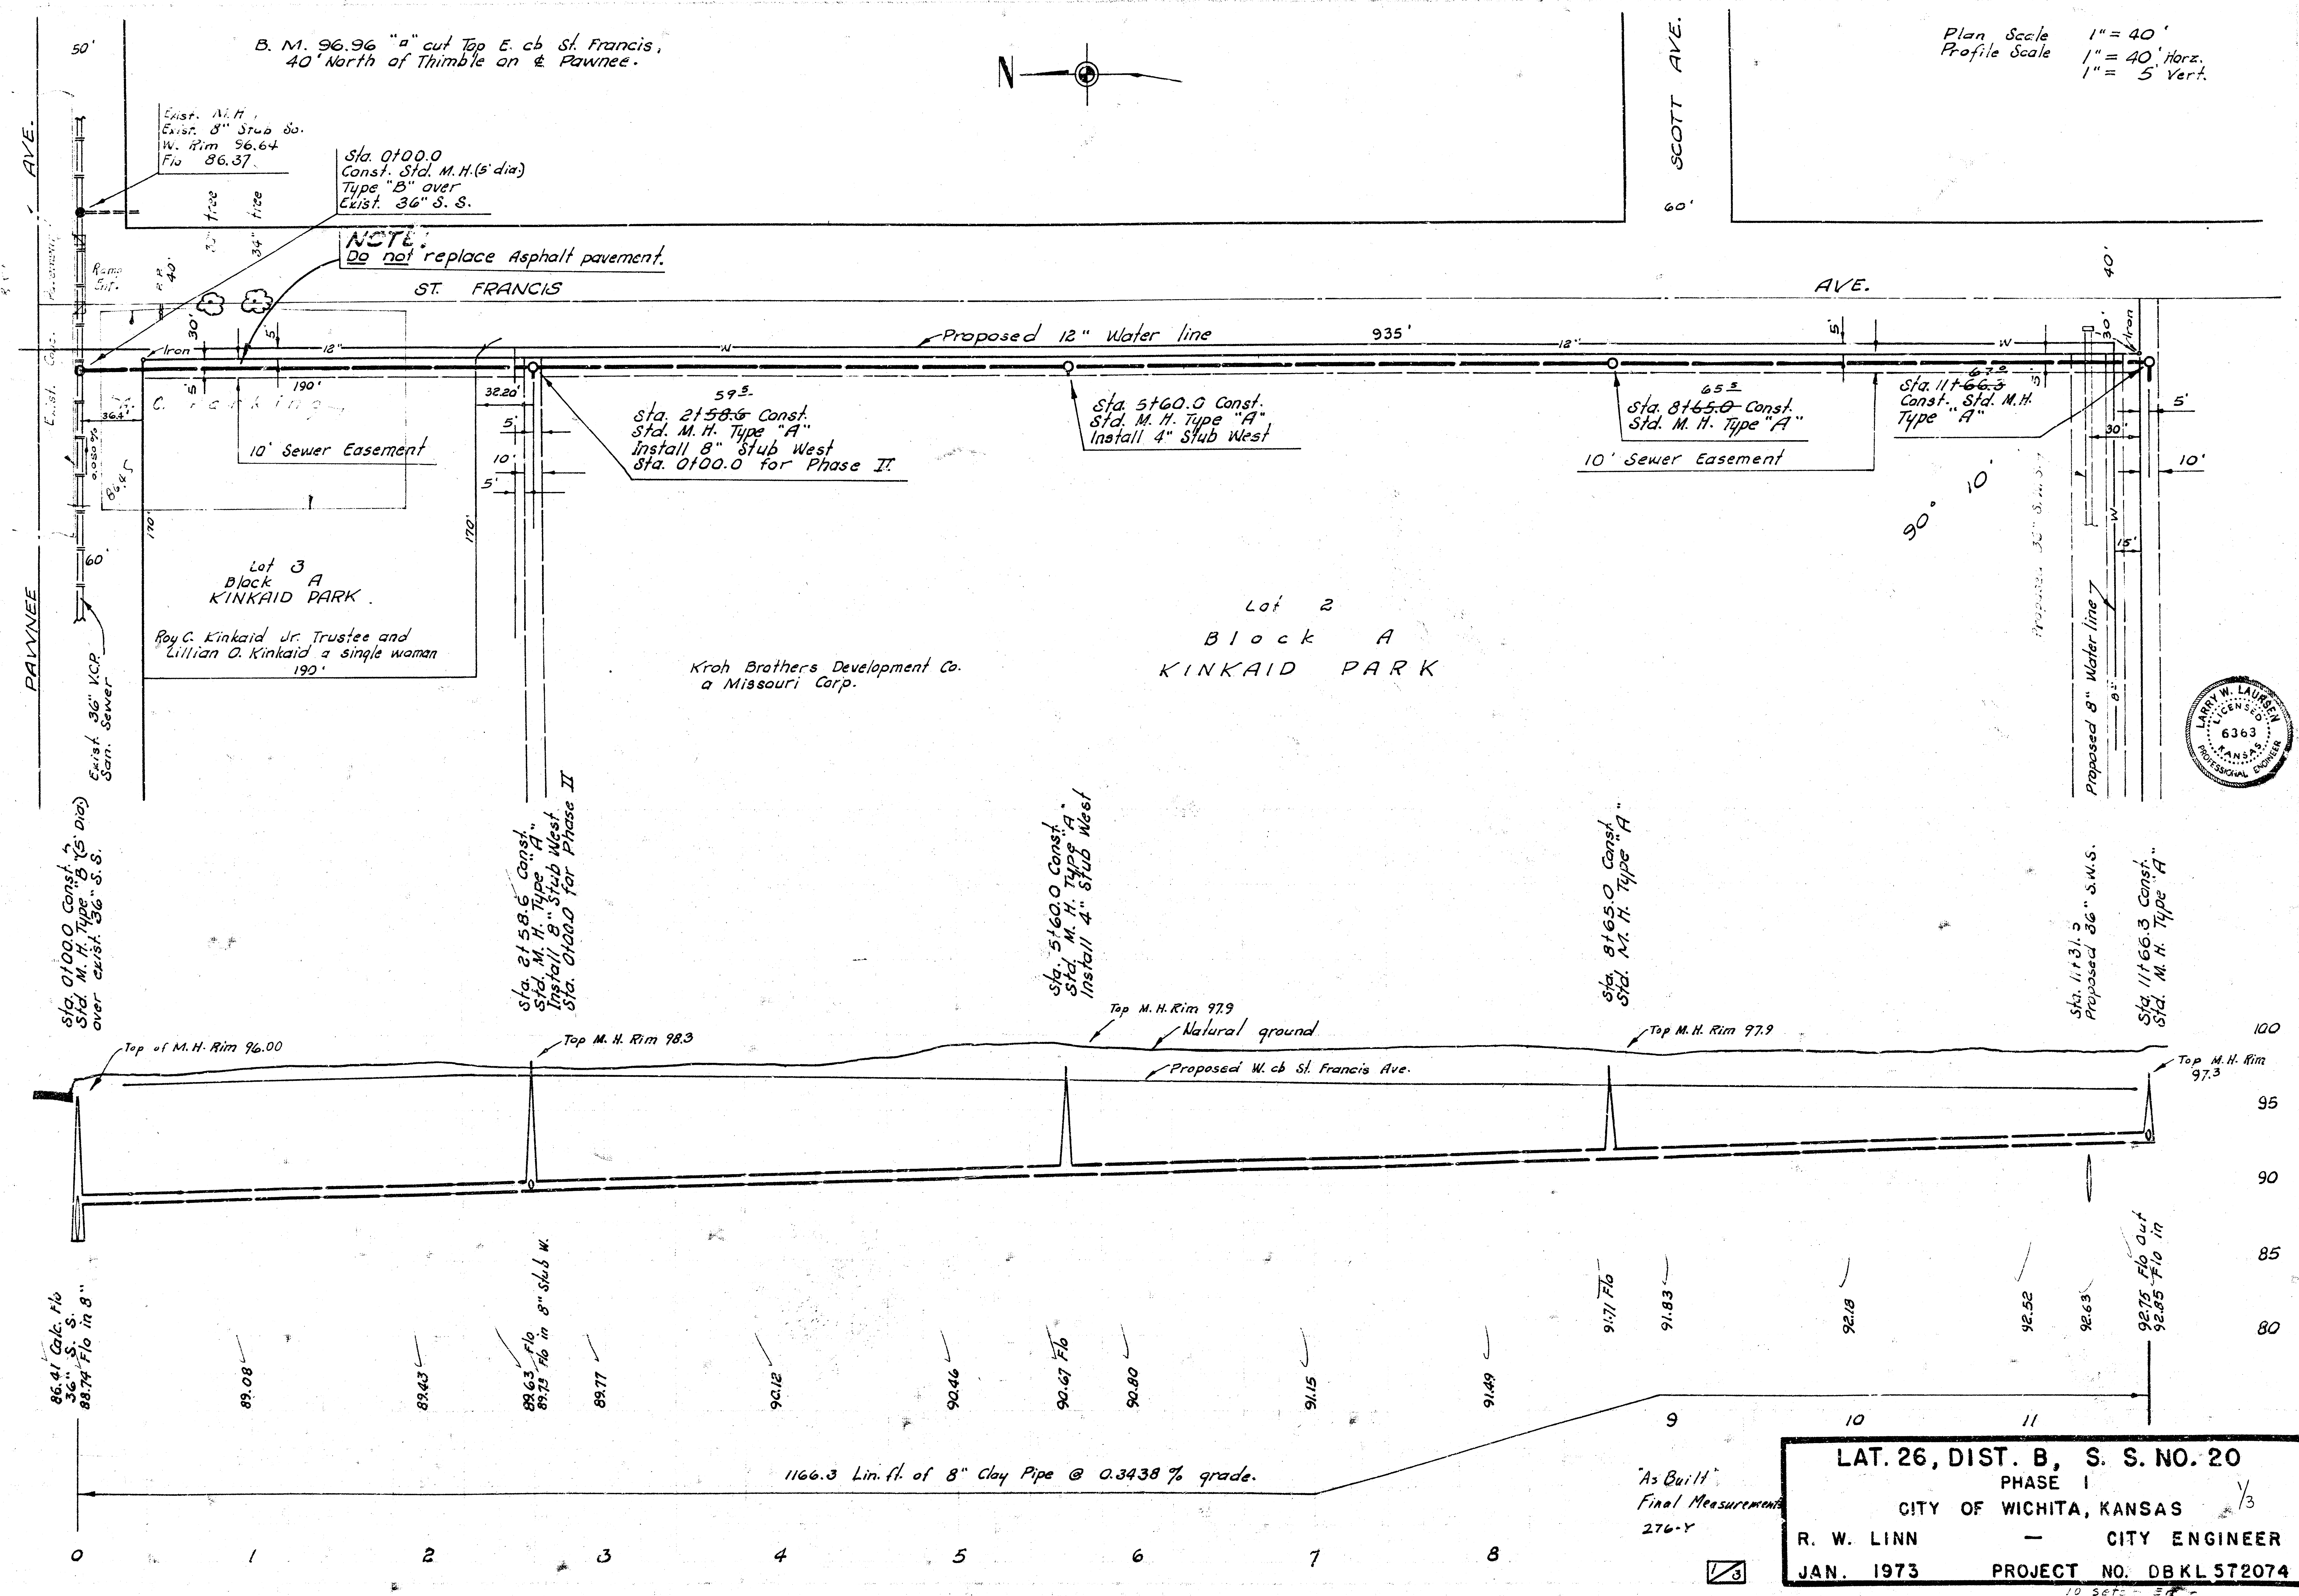

LAT. 26, DIST. B, S. S. NO. 20
PHASE I
CITY OF WICHITA, KANSAS
R. W. LINN — CITY ENGINEER
JAN. 1973 PROJECT NO. DBKL 572074

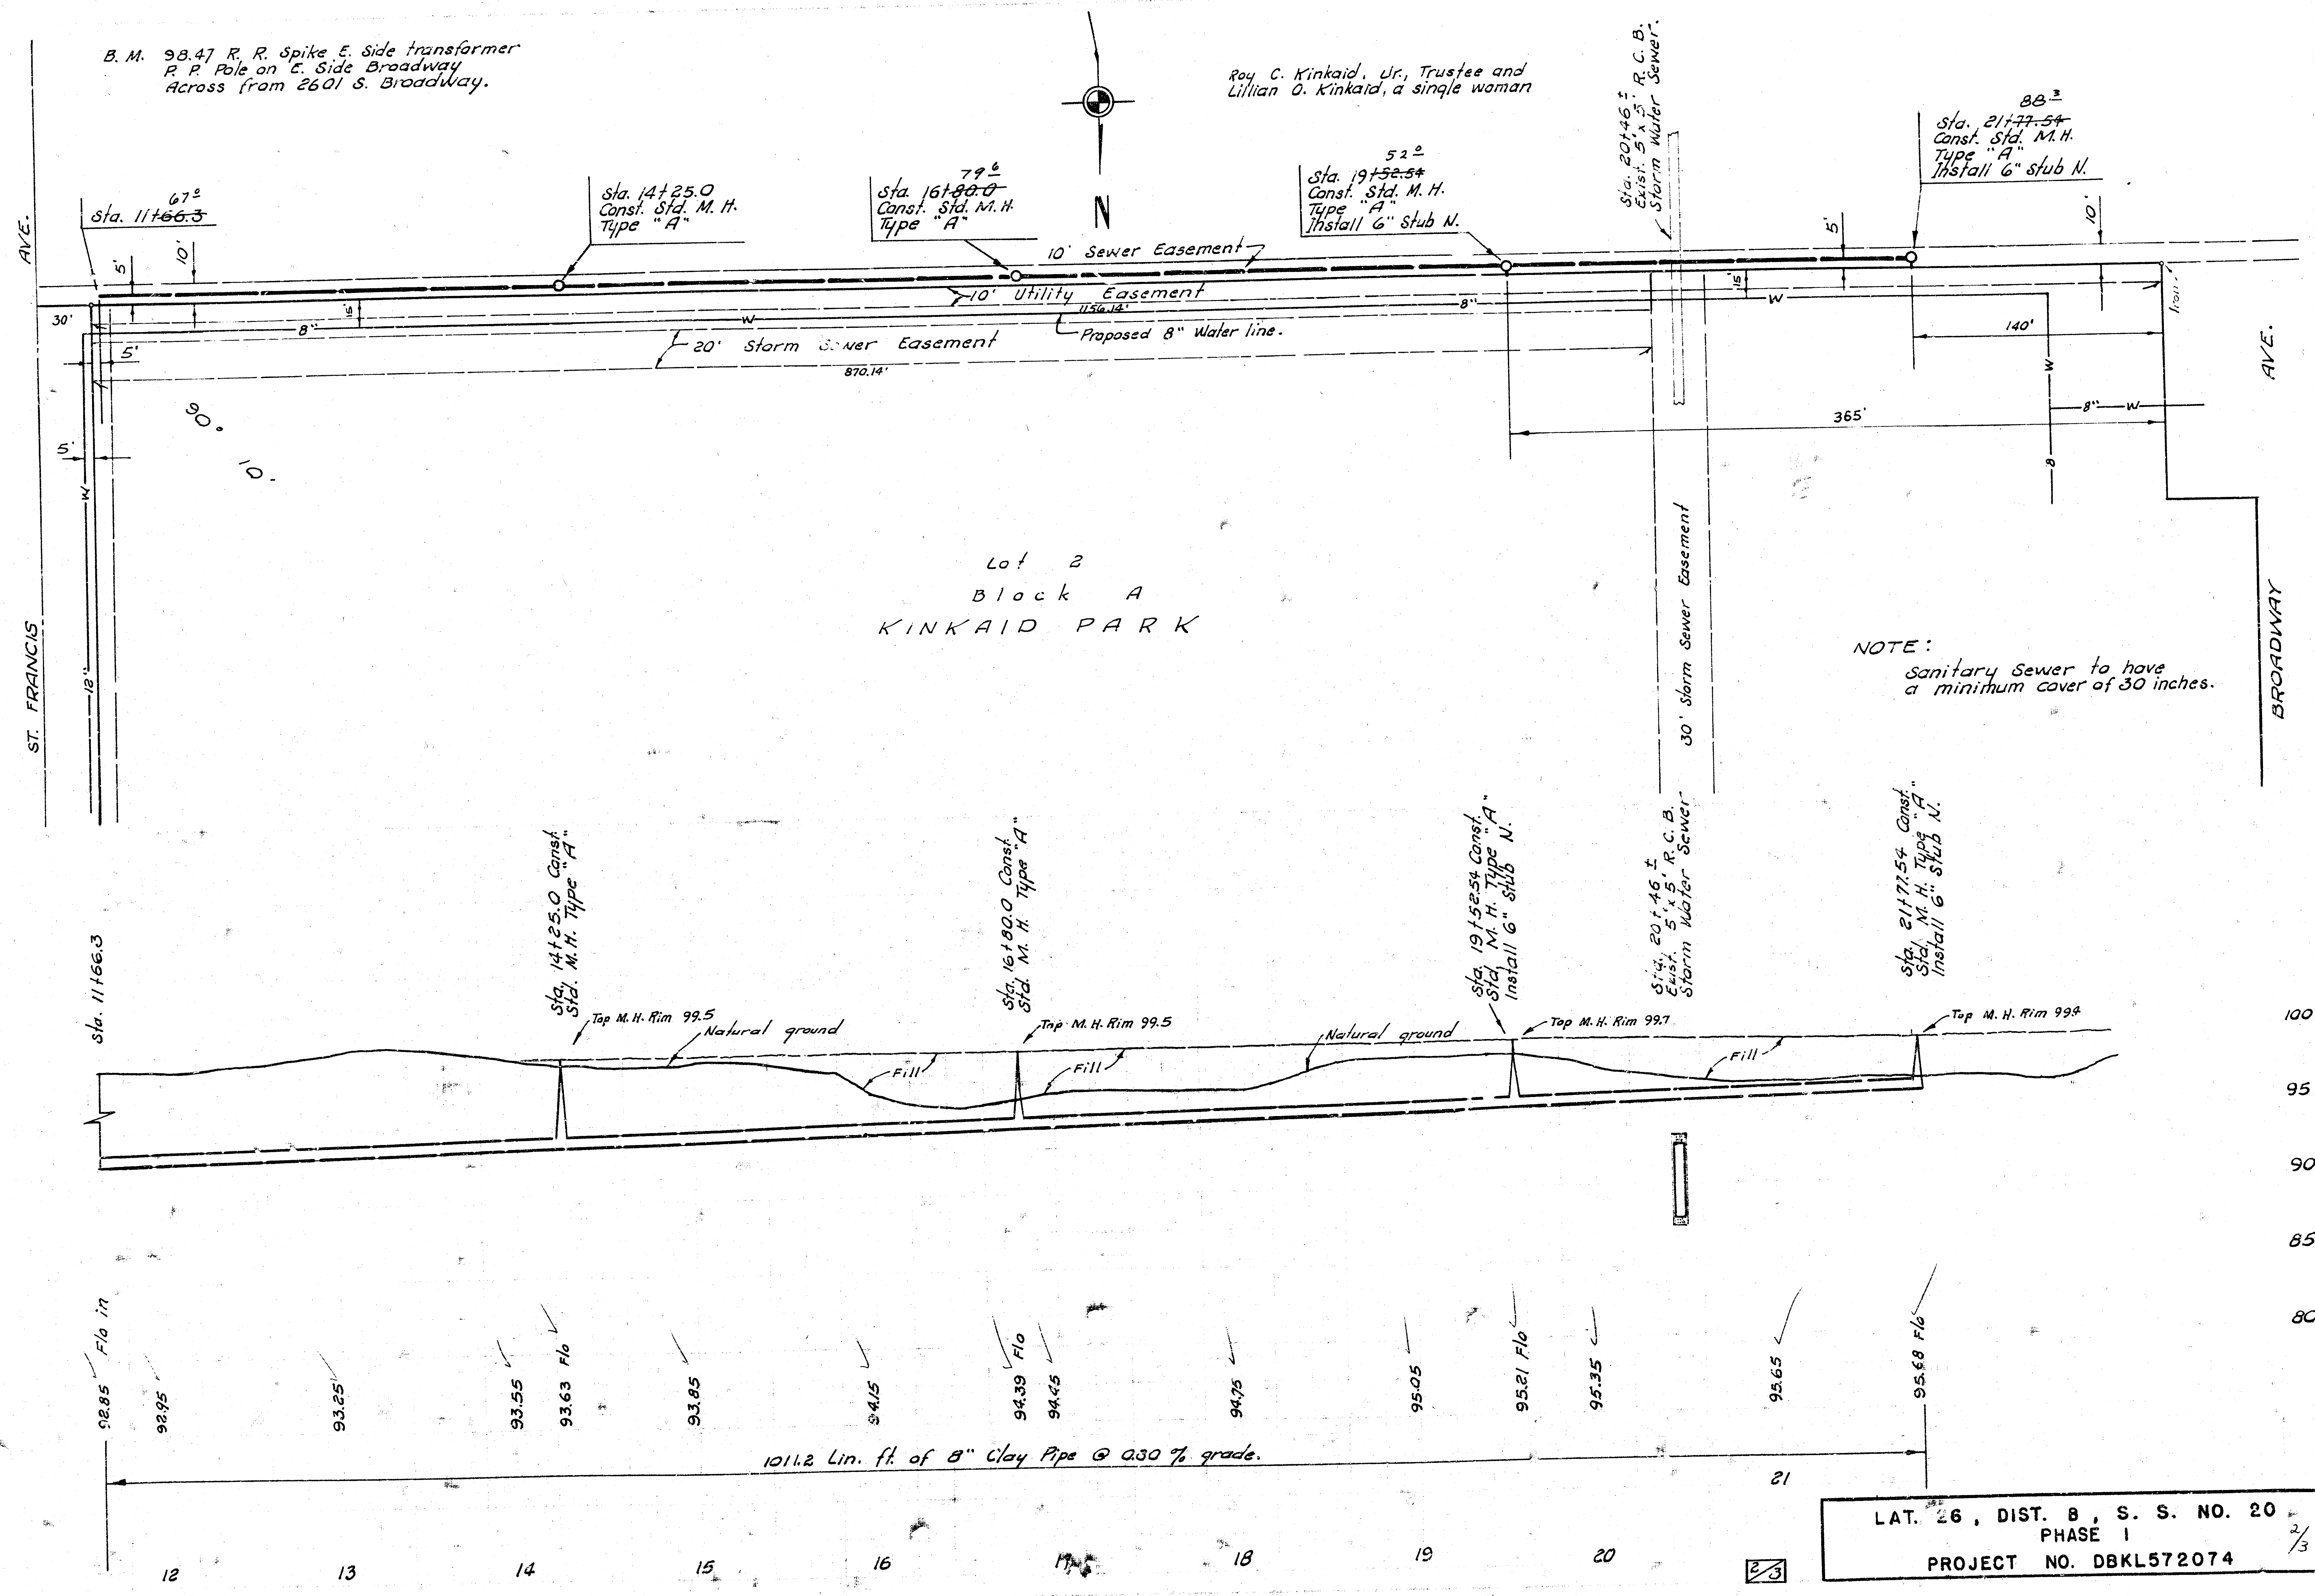

J. F. G.
J. R. W.

205

