

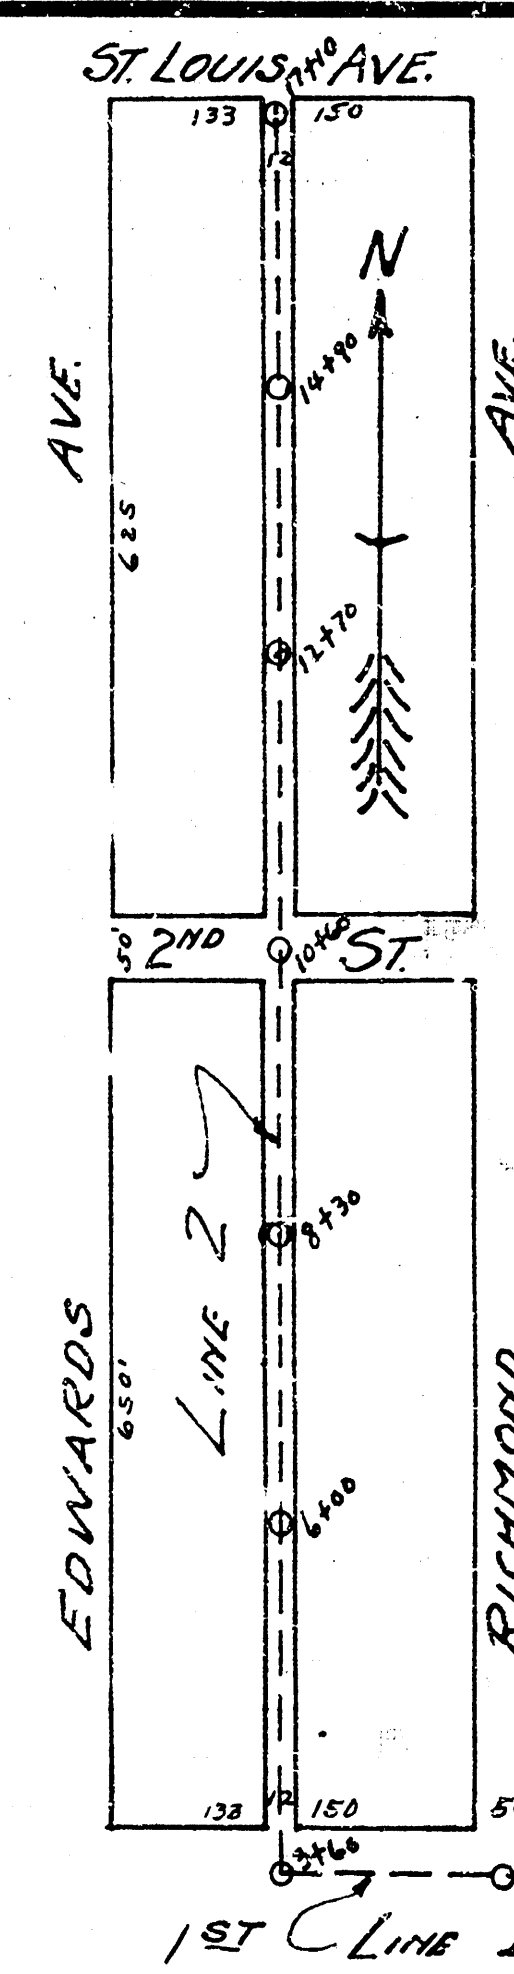
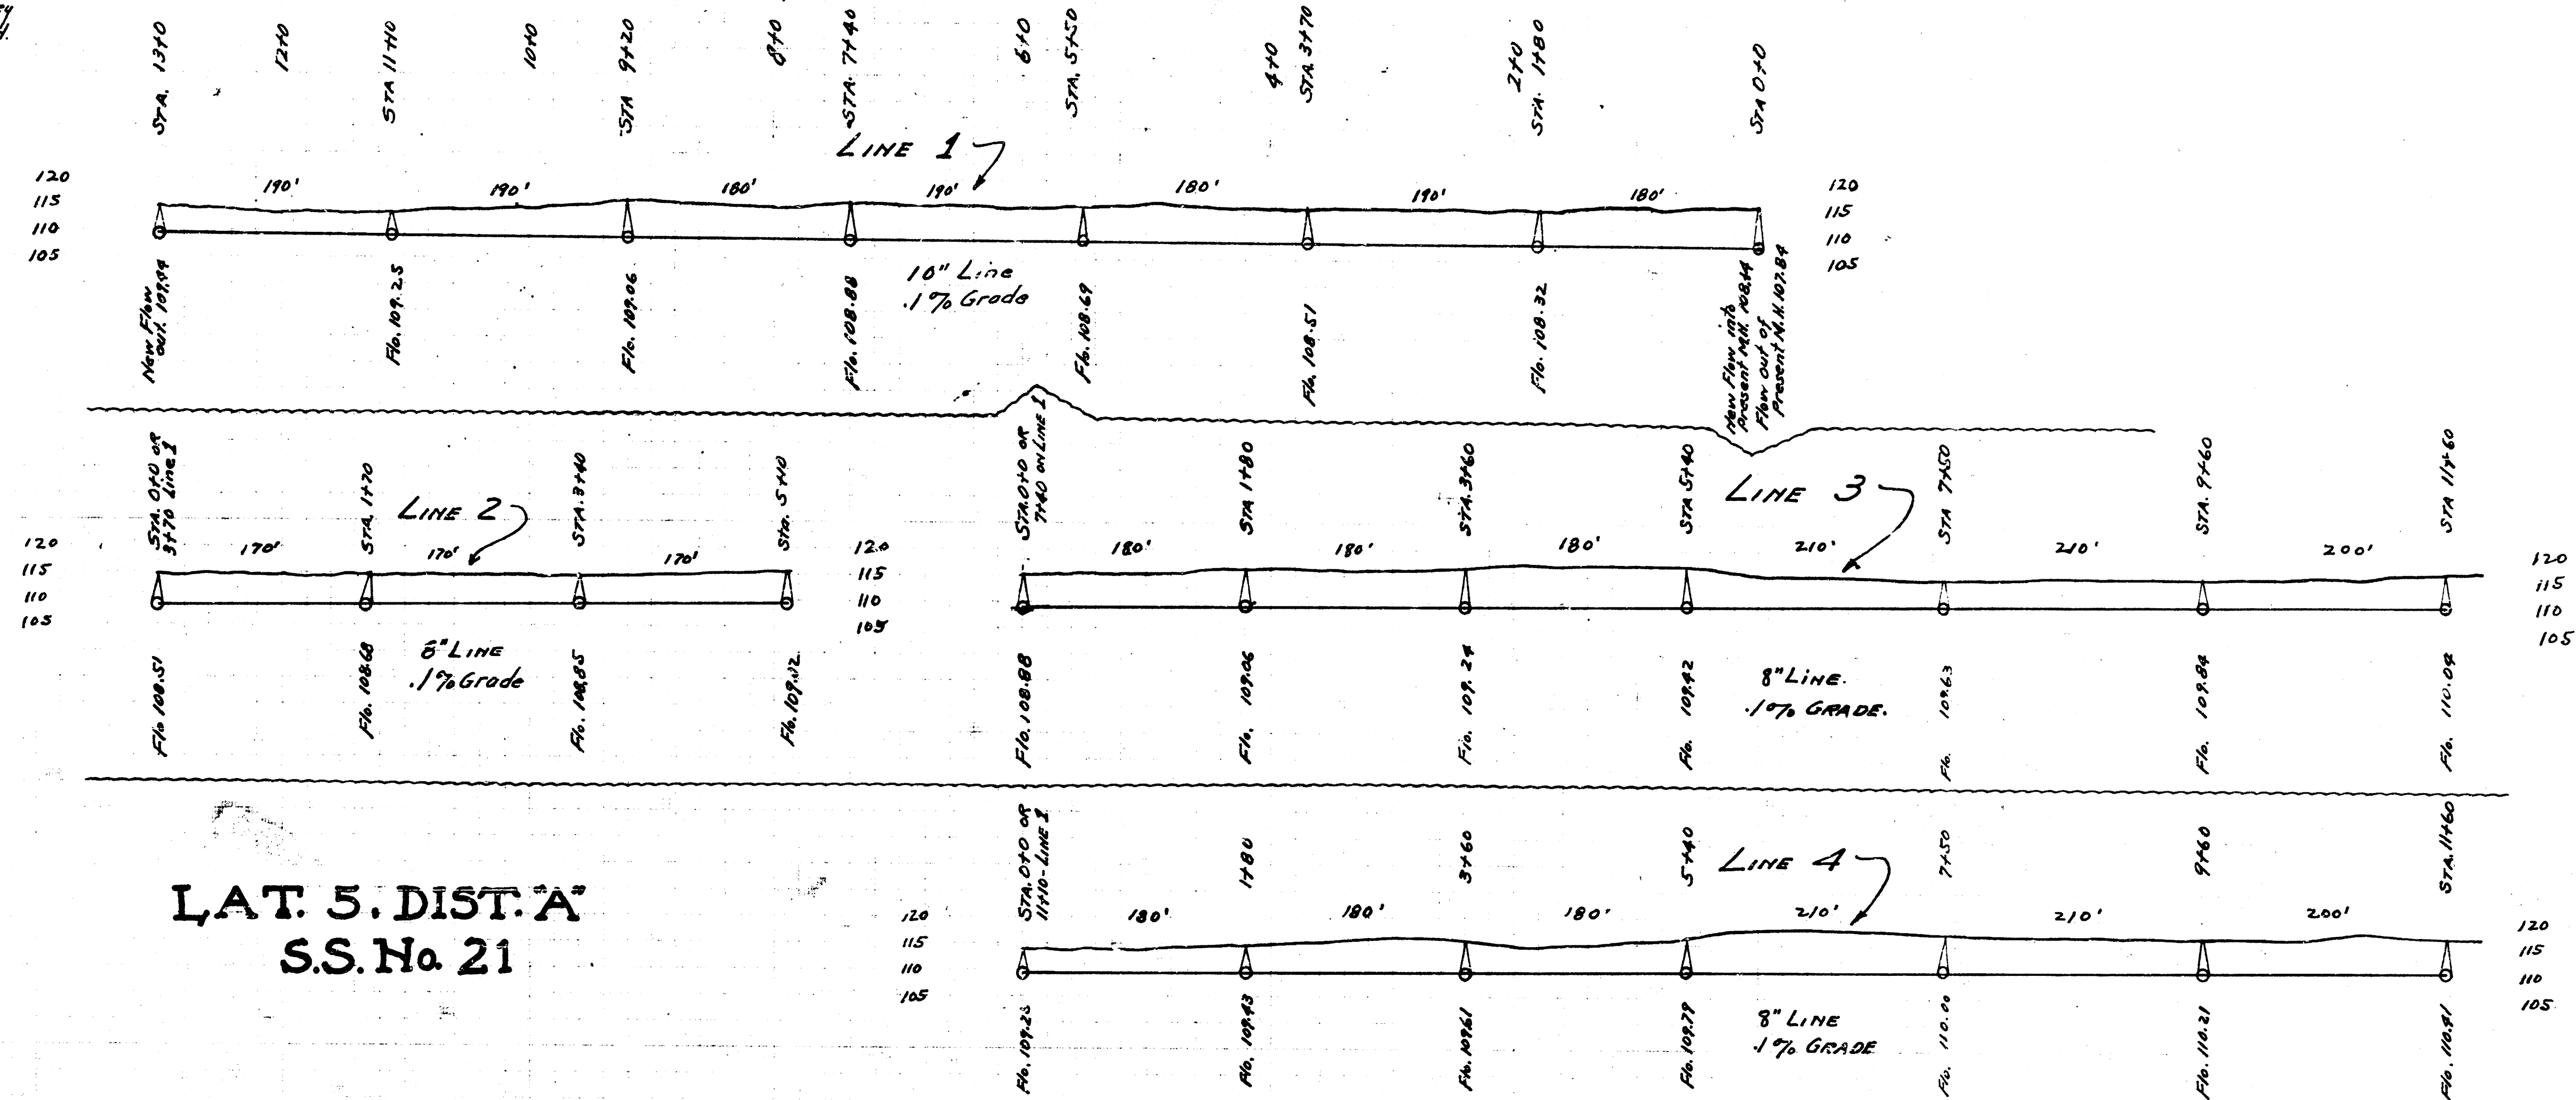


B.M. 114.86 "K" in Kensler in ctr. wk. N.S. of Alley
N. of Douglas - W.S. of Richmond.

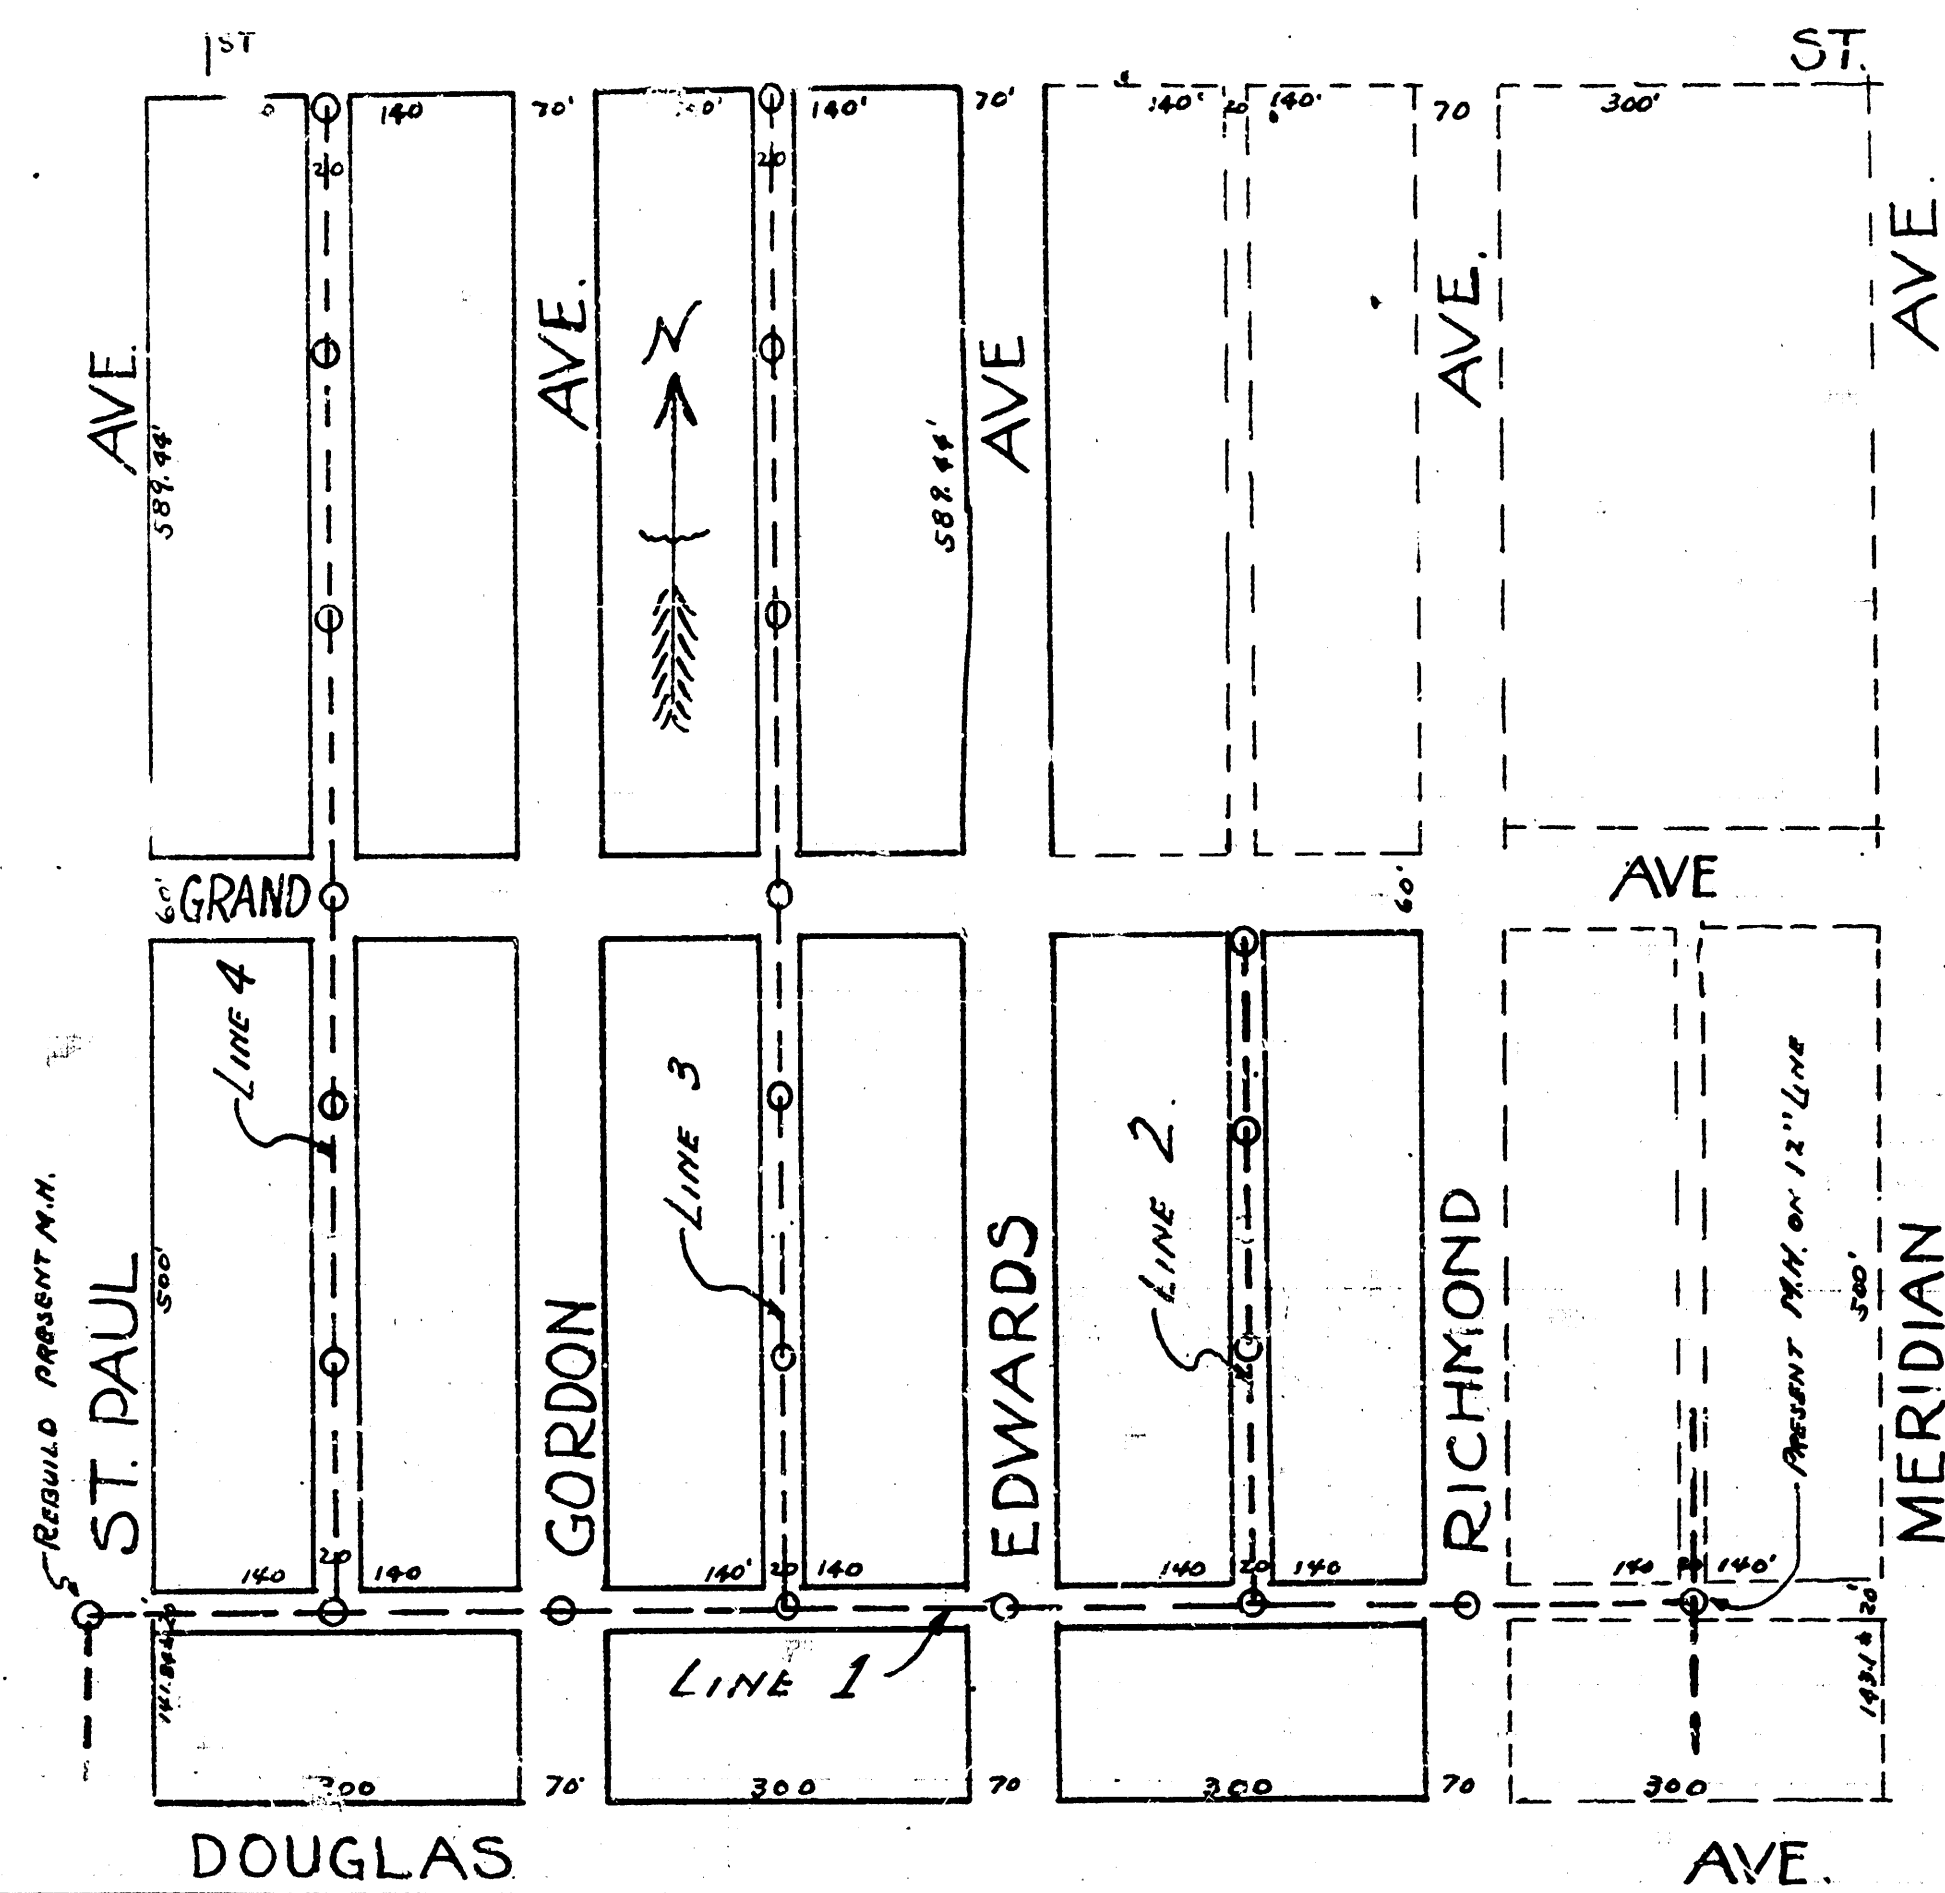



B.M. 116.21 Std.
N.E. cor. Meridian & 1st.

**LAT. 4.,
DIST. A.,
S.S. No. 21**

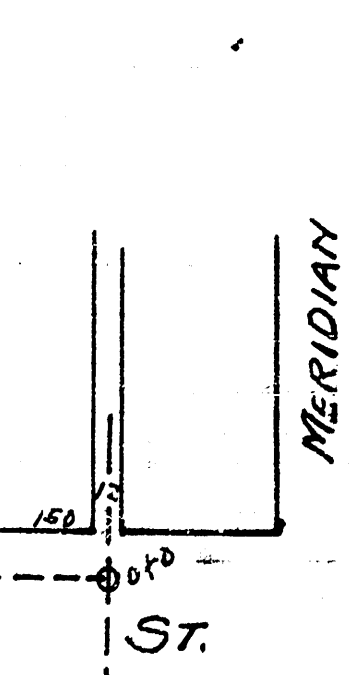


B.M. 102.35 "X" in Kensler
N.E. of W. H., N.W. Water & Clark.

**LAT. 13.,
DIST. C,
S.S. No. 20.**

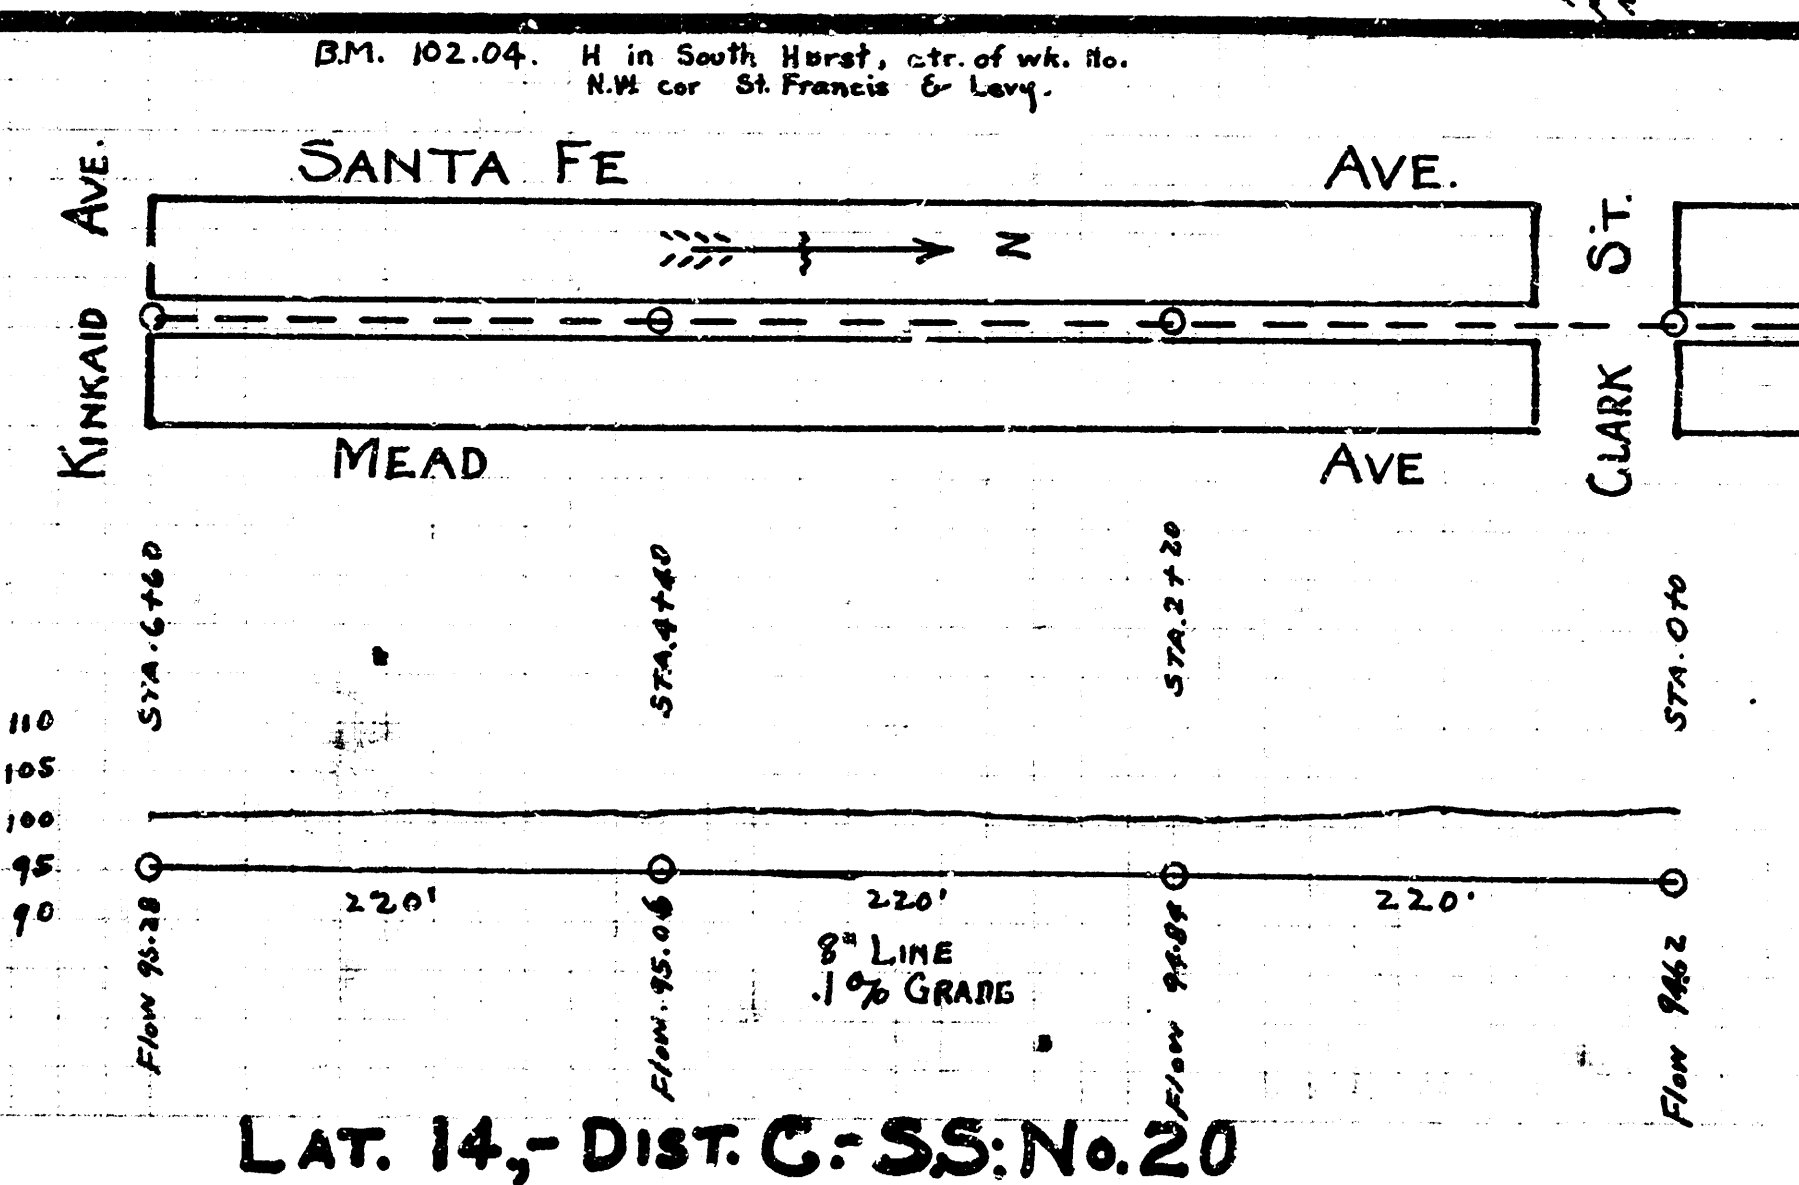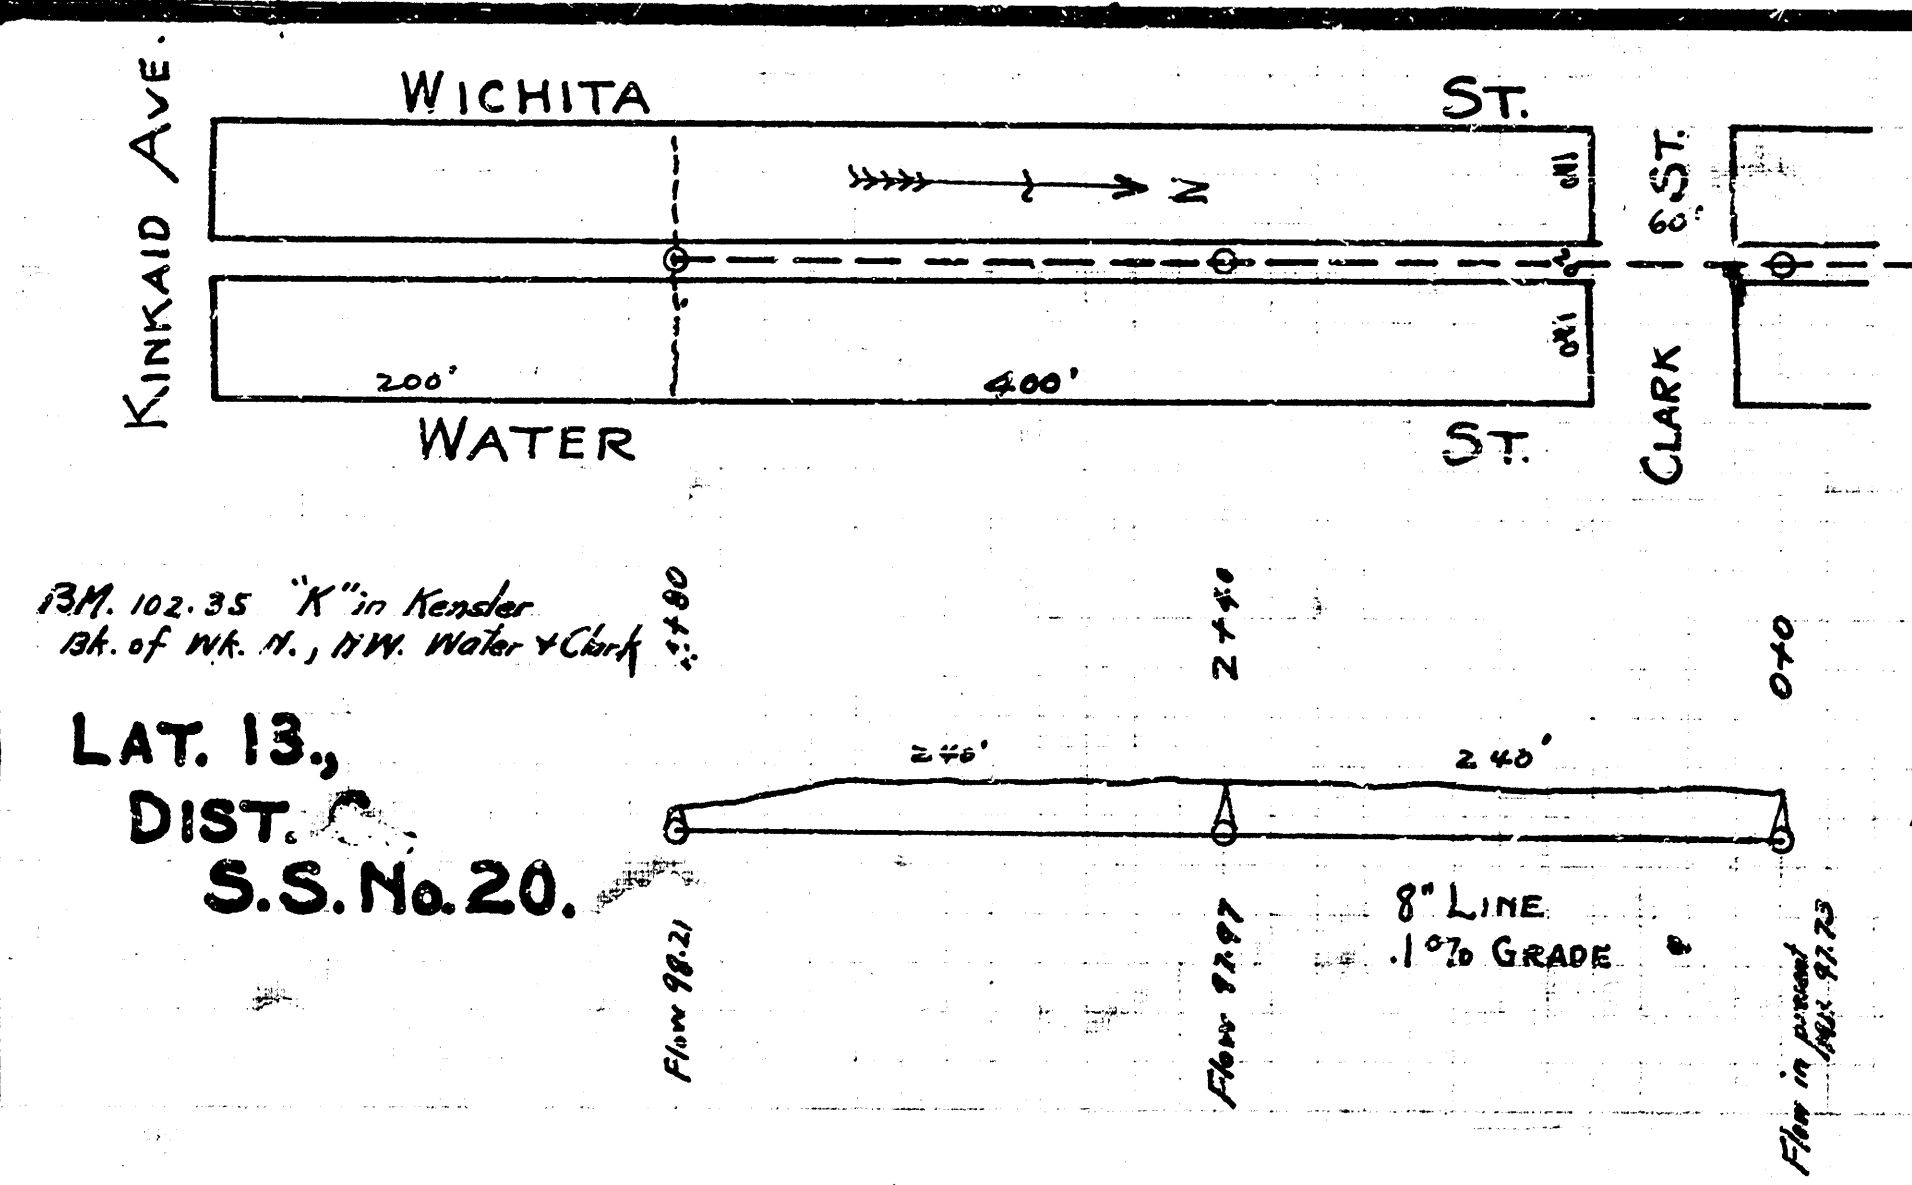


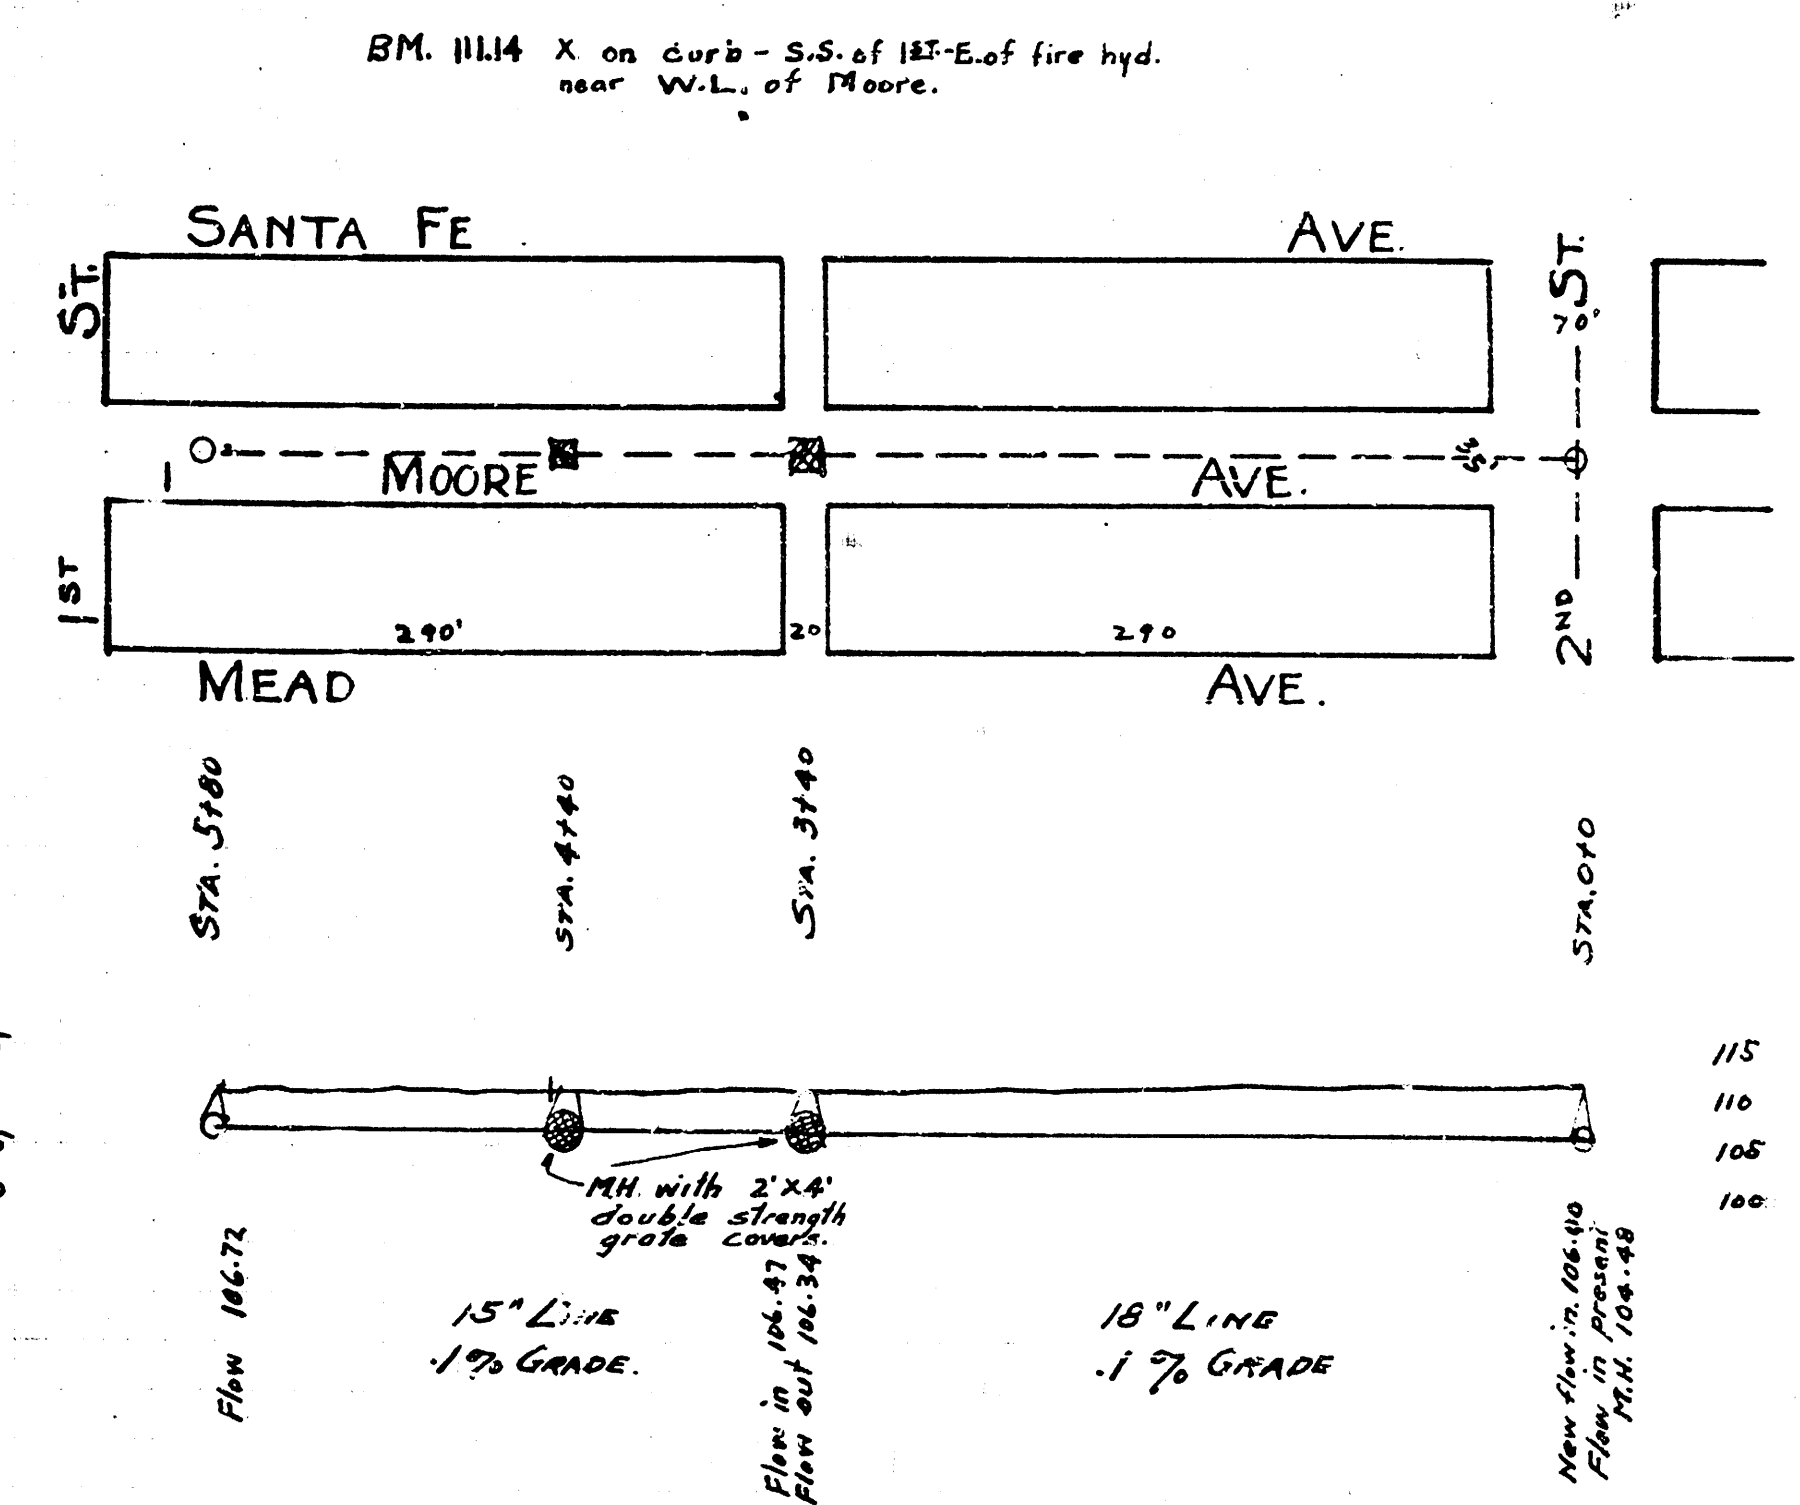

LAT. B - S.W.S. No. 5