

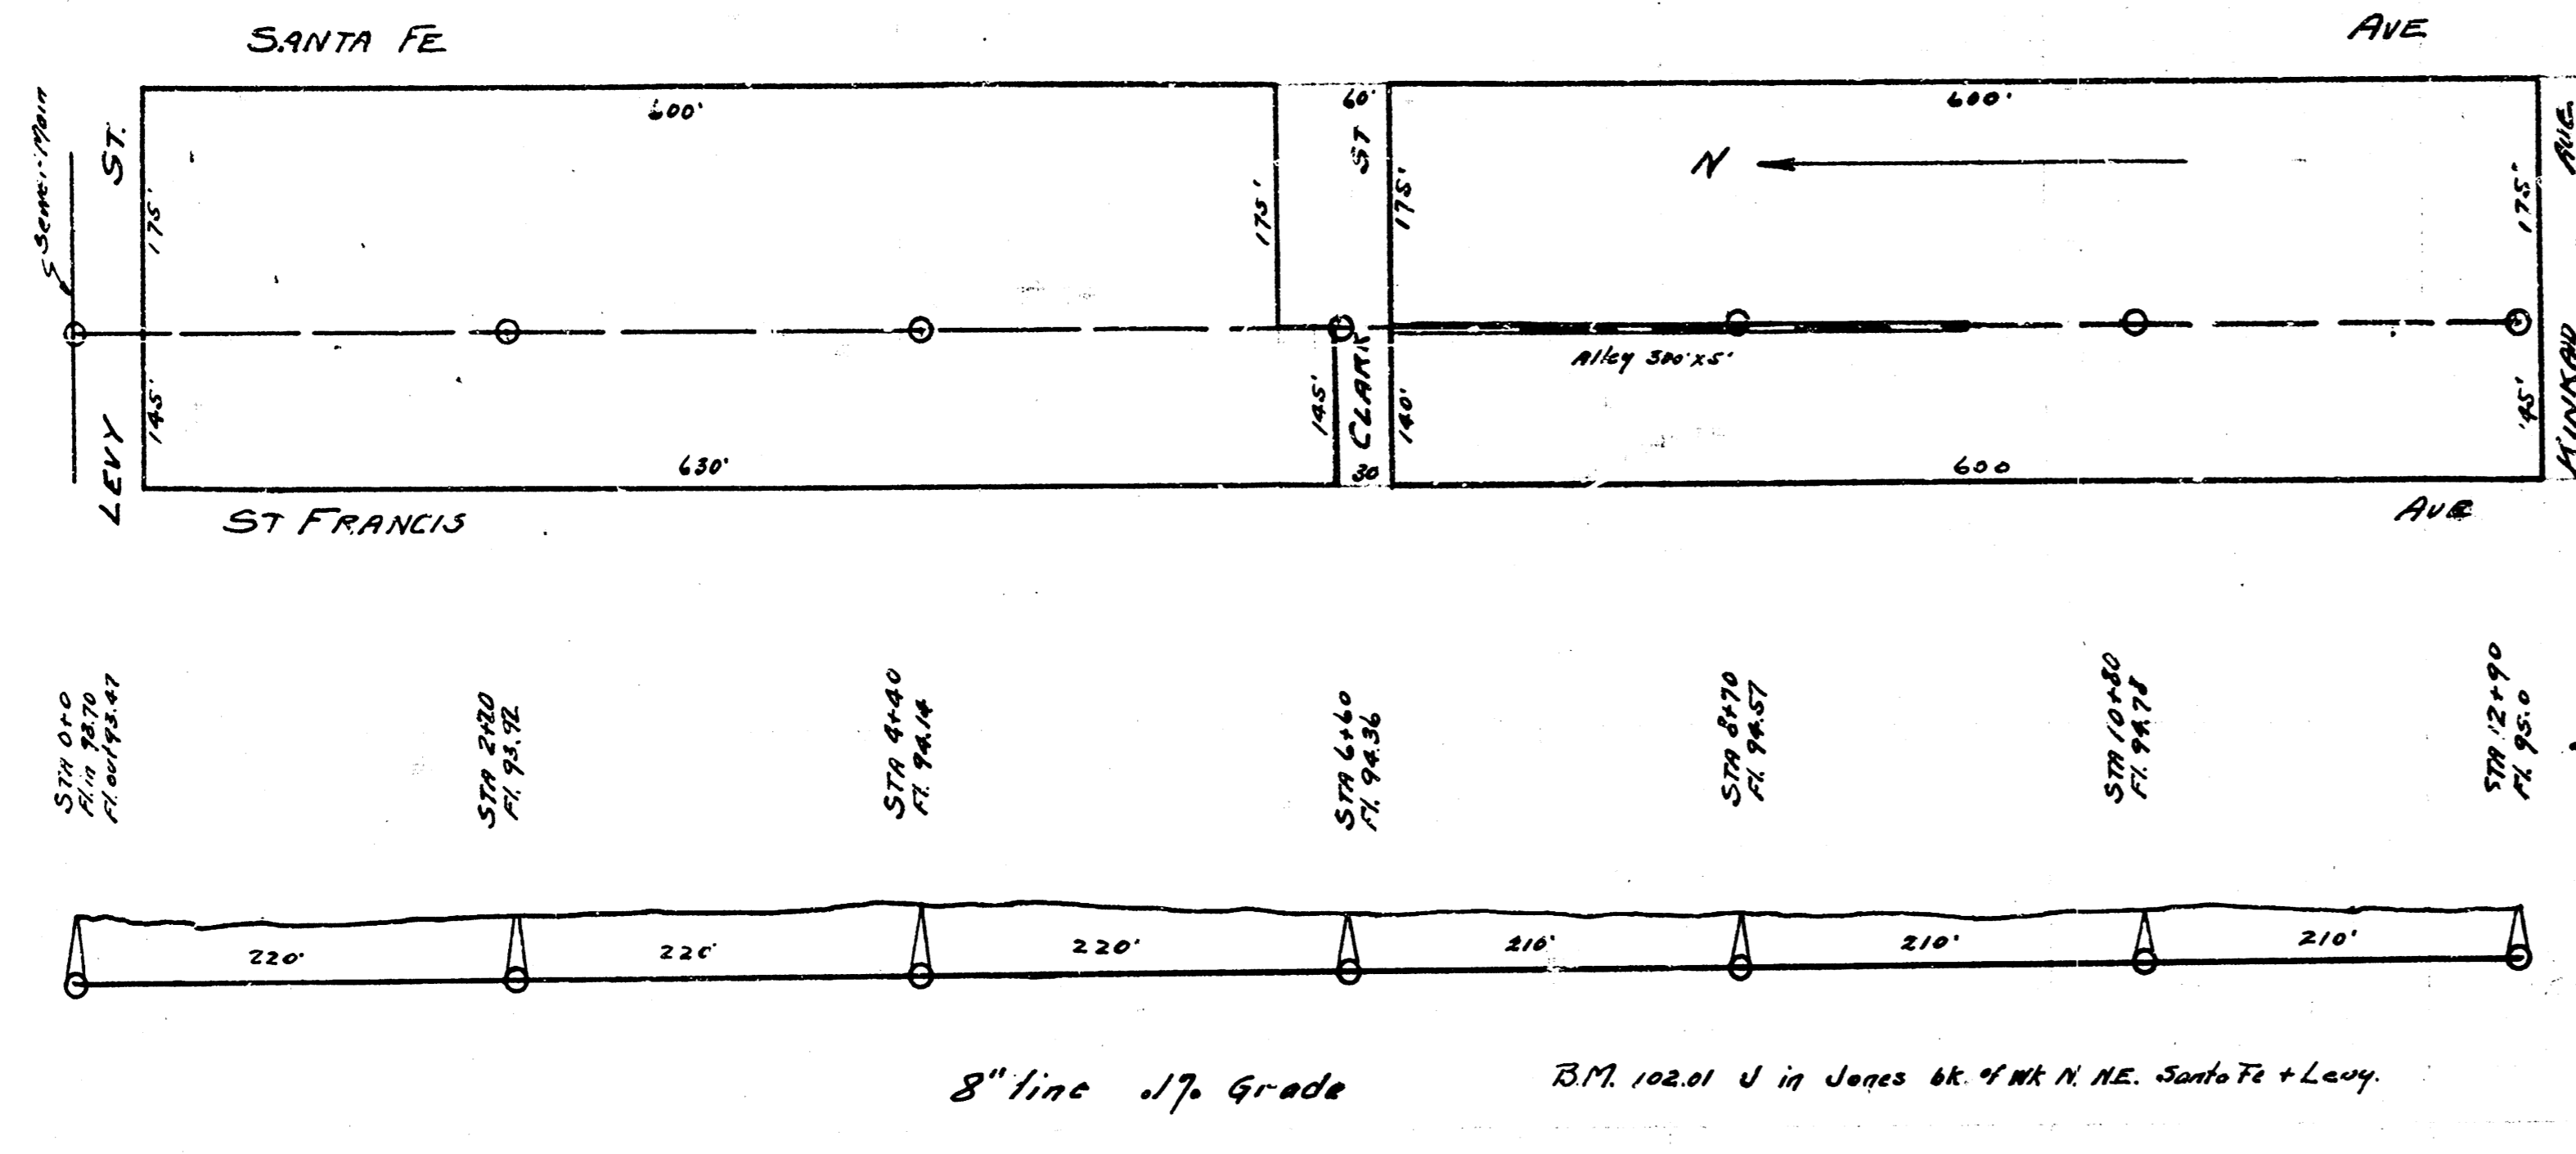
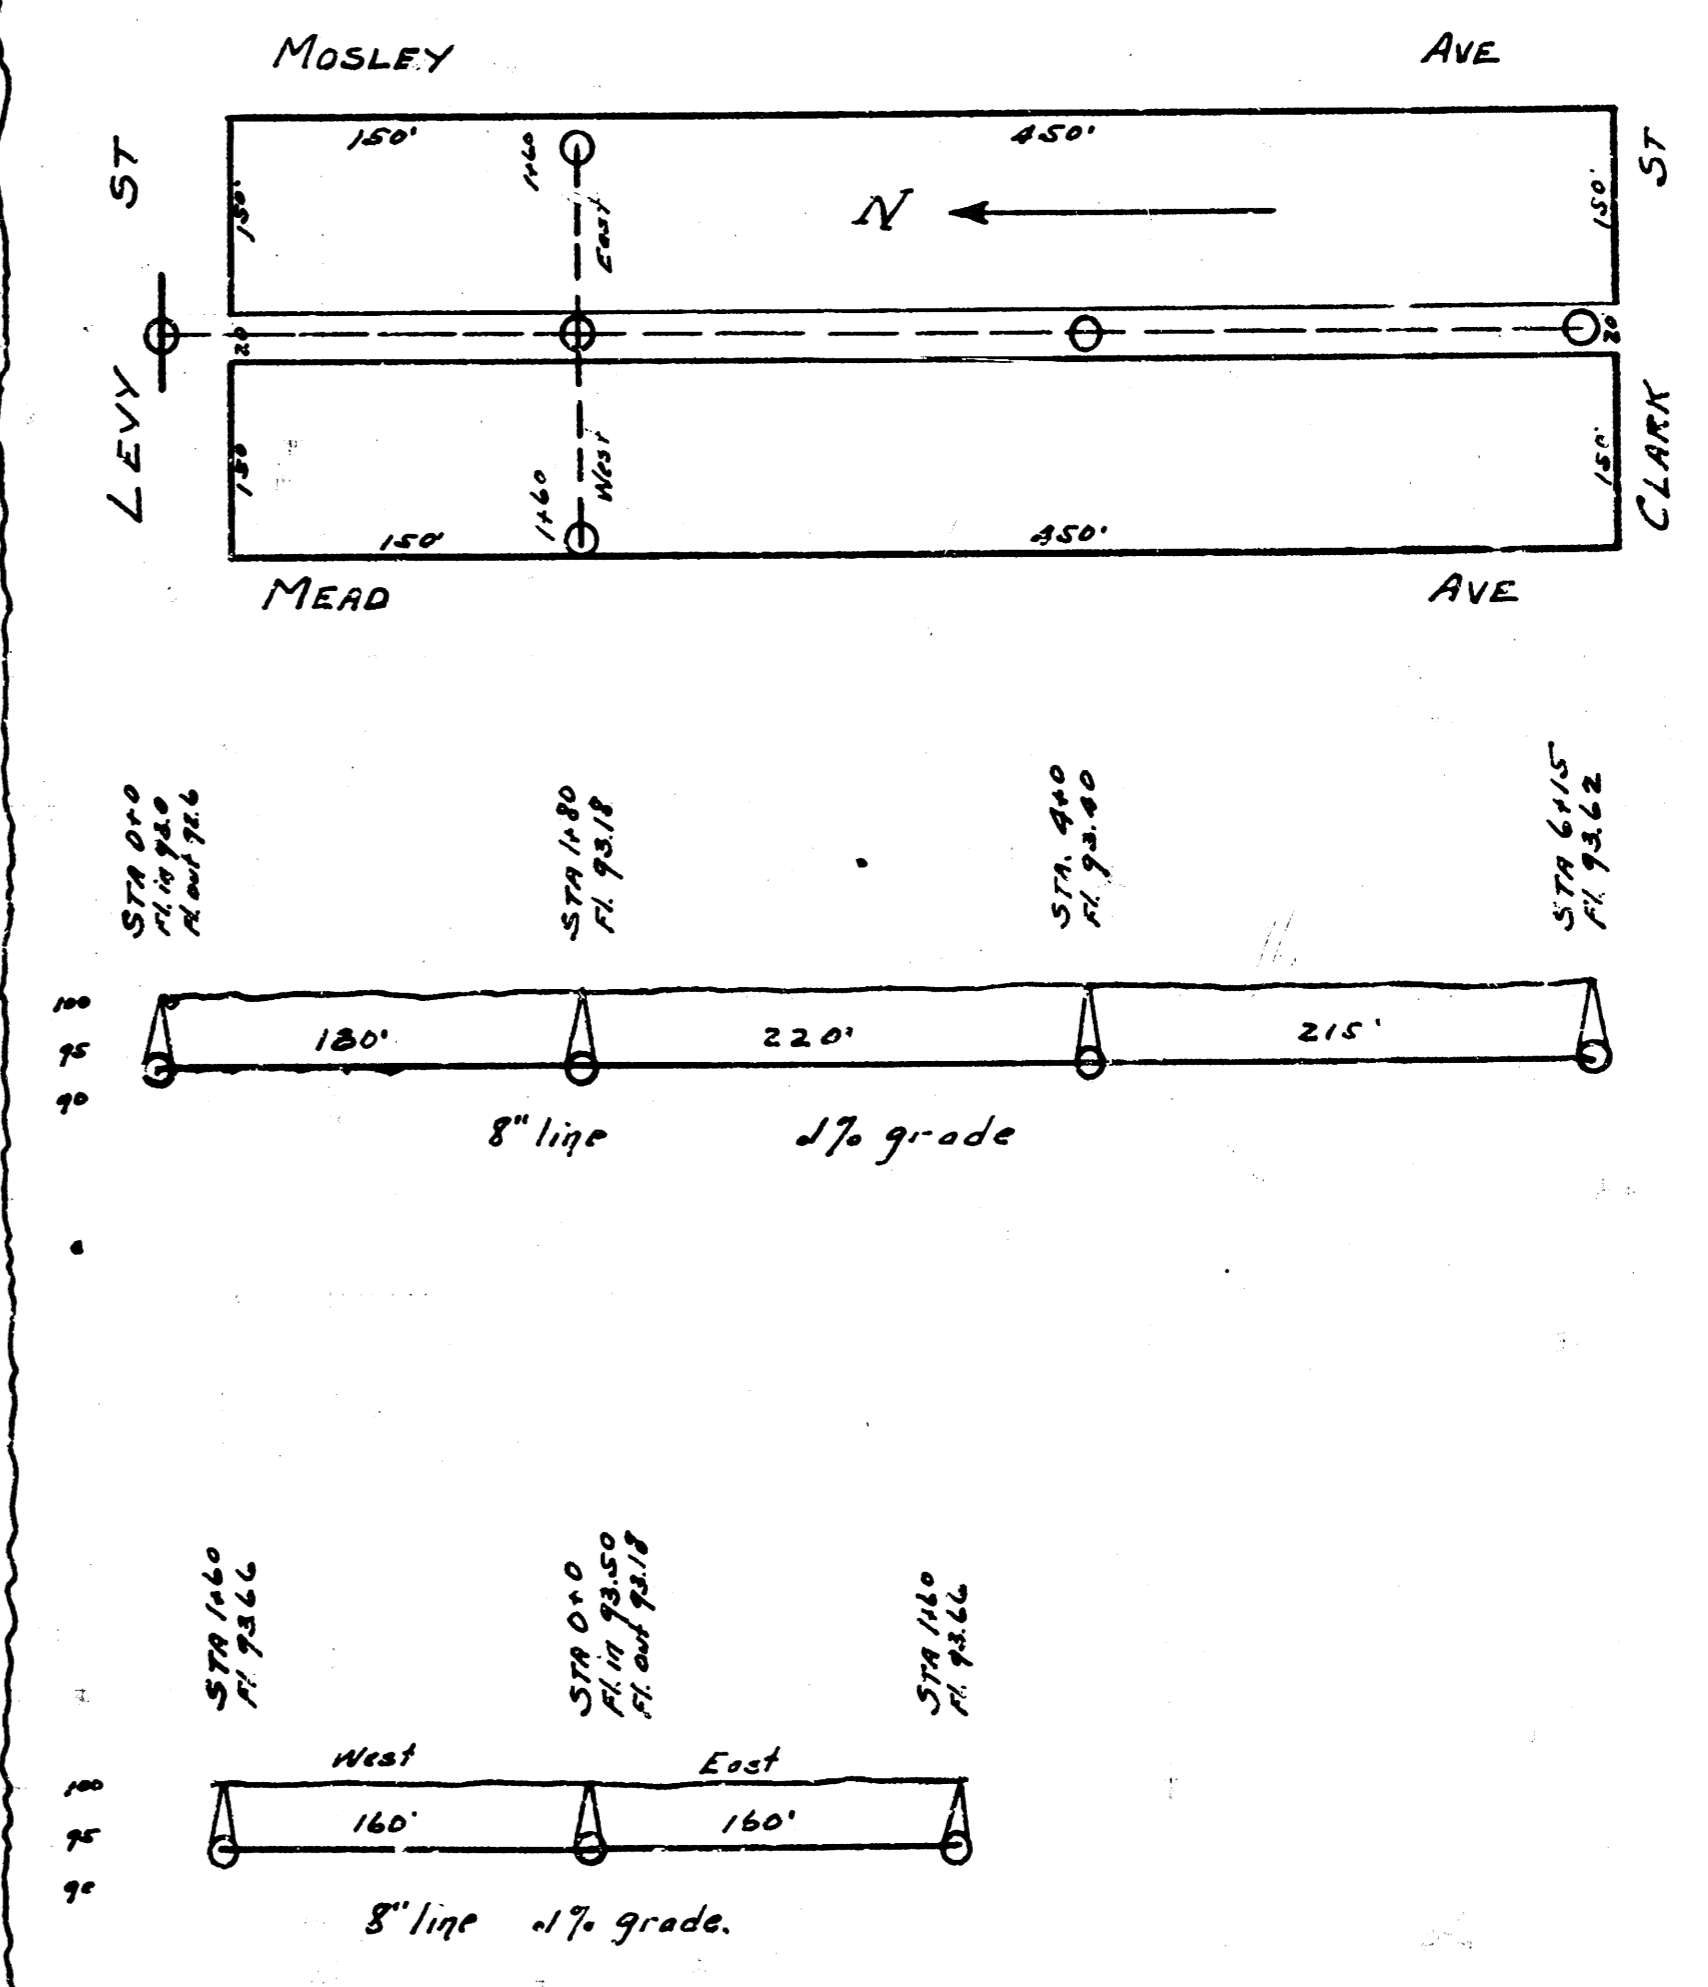
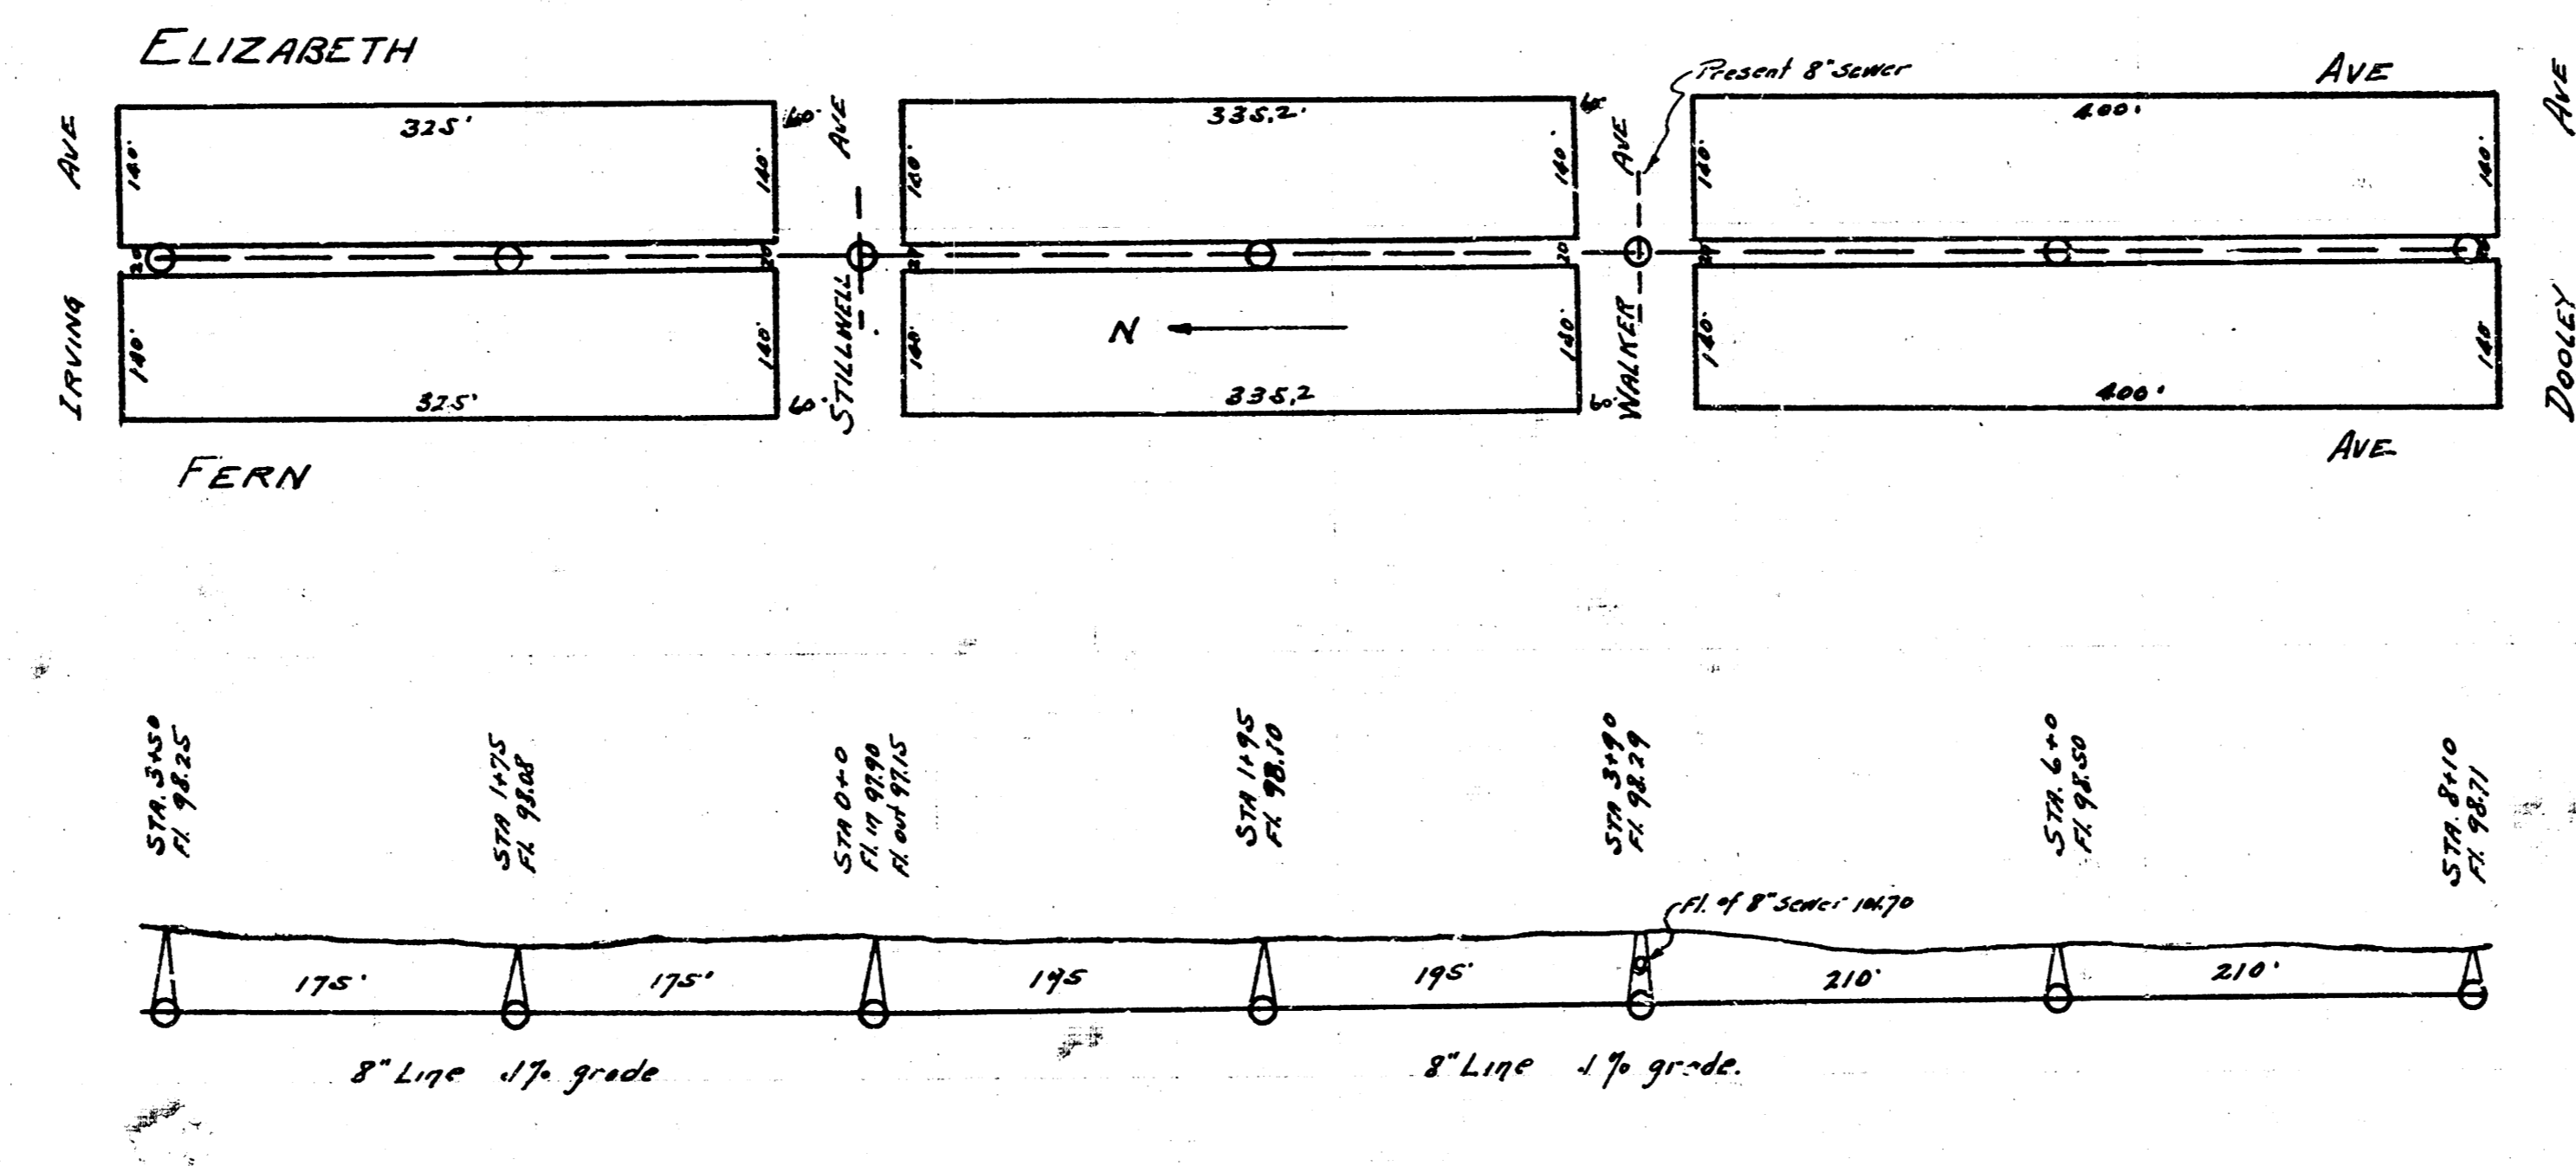


LAT. 20, DIST. C, S.S. 20.

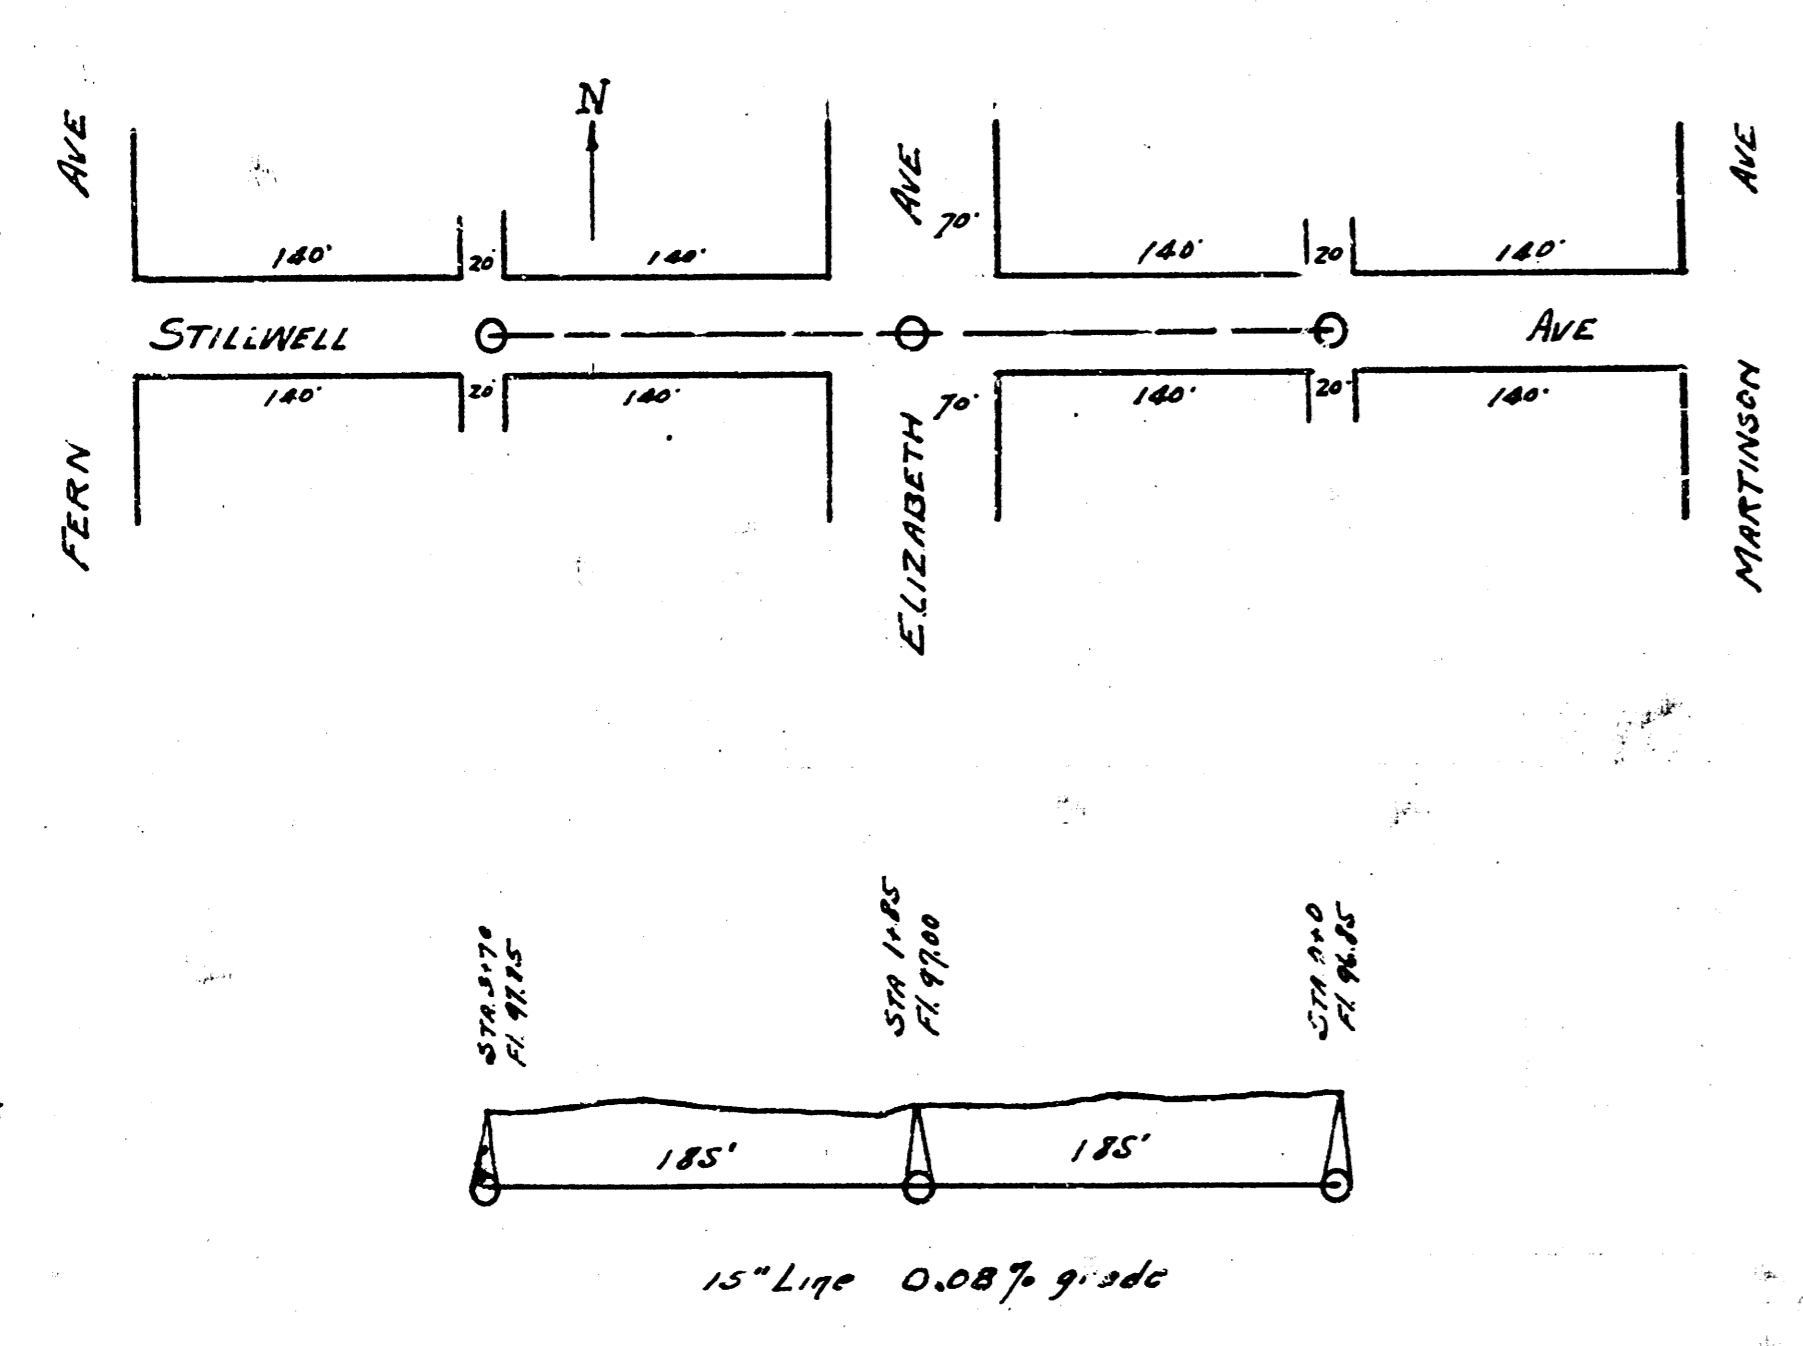

LAT. 1, DIST. B, S.S. 20

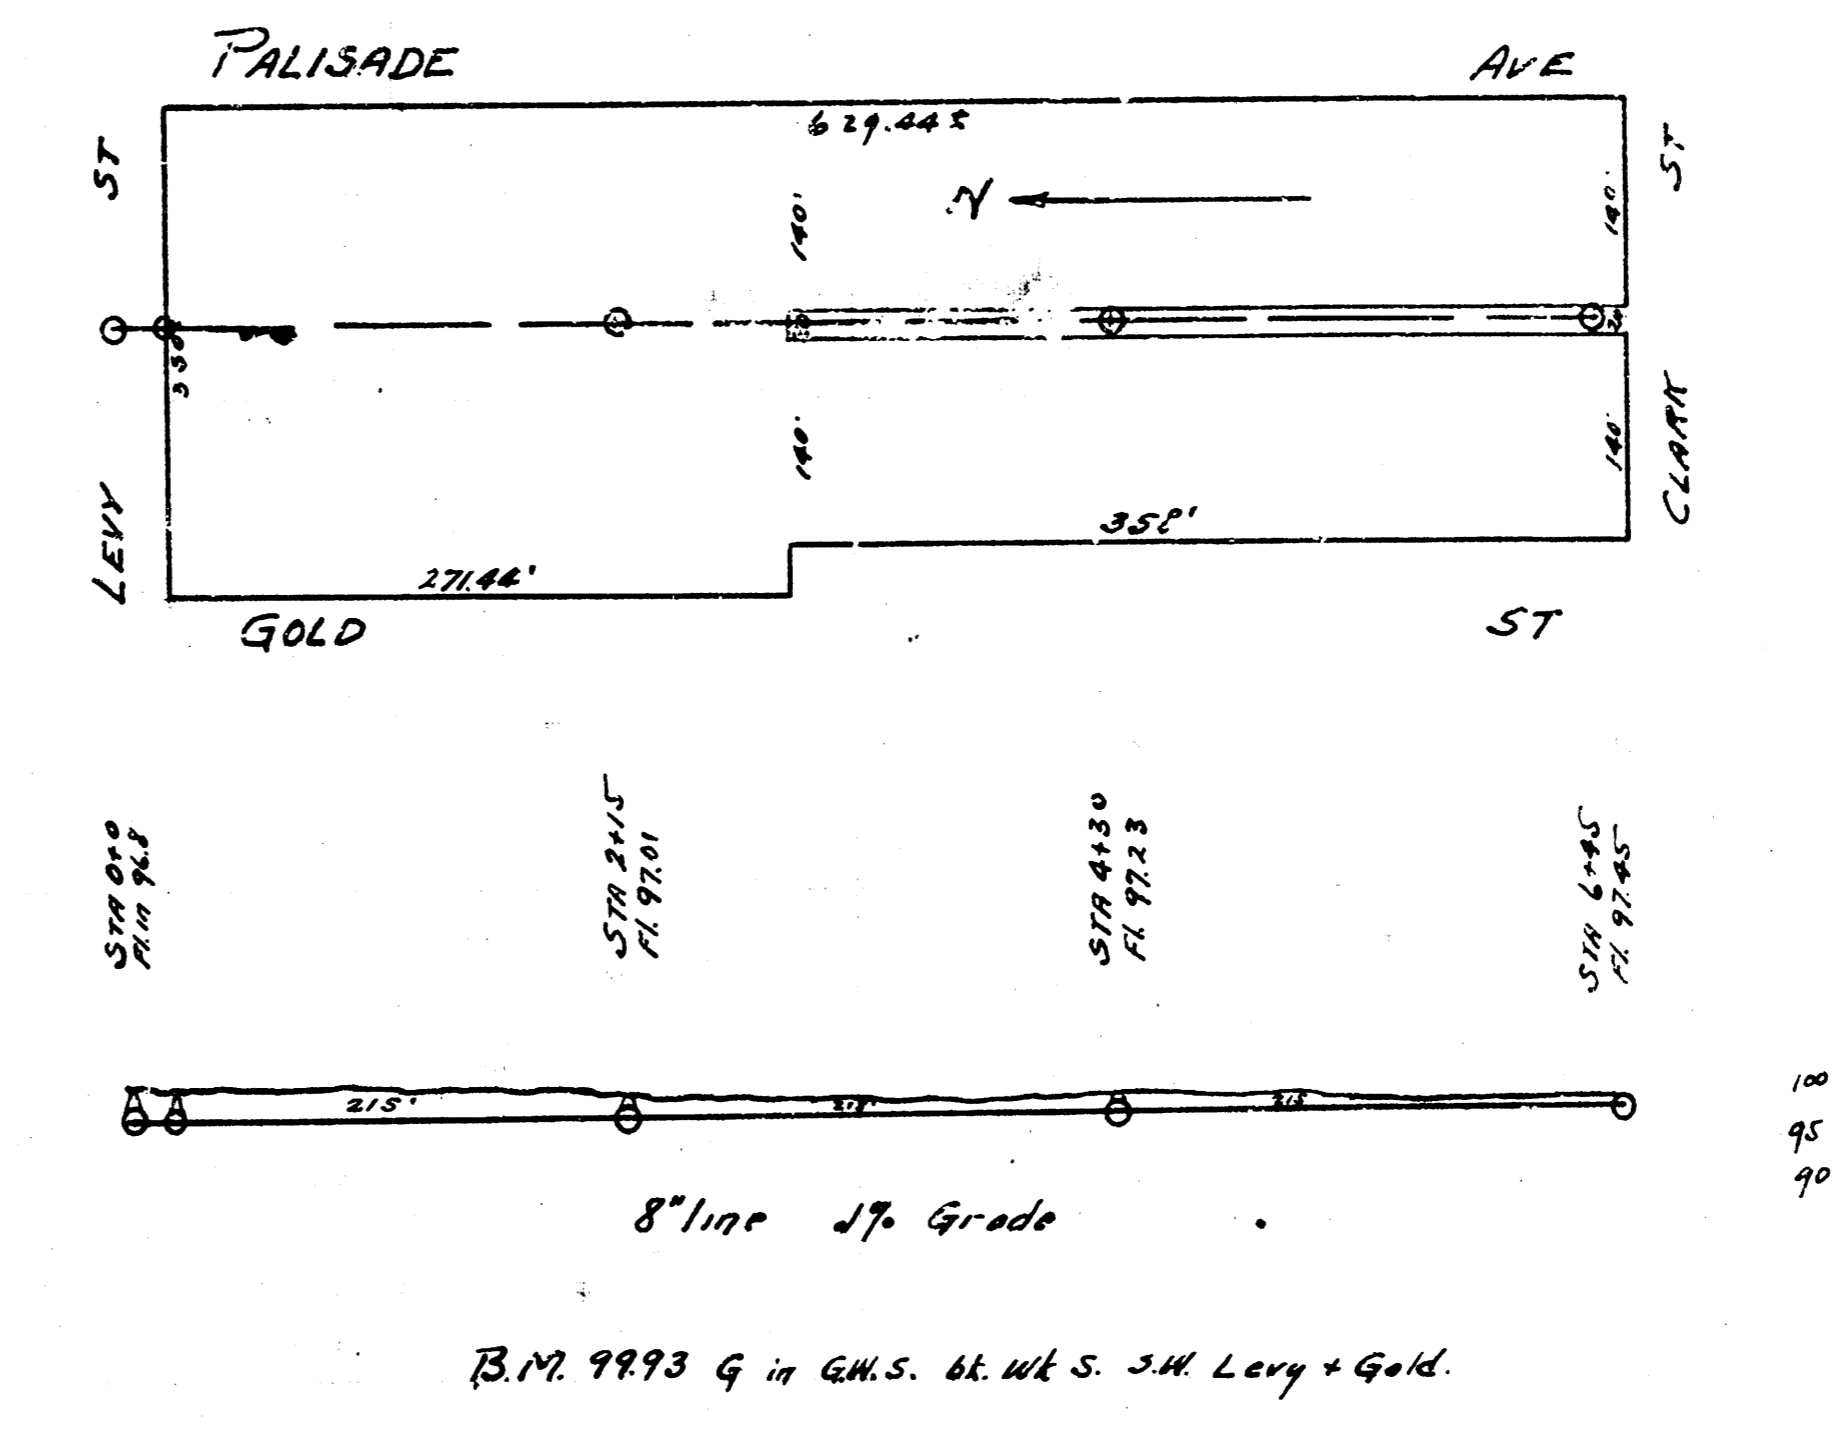

LAT. F, DIST. E, S.S. 21.

LAT. 21, DIST. C, S.S. NO. 20.