




Scale: 1"=40'
 Box: M-16

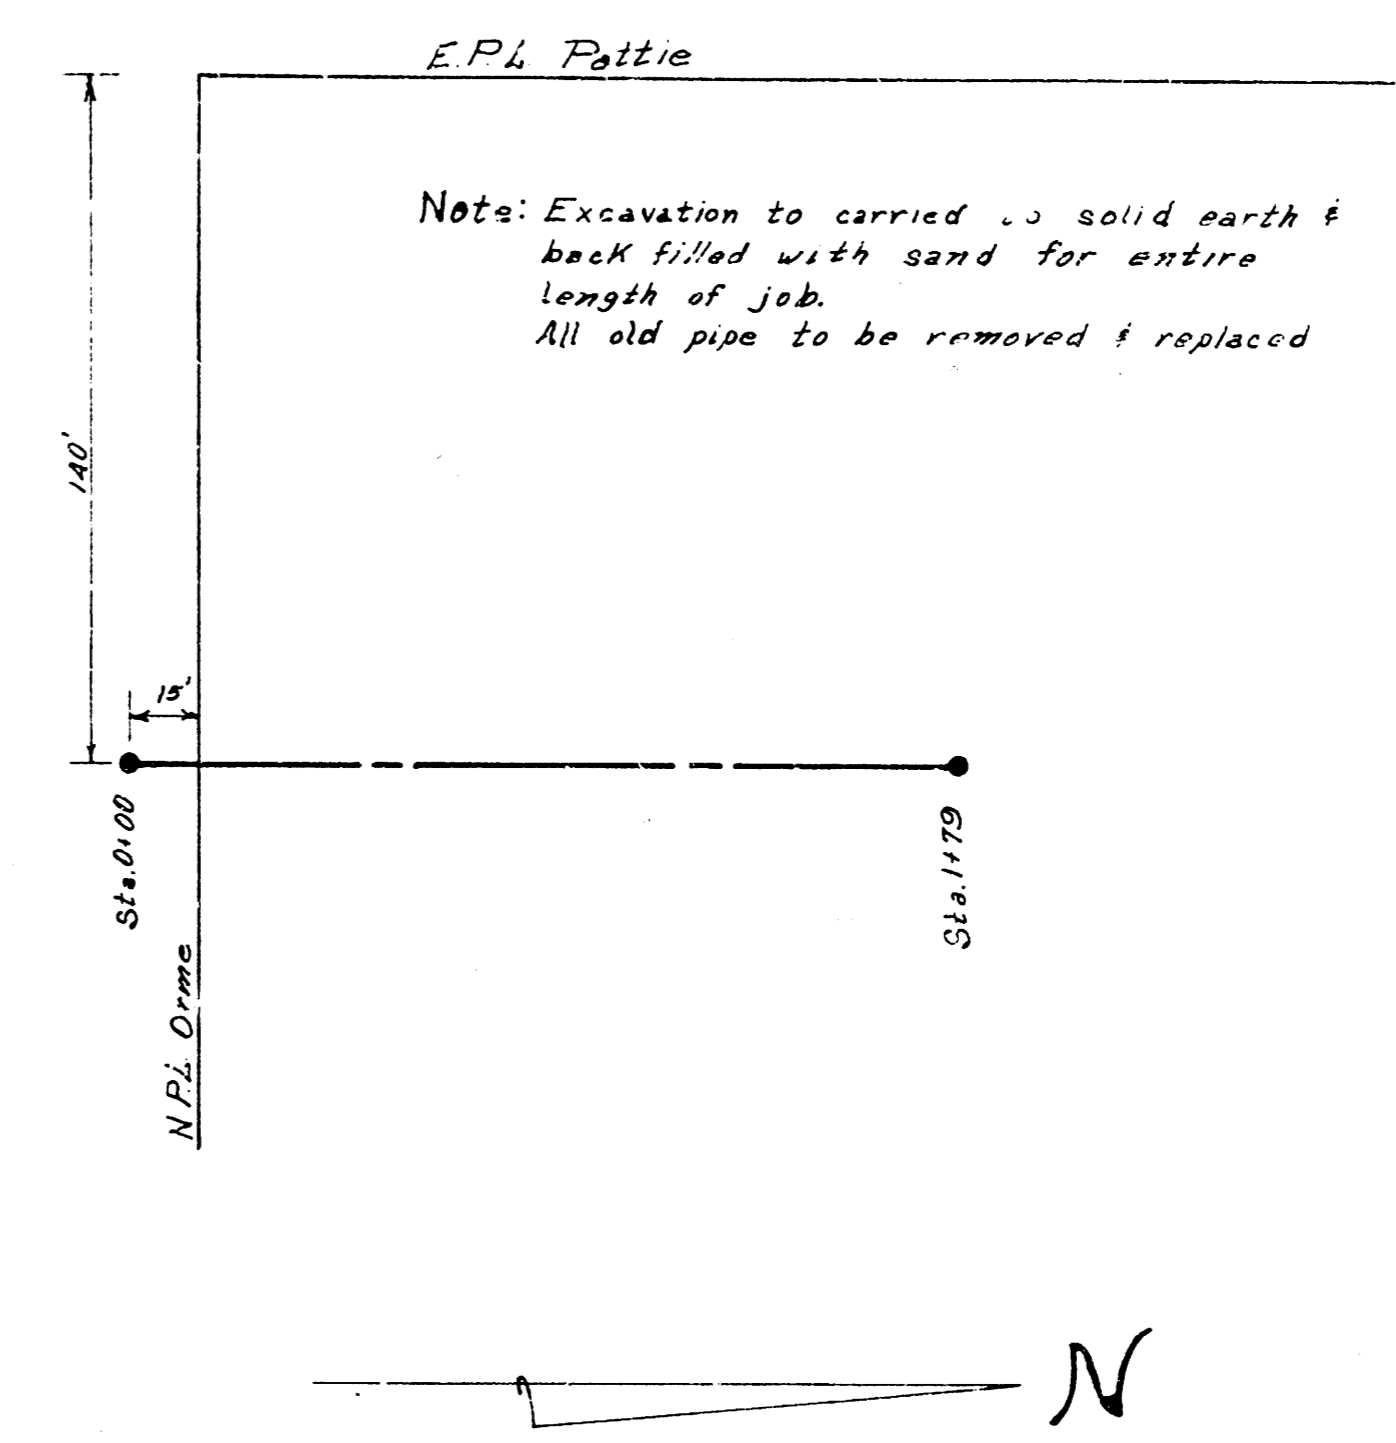

Scale: 1"=40'
 Box: Final Profile *5

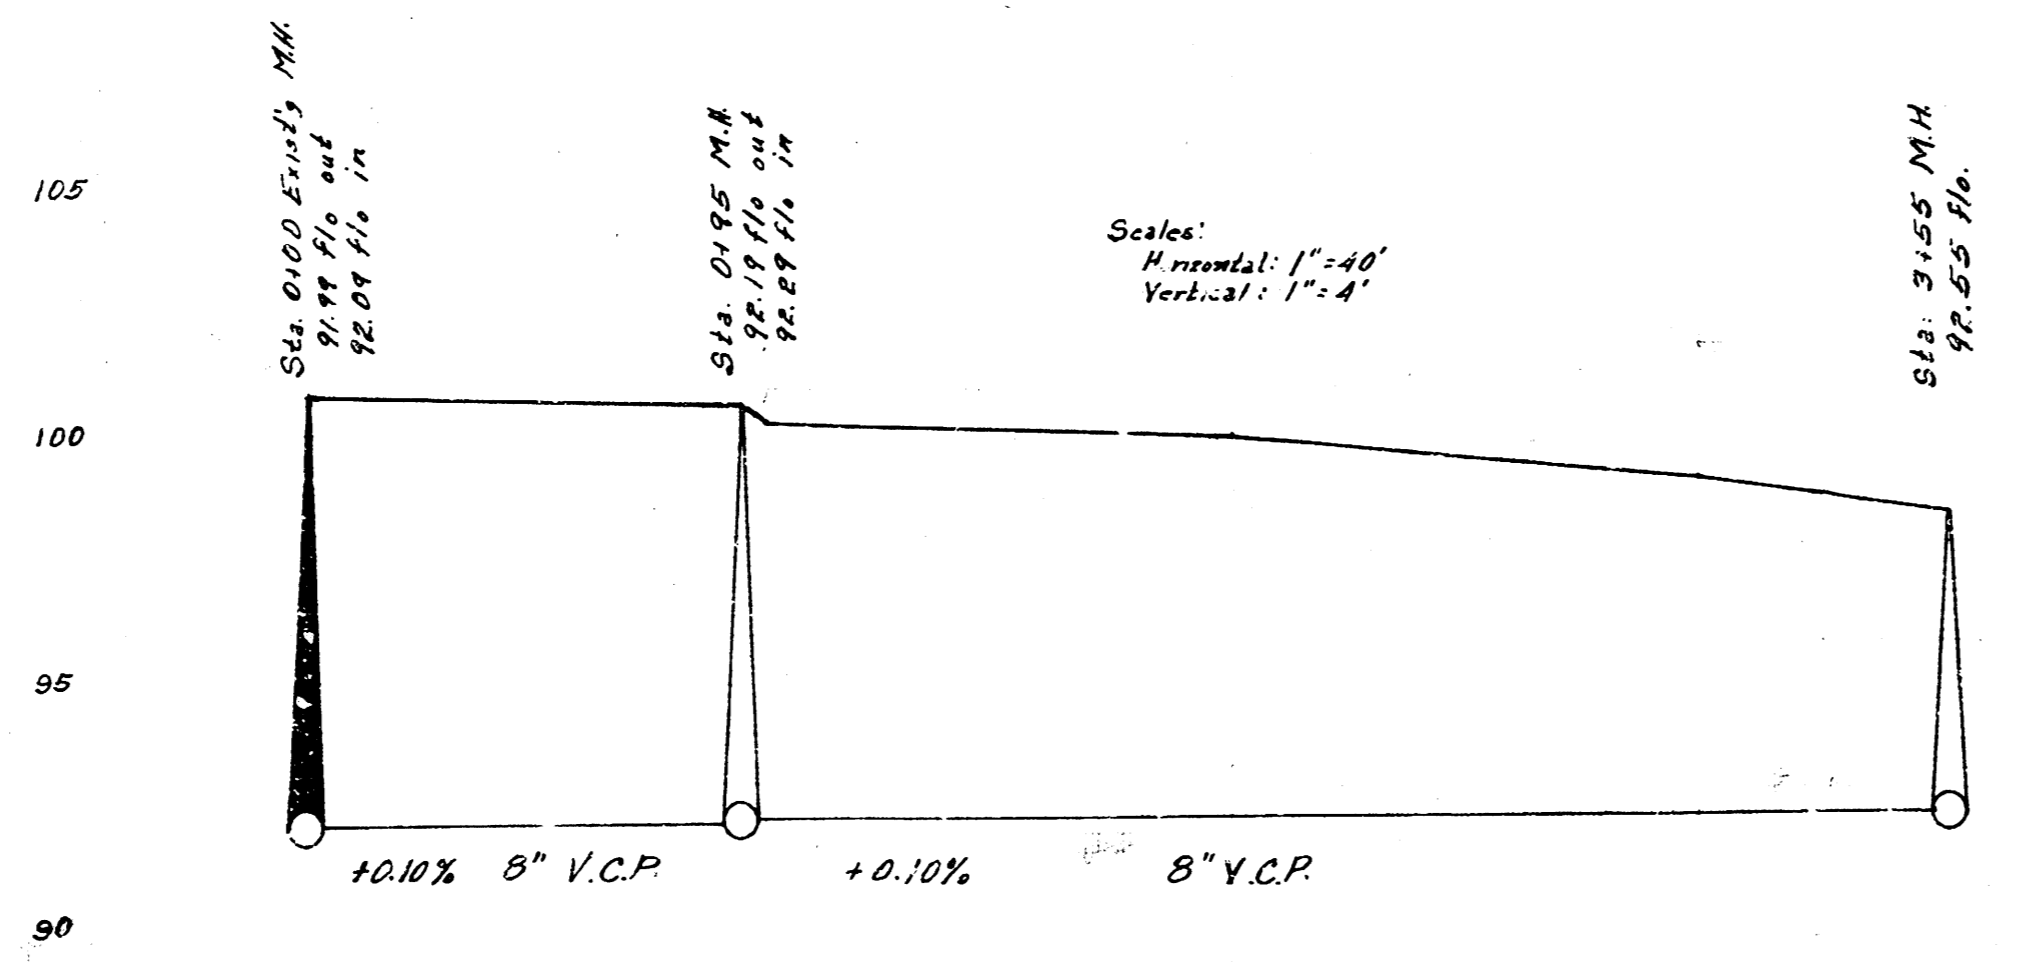

Scale: Horizontal: 1"=40'
 Vertical: 1"=4'

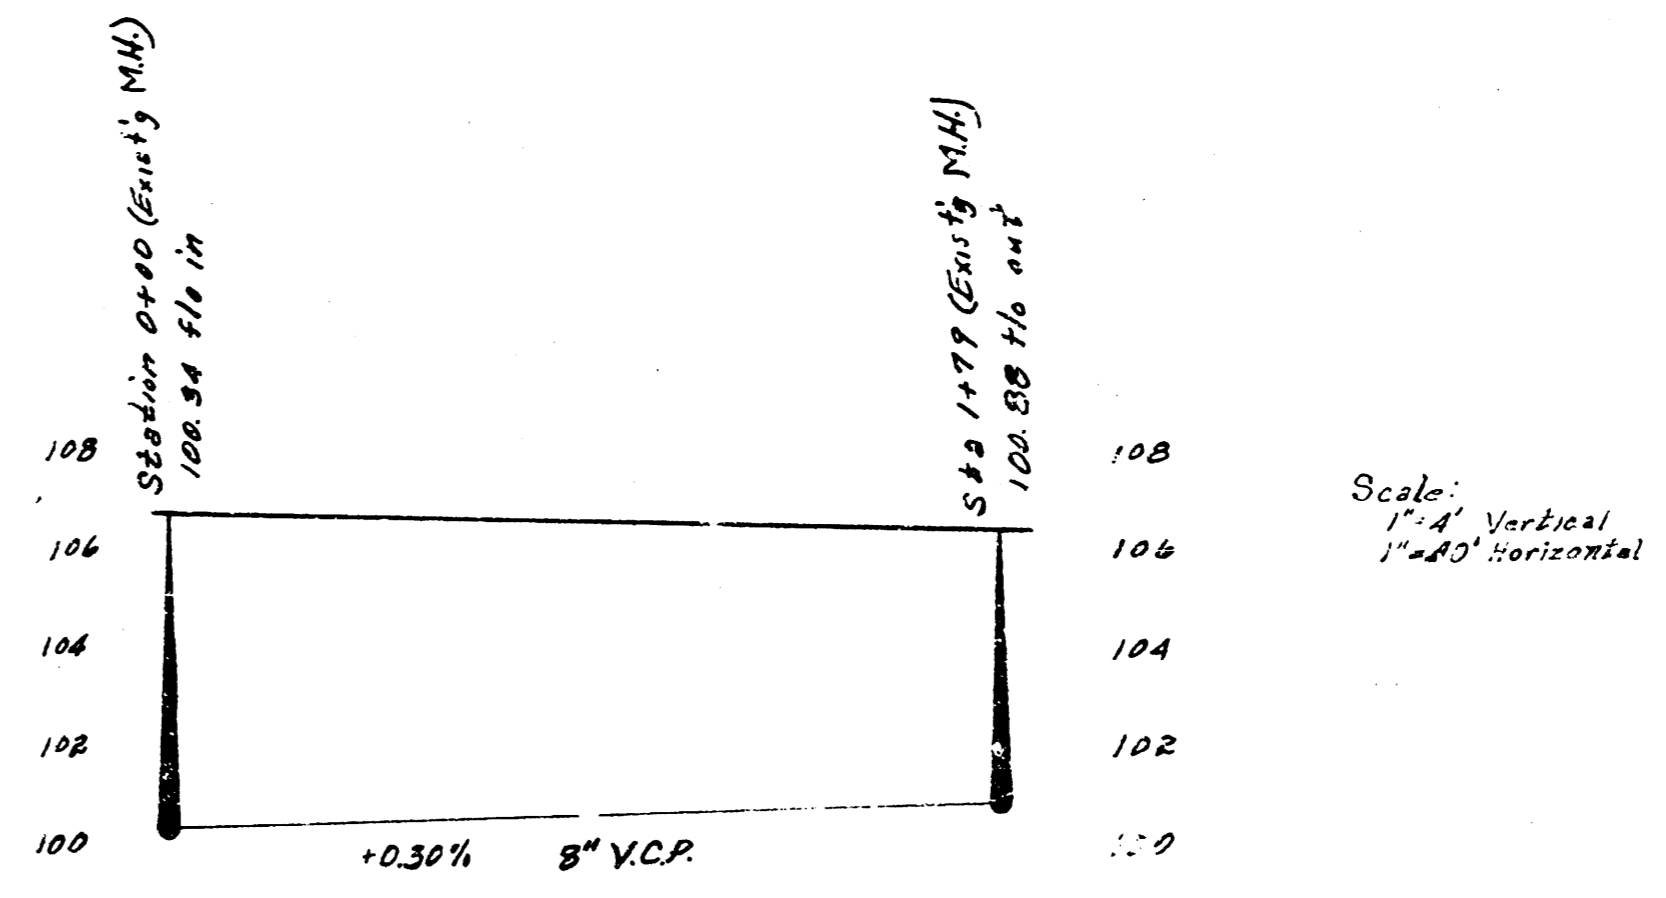

Scale: Vertical: 1"=4'
 Horizontal: 1"=40'

SUB-LAT Q, Dist. B, SS*20
 City of Wichita, Kansas
 L.K. White City Engineer
 April, 1951 Proj. No. C20-61

Reconstruction of portion of
 DISTRICT H, SS*20
 City of Wichita, Kansas
 L.K. White City Engineer
 March 1951 Proj. No. C28-22



0+00

1+00

2+00