

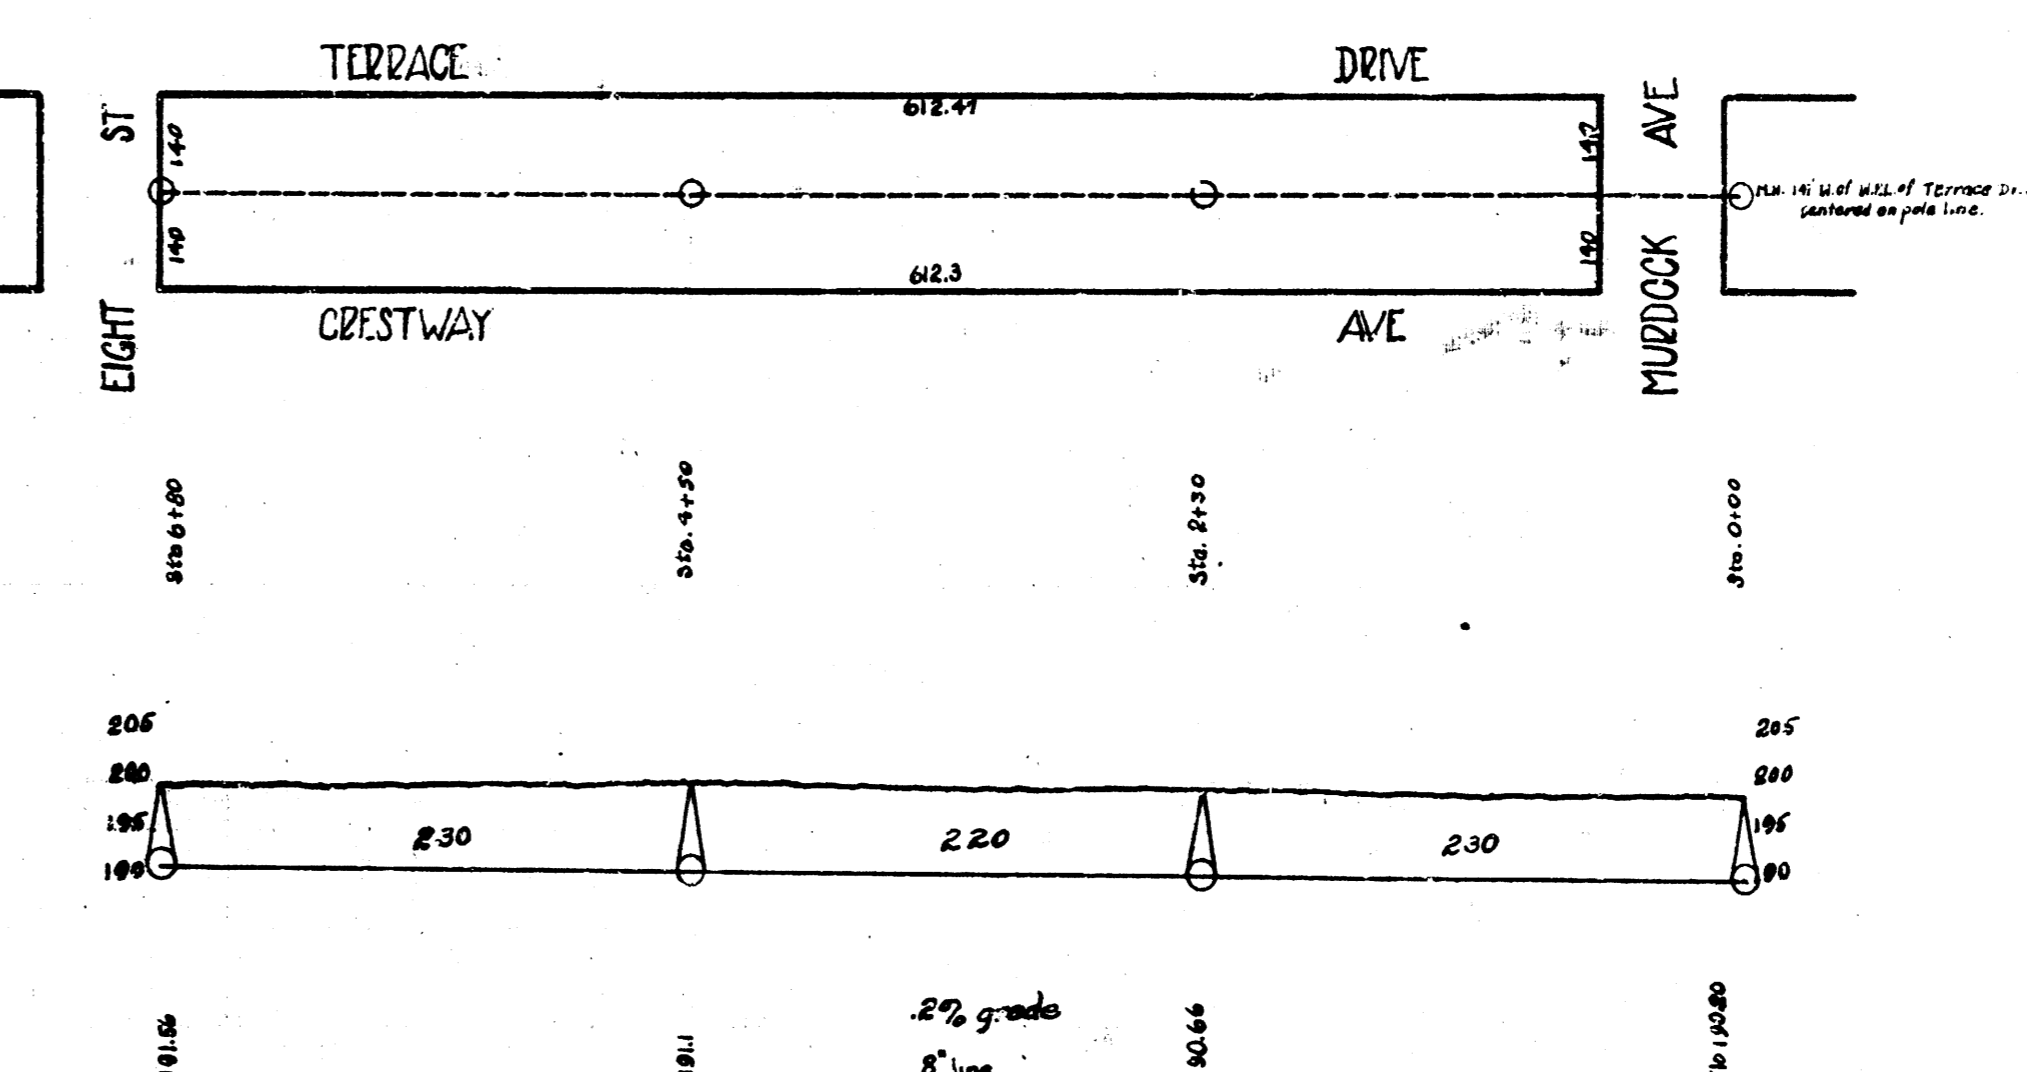
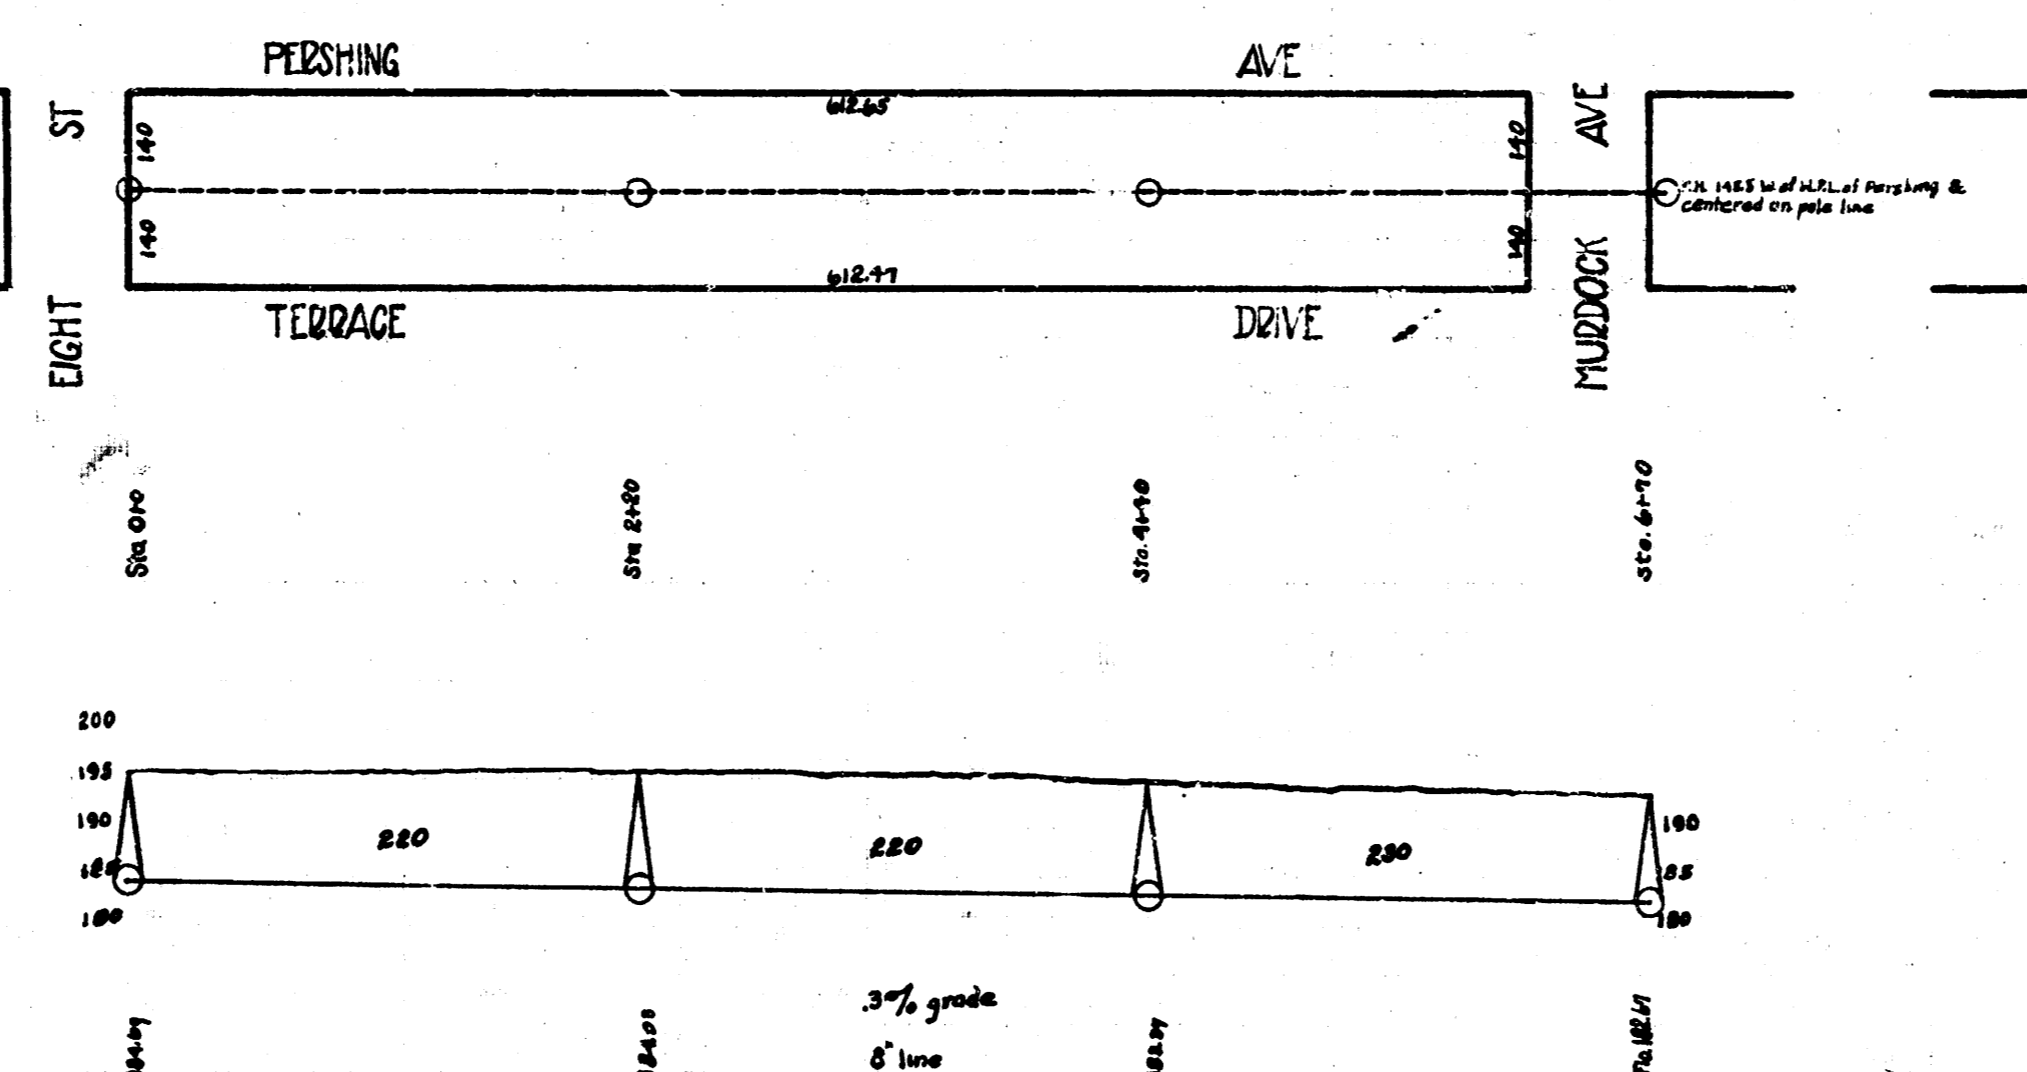
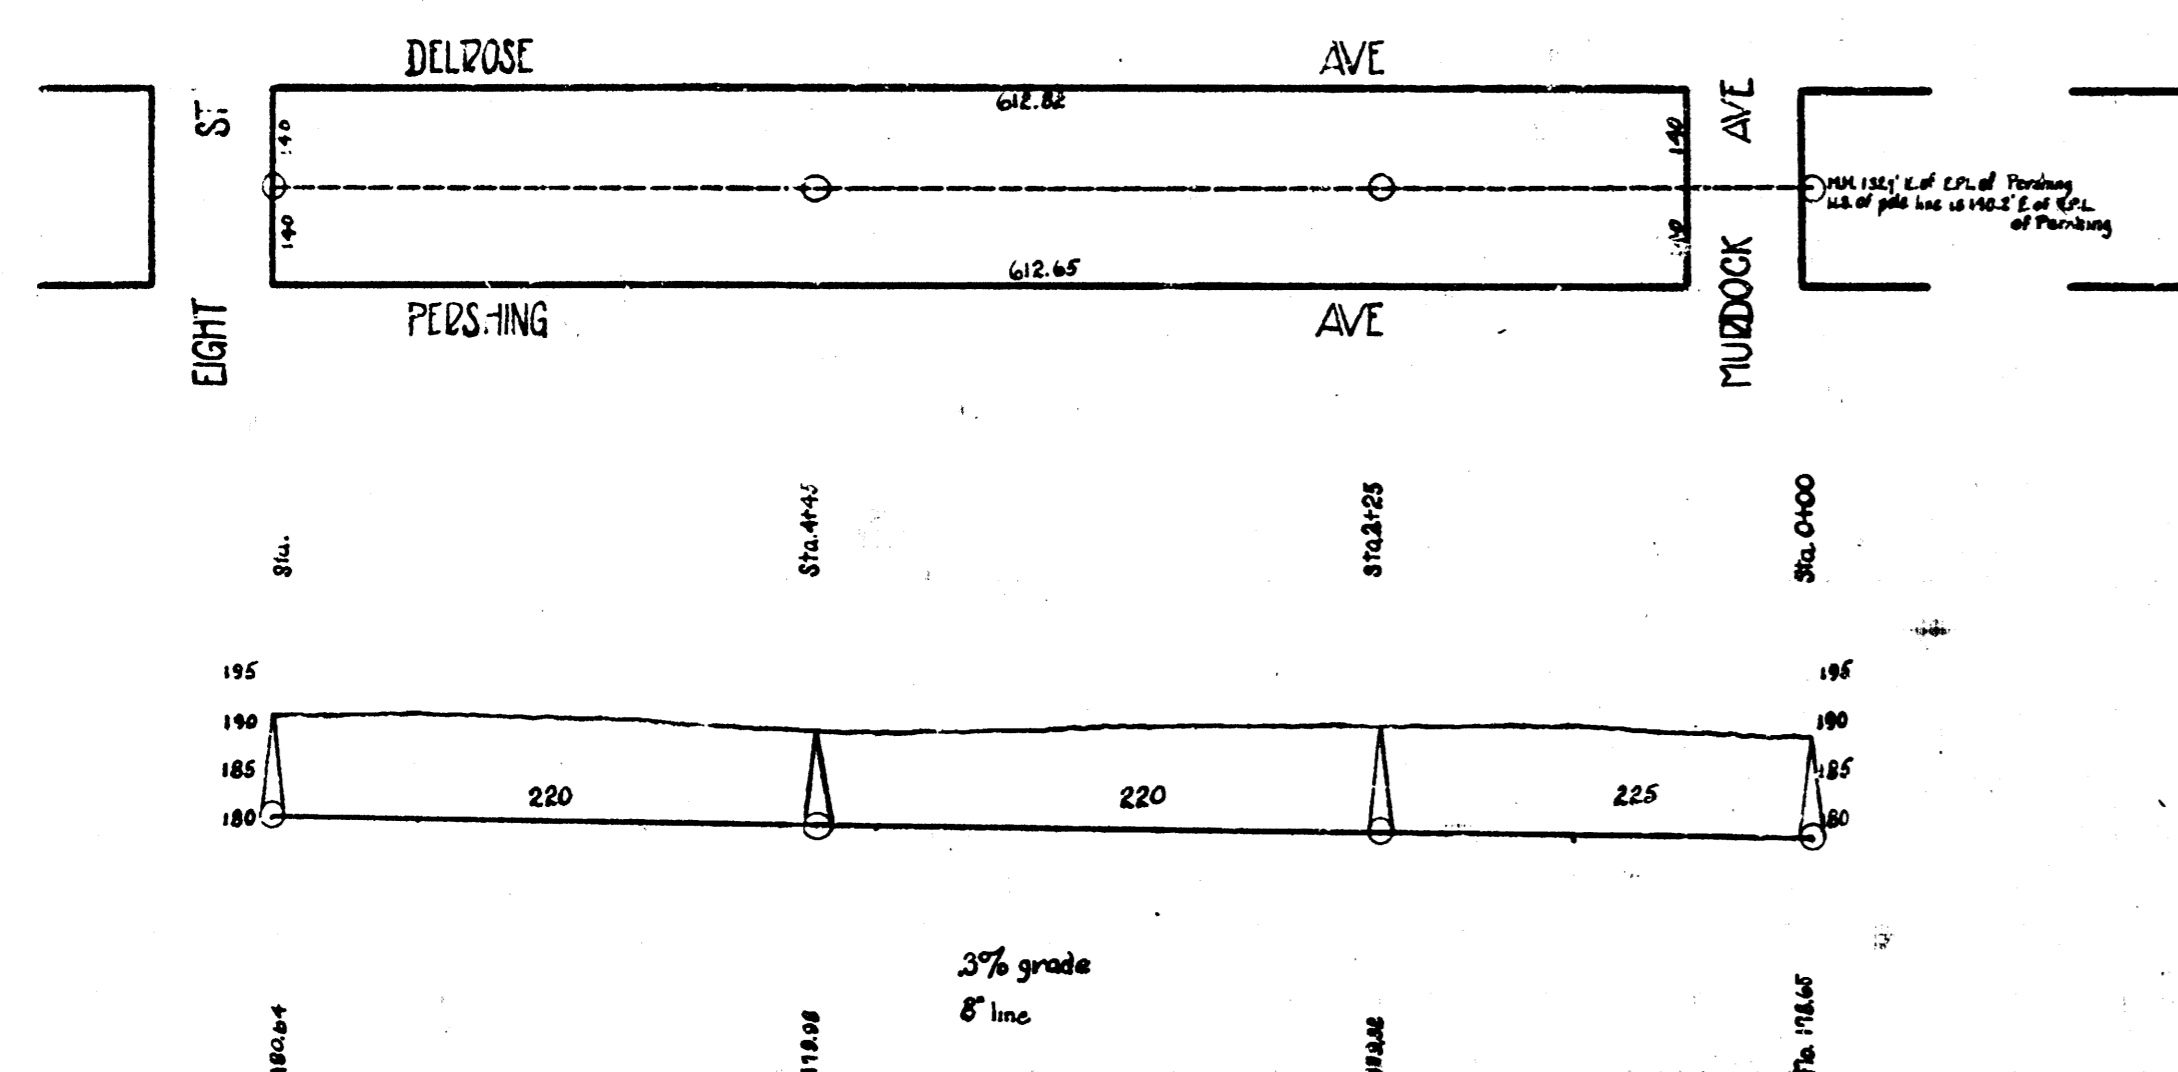



LAT. F. DIST. 6, S.S. 12

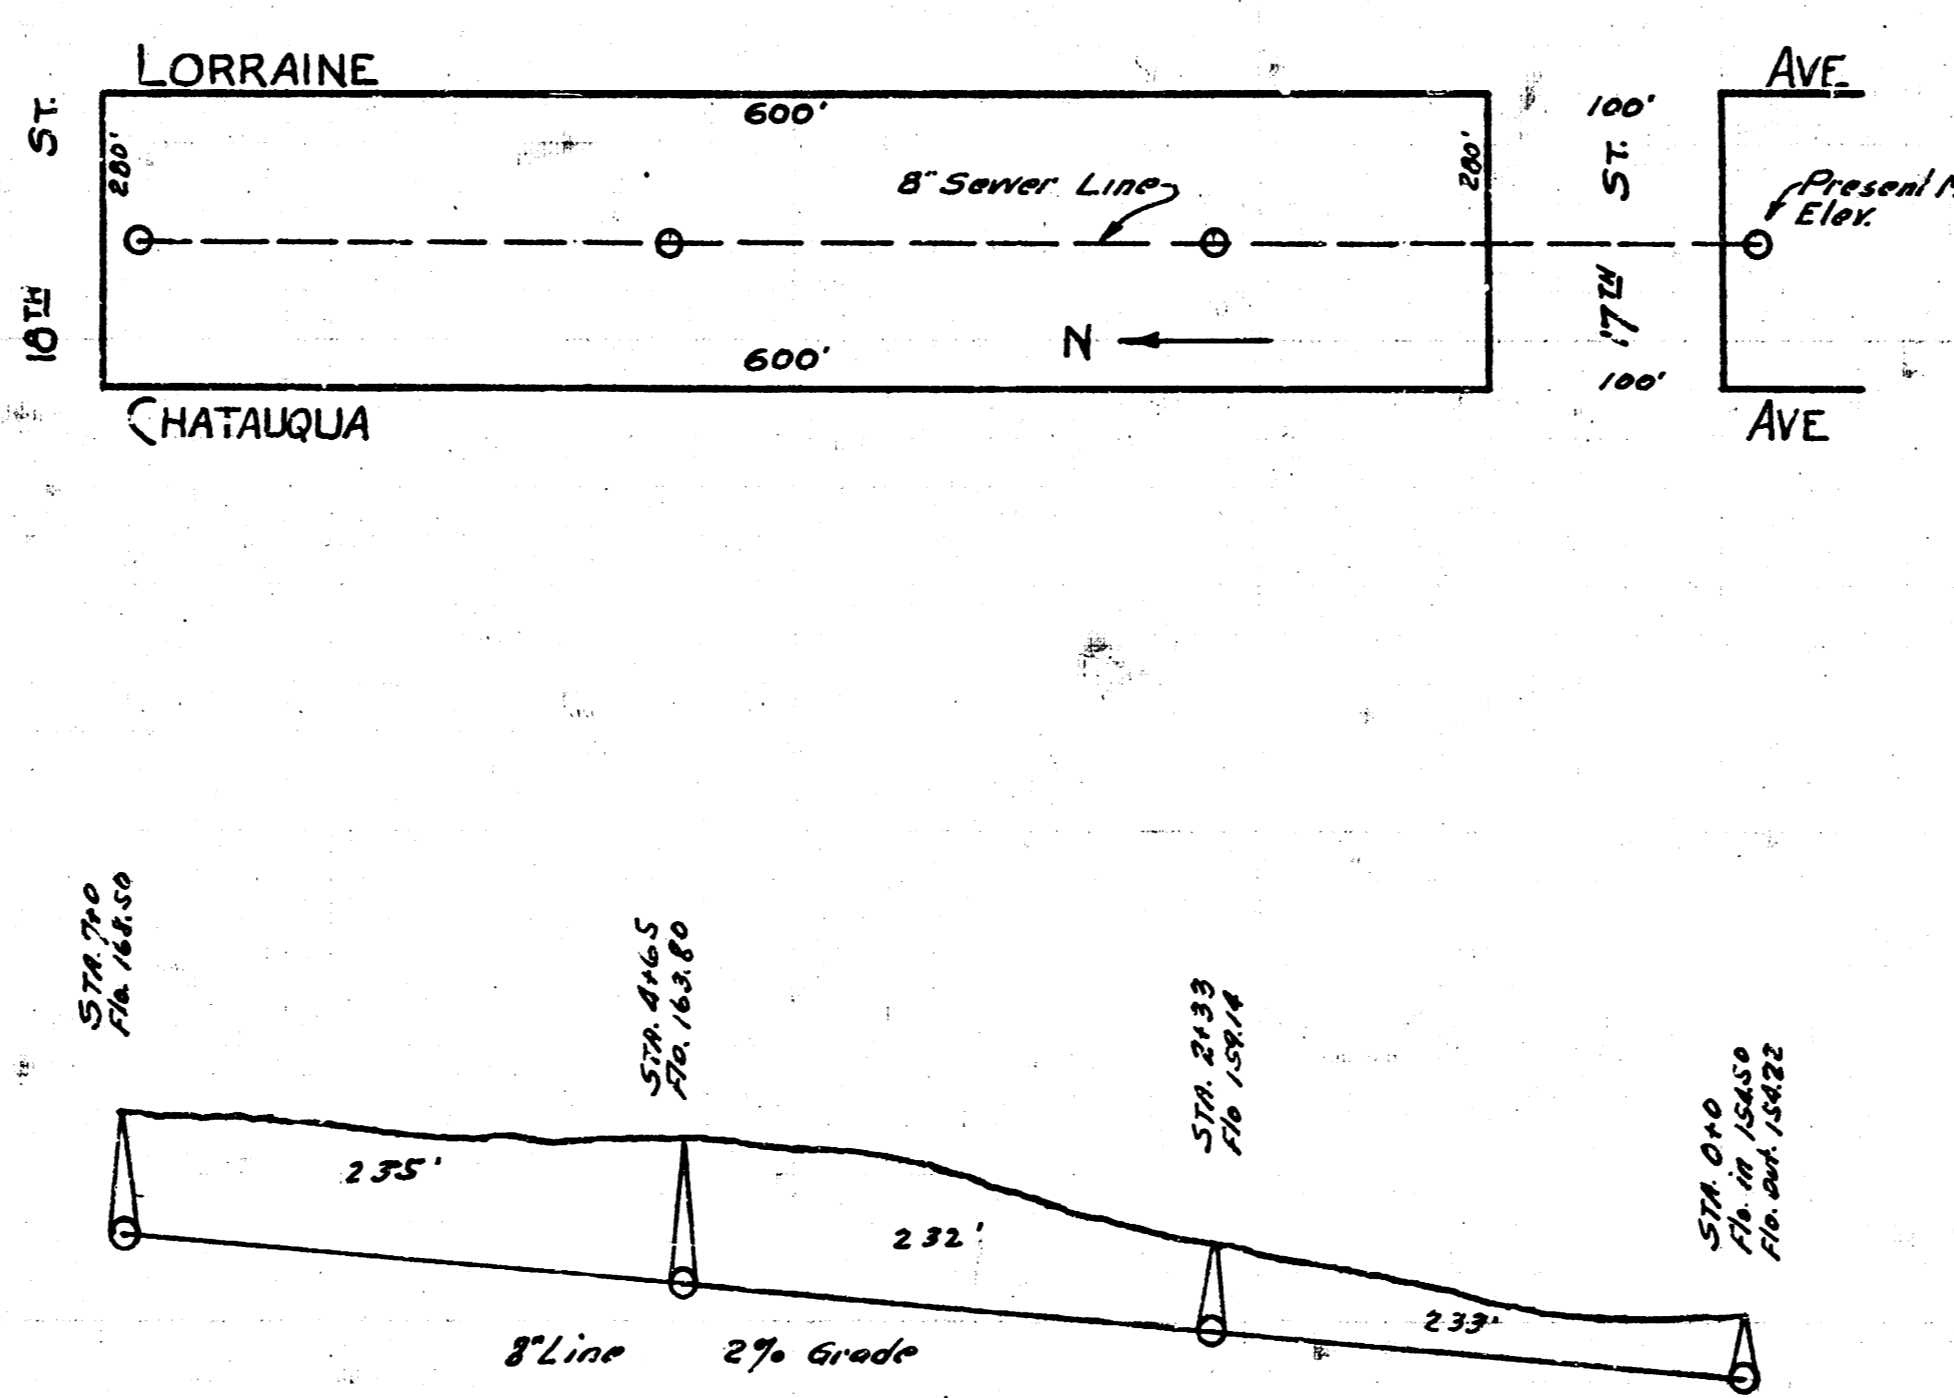

LAT. L, Dist. R, S.S. No. 20

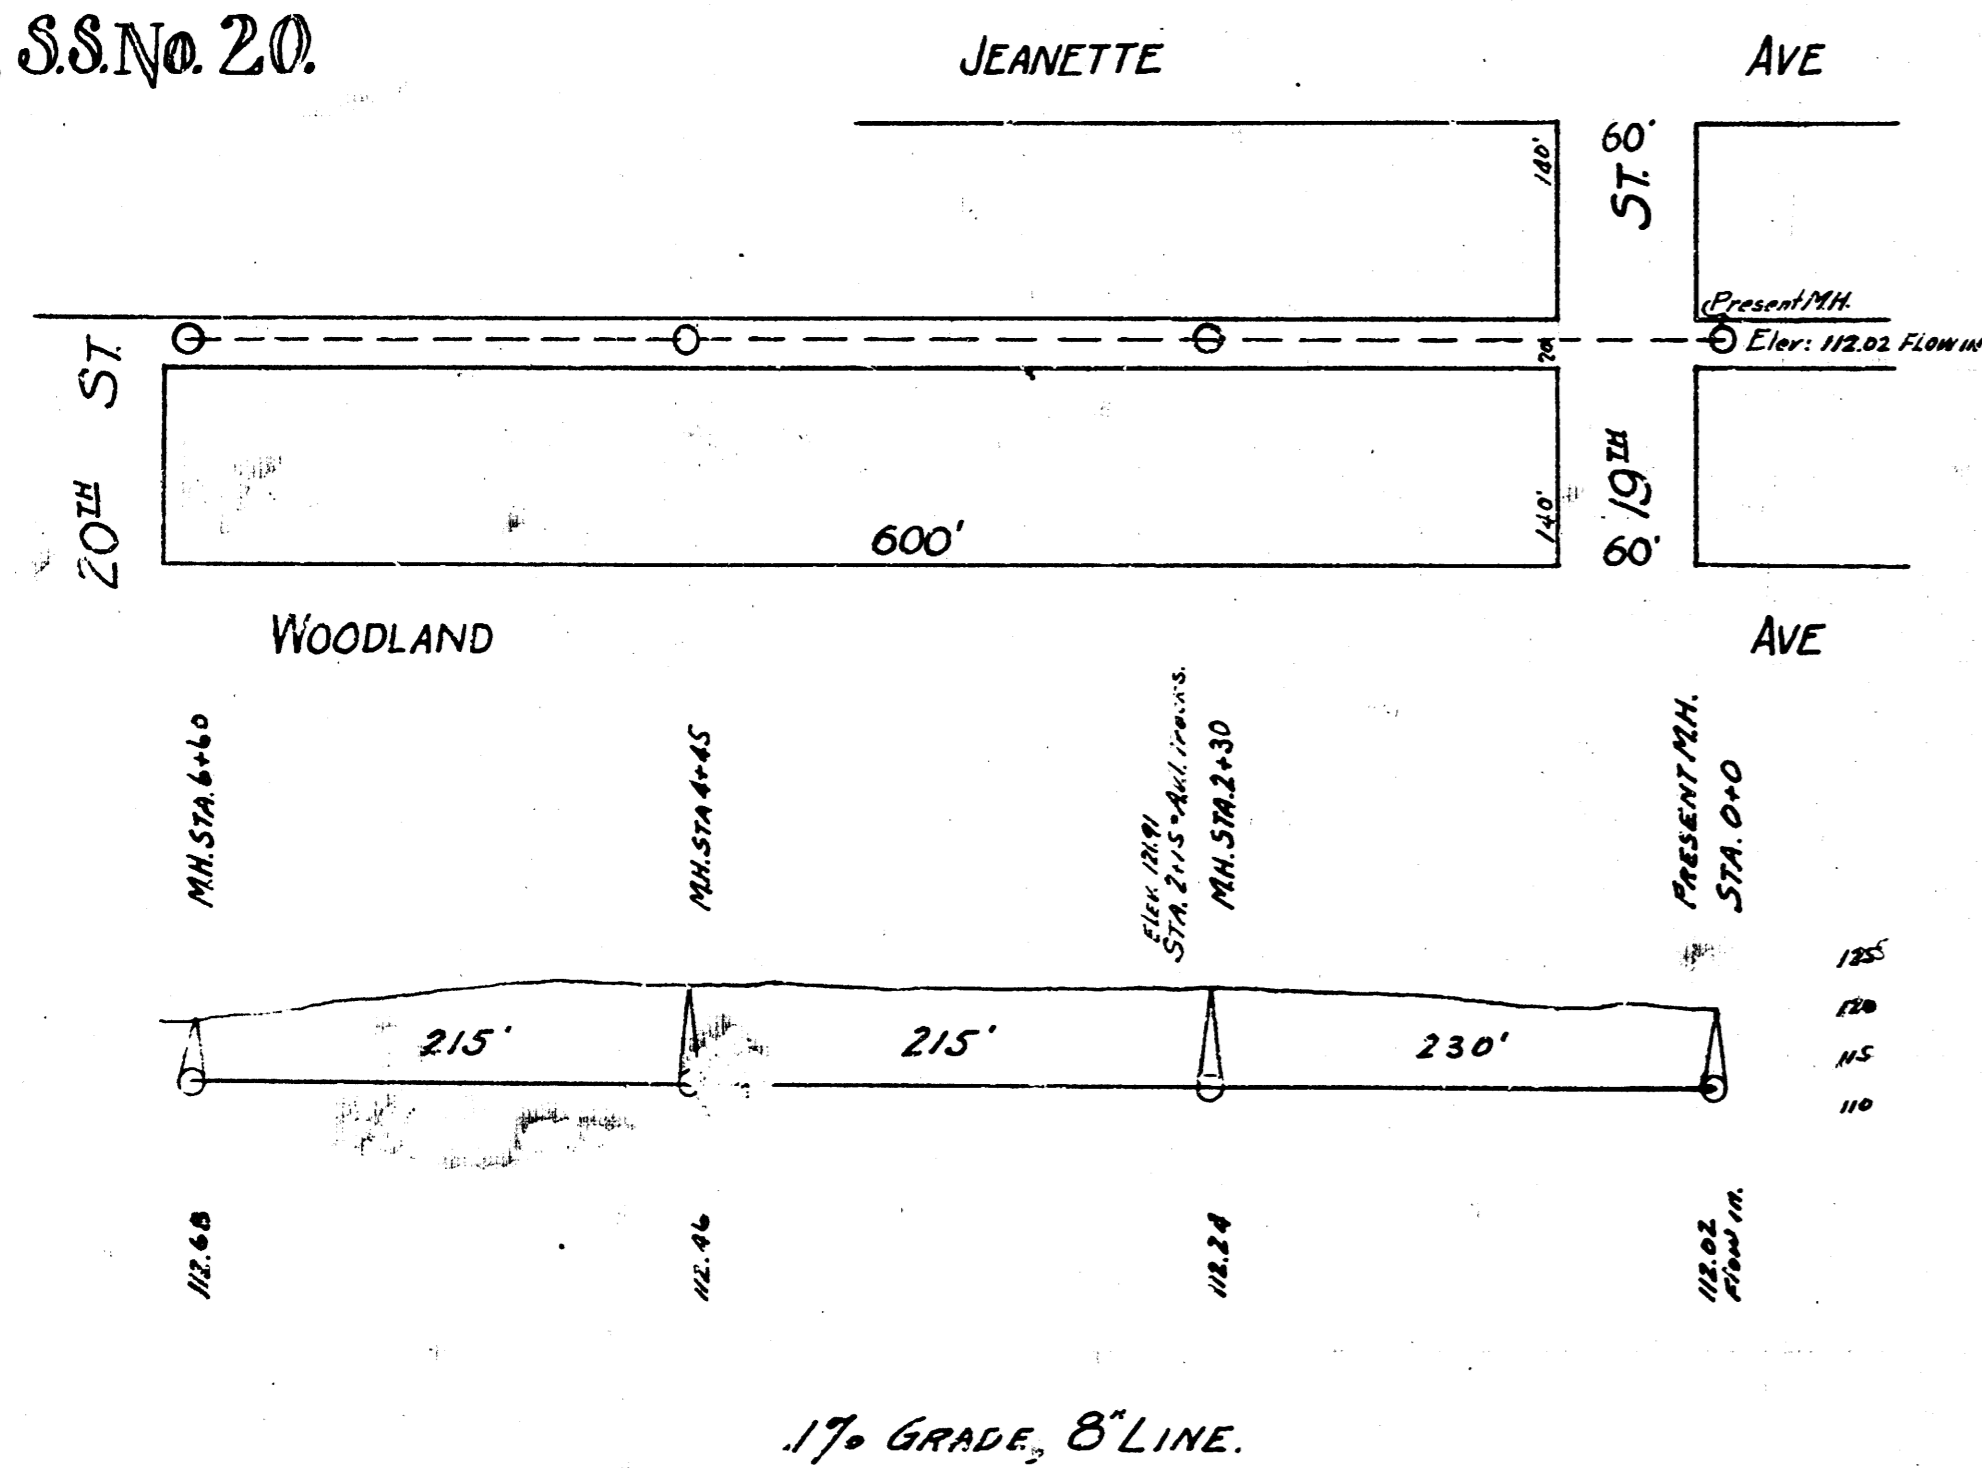

LAT. A, DIST. P, S.S. 12.

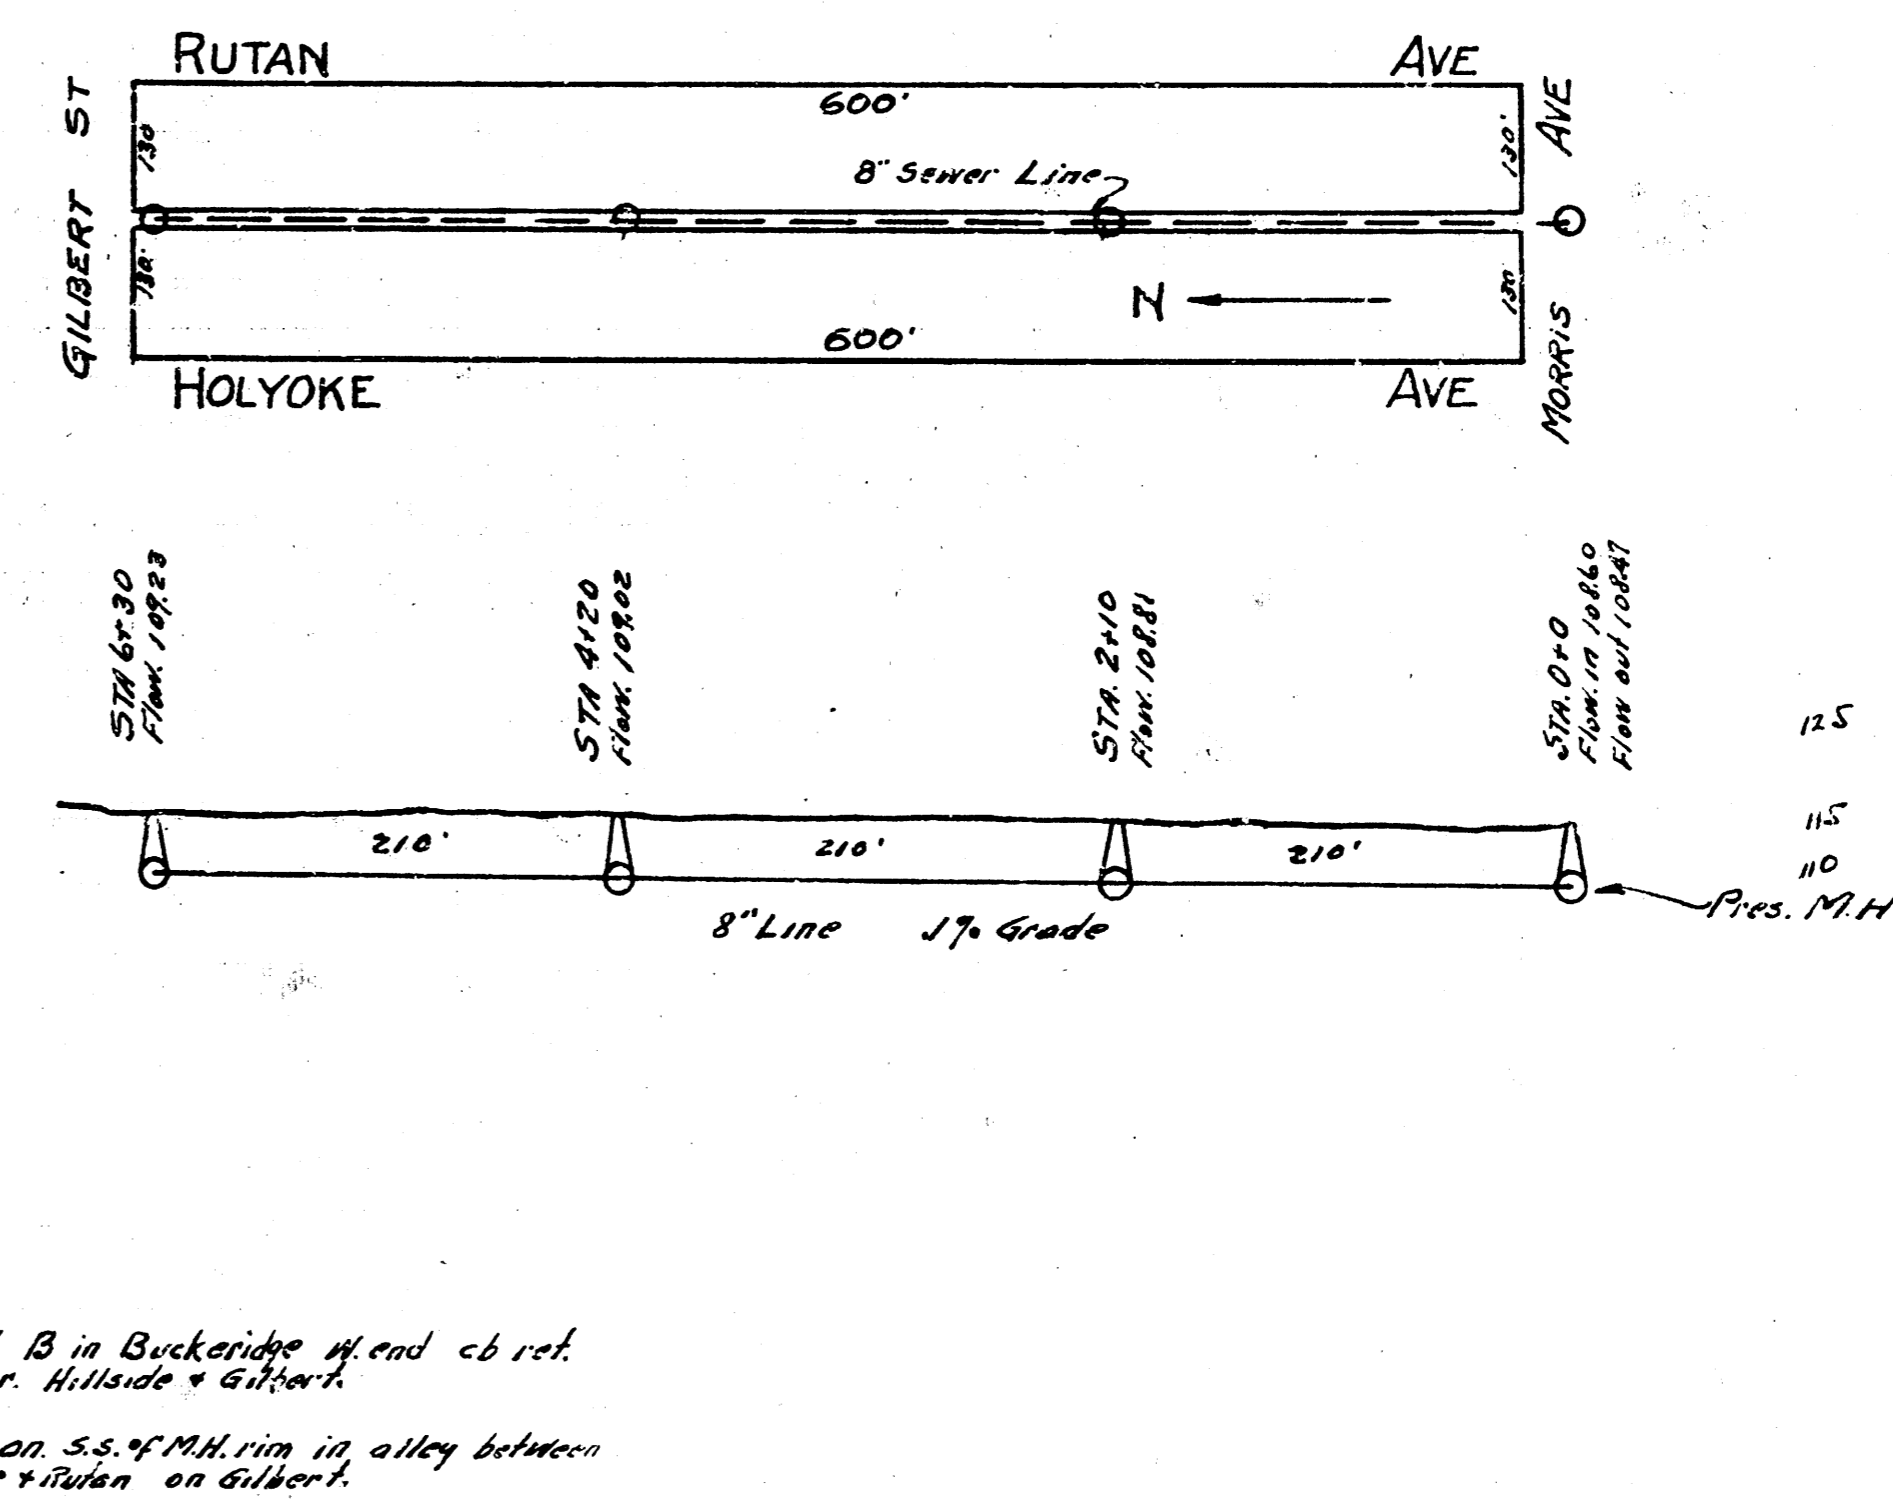

LAT. F, DIST. 6, S.S. 12.

B.M. 165.74 N in Whaley ch. 4' x 4' S.E. cor. Lorraine & 17th.

