



Date 9-18-52  
 Drawn by Maclean  
 Check by [Signature]  
 Book No. 299

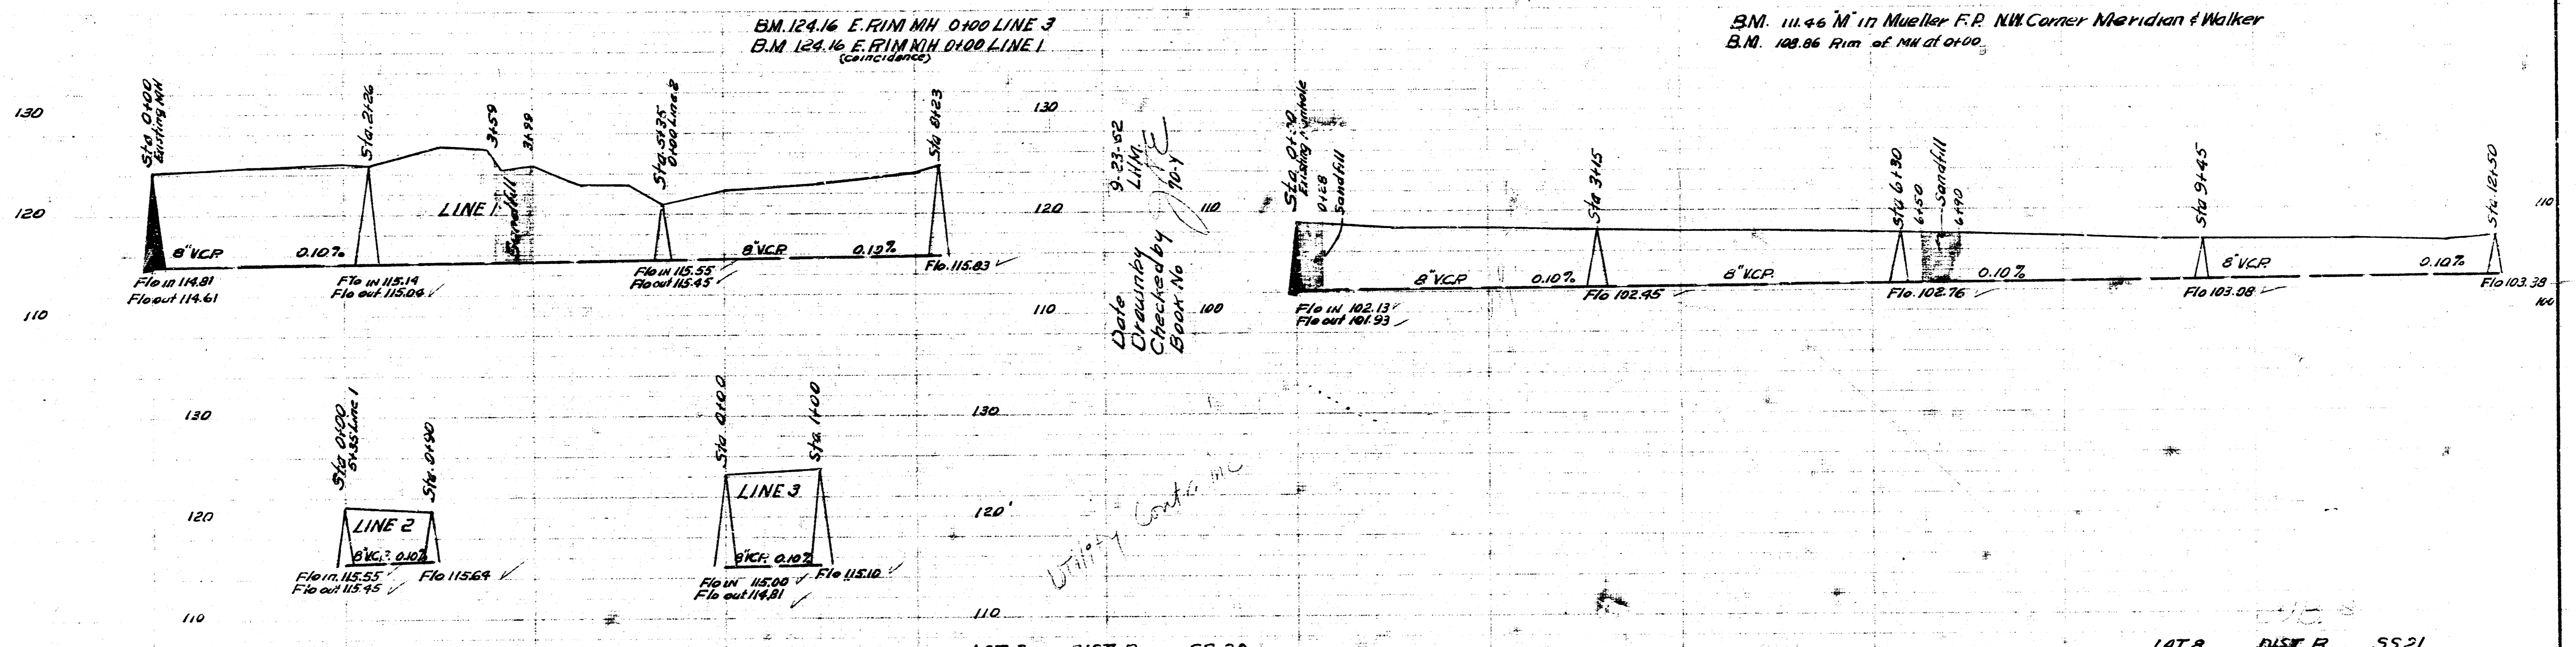

LAT. 3 DIST. R SS. 20  
 CITY OF WICHITA KANSAS  
 LK. WHITE CITY ENGINEER  
 Proj. C-22-71

LAT. 8 DIST. B SS. 21  
 CITY OF WICHITA KANSAS  
 LK. WHITE CITY ENGINEER  
 Proj. No. C-22-74

