

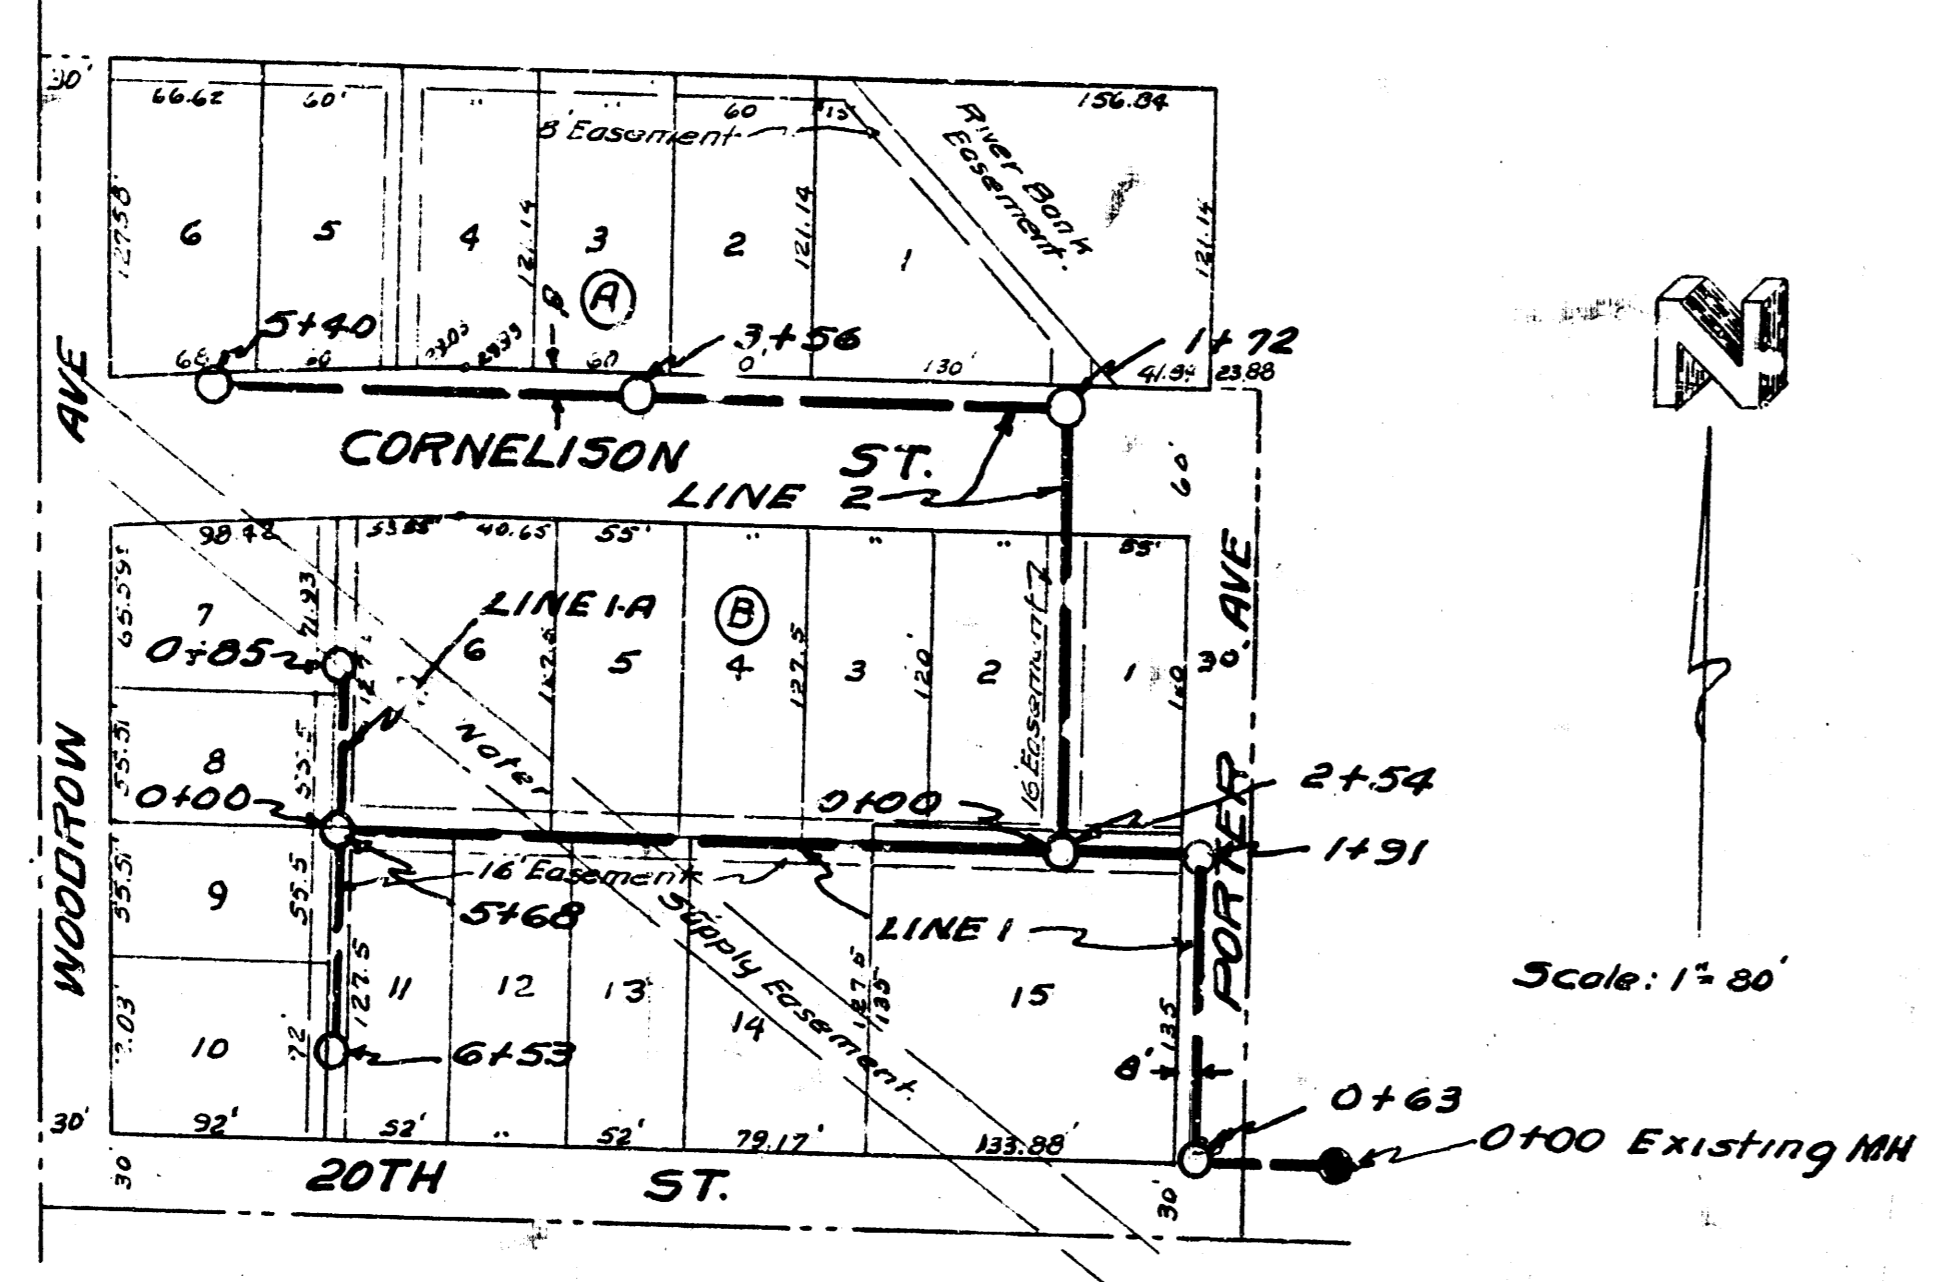



CORNELISON ADDITION

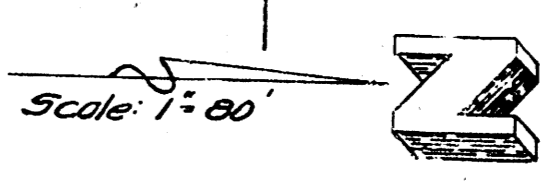

Scale: 1" = 80'

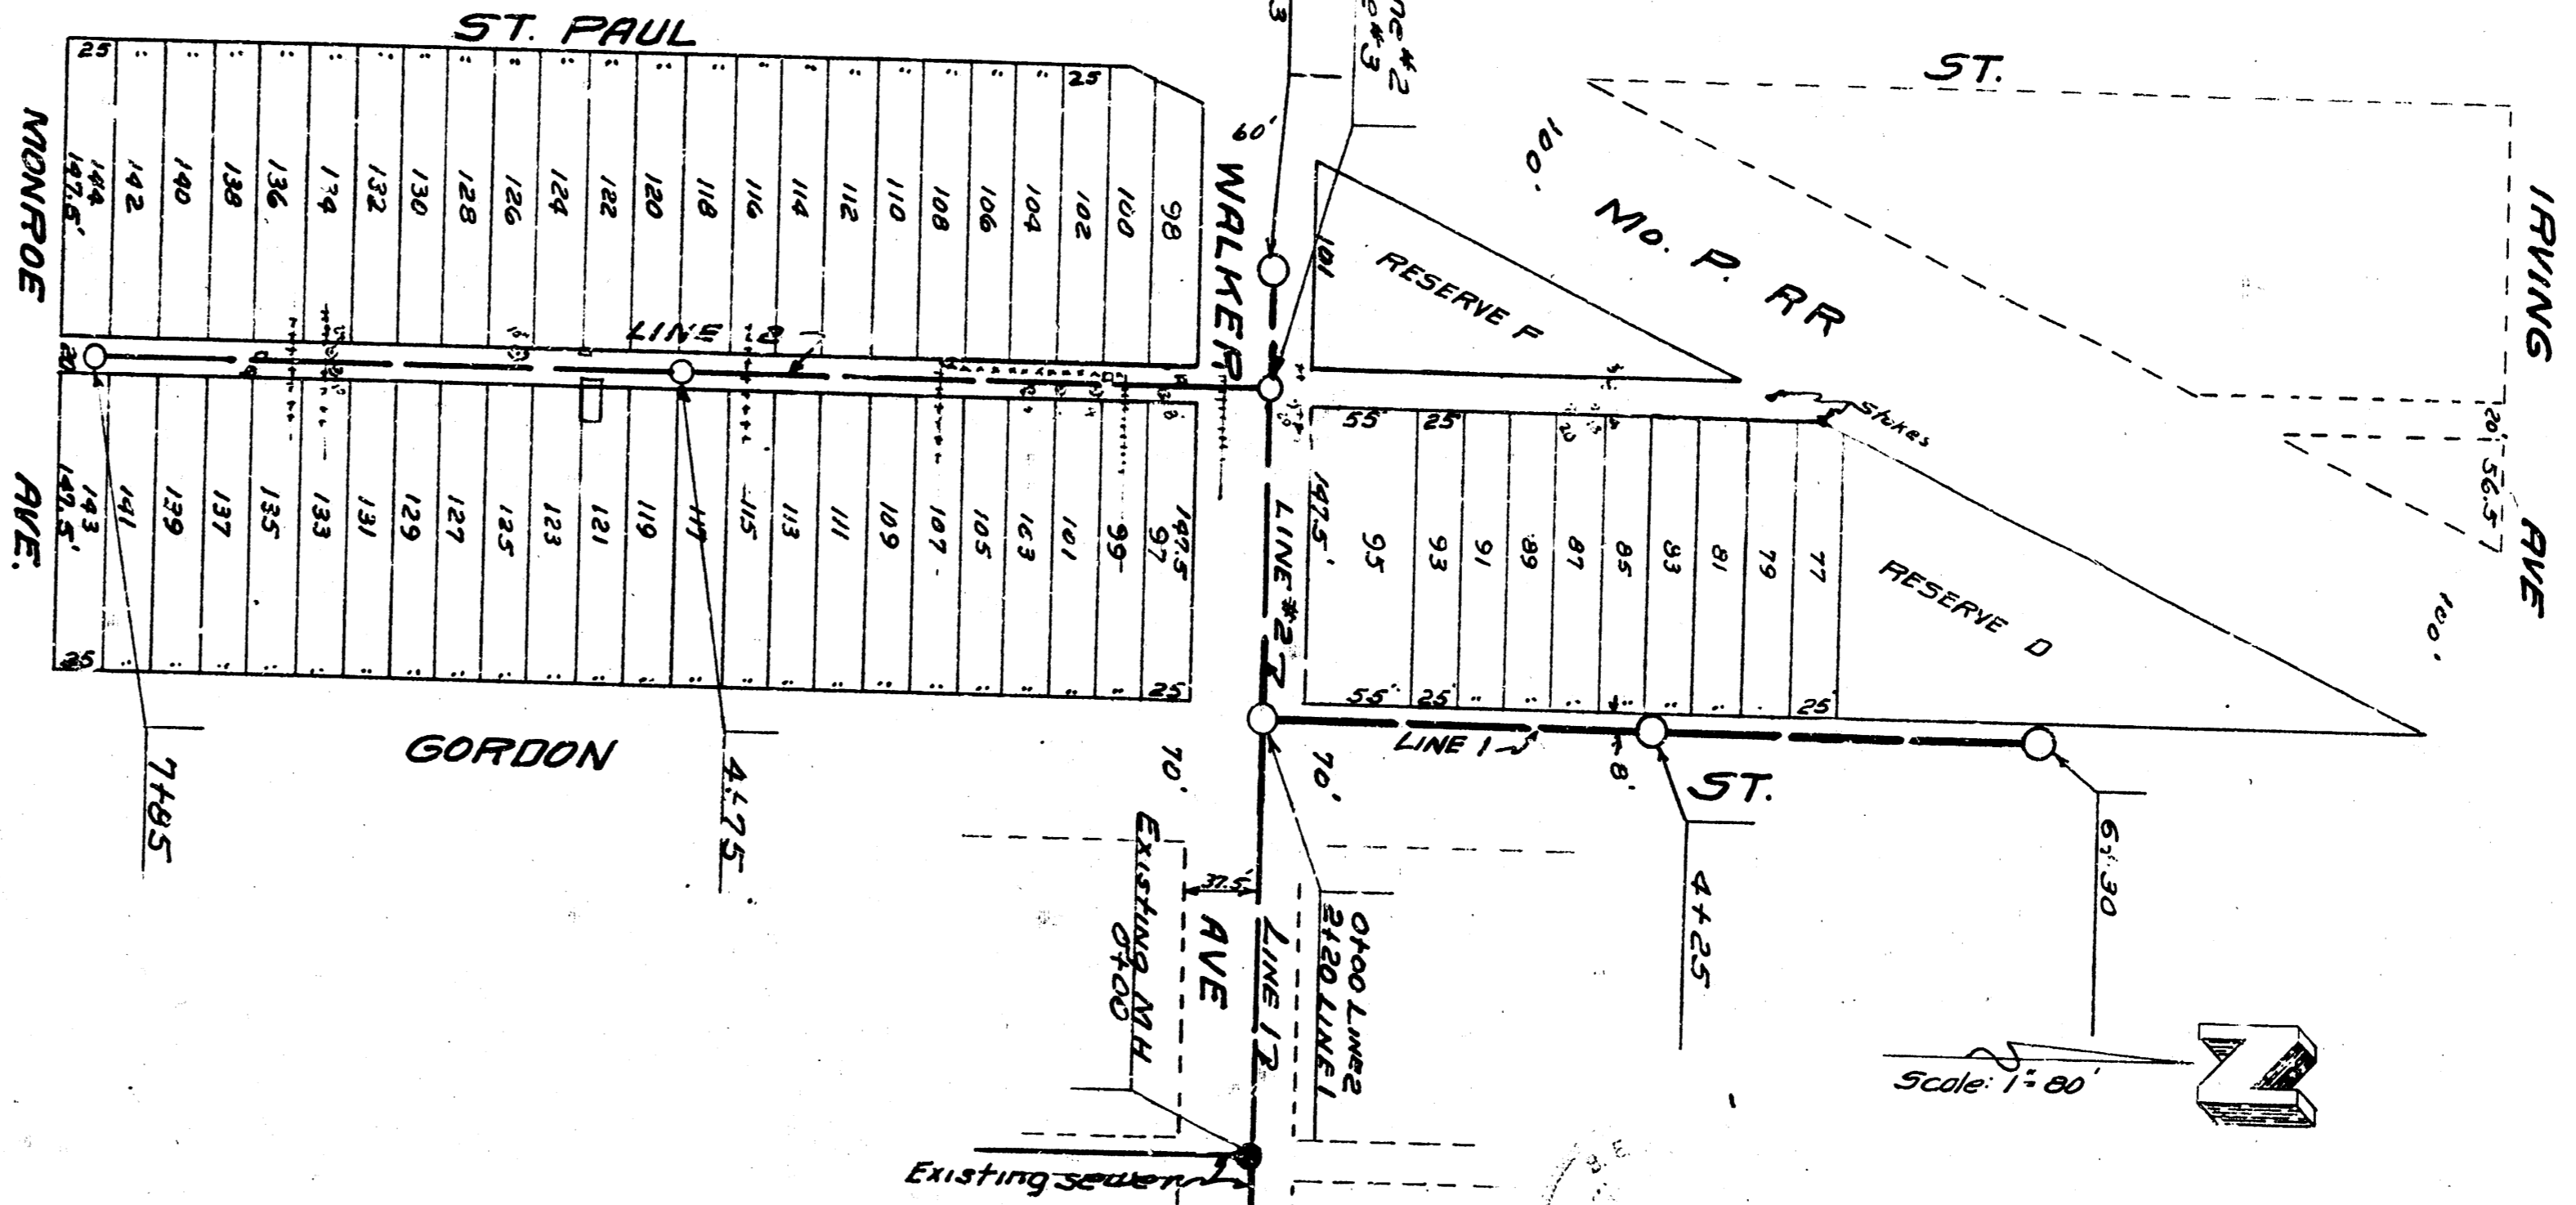

Scale: 1" = 80'

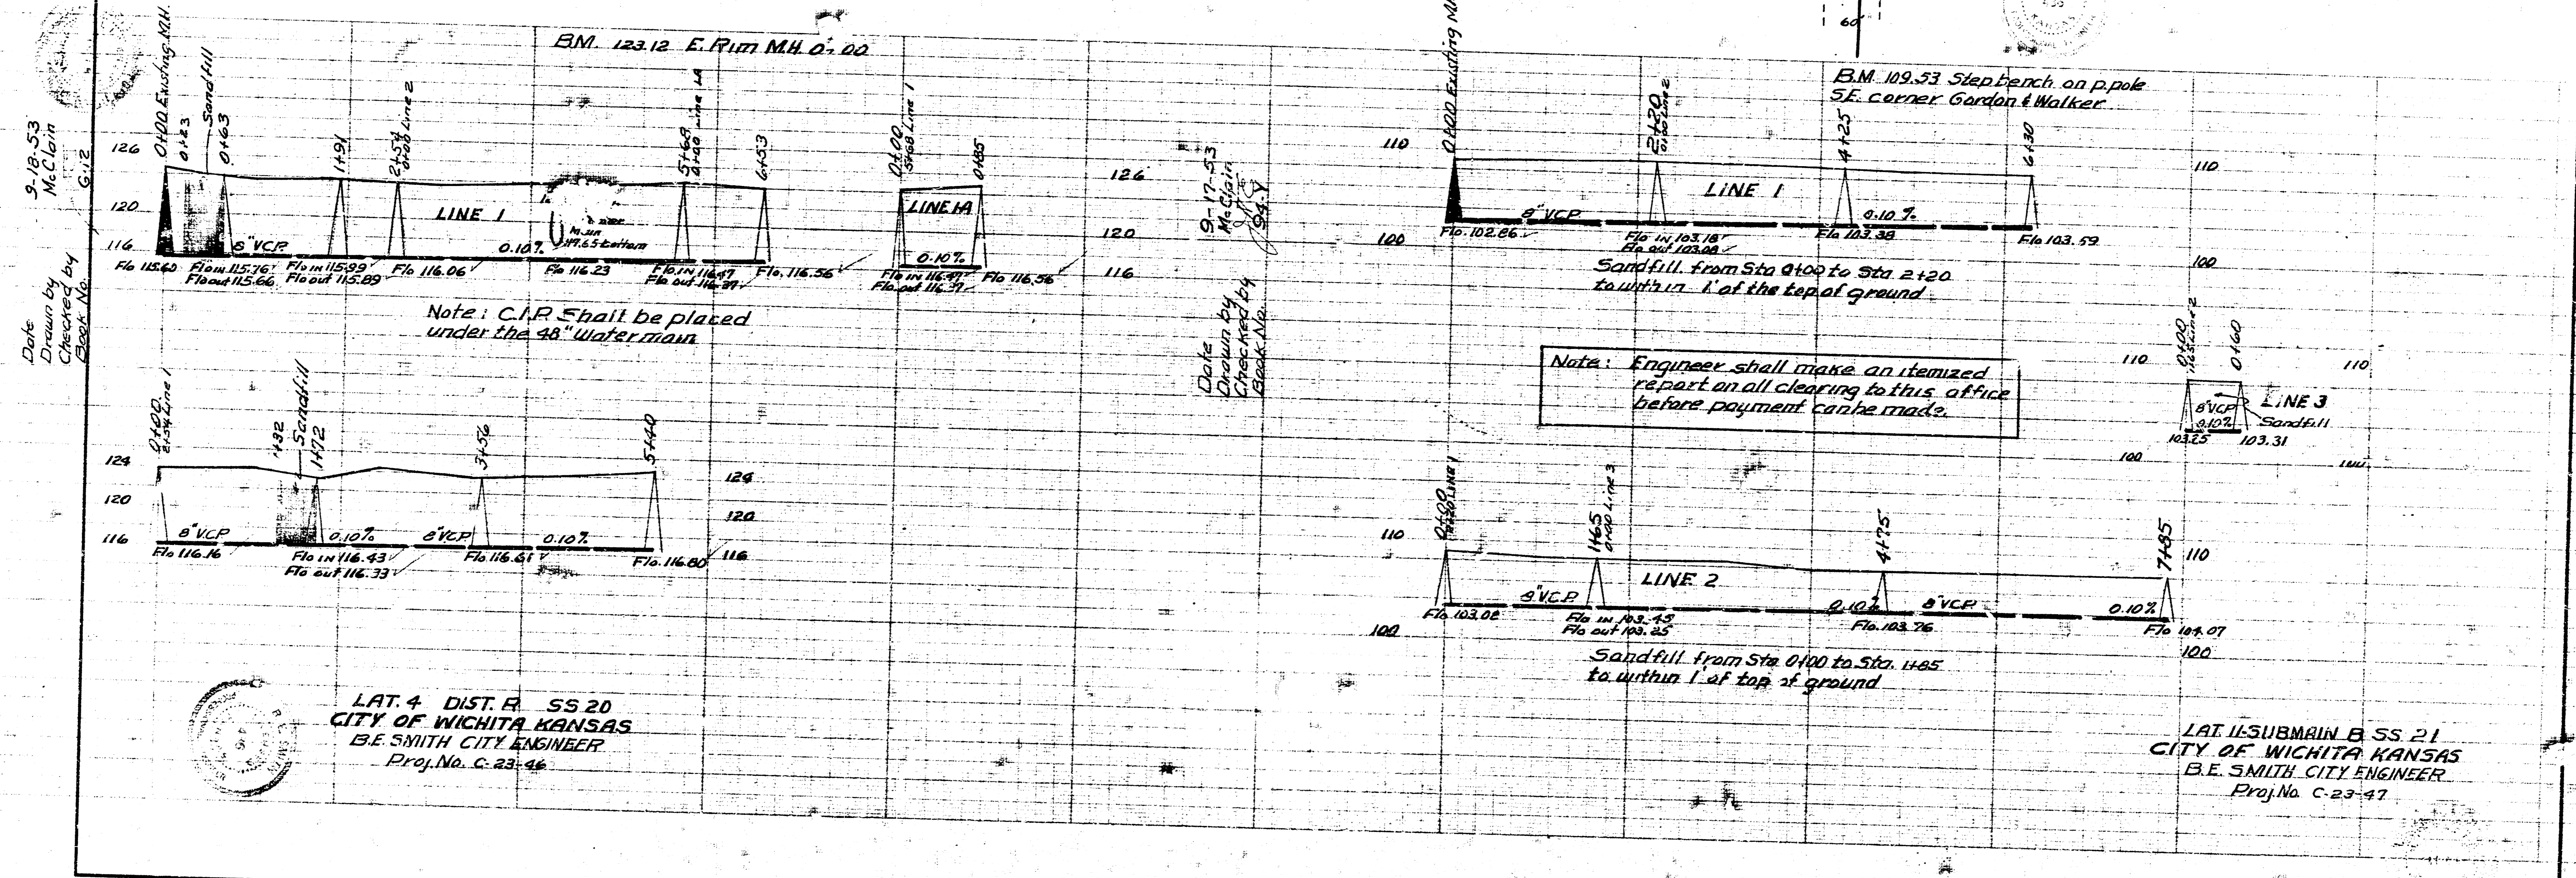

9-18-53  
 Drawn by  
 Checked by  
 Block No.

9-17-53  
 Drawn by  
 Checked by  
 Block No.

LAT. 4. DIST. R. SS 20  
 CITY OF WICHITA KANSAS  
 B.E. SMITH CITY ENGINEER  
 Proj. No. C-23-46

LAT. 16. SUBMAIN B SS 21  
 CITY OF WICHITA KANSAS  
 B.E. SMITH CITY ENGINEER  
 Proj. No. C-23-47