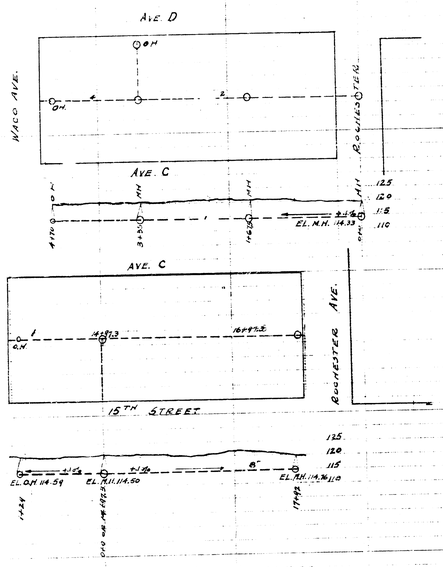

Sec A, Sub R, Lateral G, District R, S.S. #30