


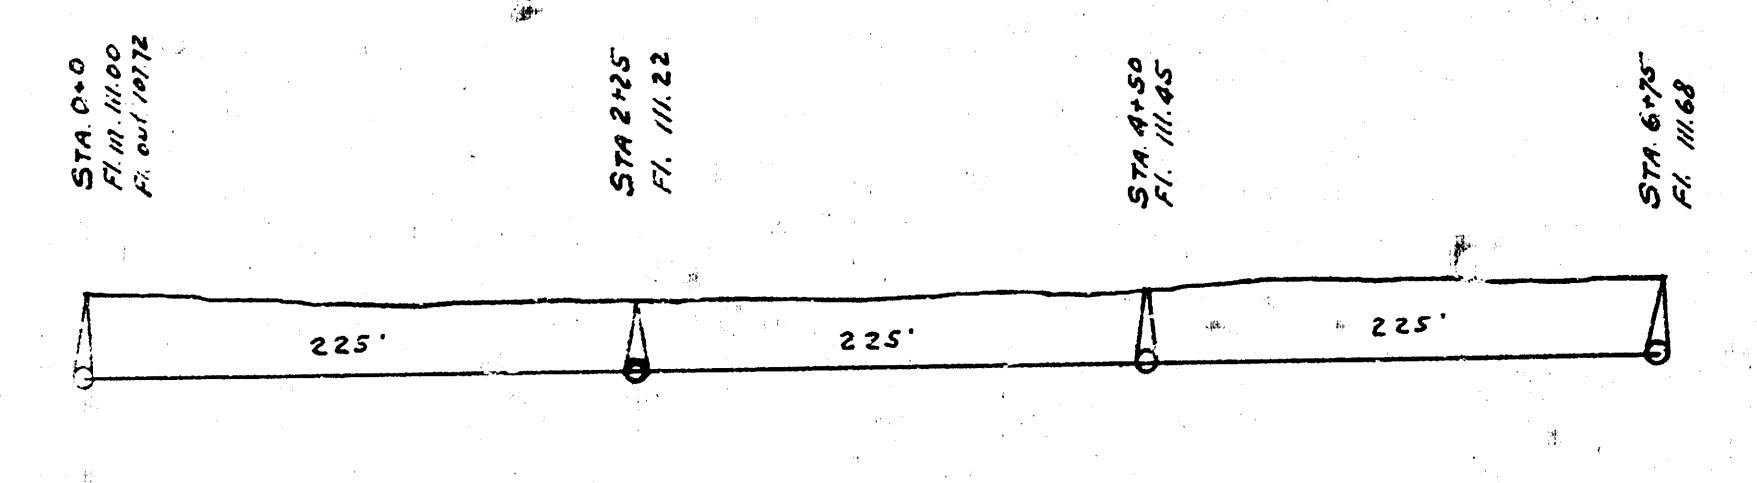

B.M. 11940 K in Kensler back walk north N.W. cor. Woodland + 15<sup>th</sup>  
 B.M. 11863 L in Lefever dr. walk east N.E. cor. Woodland + 14<sup>th</sup>

