




Lot 12, Dist. A, SS# 20

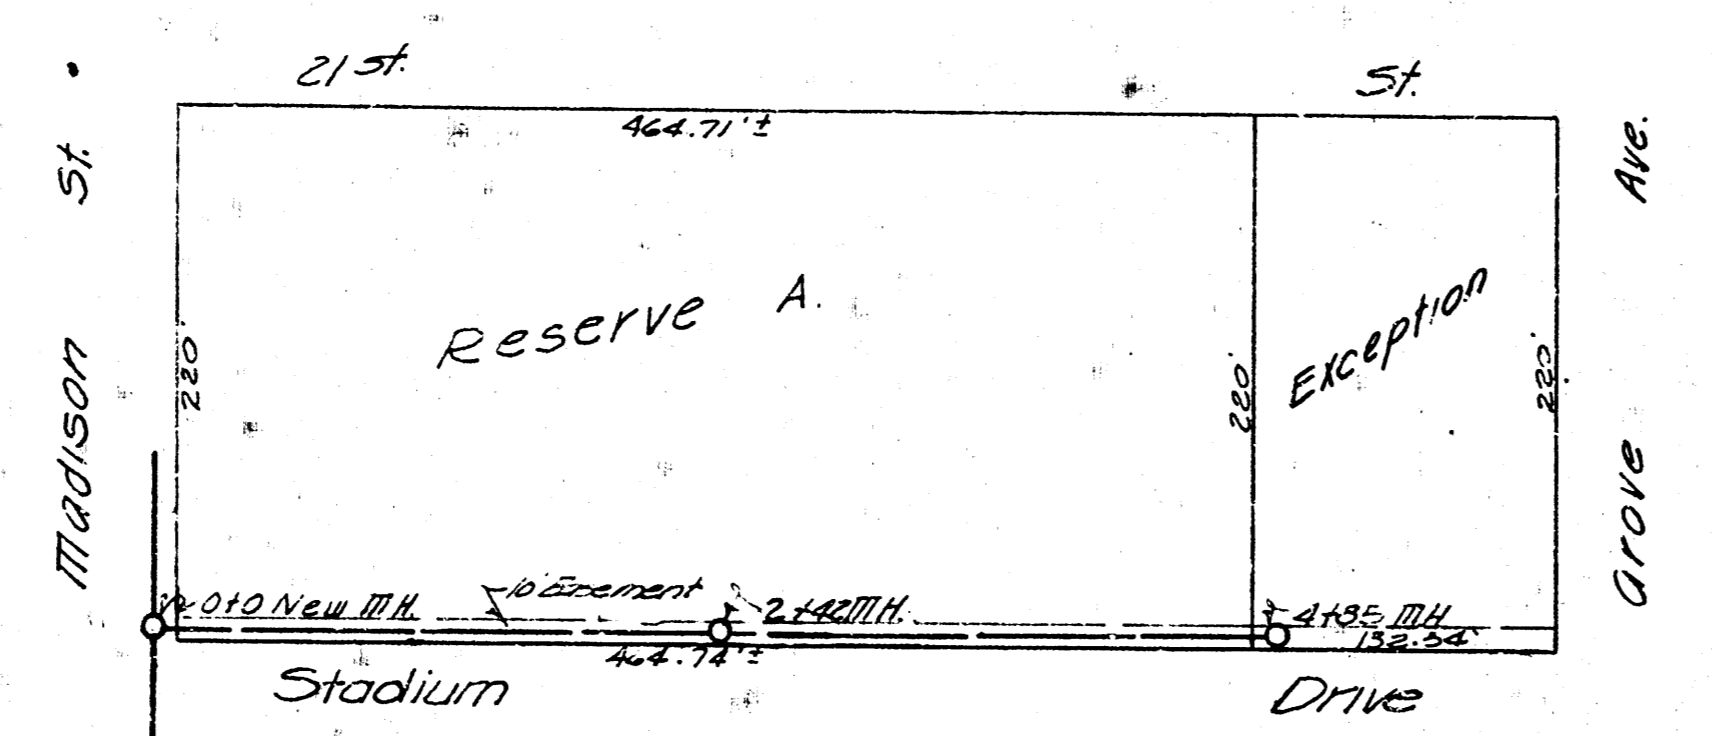


Lot 9, Dist. E, SS# 12

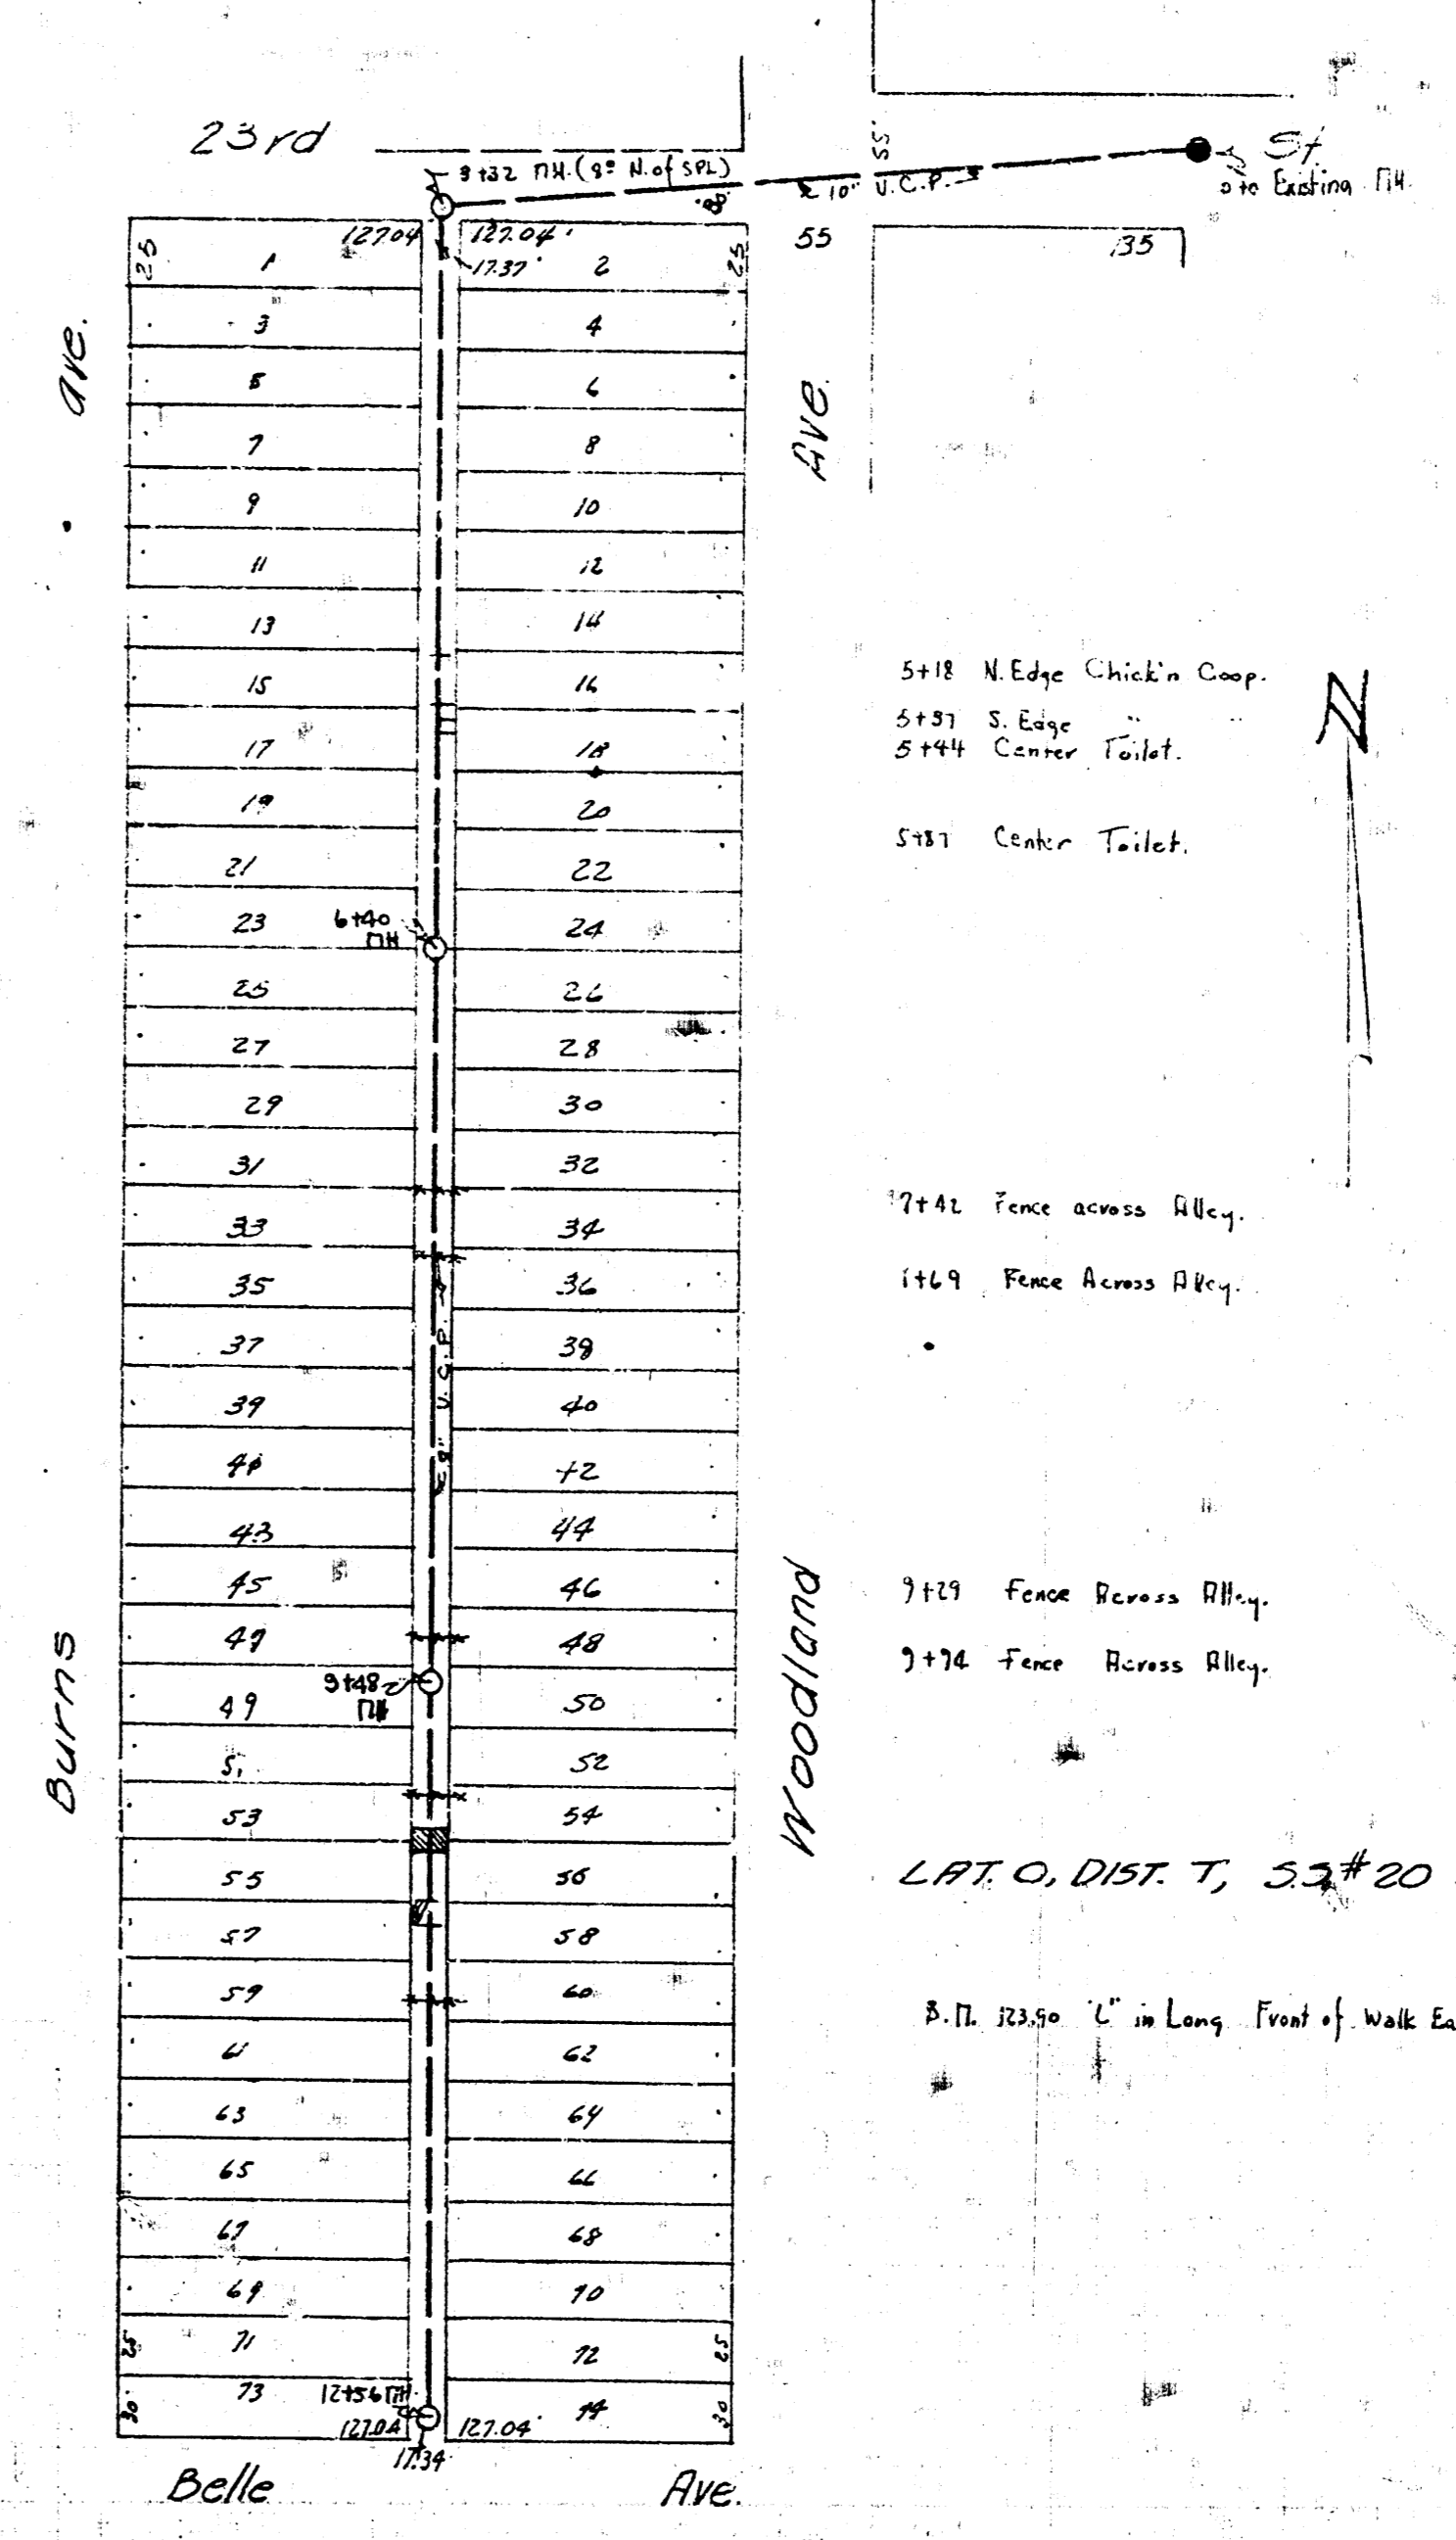


Lot 0, Dist. T, SS# 20

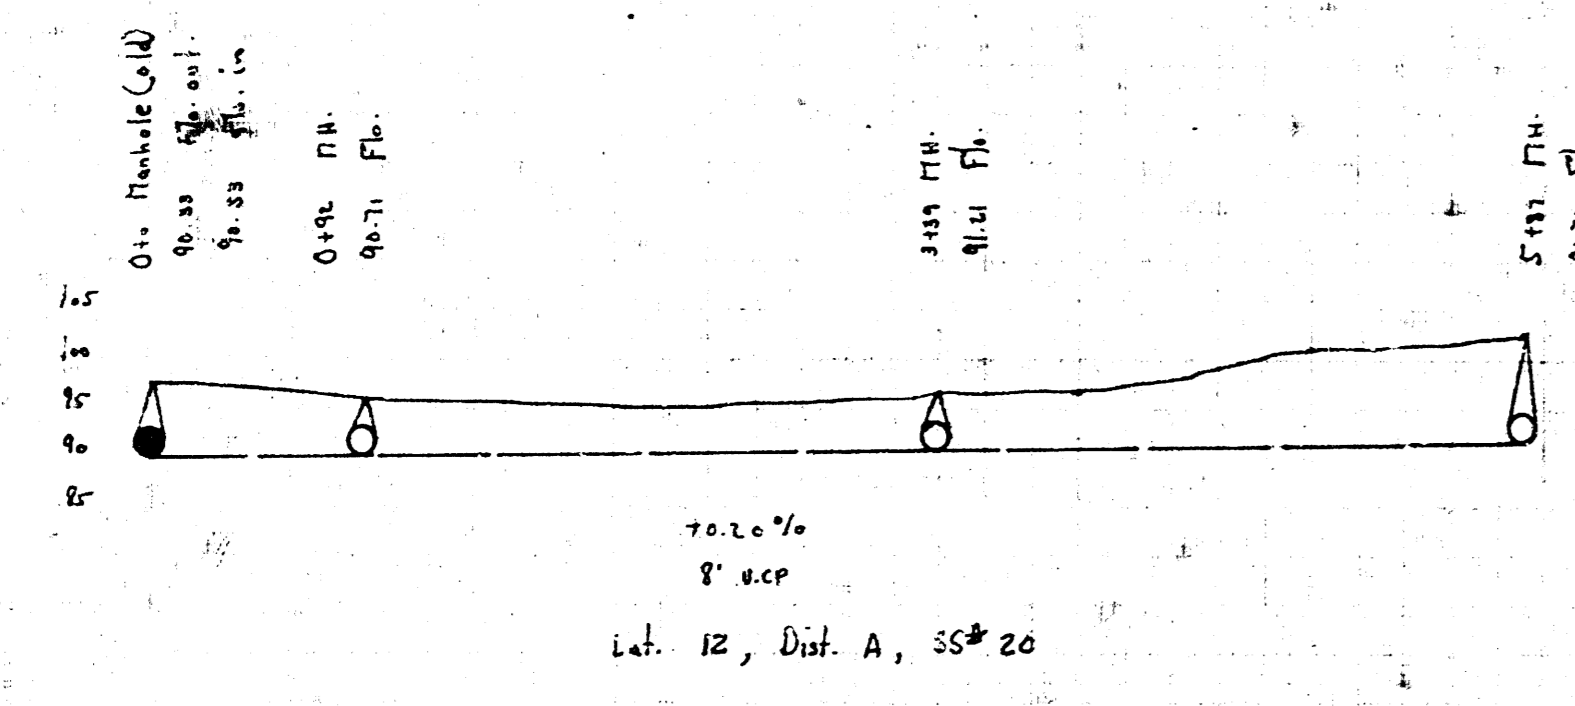

Lot 12, Dist. A, SS# 20

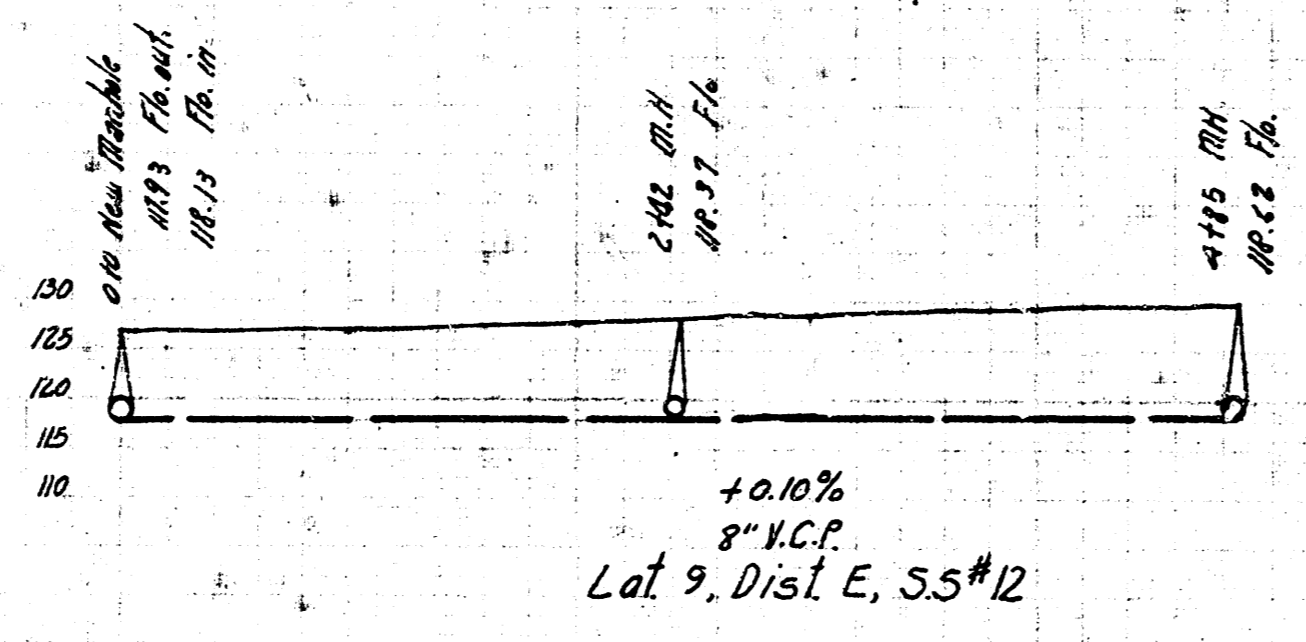

Lot 9, Dist. E, SS# 12

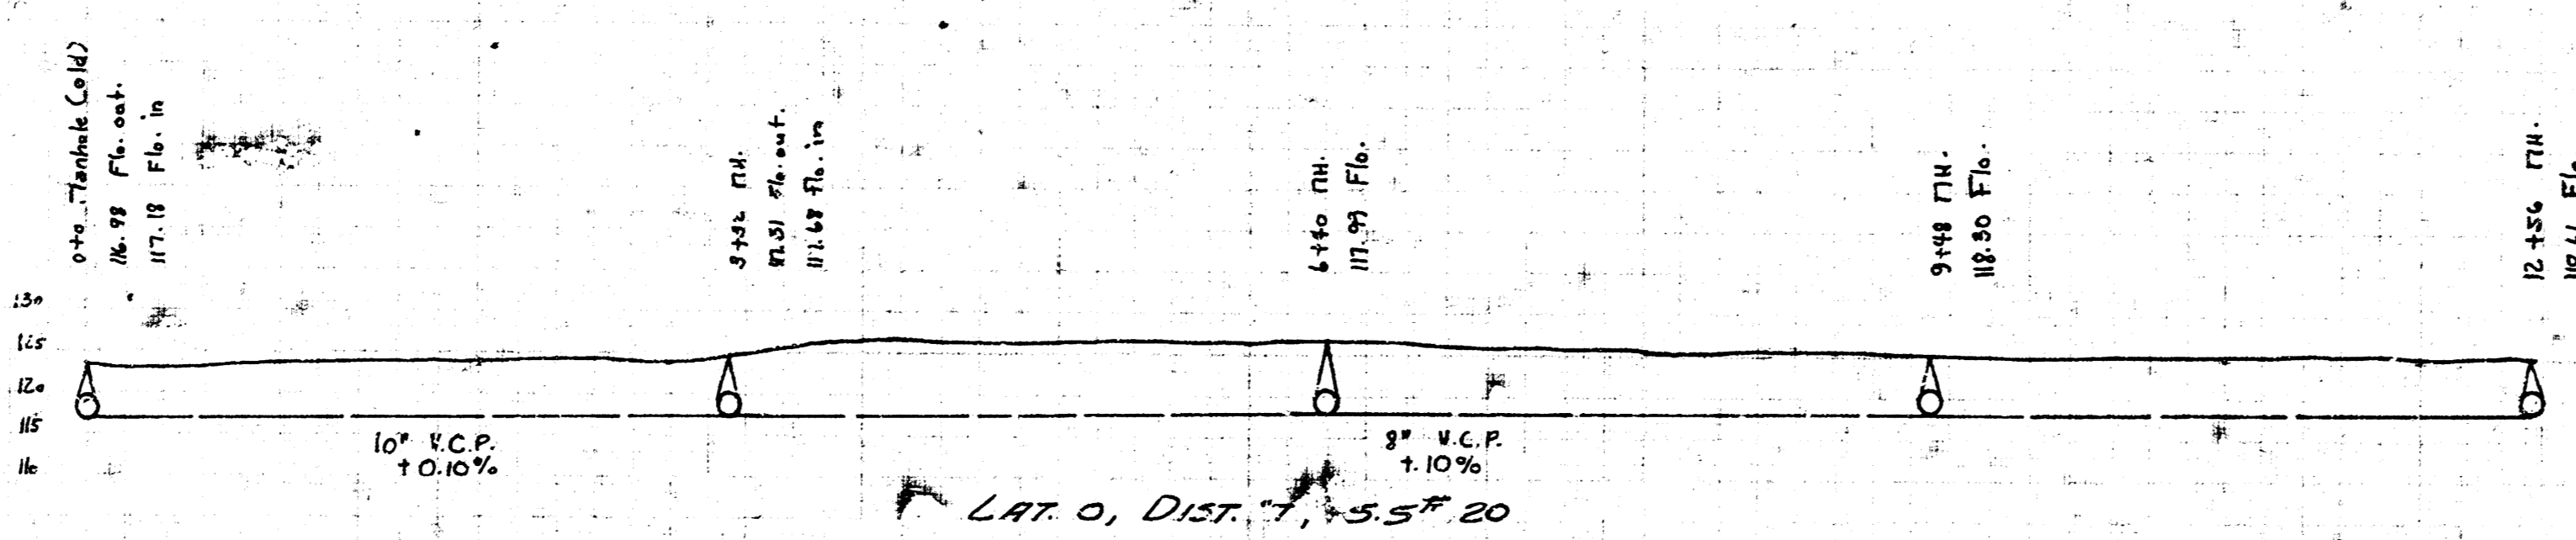

Lot 0, Dist. T, SS# 20






Lot 12, Dist. A, SS# 20
Lot 9, Dist. E, SS# 12
Lot 0, Dist. T, SS# 20

City of Wichita, Kansas.
L.E. White City Engineer

1774 1949

