


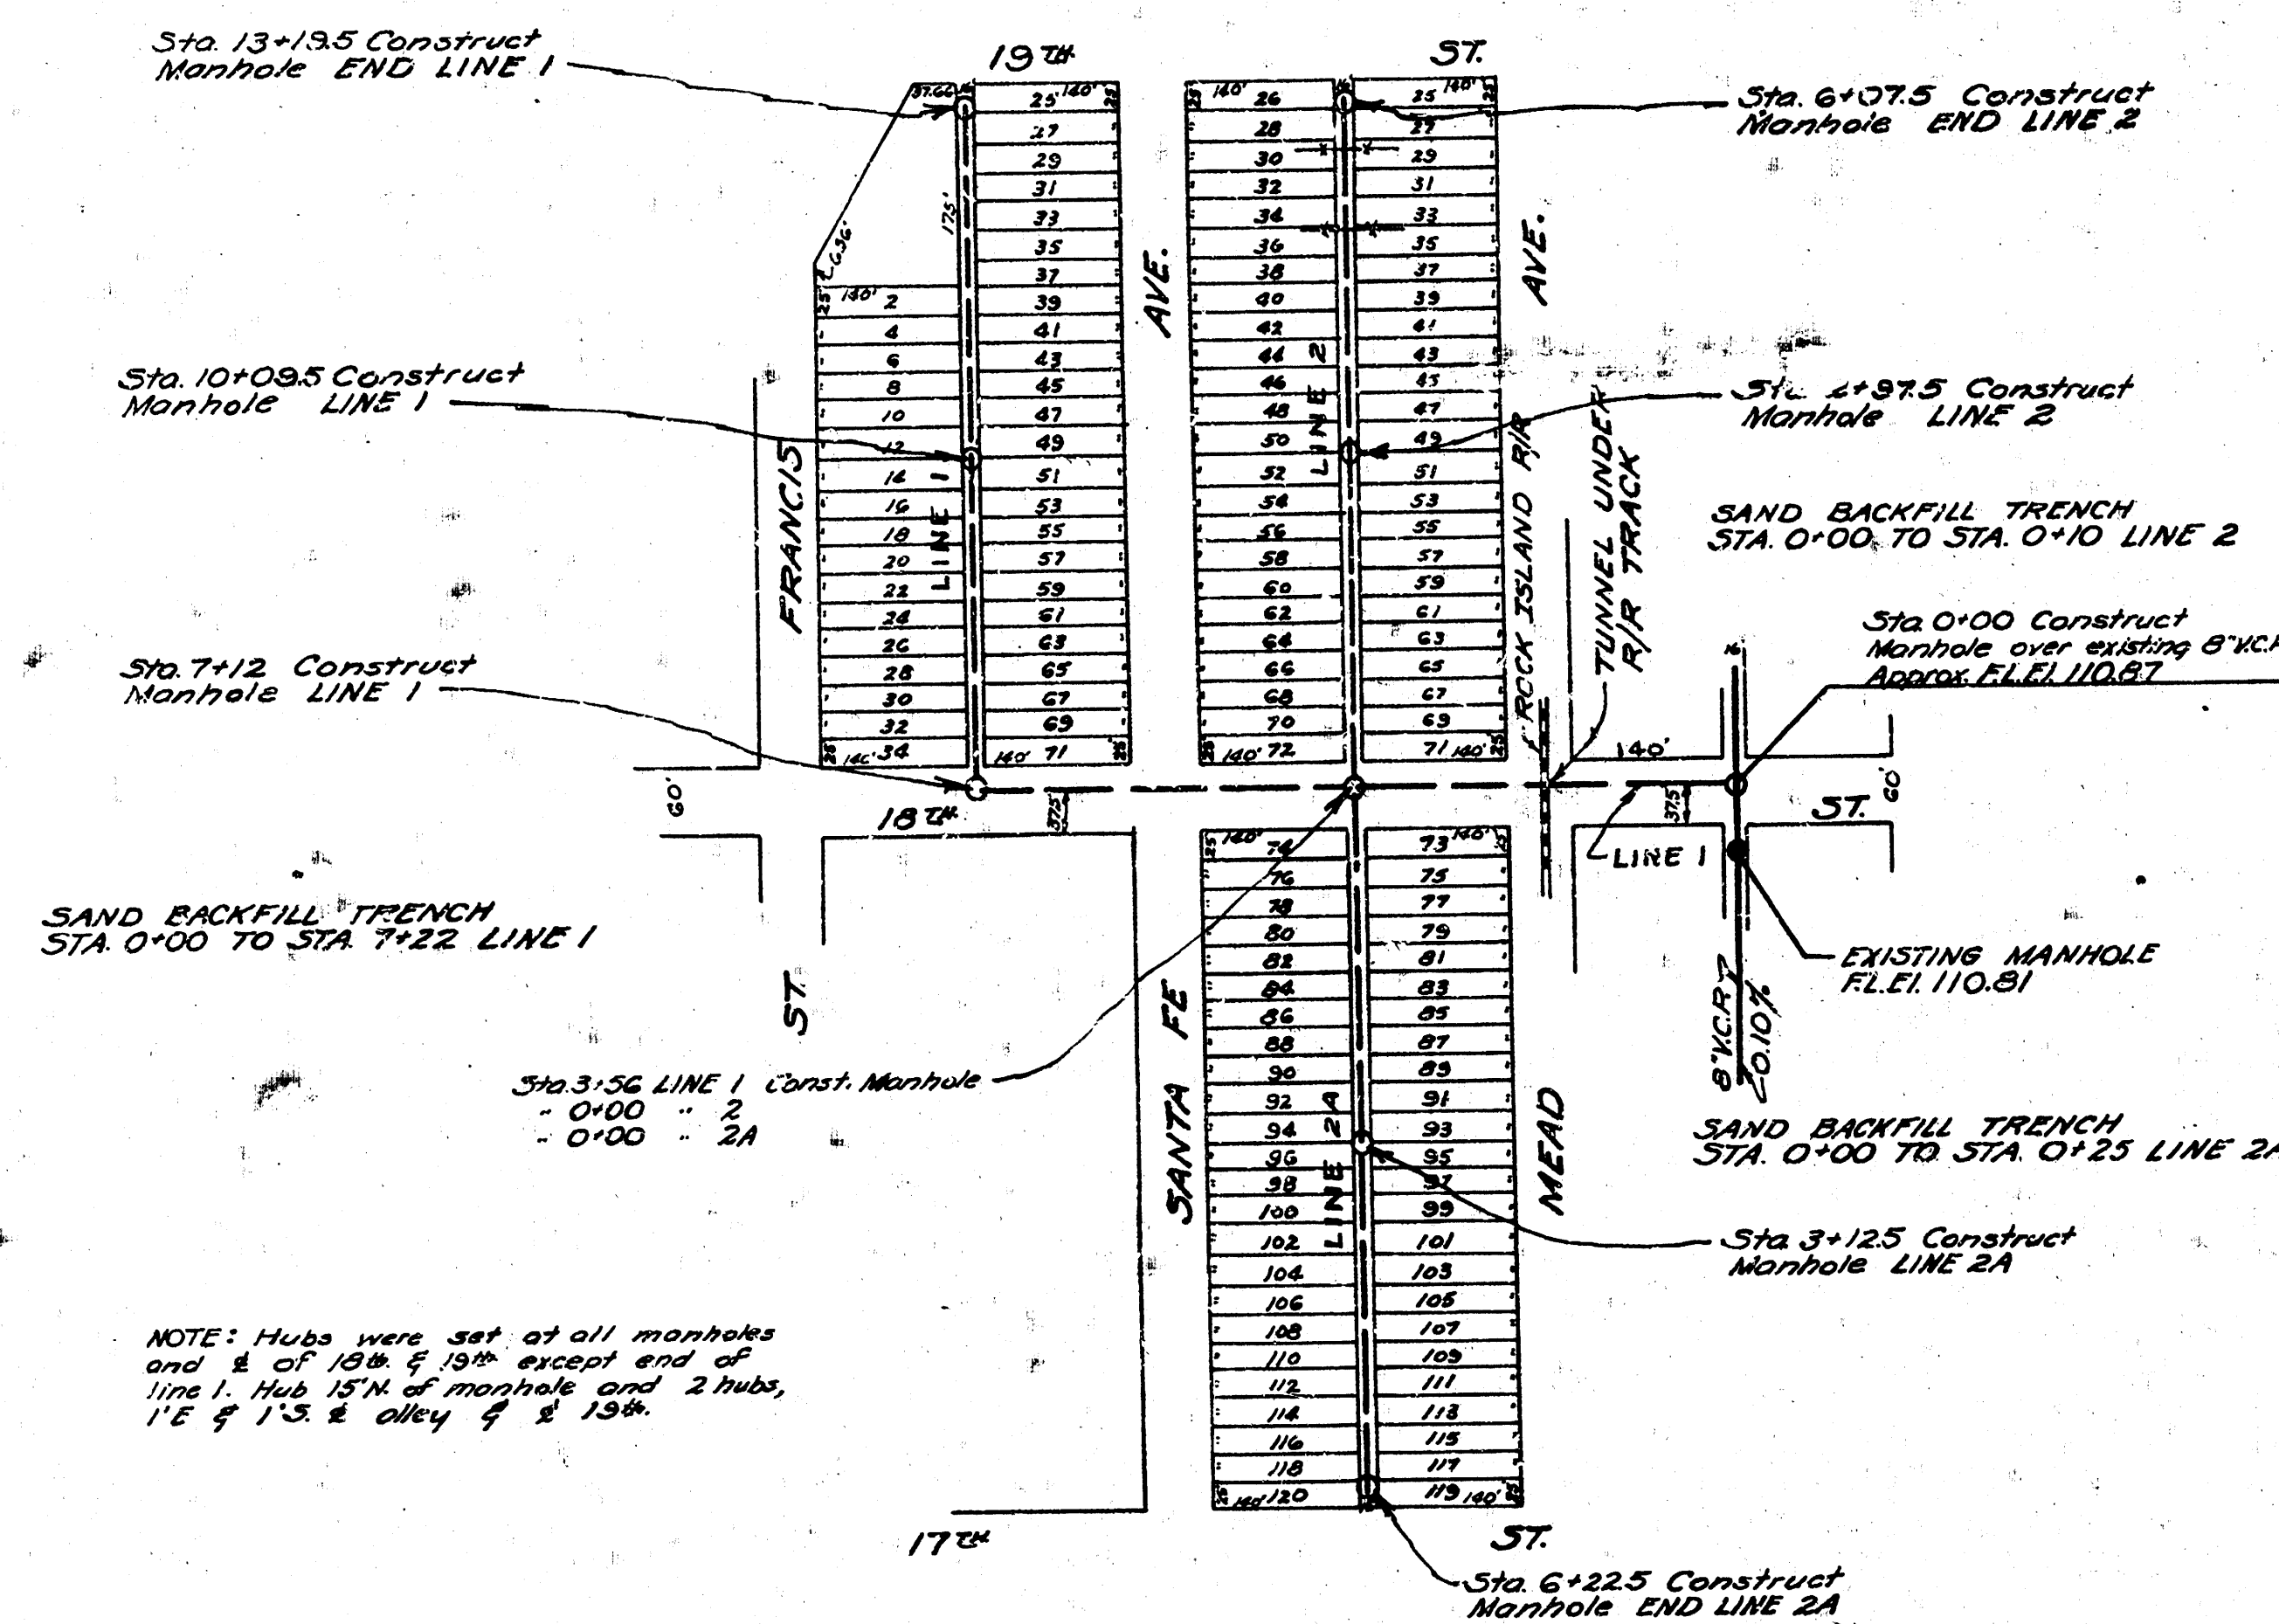



B.M. T in Troy Top Fire hydrant S.E. cor. 18th & Mosley El. 121.43
 B.M. Top 2x2 stake & alley S.E. 19th St. between Santa Fe & St. Francis El. 118.96



B.M. Top 2x2 stake Sta. 6+07.5 Line 2 El. 118.39

B.M. N rim manhole 575 S. Sta. 0+00 El. 118.33

B.M. N rim manhole near & 17th & alley between St. Francis & Santa Fe El. 120.86

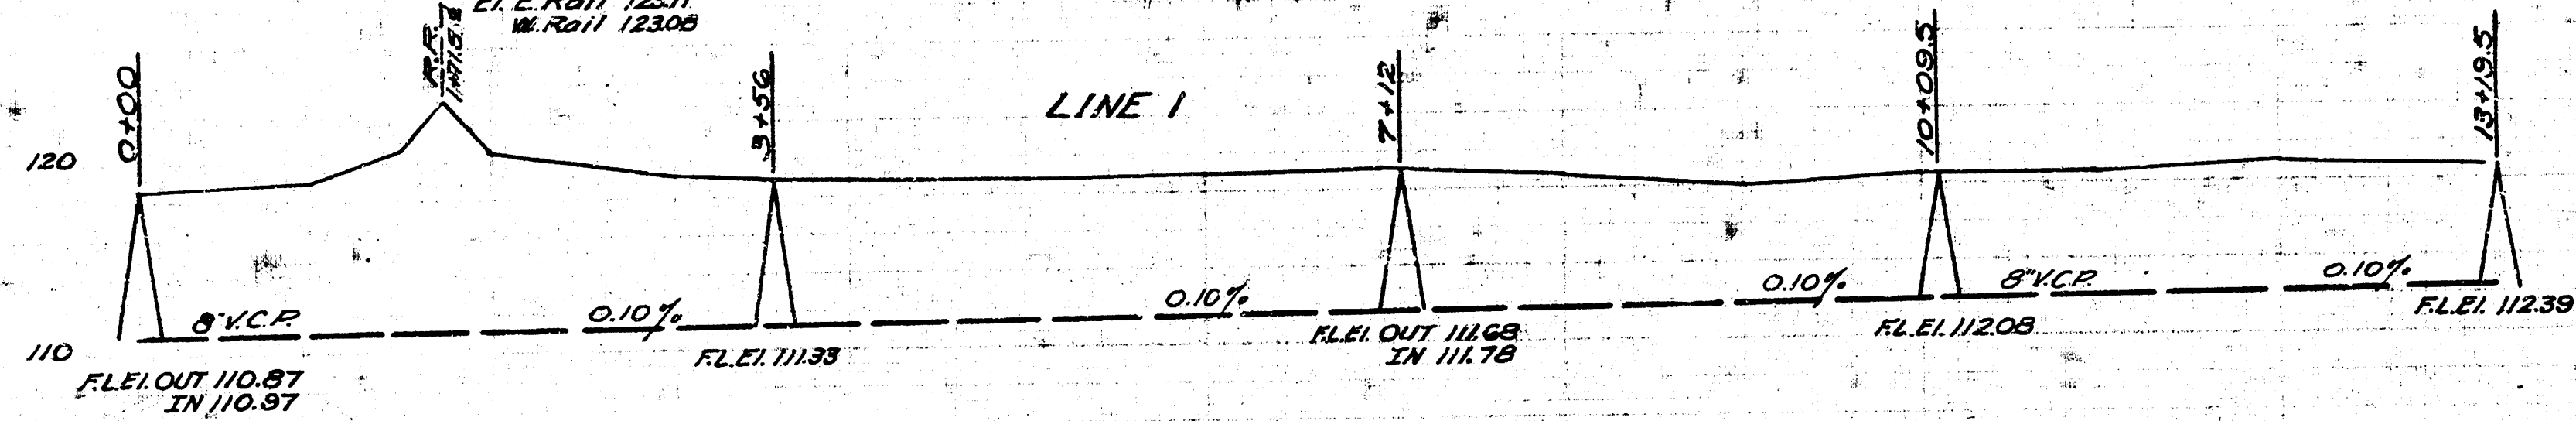


SCALE 1" = 80' Horiz.
 1" = 8' Vert.

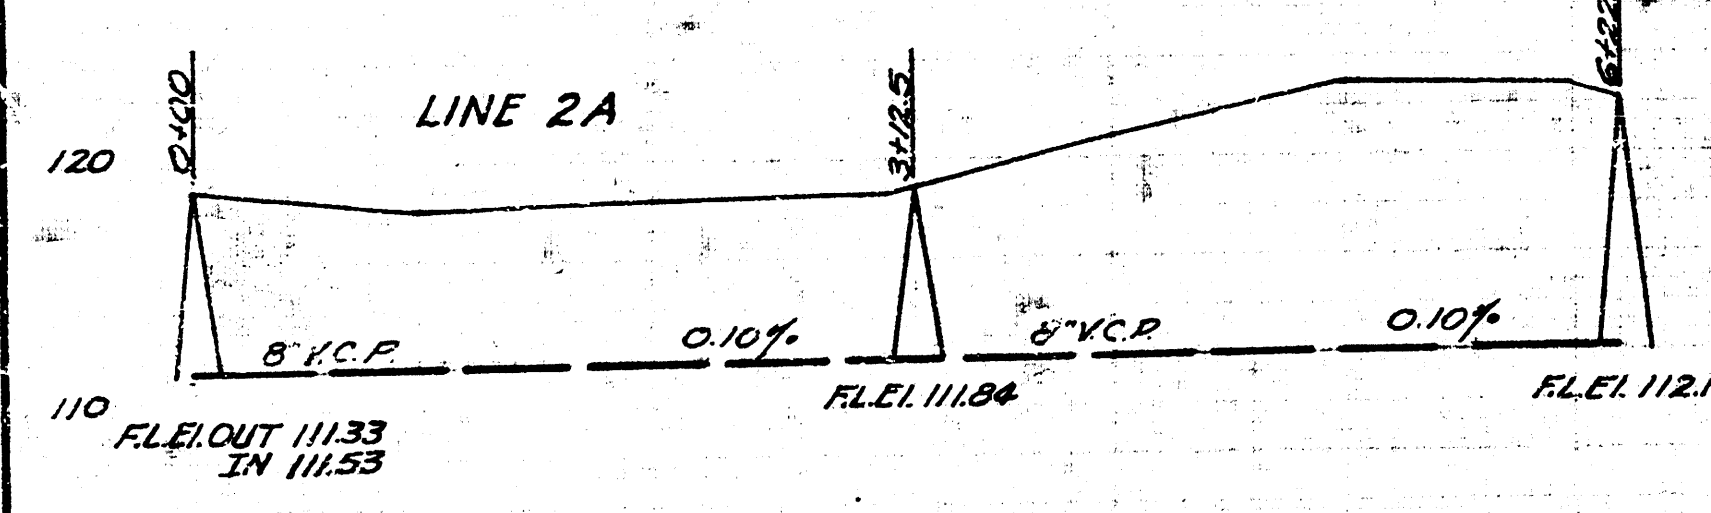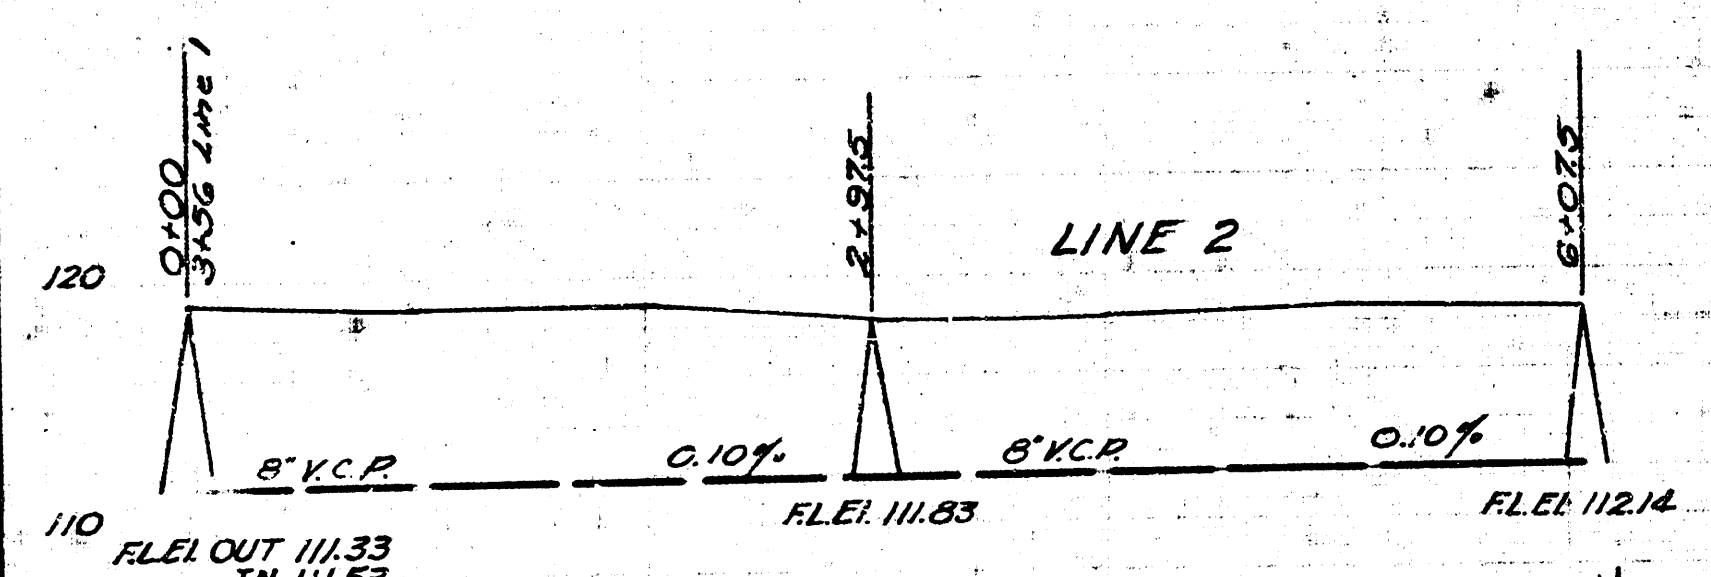



(LINE 1 AND LINE 2)
 LAT. T DIST. T MAIN 20
 CITY OF WICHITA KANSAS
 LK WHITE CITY ENGINEER
 Proj. No. C21-50

(LINE 2A)
 LAT. I WEST-SUB D. MAIN 1
 CITY OF WICHITA KANSAS
 LK WHITE CITY ENGINEER
 Proj. No. C21-20

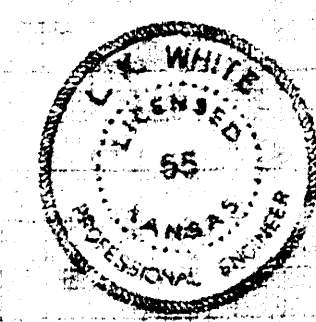

SCALE 1" = 150'

DETAIL SHOWING SANITARY SEWER UNDER RAIL ROAD ON MEAD AVE. AT 18th STREET

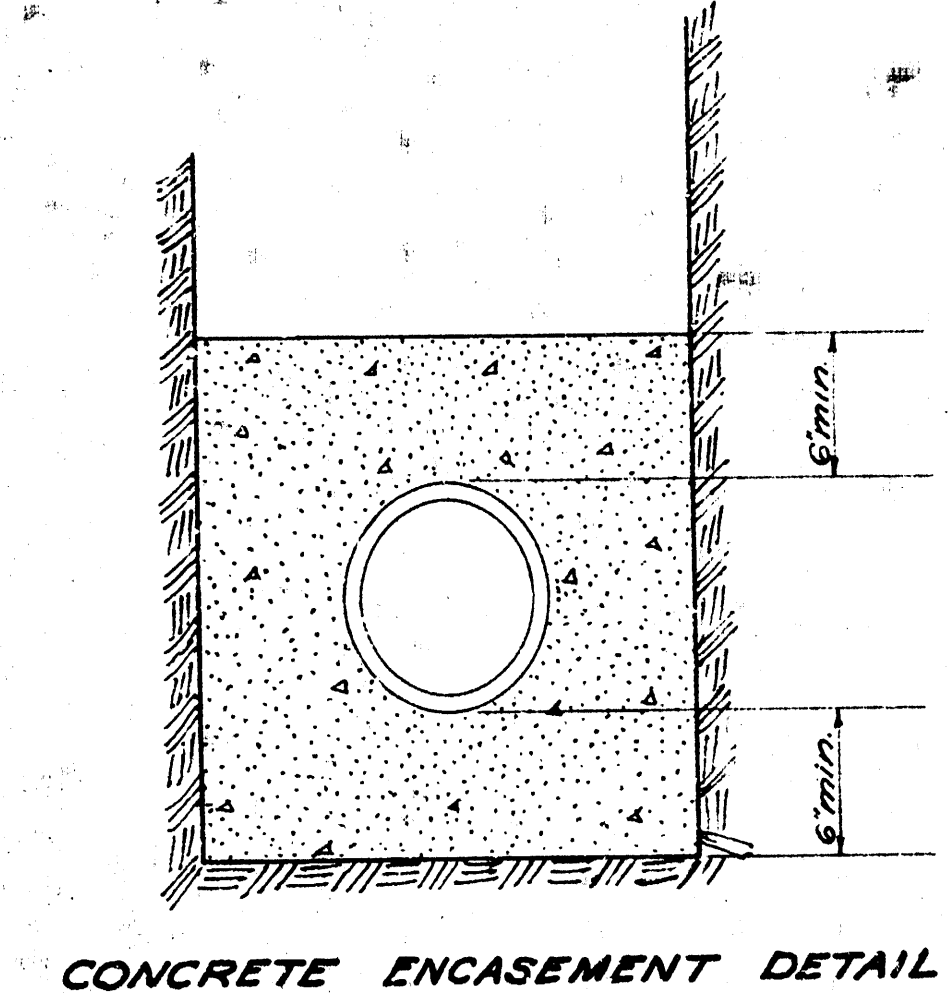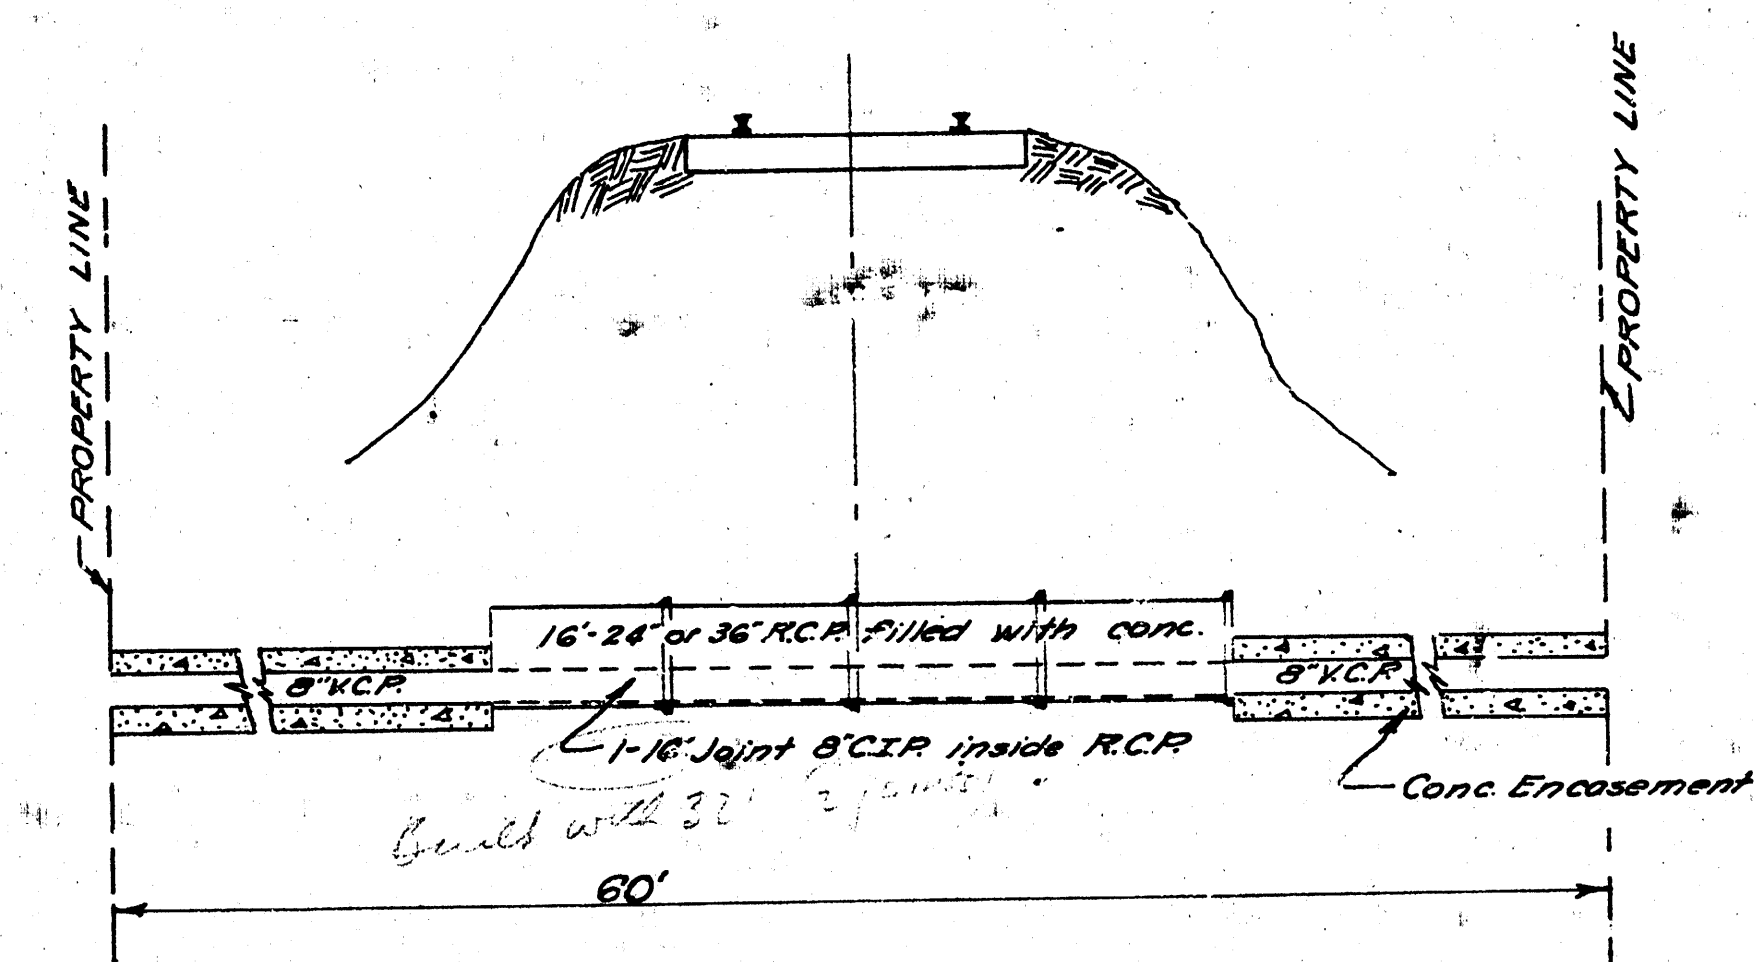

Date 10-3-51
 Drawn by J.L.A.
 Checked by H.C.
 Note Book No. 57-56