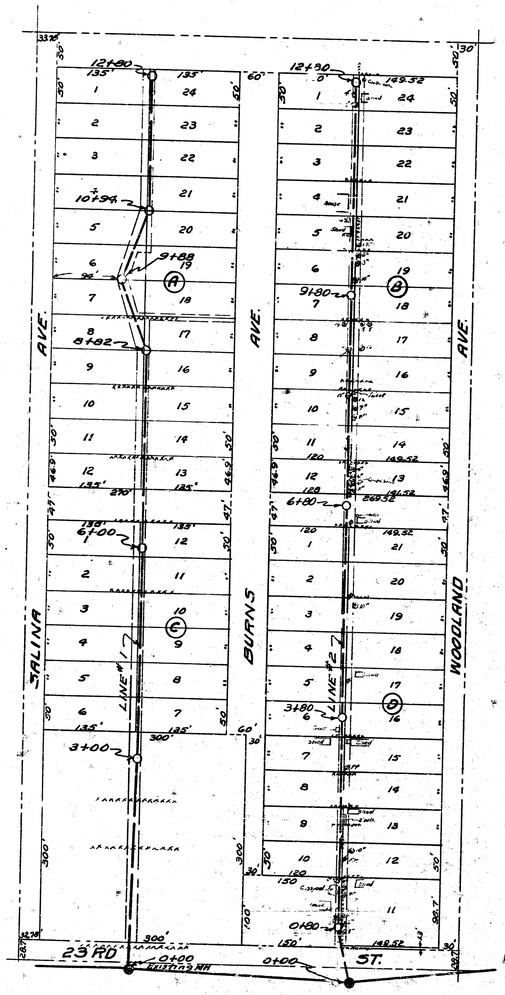

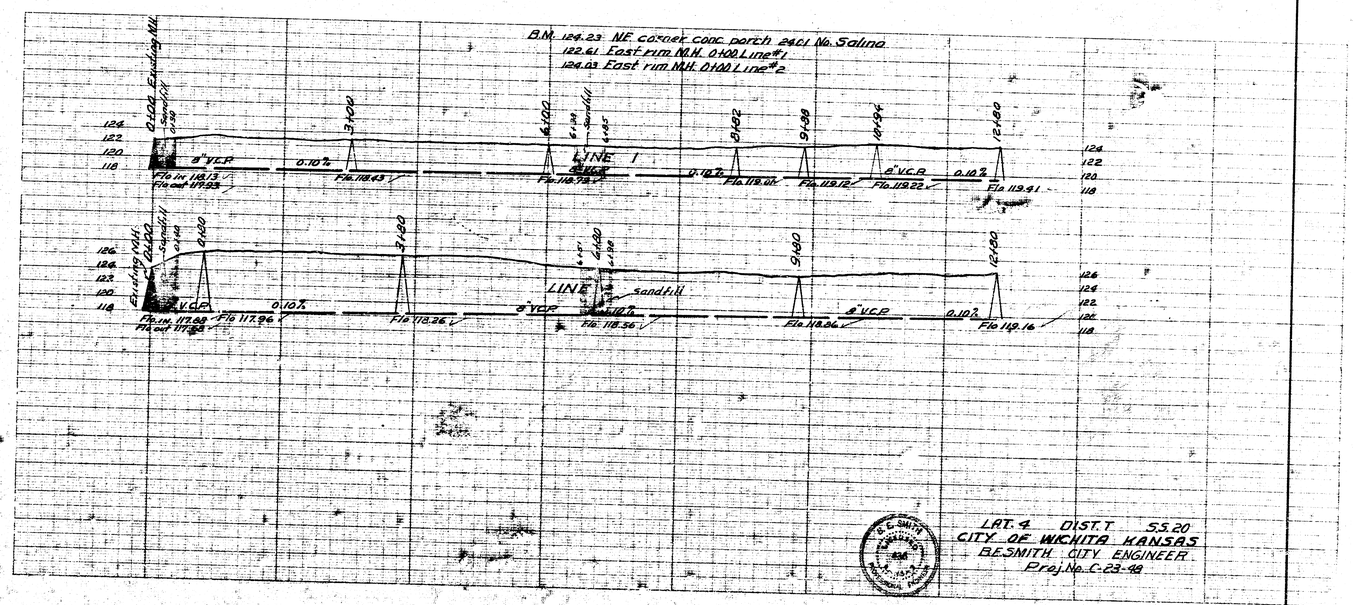

LAT. 4 DIST. T S.S. 20
CITY OF WICHITA KANSAS
B.E. SMITH CITY ENGINEER
Proj. No. C-23-48

Date
Drawn by
Checked by
Book No.

1-15-48
McClain
H. G.