
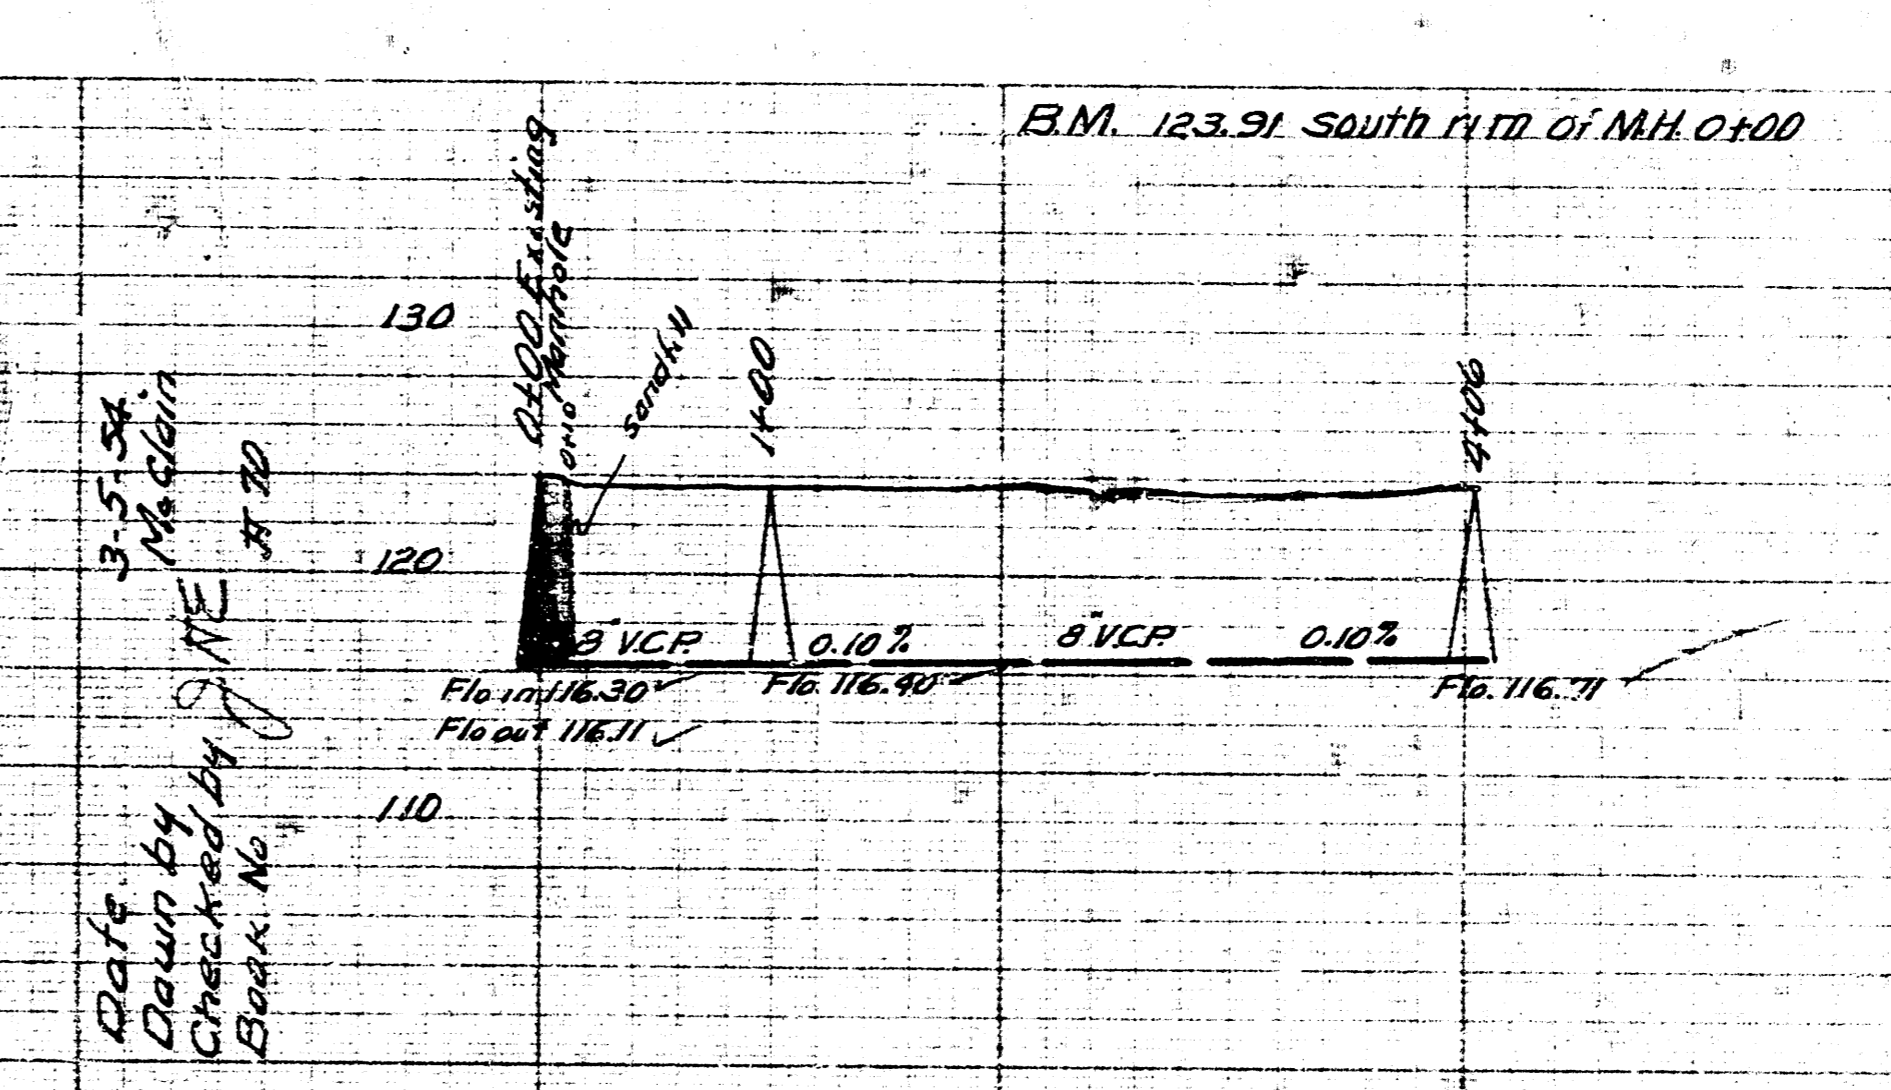


Date
 Drawn by
 Checked by
 Book No.

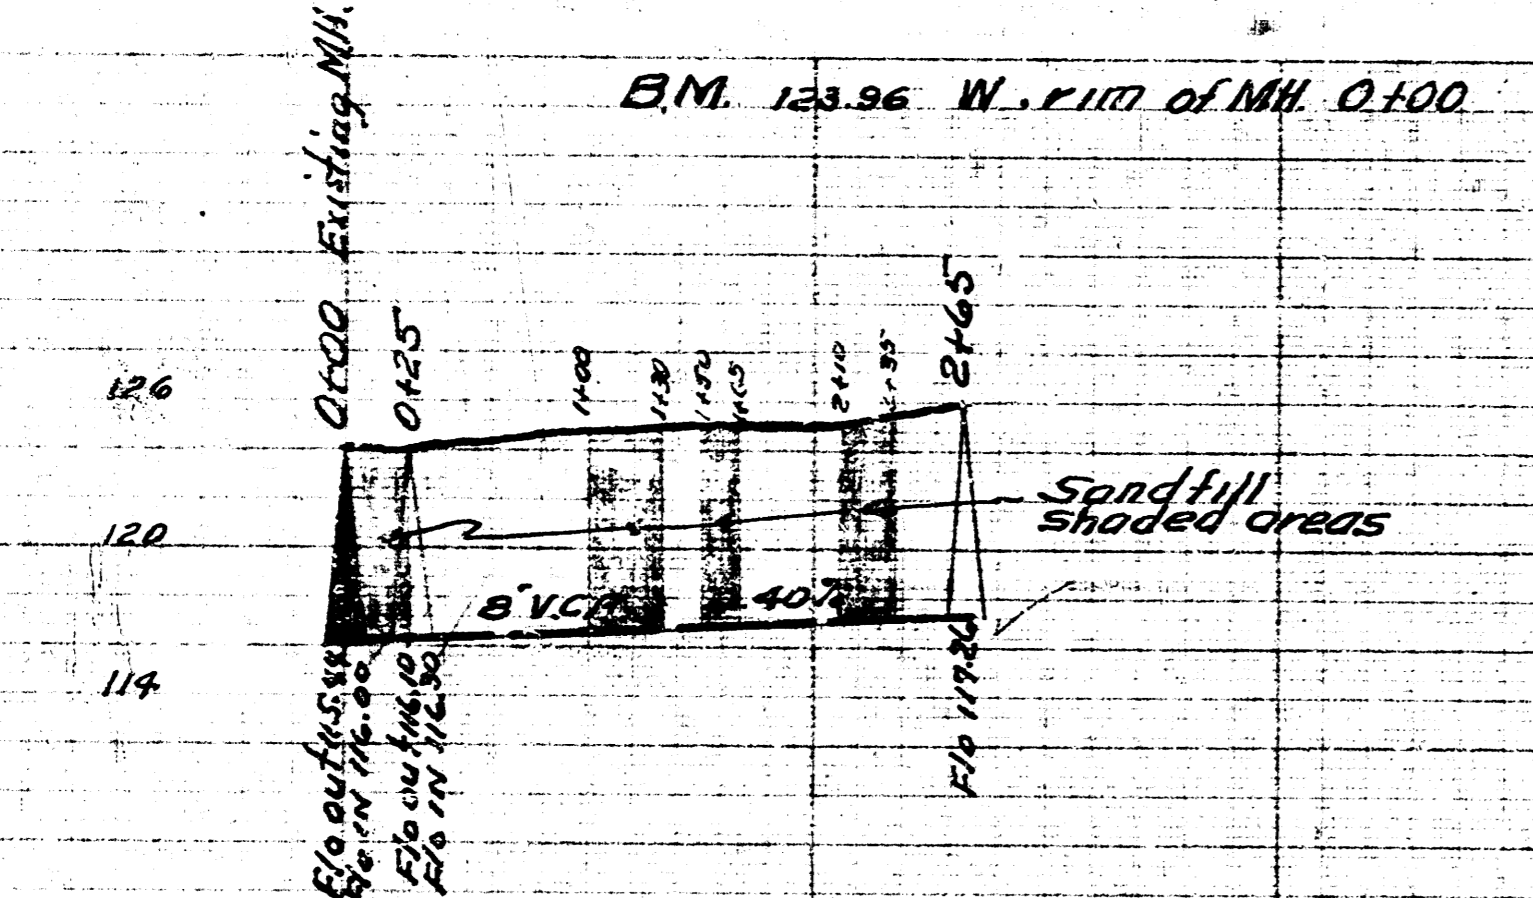

LAT. 24 DIST. E. SS. 12
 CITY OF WICHITA KANSAS
 BE. SMITH CITY ENGINEER
 Proj. No. C-23-20

LAT. 14 DIST. T. SS. 20
 CITY OF WICHITA KANSAS
 BE. SMITH CITY ENGINEER
 Proj. No. C-24-7