


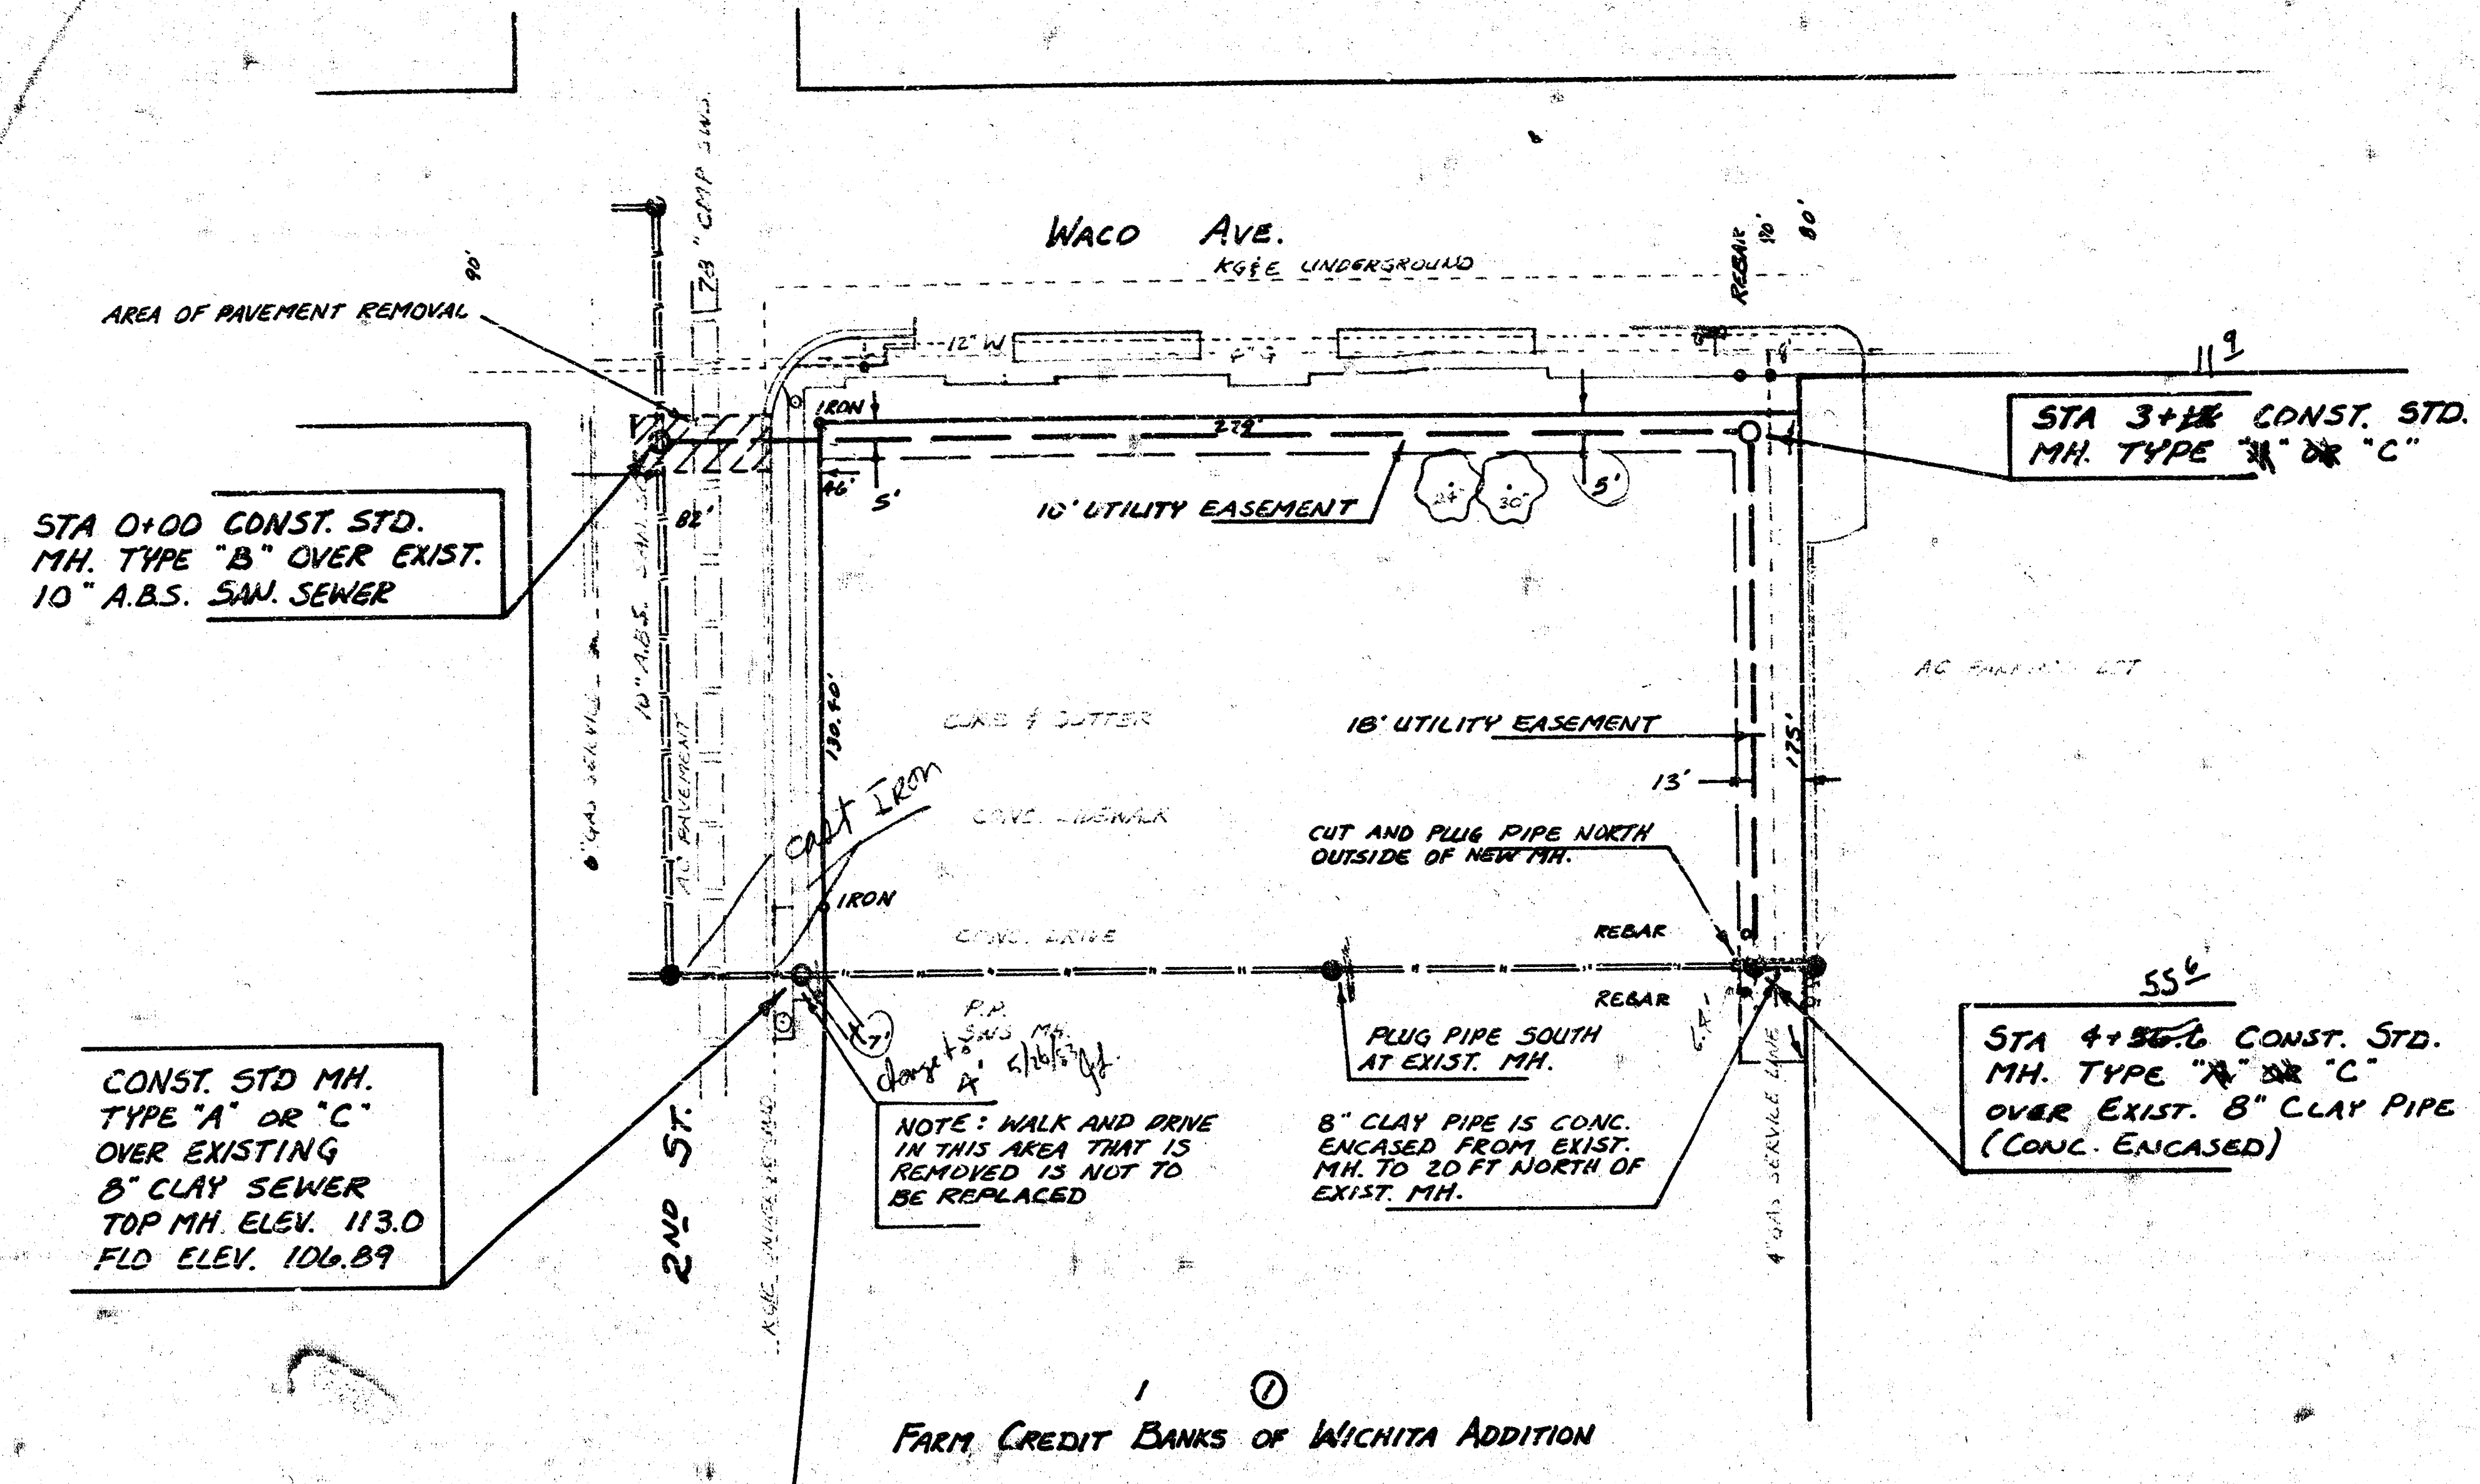

CAUTION
UNDERGROUND
UTILITIES

Please check with K & E or Southwestern Bell Telephone Co. for Location

THE CONTRACTOR SHALL BE RESPONSIBLE FOR PRESERVING PROPERTY IRONS. THE CONTRACTOR SHALL BE REQUIRED TO RE-ESTABLISH ANY PROPERTY IRONS WHICH ARE DAMAGED OR DESTROYED BY HIS CONSTRUCTION OPERATIONS. SUCH IRONS SHALL BE RE-ESTABLISHED BY A LICENSED LAND SURVEYOR OR A LICENSED PROFESSIONAL ENGINEER IN ACCORDANCE WITH STATE LAWS.

SCALE PLAN 1" = 40' PROFILE 1" = 40' HORIZ. 1" = 5' VERT.

B.M. 111.75 R.R. SPIKE S. FACE P.P. AT NW. CORNER OF WACO AND THIRD ST.

B.M. 116.89 "X" CUT ON WEST SIDE OF TRAFFIC SIGNAL BASE AT NW. CORNER WACO AND SECOND ST.

