

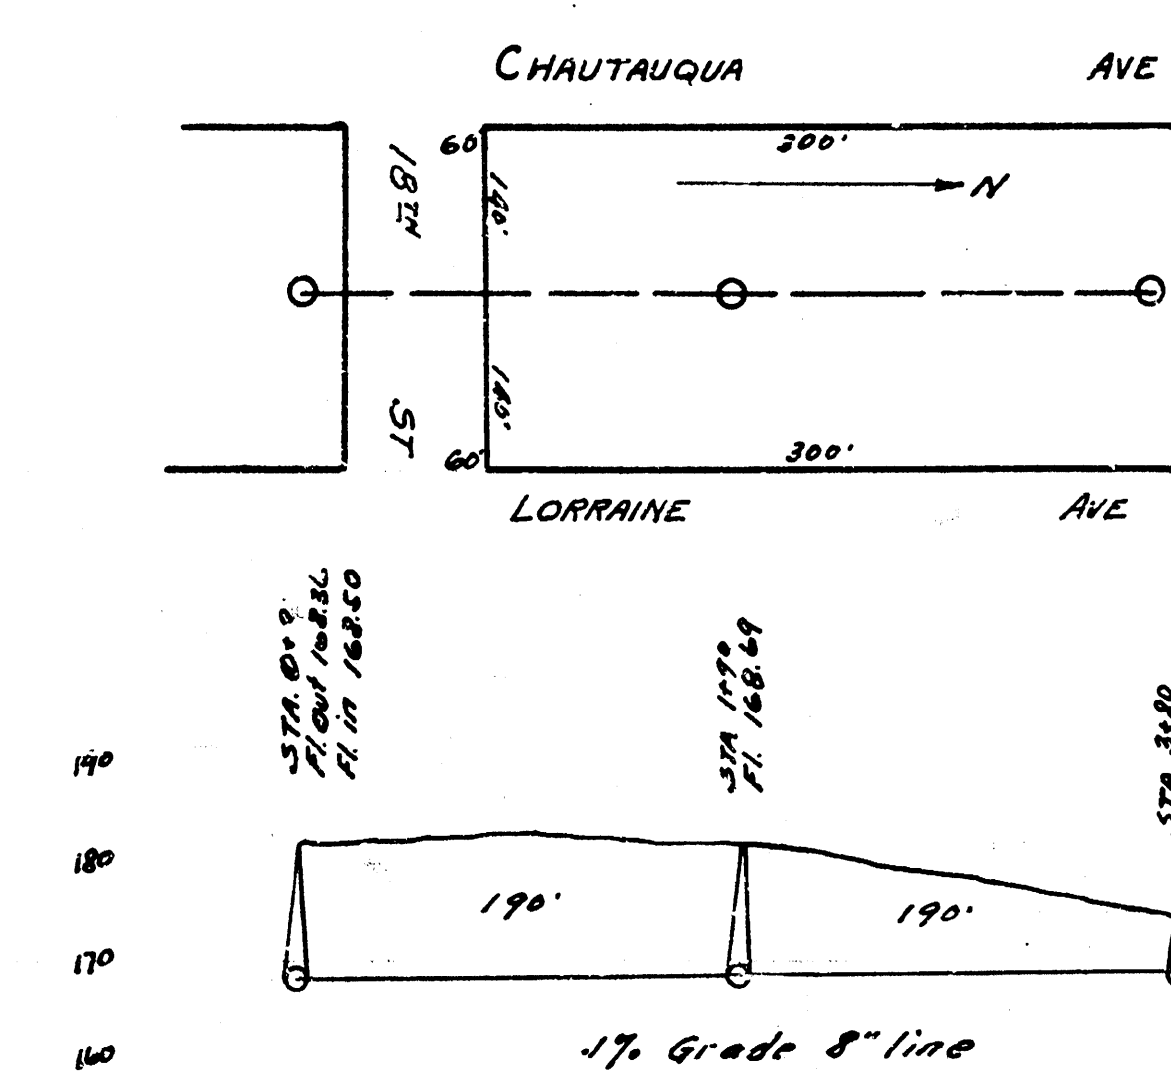


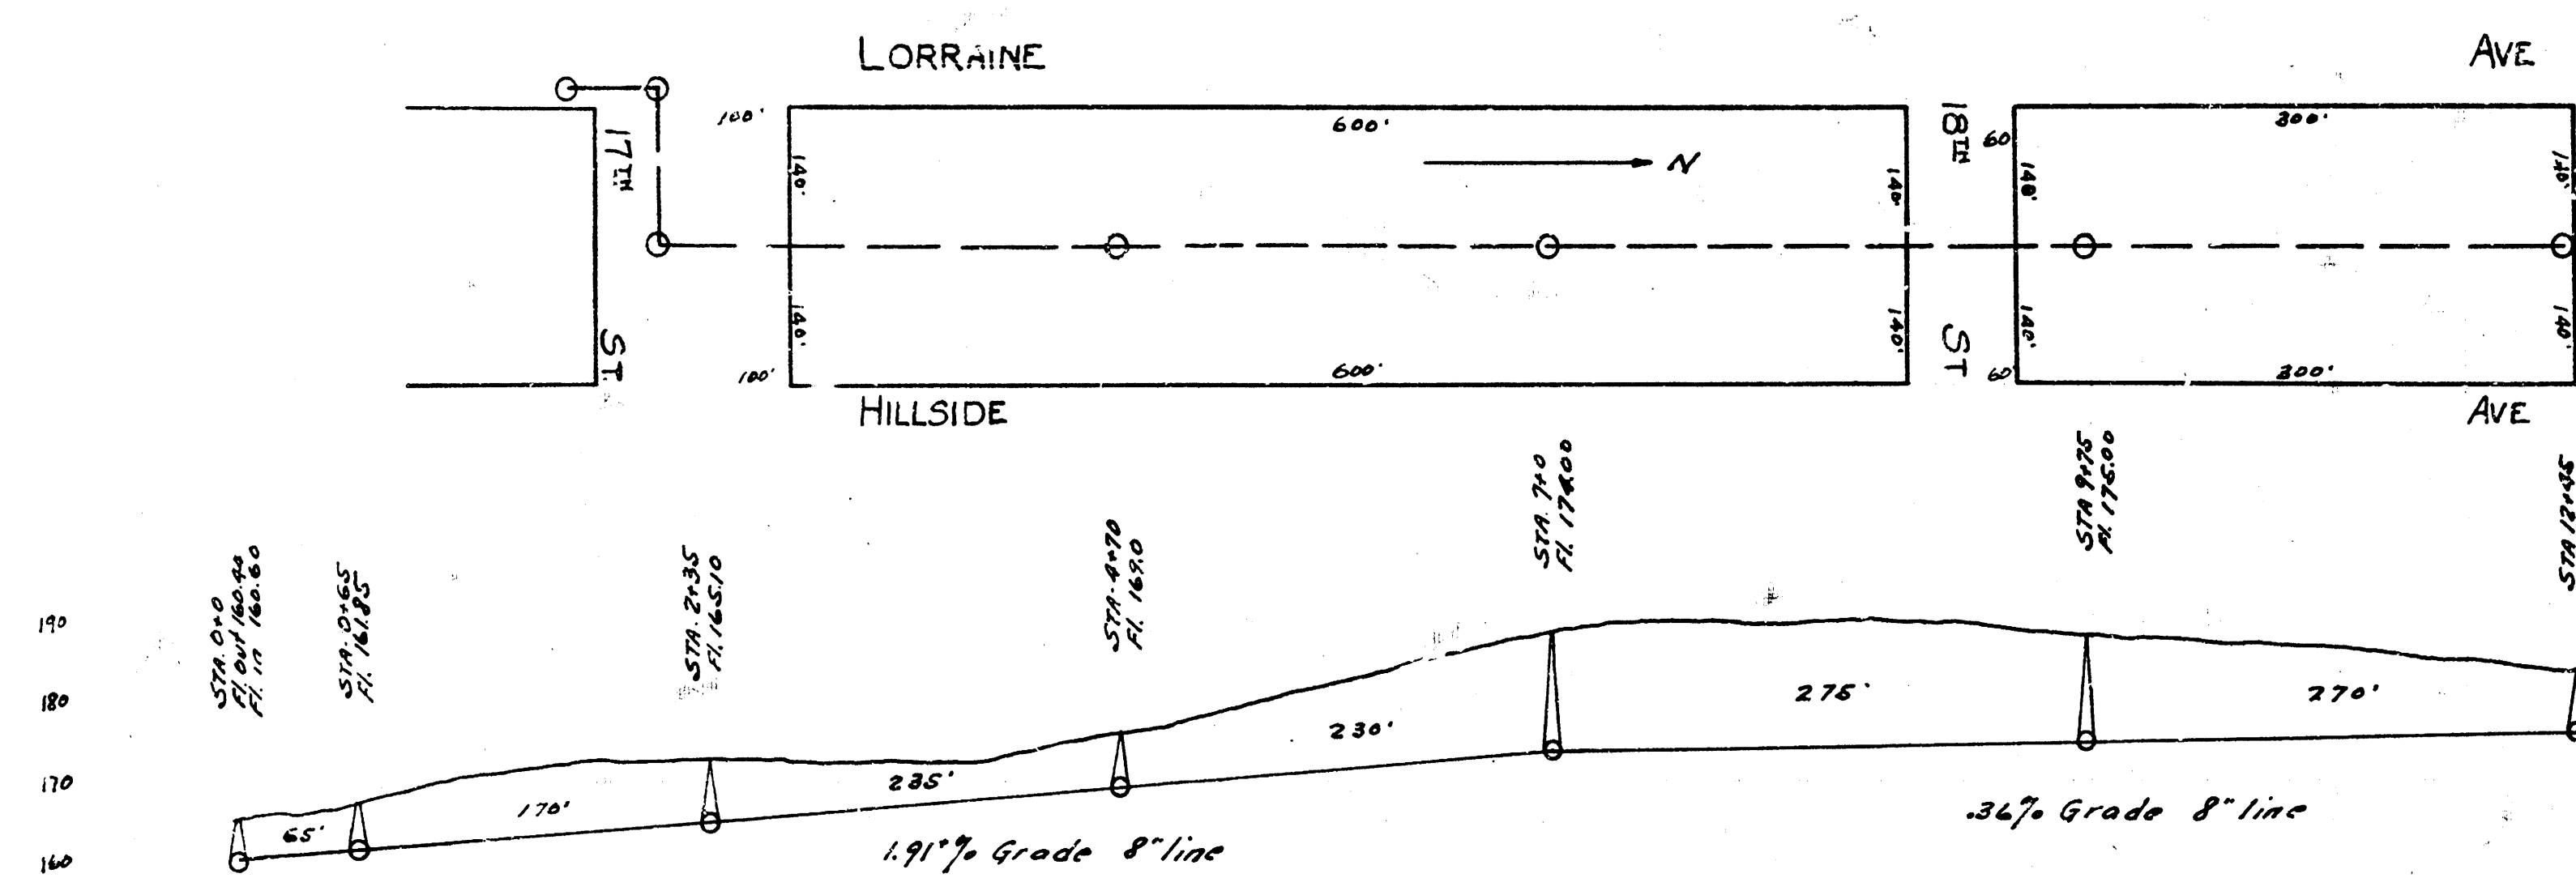

B.M. 145.74. W in Whaley ctr. of NW Sec. 5.E. Lorraine + 17th.

LAT. B, DIST. P, SS. 12.

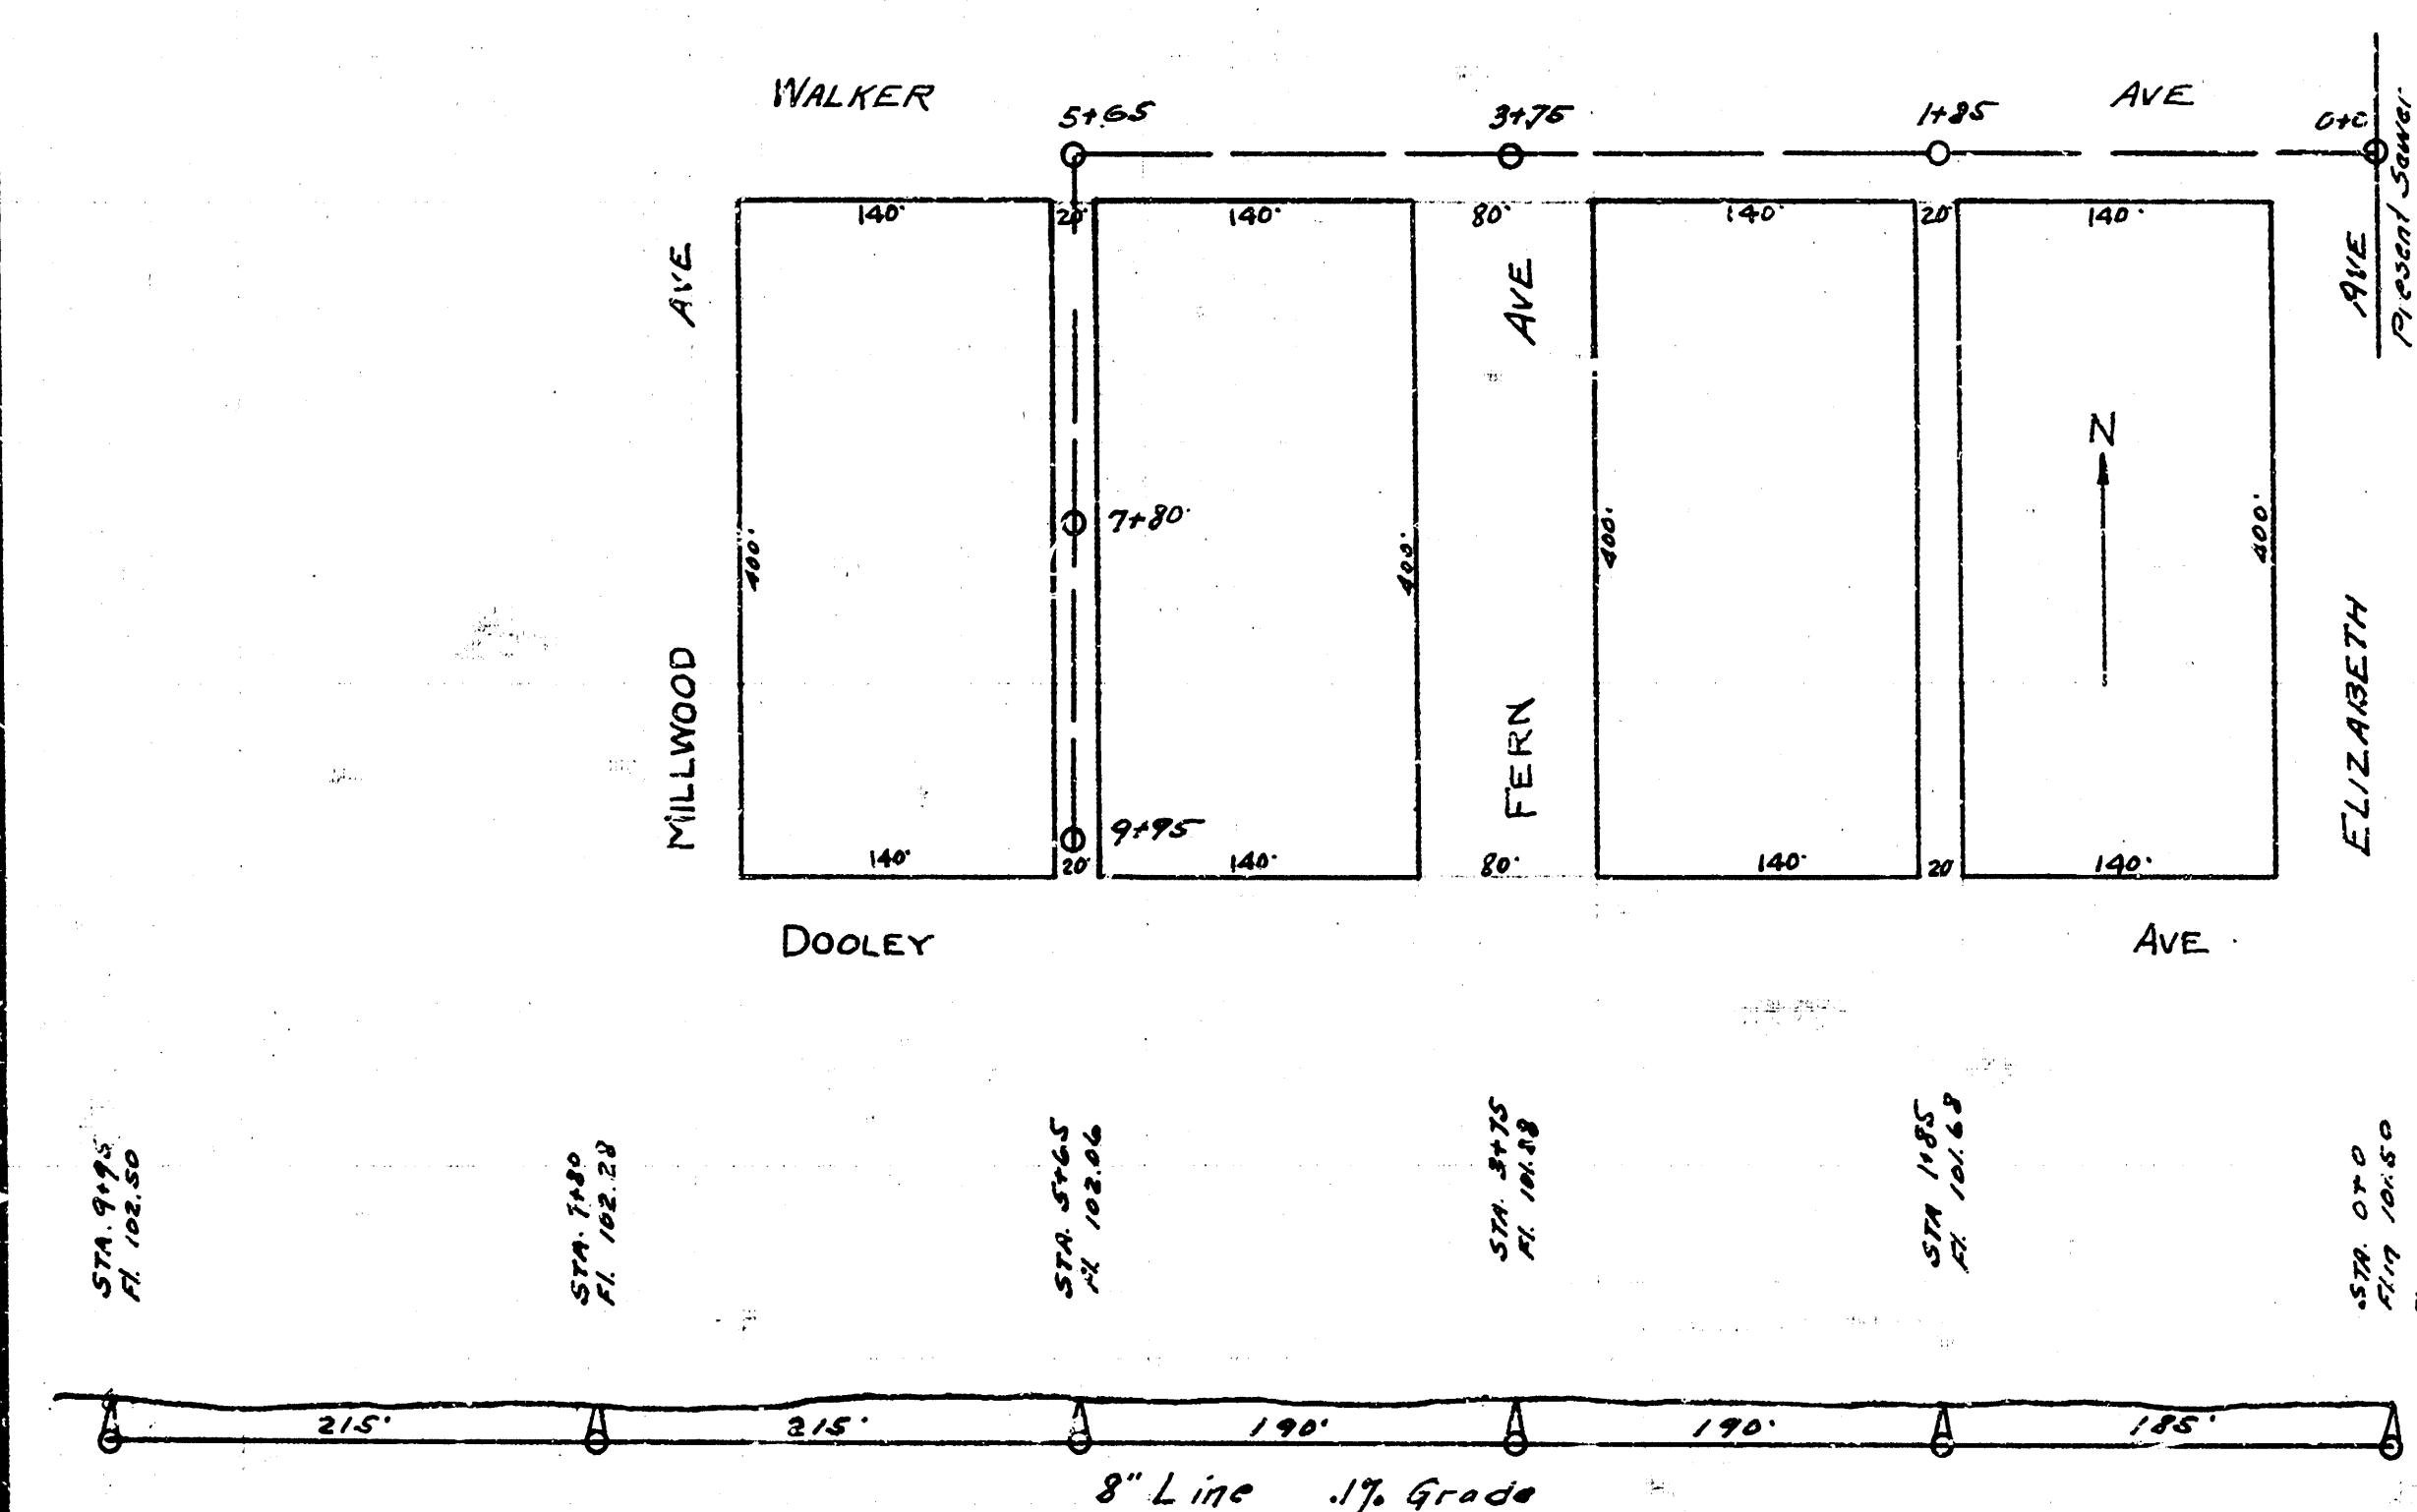

M.H. north of Walker is 348 E. 146. of W. N.W. on Elizabeth + 109.3' N. of So. line of Walker east.

B.M. 105.60 L in Long ctr. of NW E. S.E. Elizabeth + Walker.

LAT. 17, DIST. A, S.S. NO. 21