


200' 12.11' P.C.T. in Tray St. Louis' North

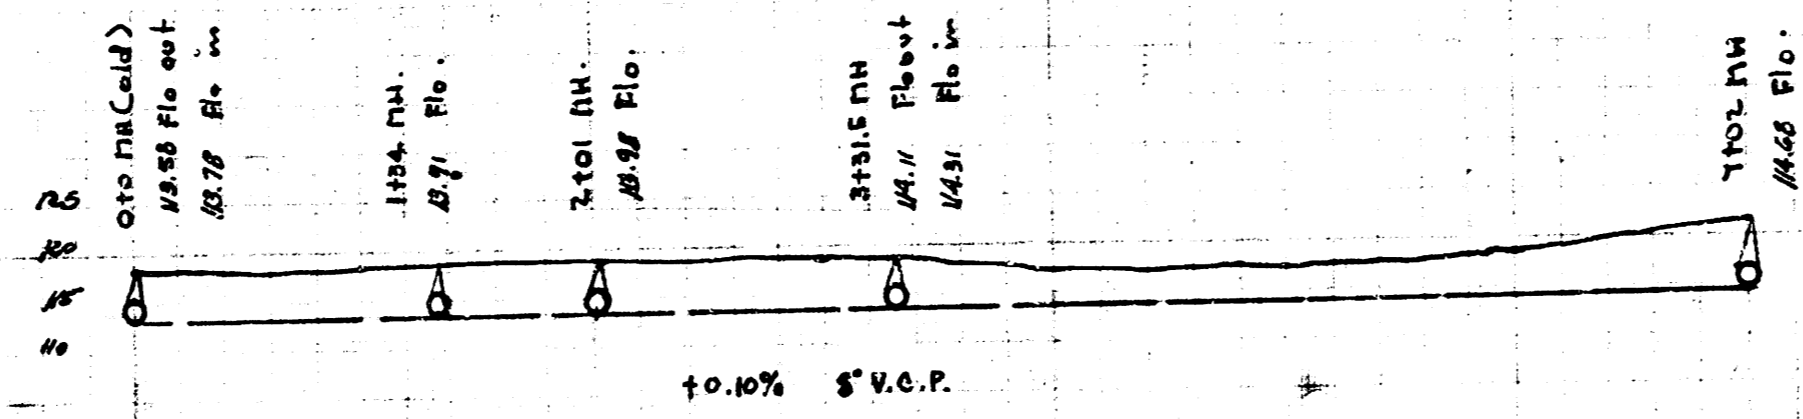

Lot 25, DIST. A, 53.4' E1.
 City of Wichita, Kansas.
 L. U. White City Engineer
 Date: 5-26-49 Proj. No. C29-14

