



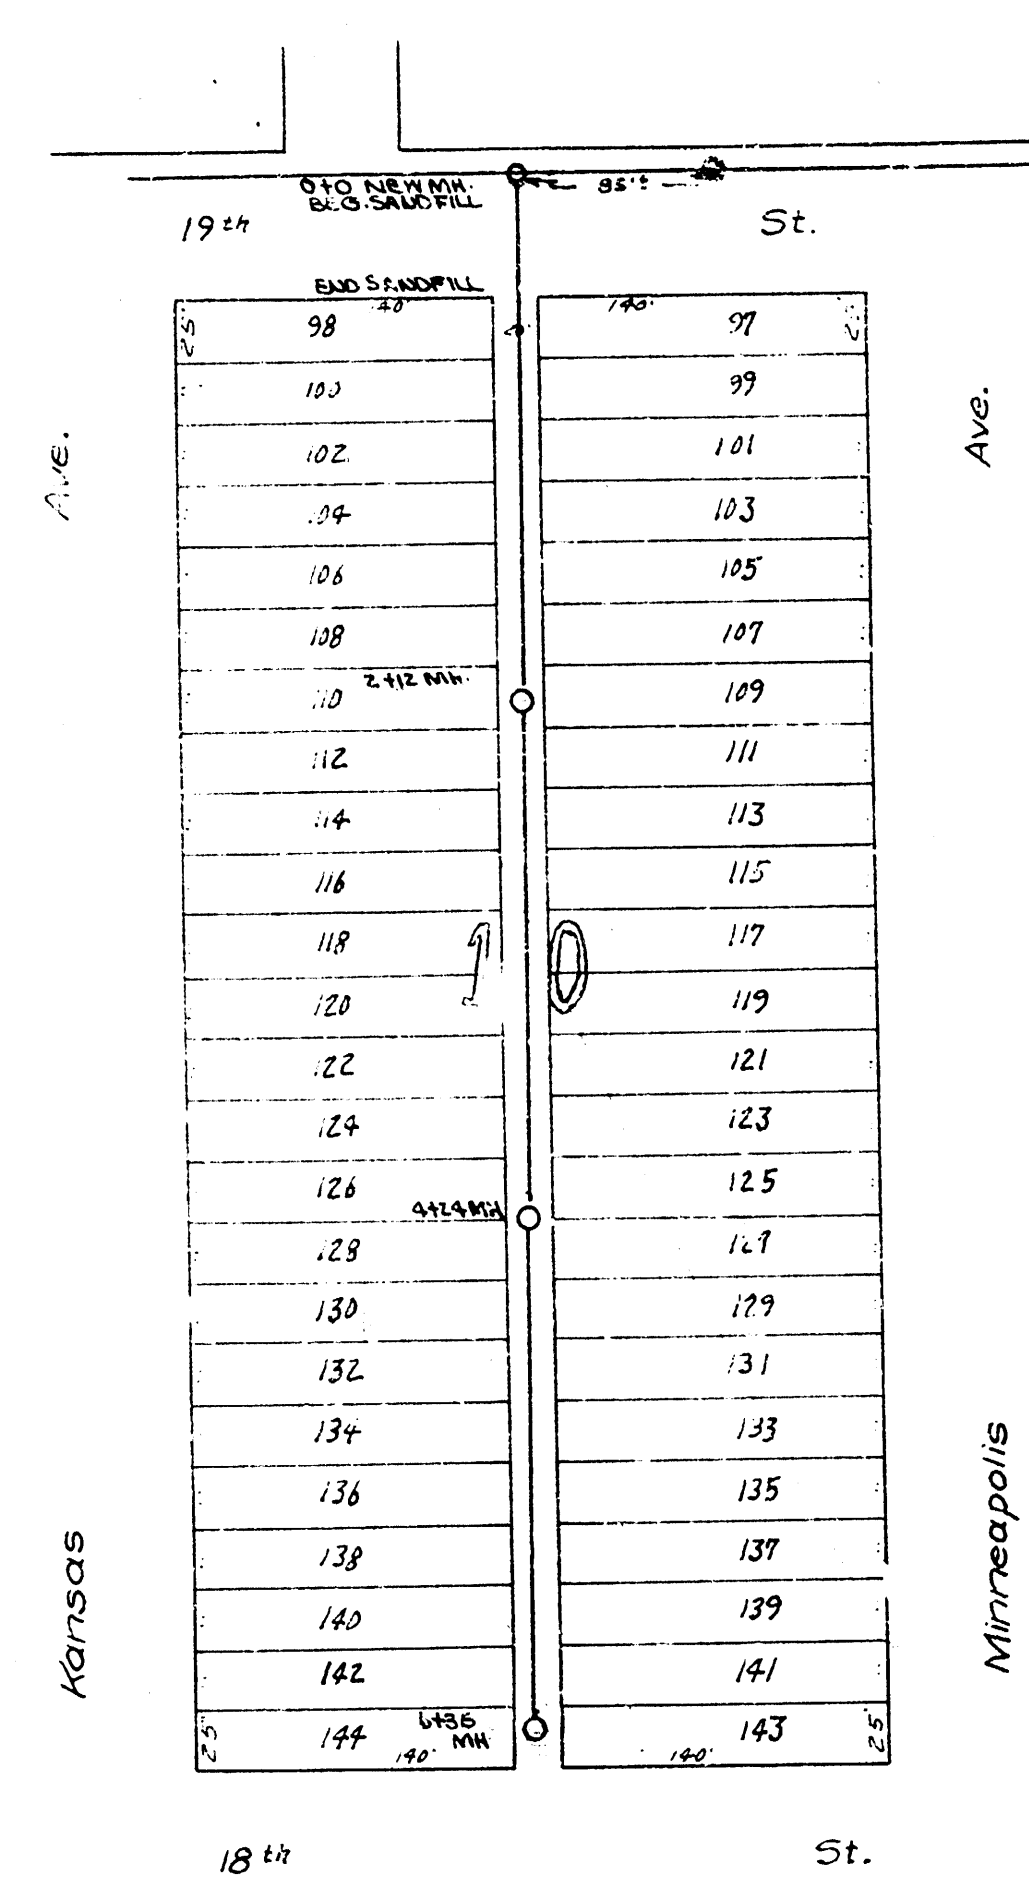


B.M. 123.36 S.E. cor. step House * 2002. North Minneapolis.

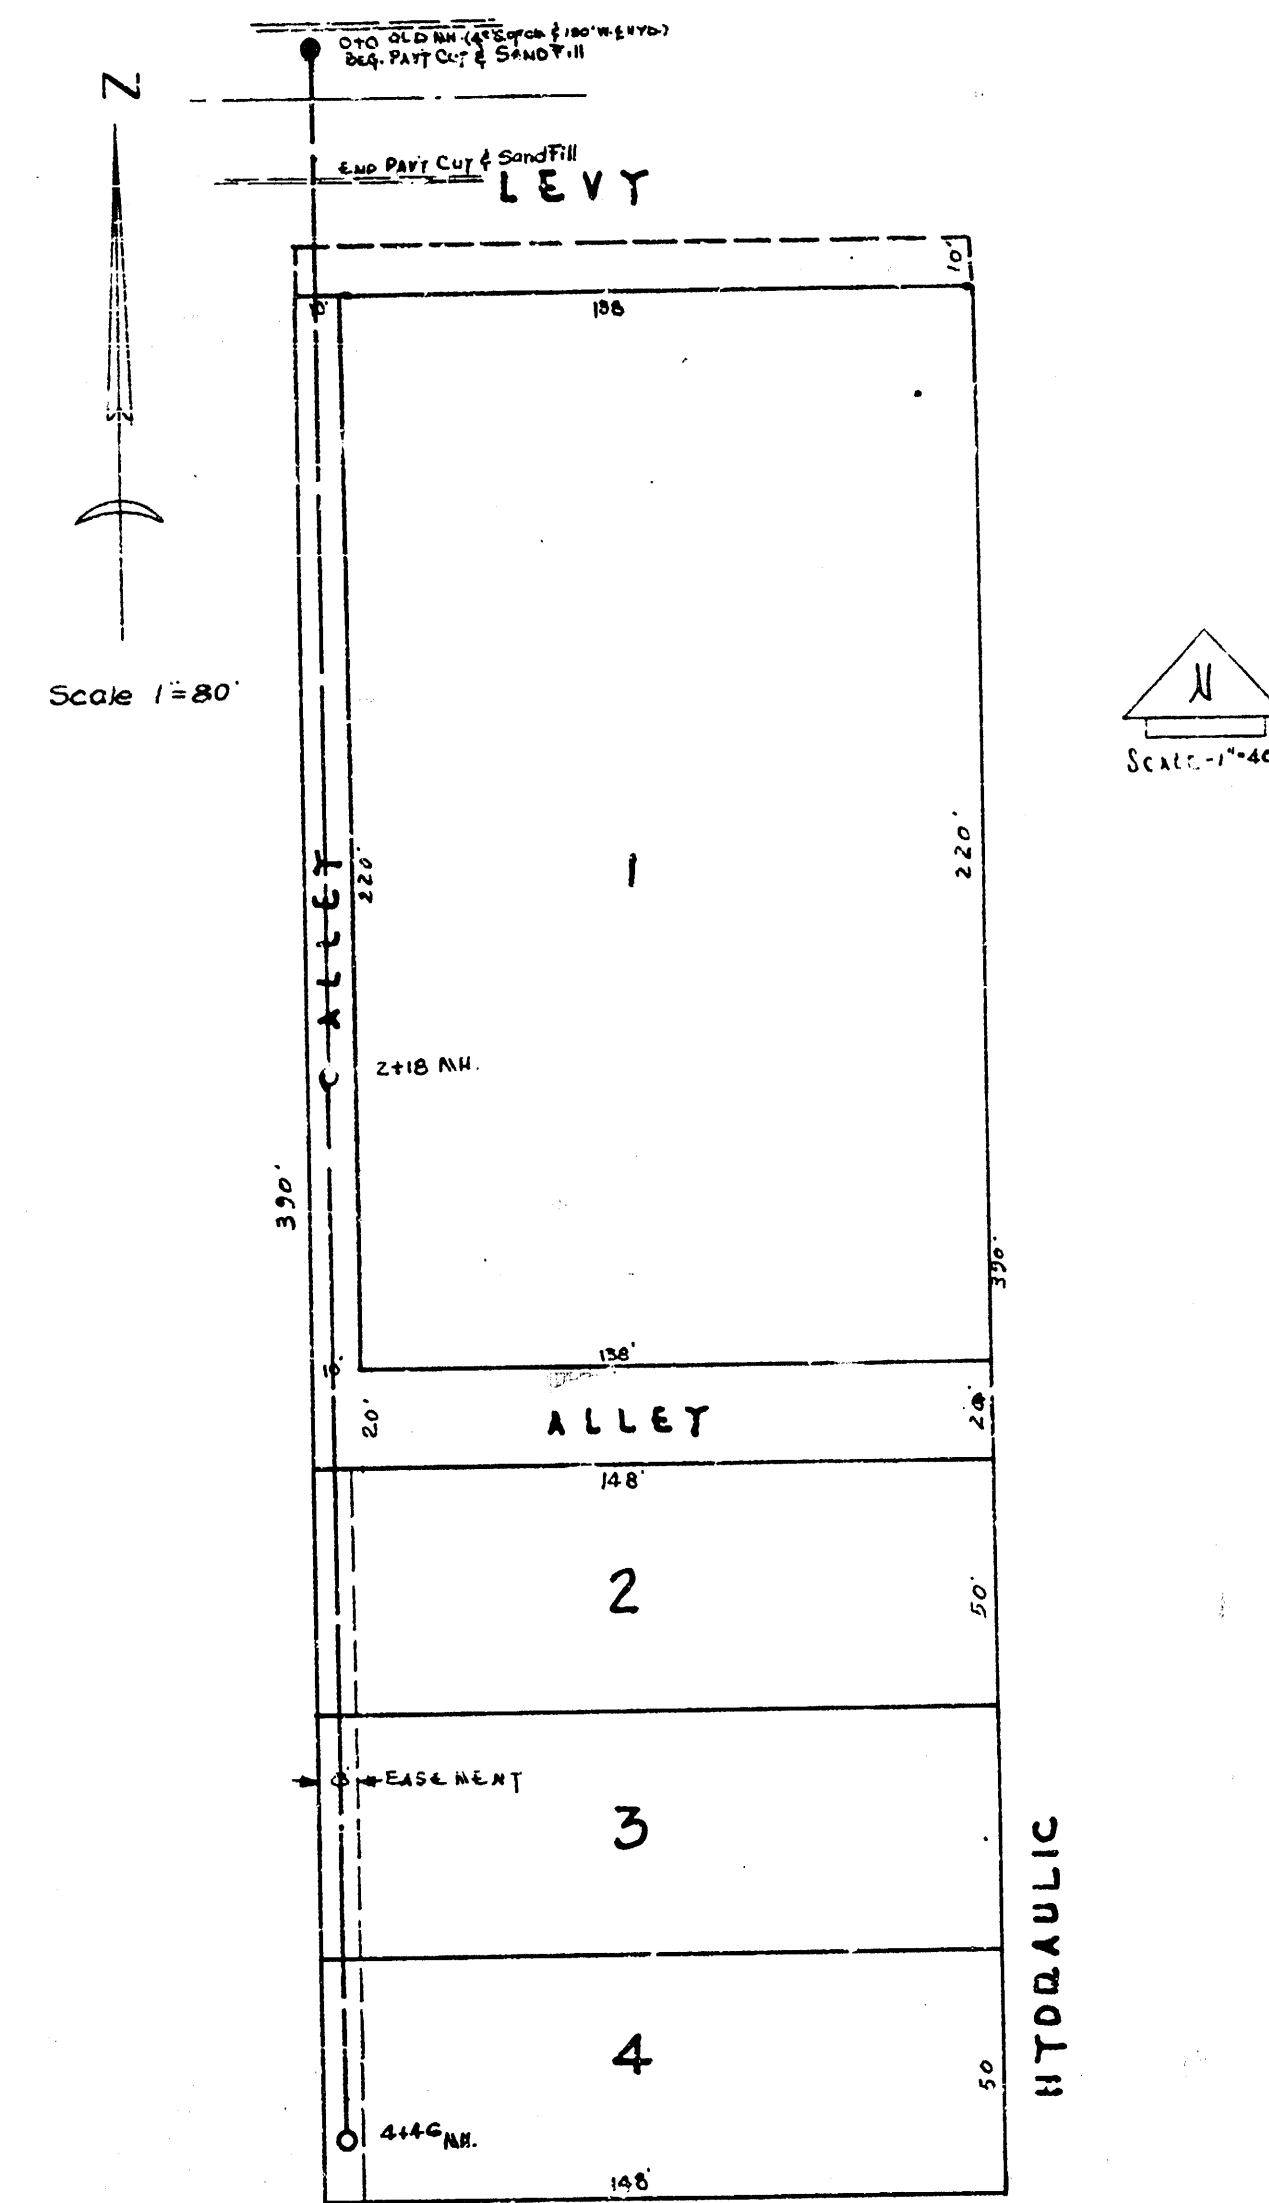


B.M. 100.28 "T" IN TROY TIRE HYD. SW. COR. HYD. & LEVY.

LAT. 13, DIST. B, SS* 20

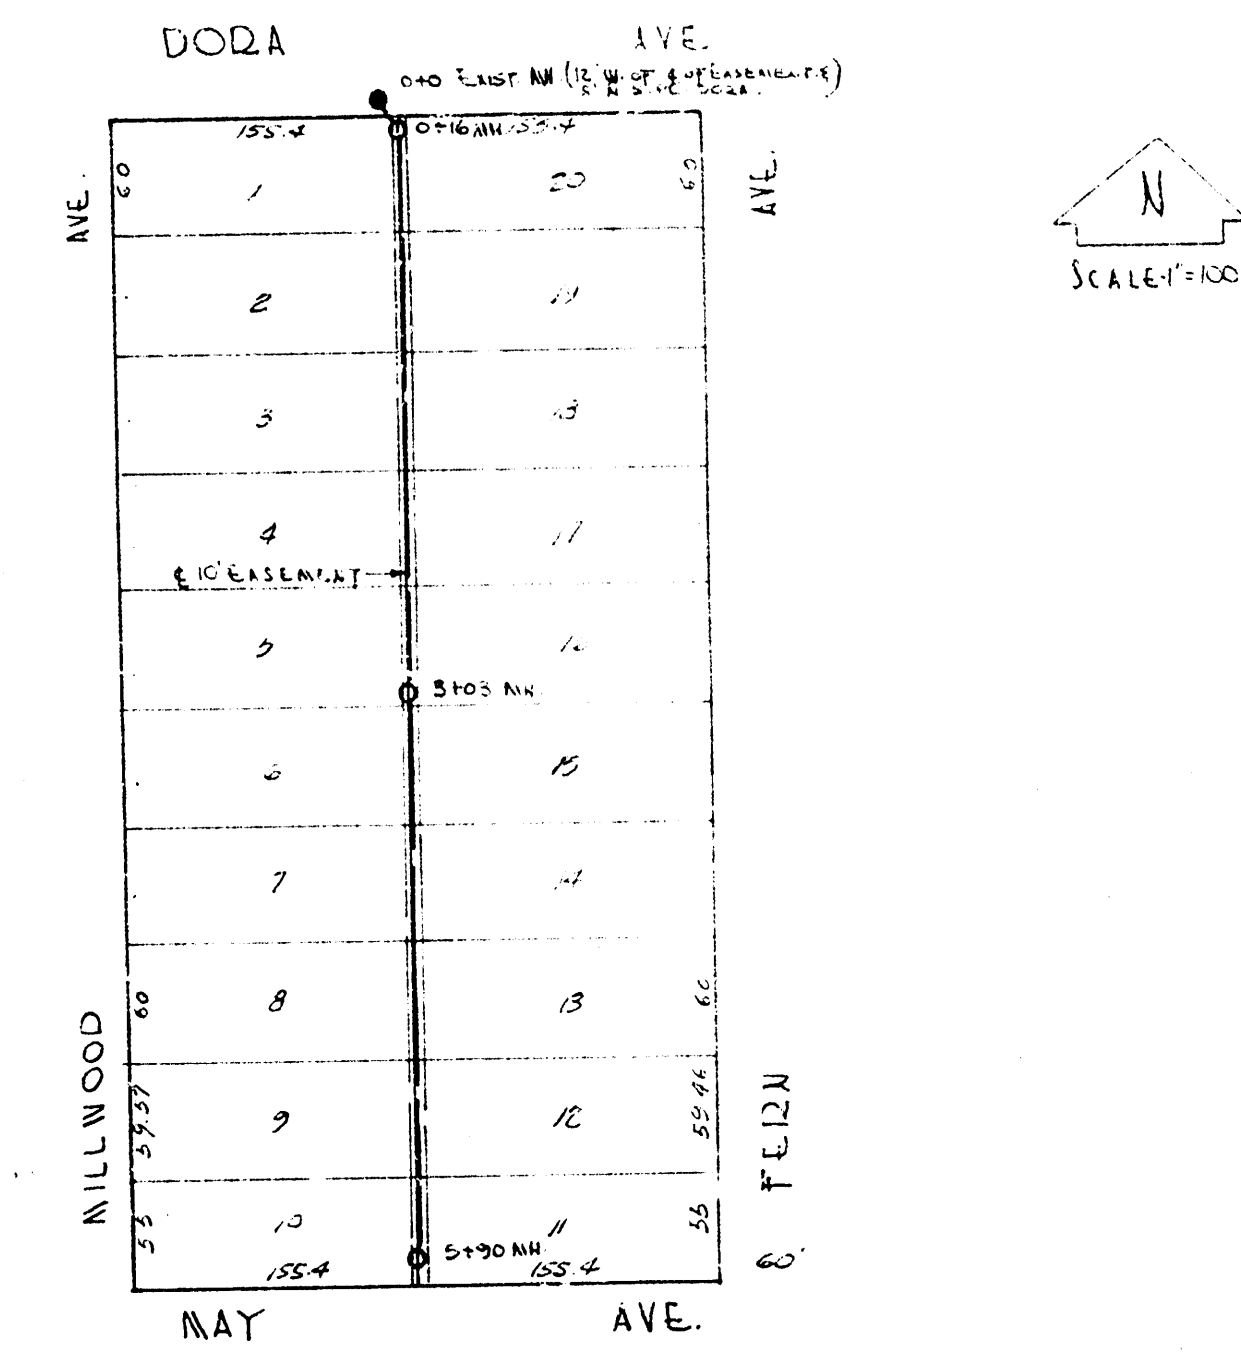


B.M. 103.47 1/4" in GLOBE on cor. N.E. DORA & E.L. MILLWOOD


LAT. 1, DIST. E, SS* 21

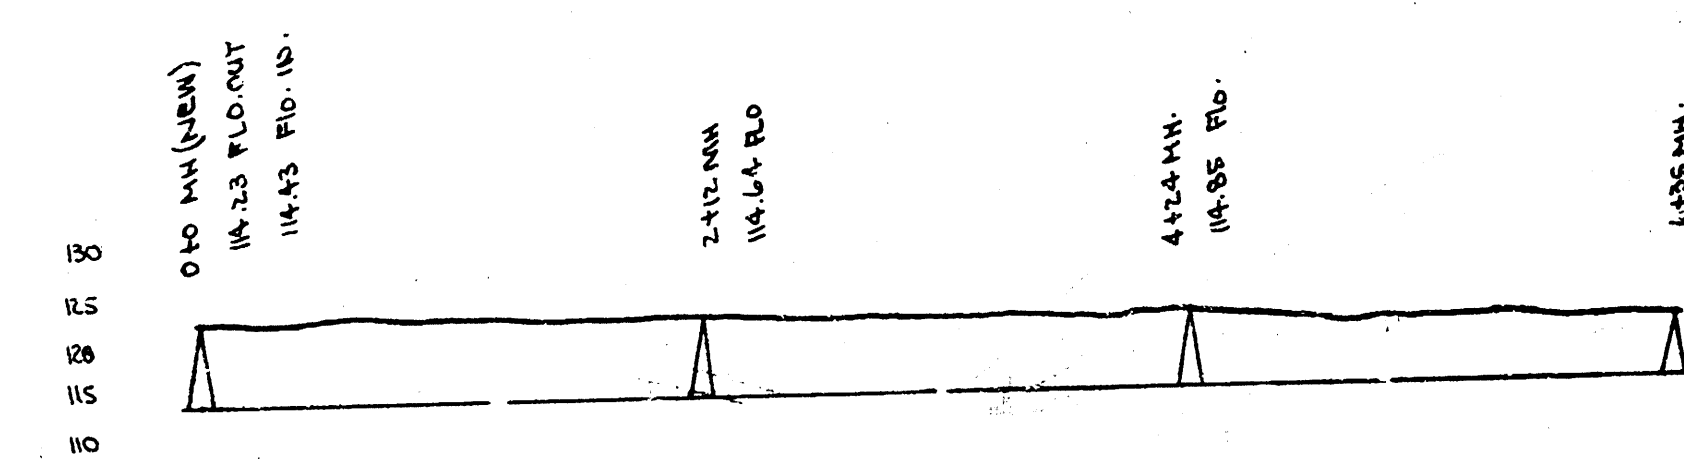

10.10% 8" V.C.R.

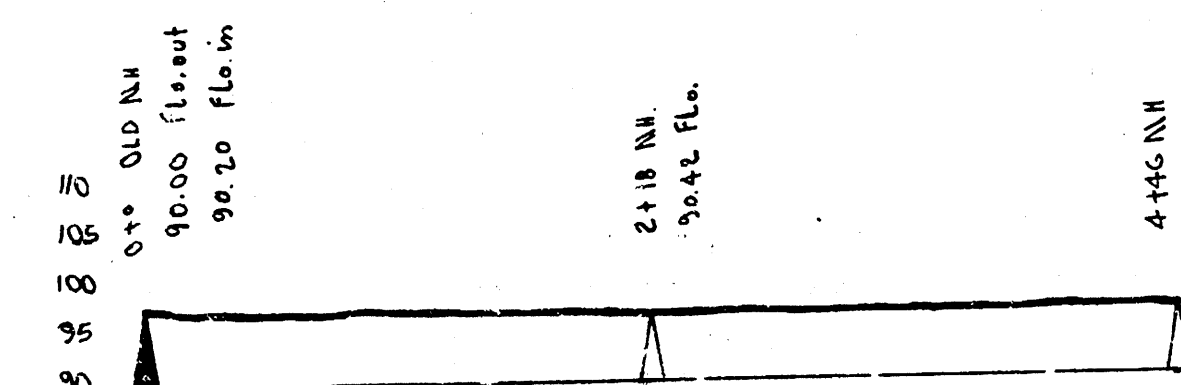

LAT. 13, DIST. B, SS* 20

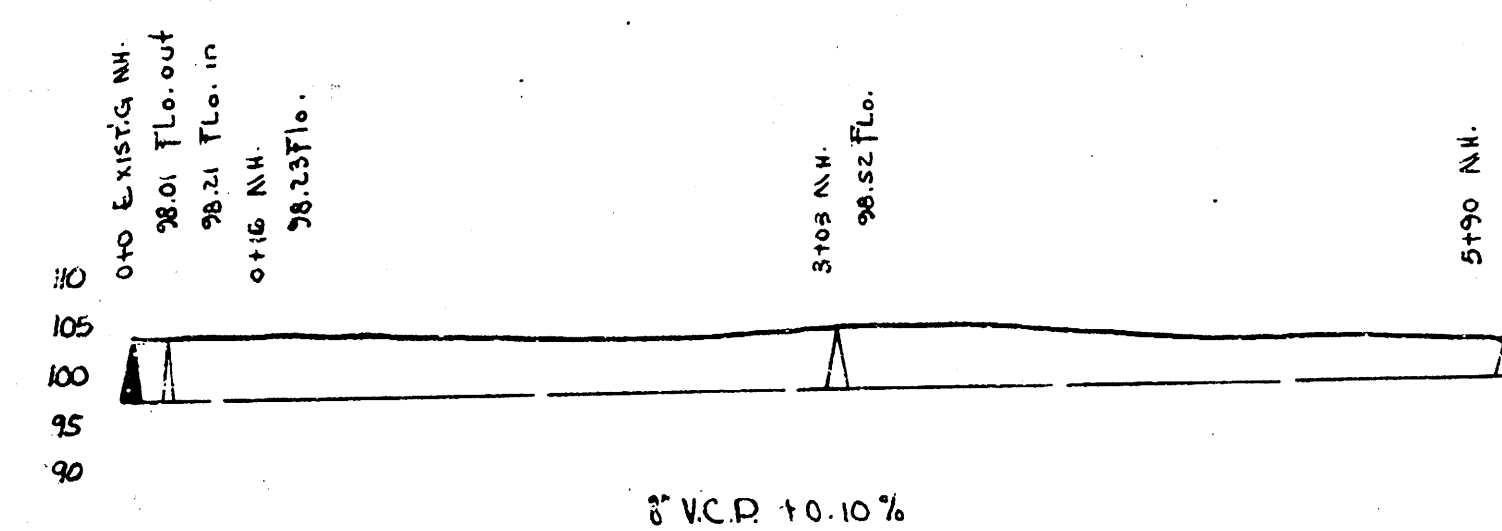

LAT. 13, DIST. B, SS* 20
LAT. 1, DIST. E, SS* 21
CITY OF WICHITA, KANSAS
L.K. WHITE City Engineer
DATE 12-8-49 Pao. No.