


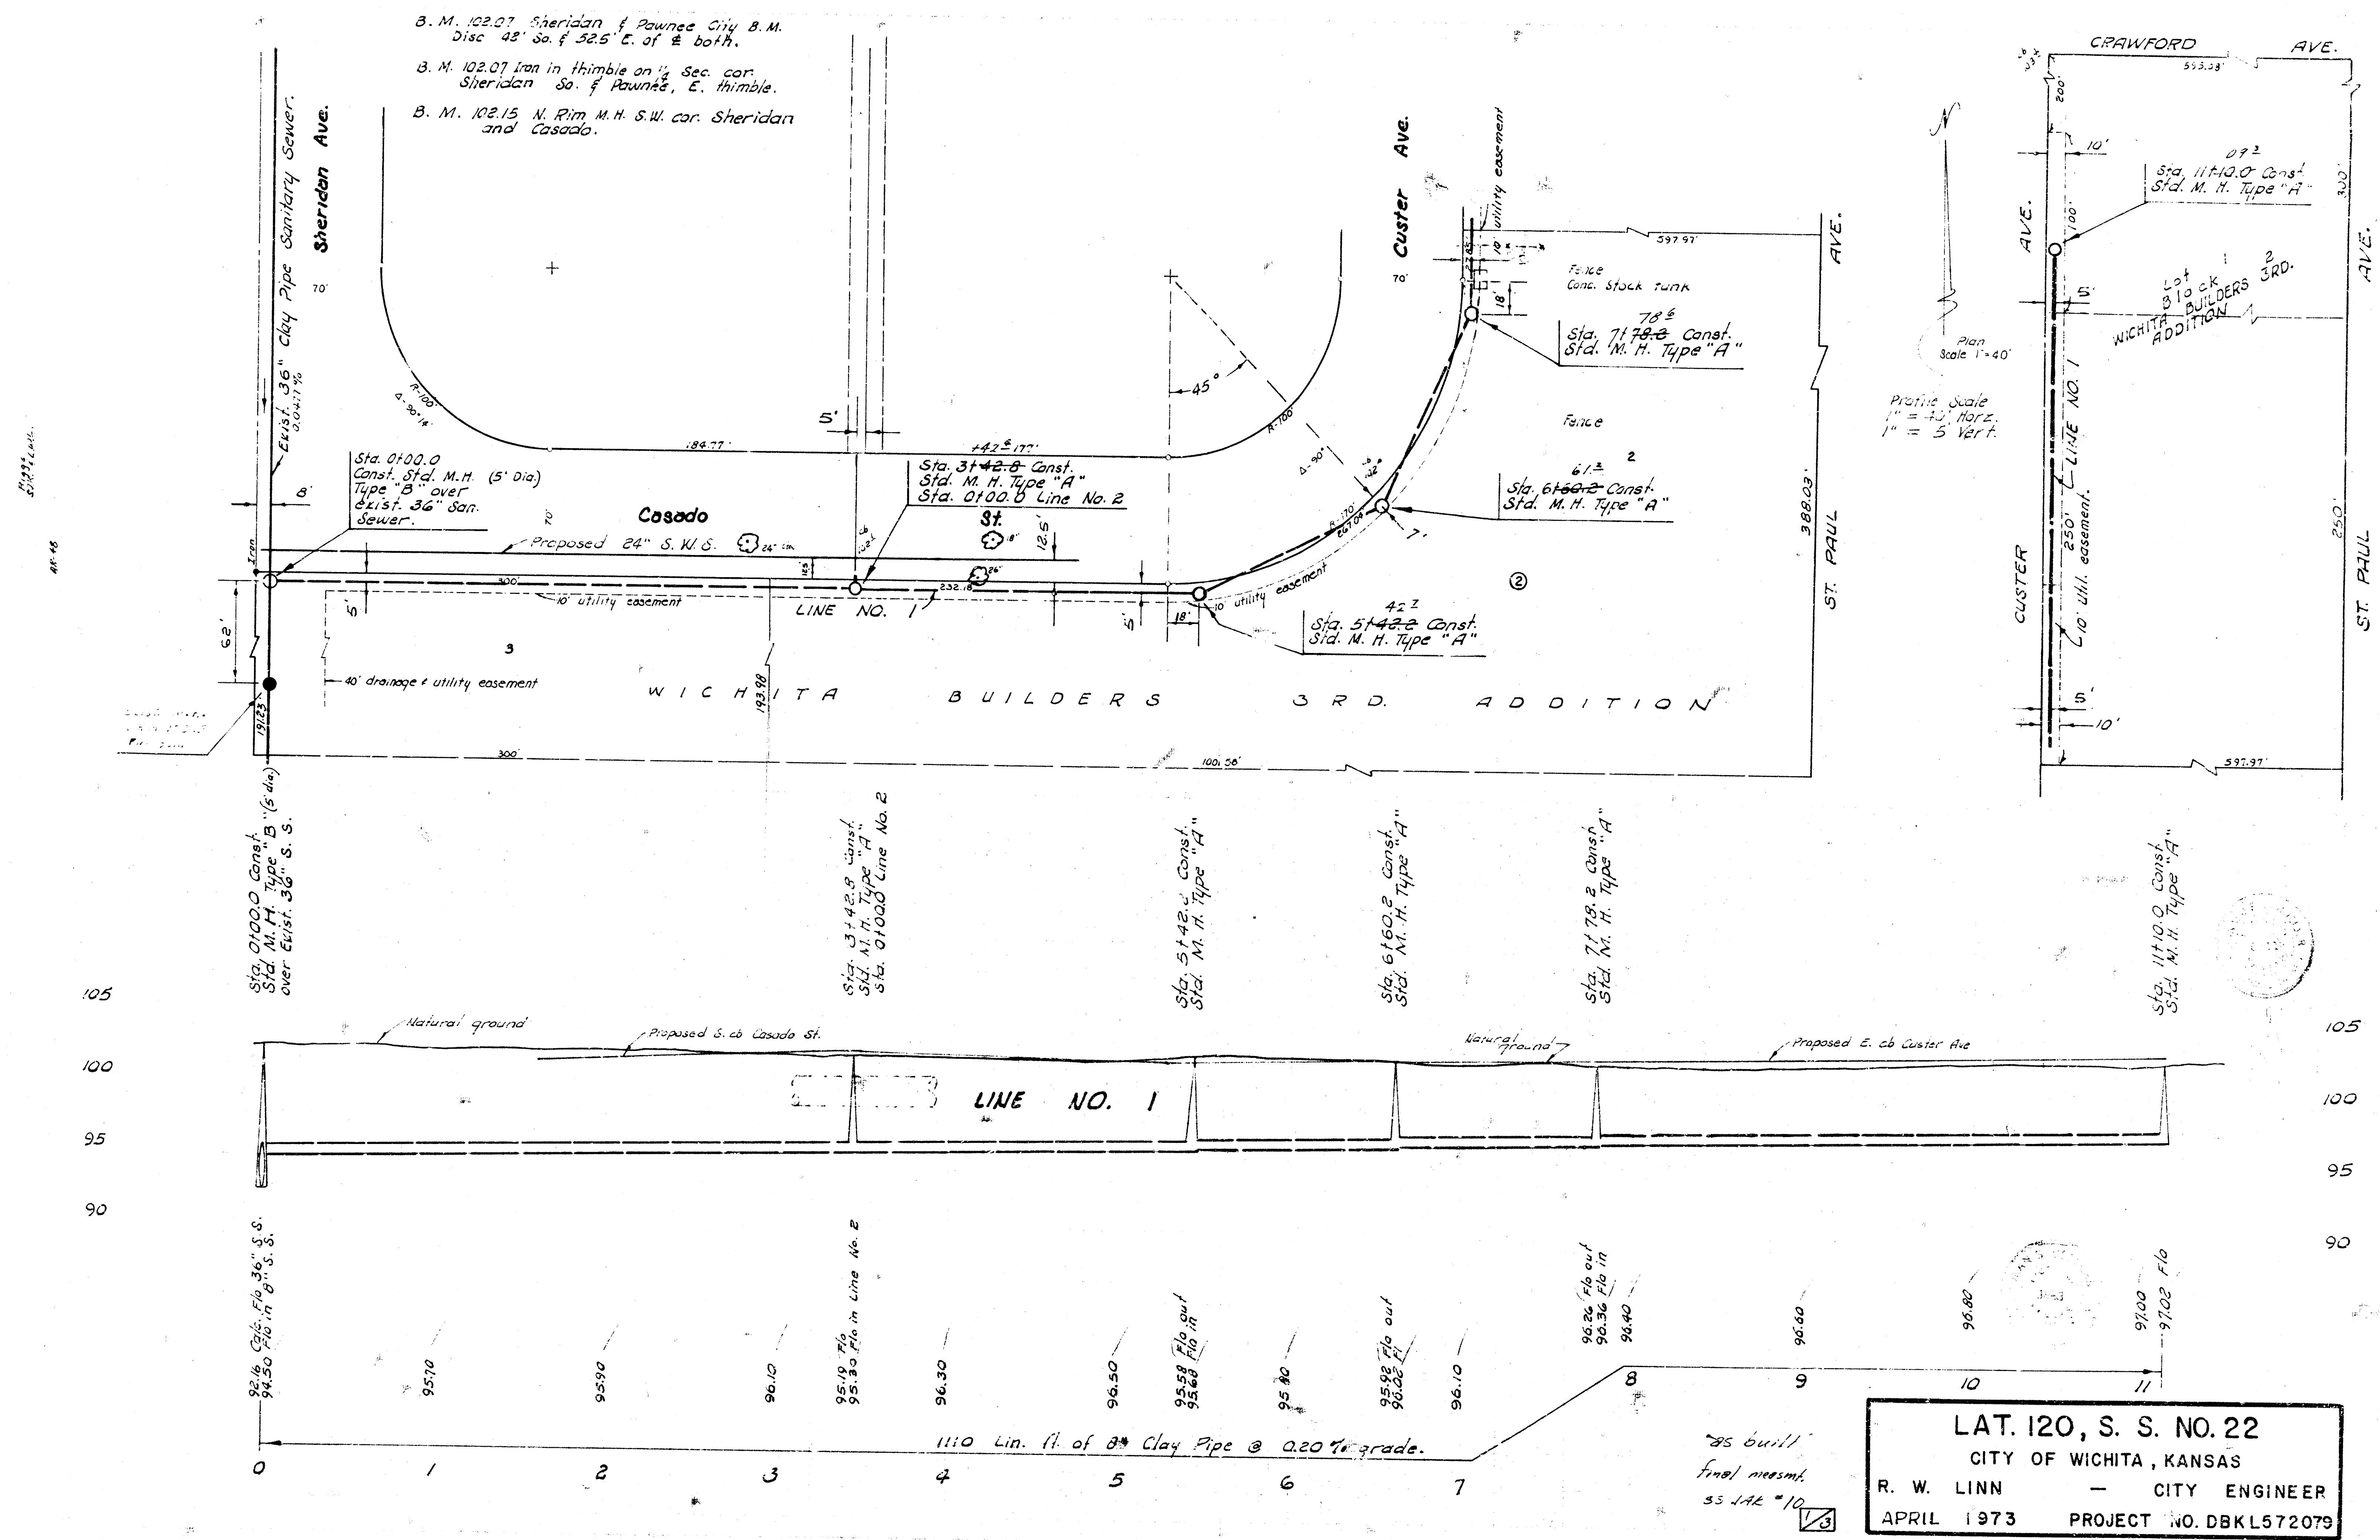


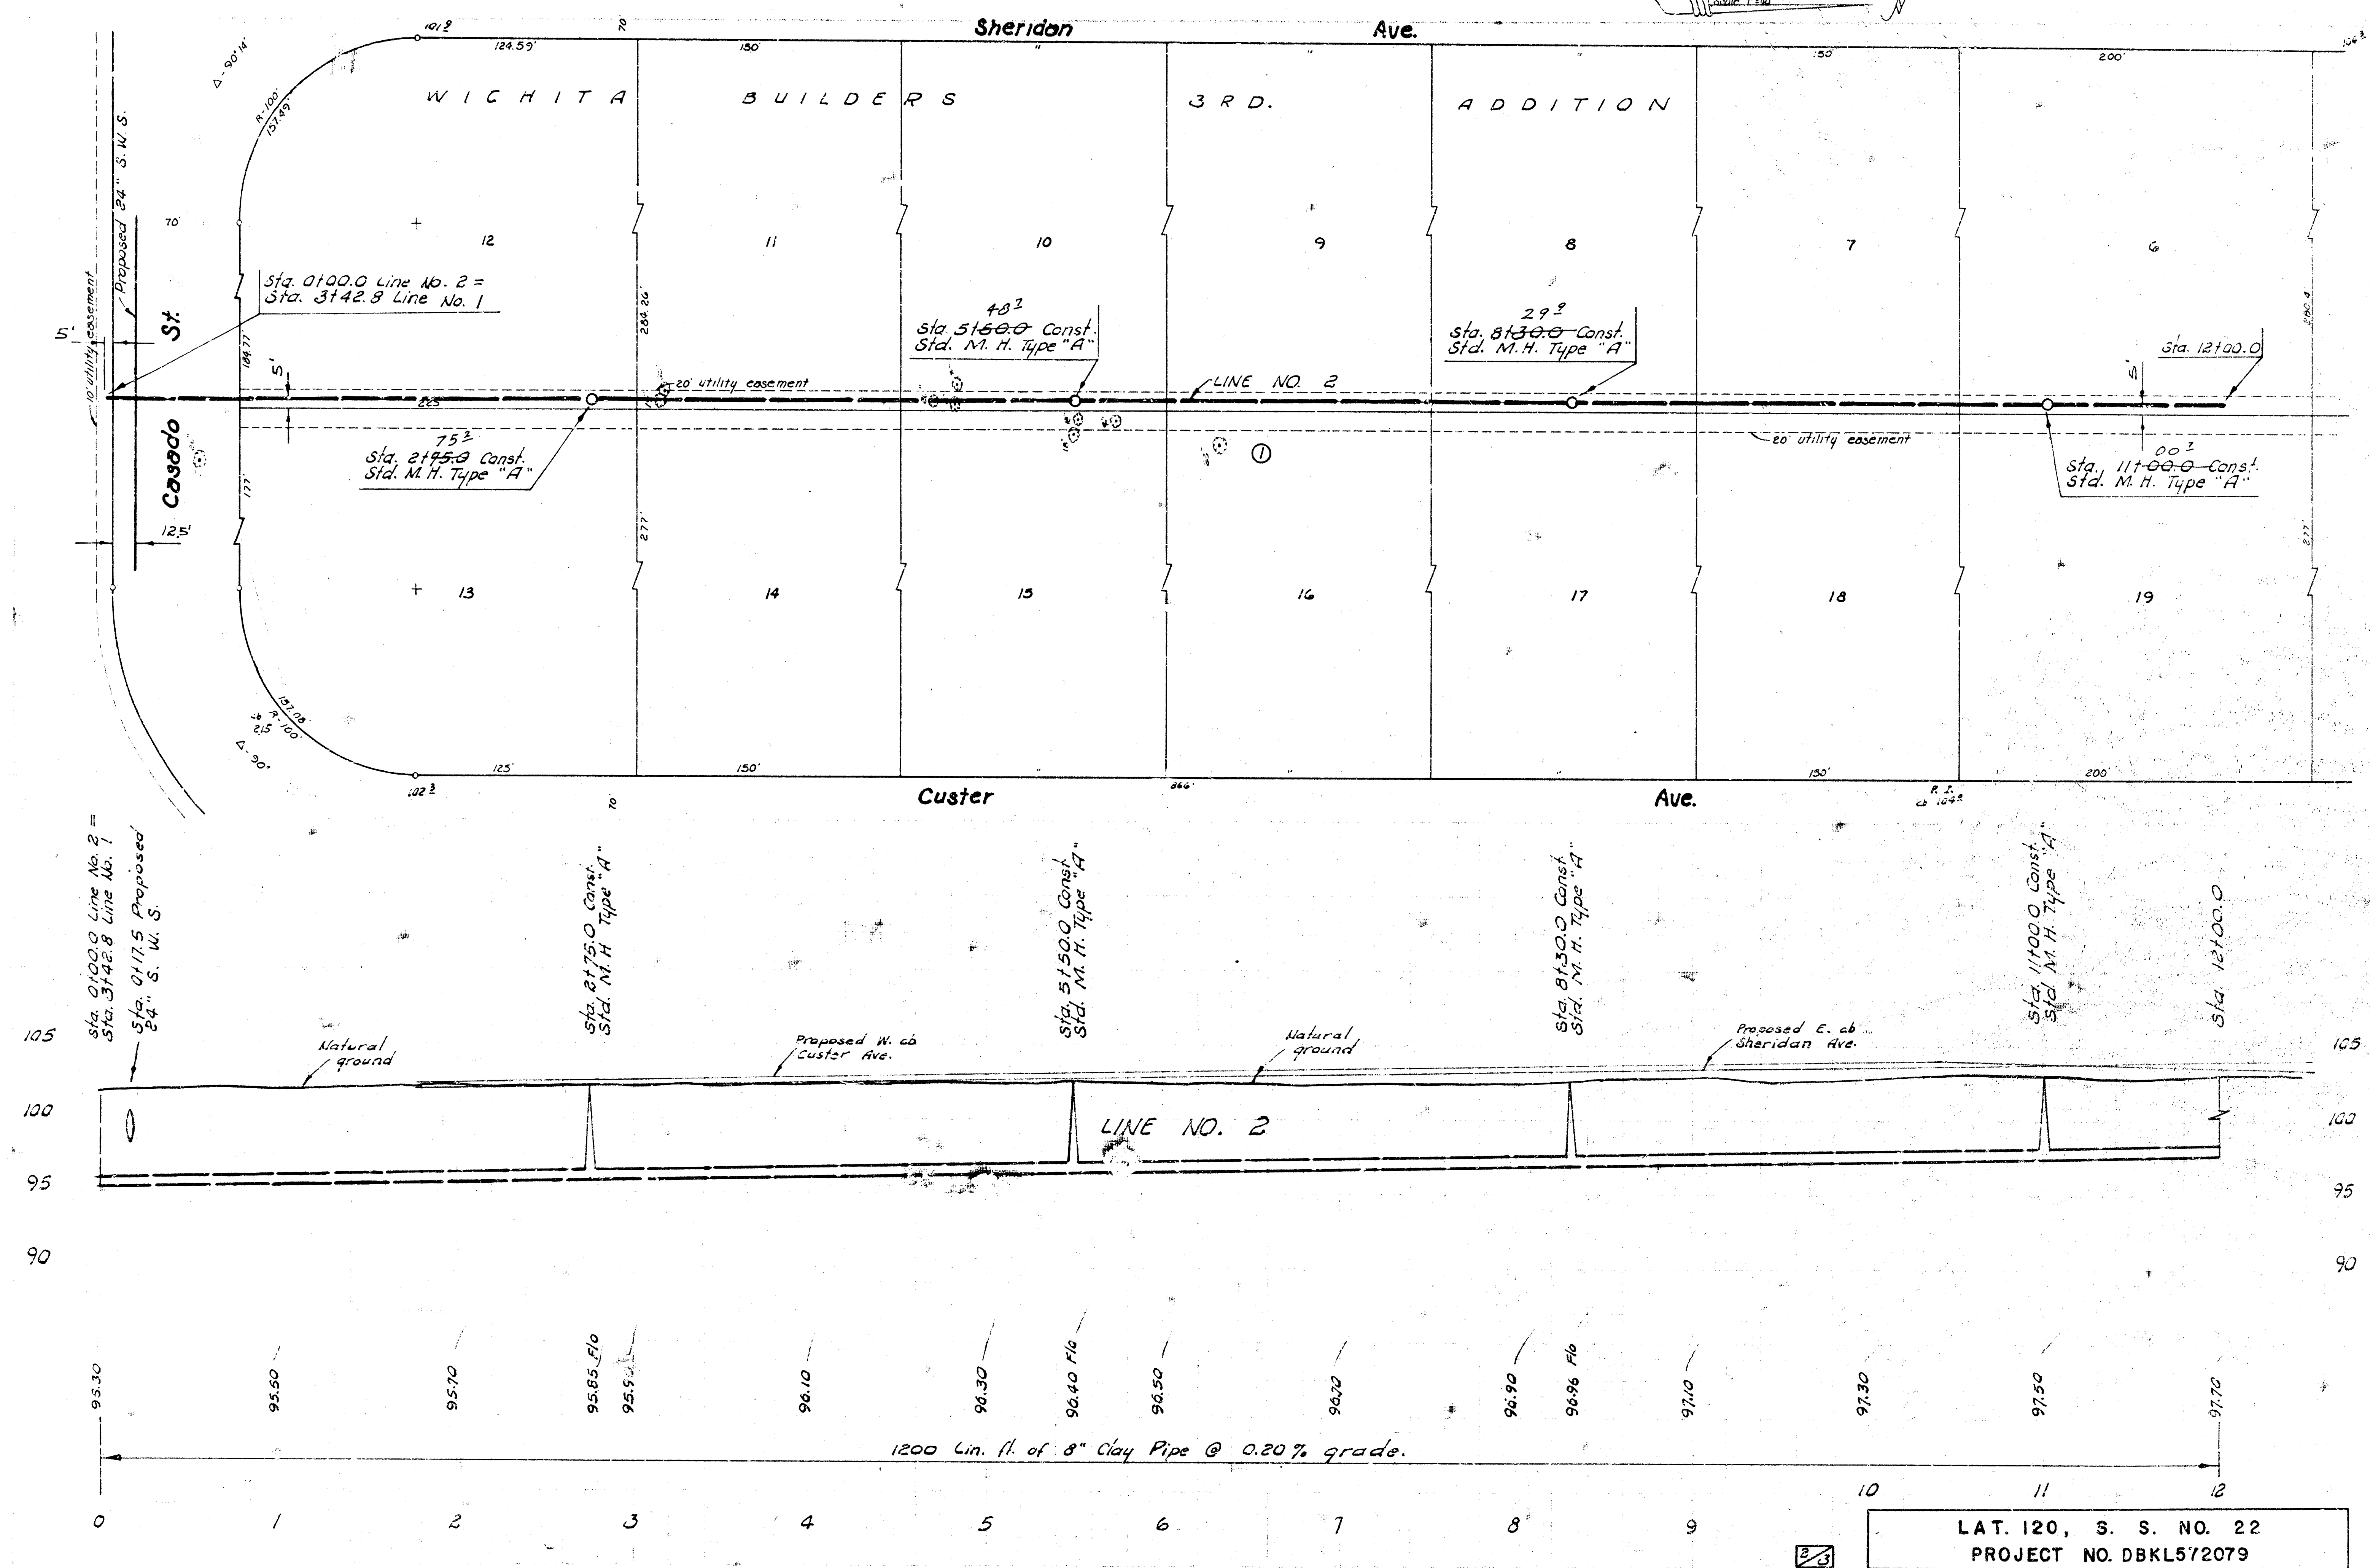

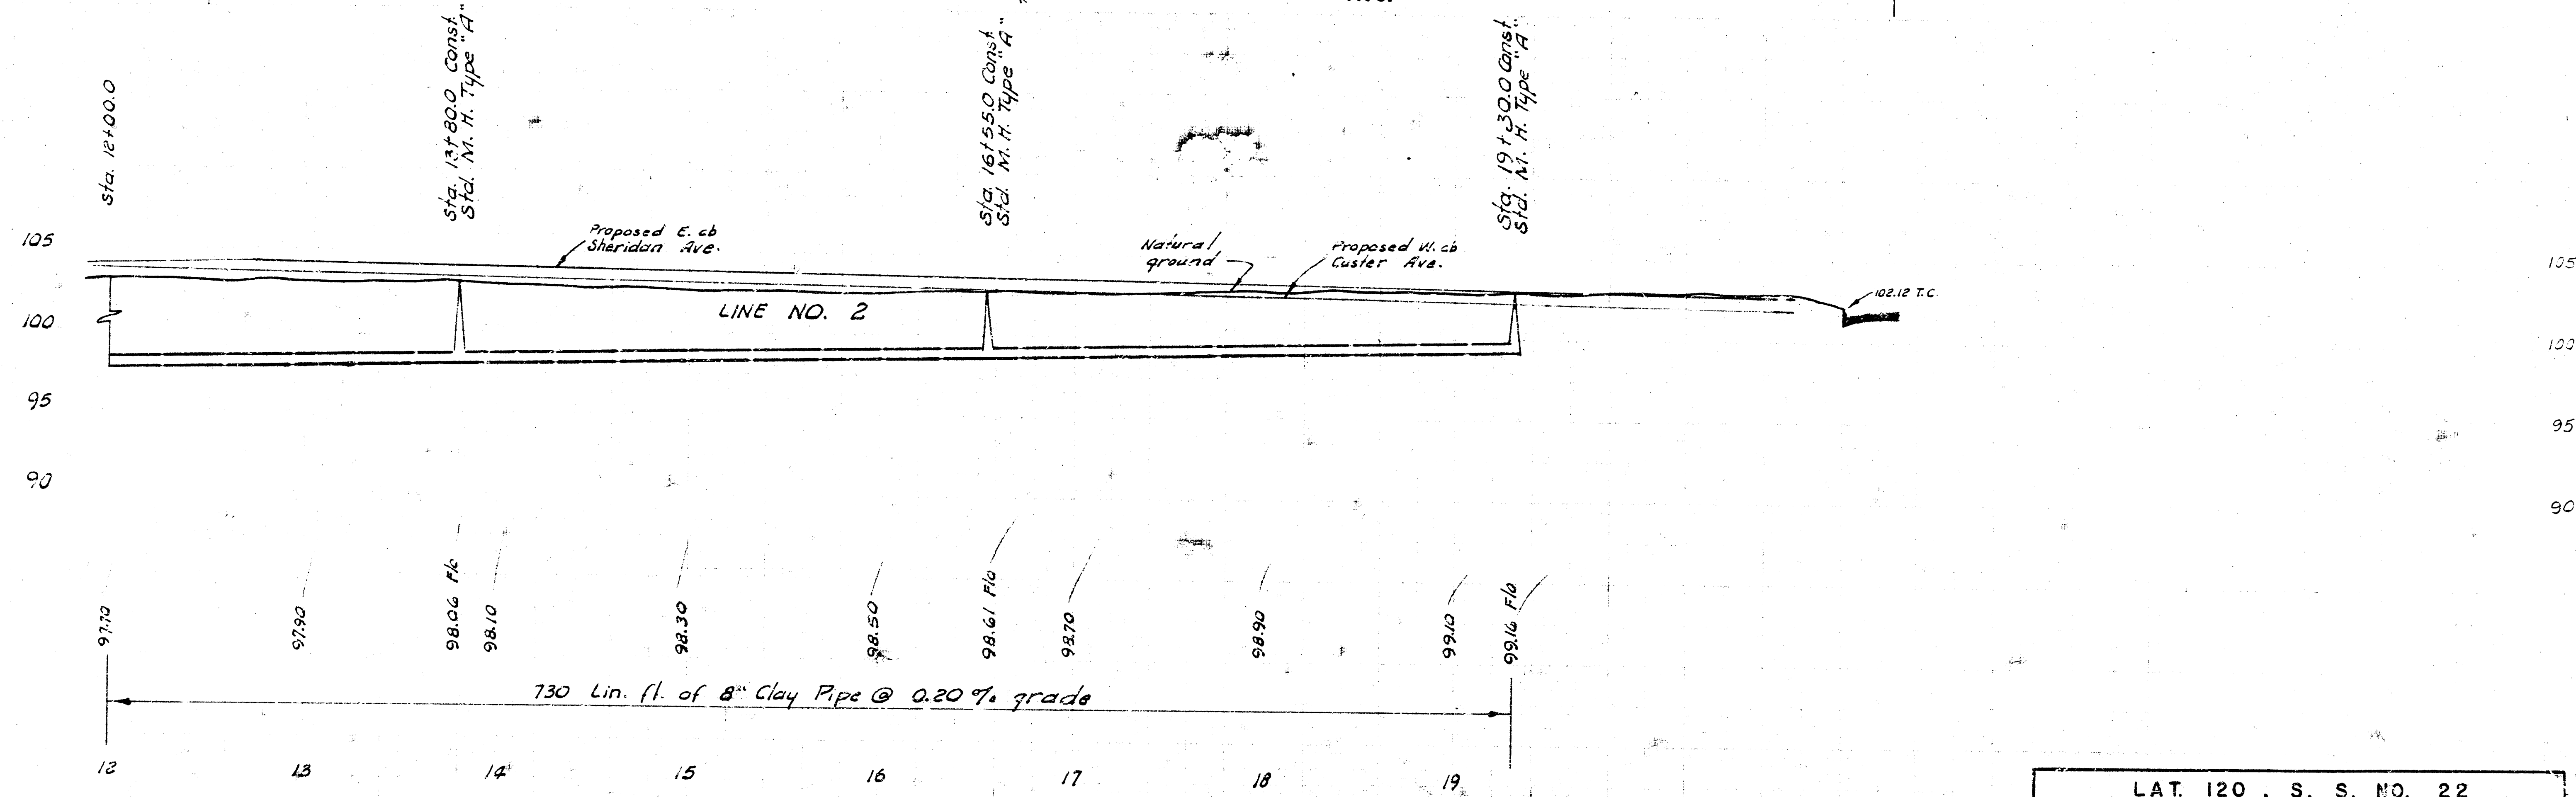

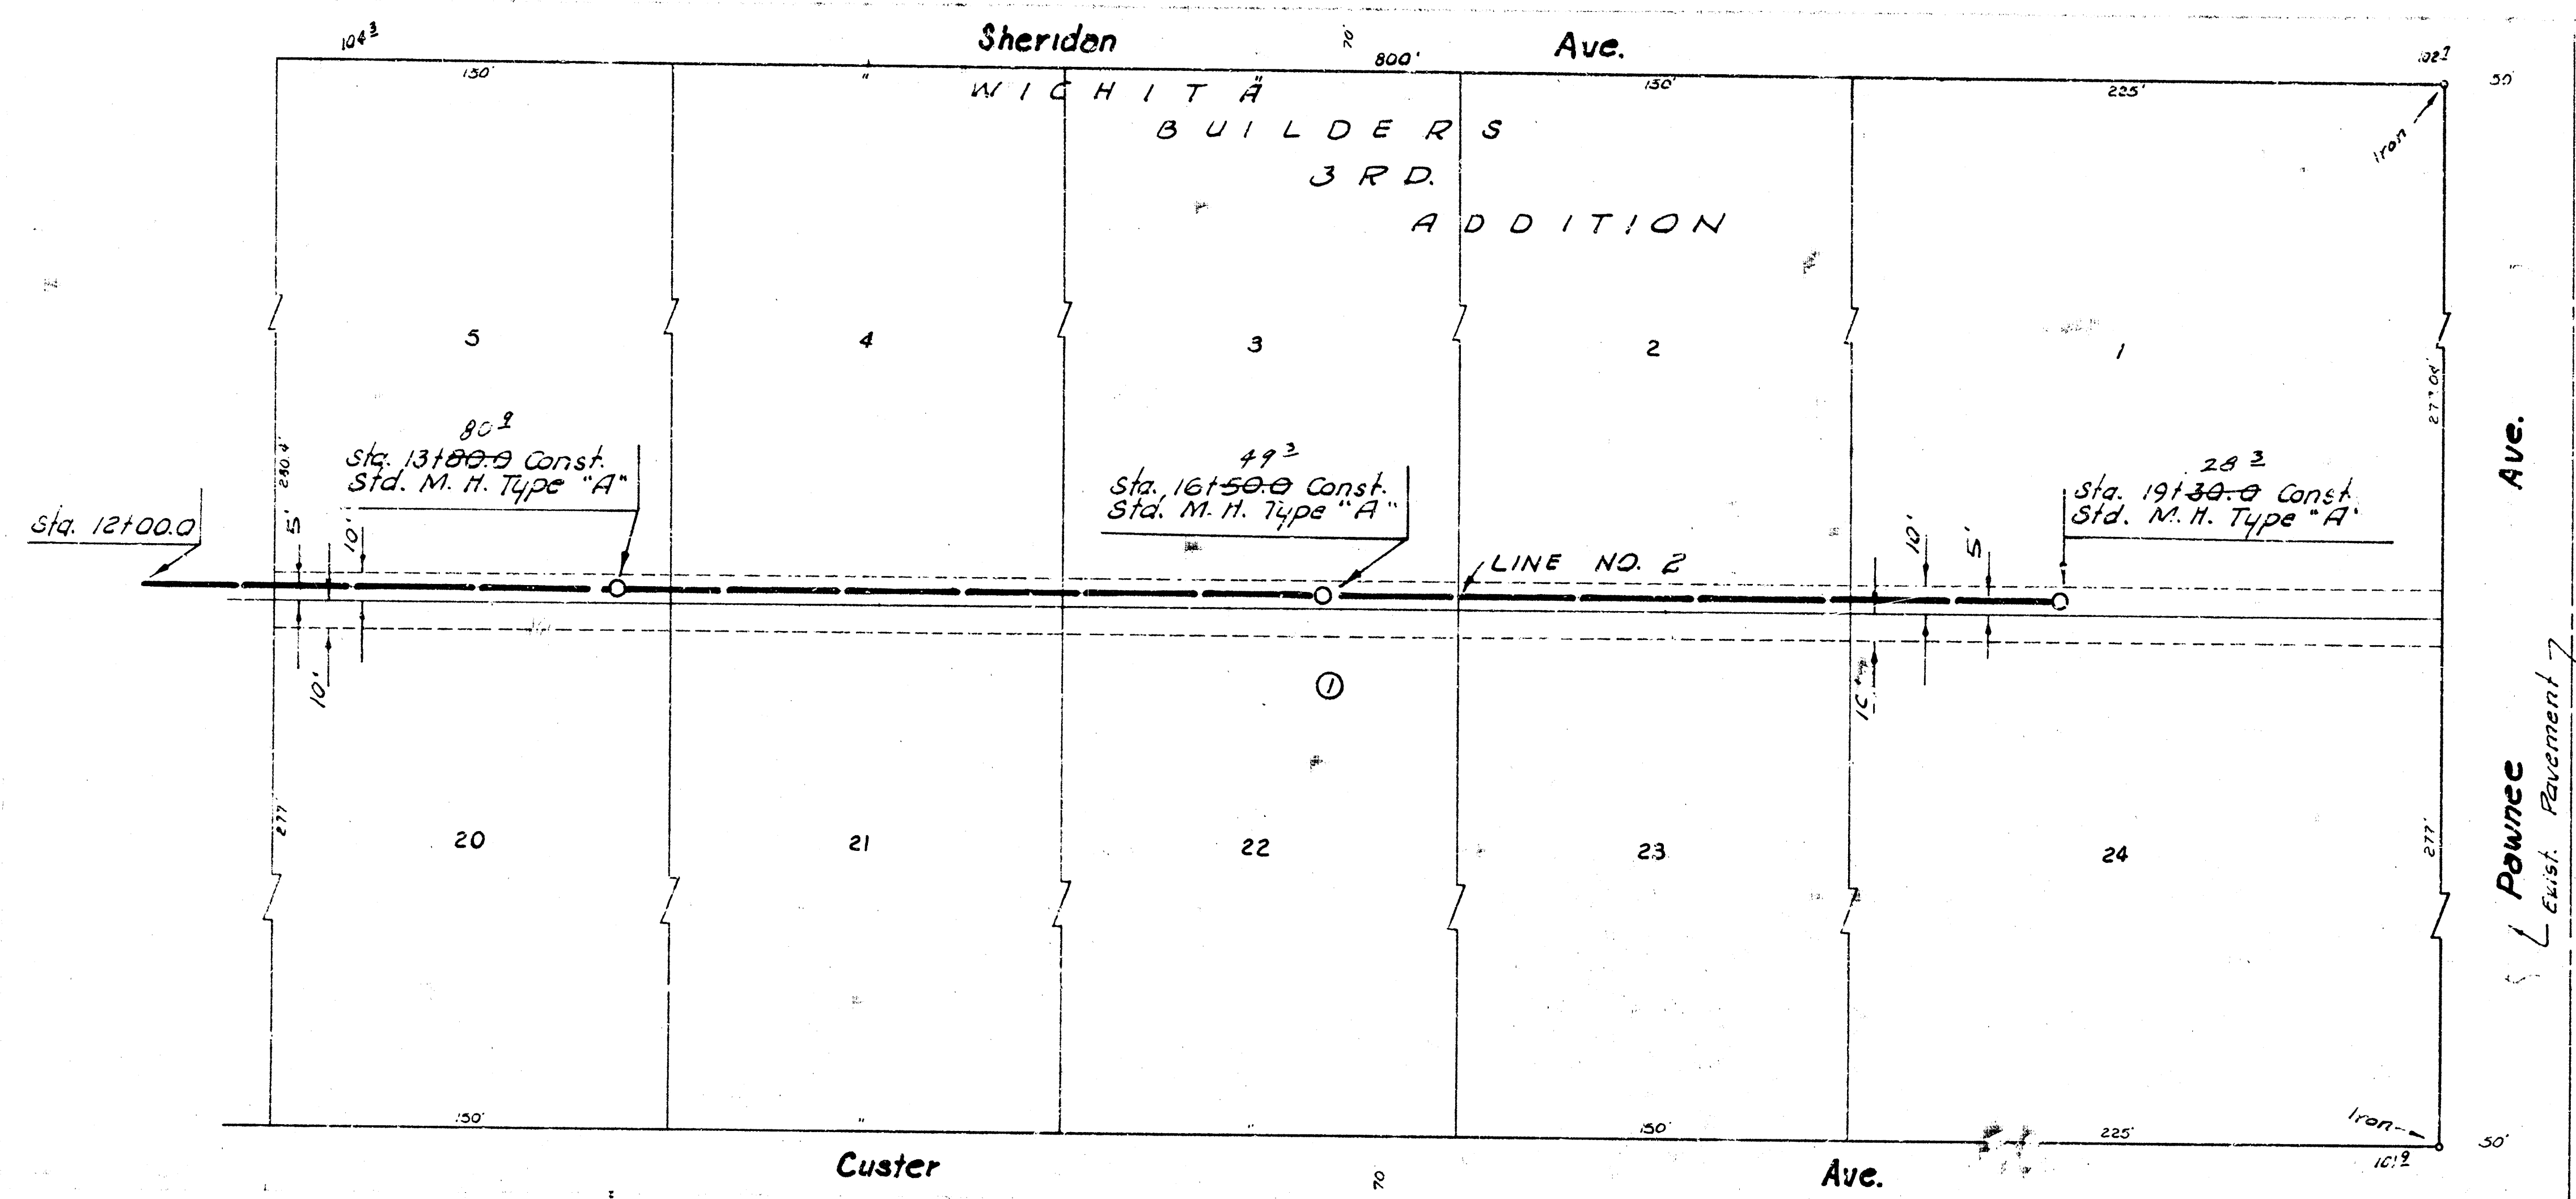

LAT. 120, S. S. NO. 22
PROJECT NO. DBKL572079

14