B.M. 99.93 City Std. Disc. 6' N. & 2' E. of S.E. R/W Corner of Sheridan & 31st

B.M. 103.52 City B.M. Disc Top East End South Handrail RCBC Sheridan & 31st

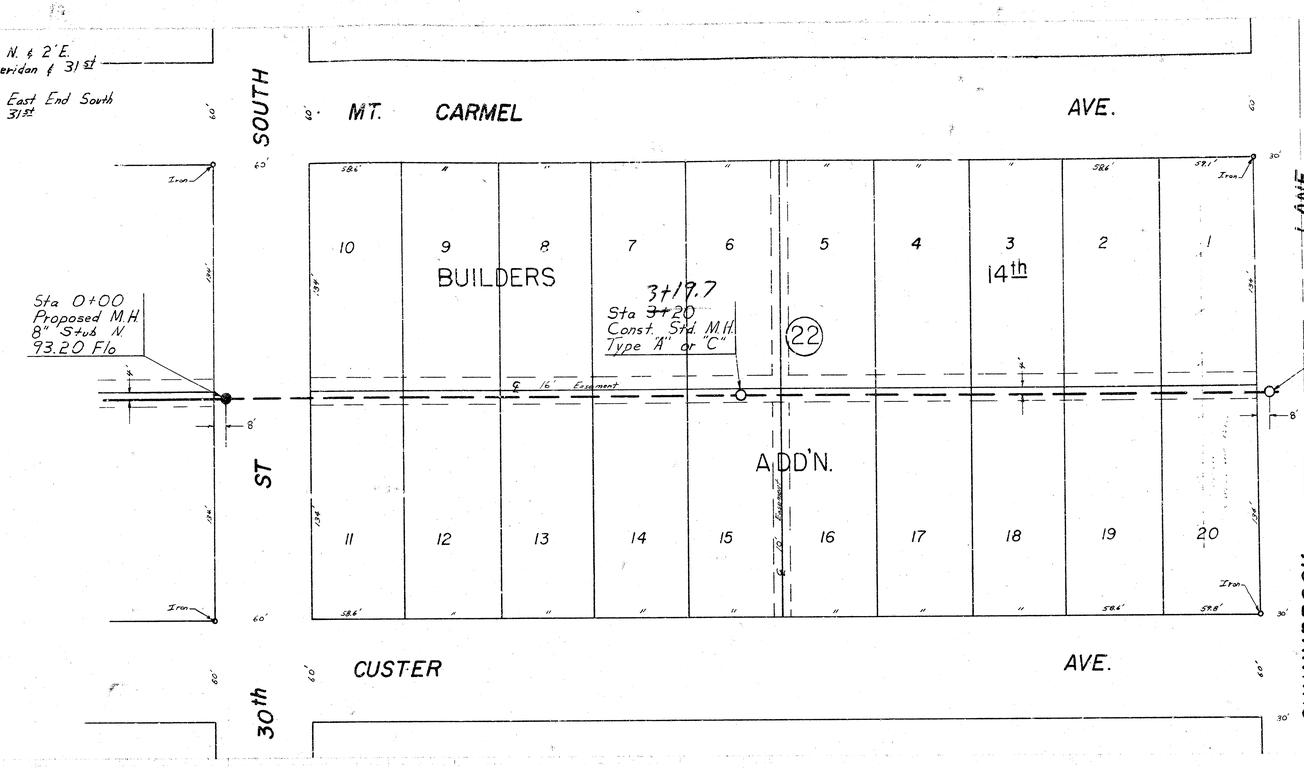

Plan Scale 1" = 40'
Profile Scale 1" = 40' Horz.
1" = 5' Vert.

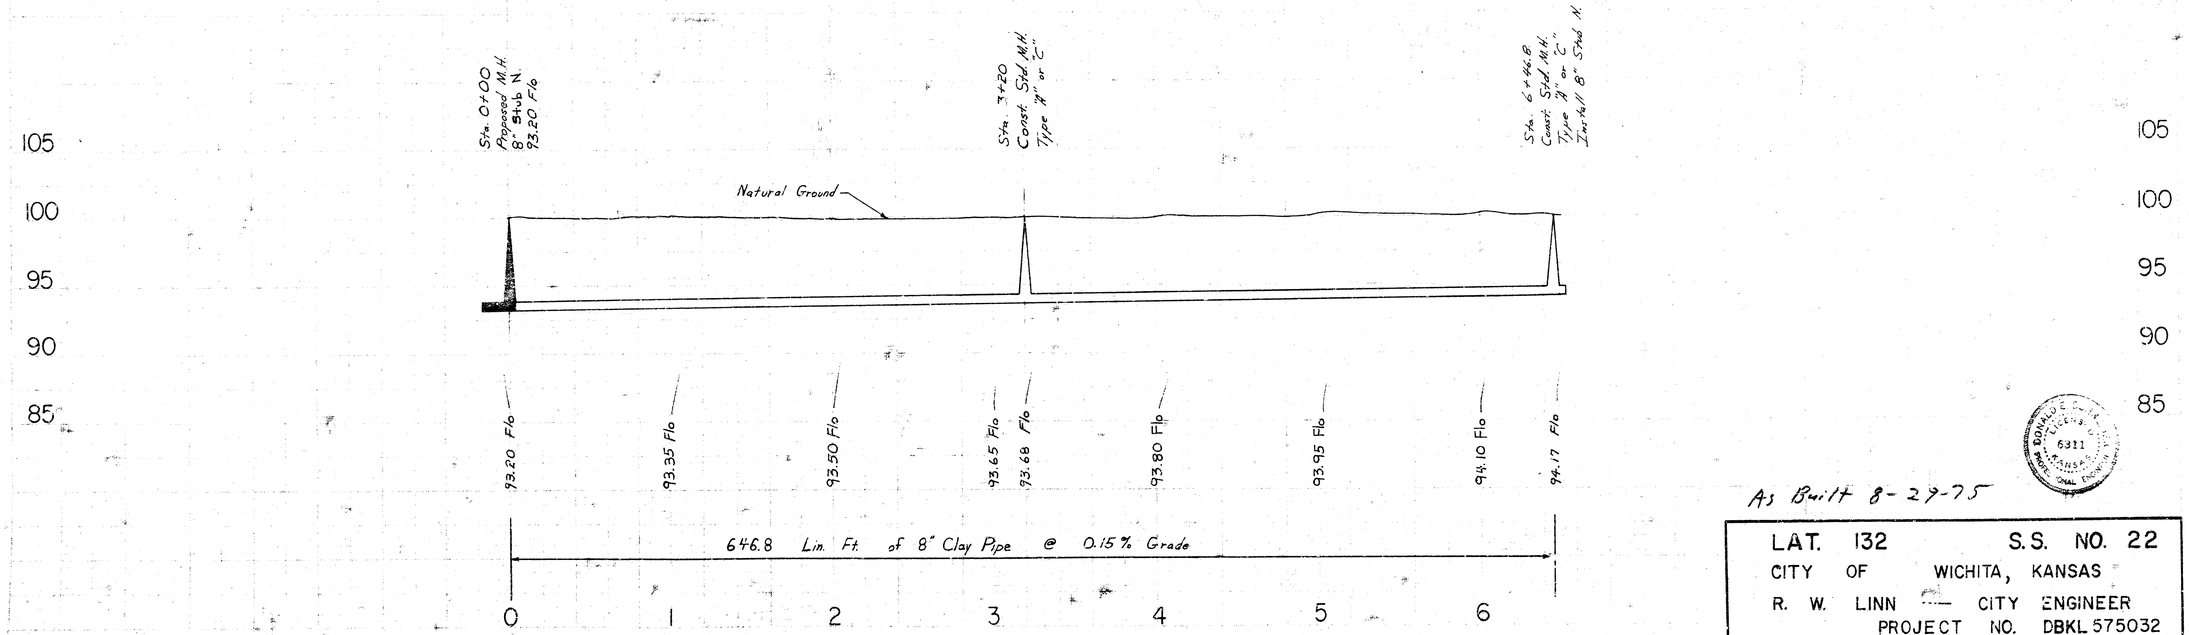

As Built 8-27-75

LAT. 132	S.S. NO. 22
CITY OF WICHITA, KANSAS	
R. W. LINN — CITY ENGINEER	
PROJECT NO. DBKL 575032	

17 8 5 4 1/1