
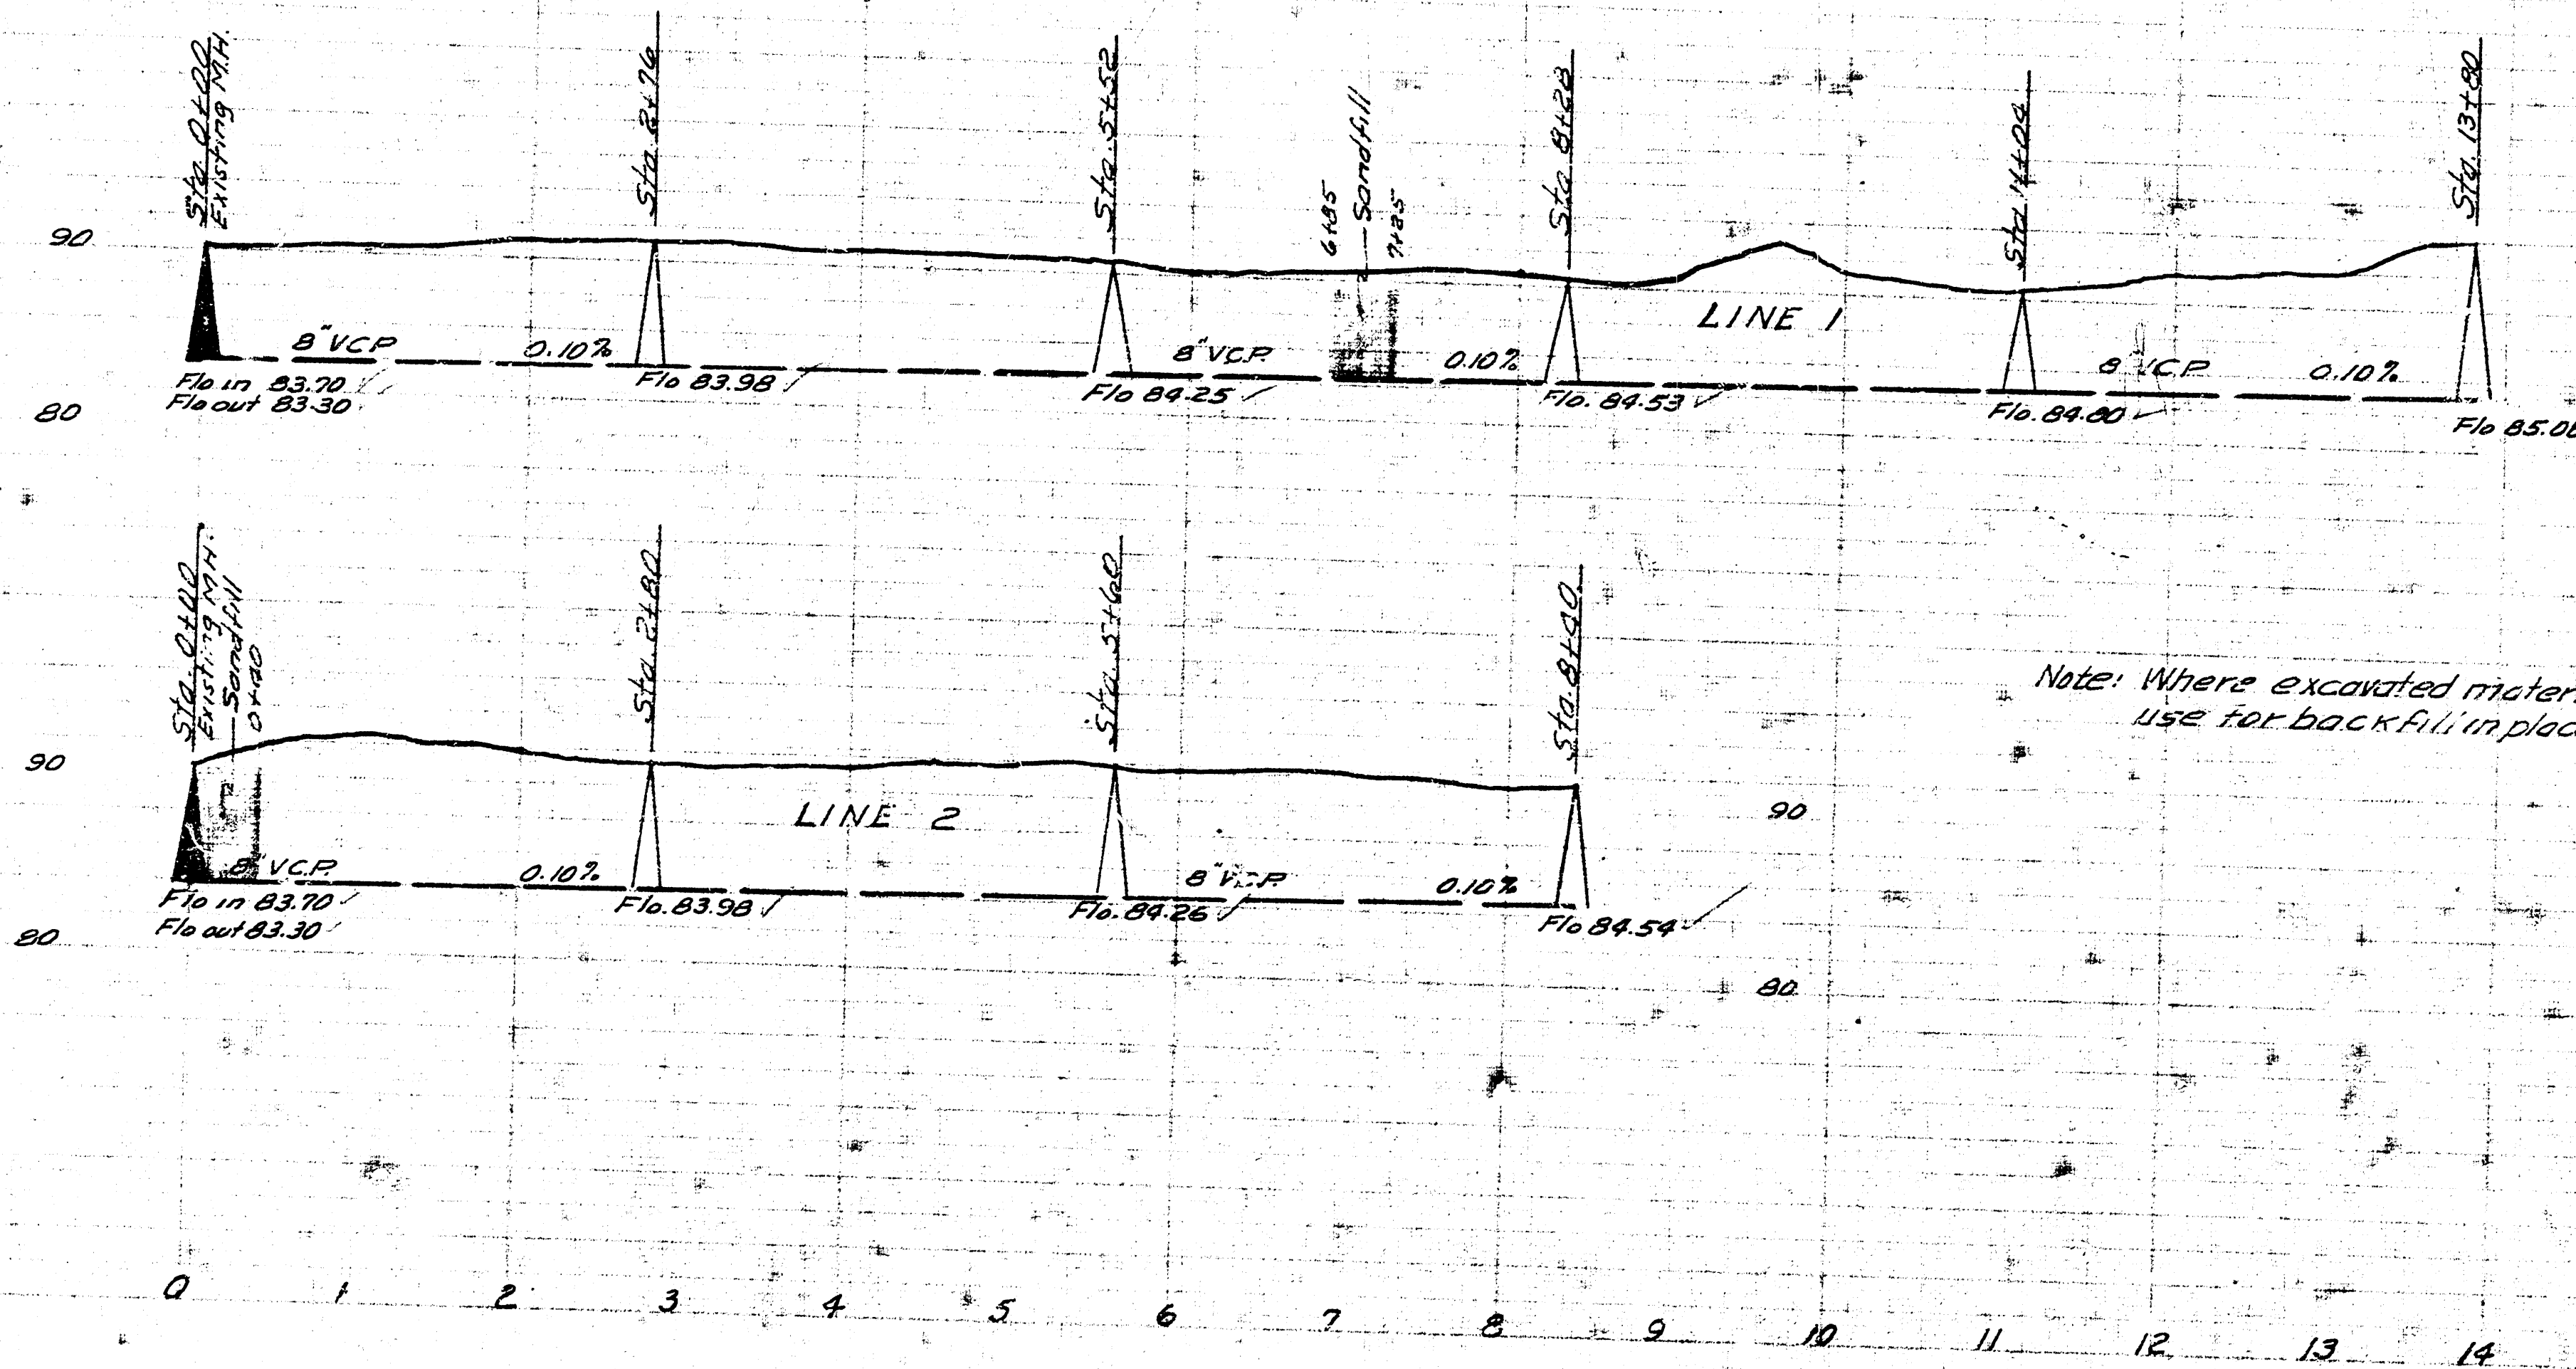


~ PART OF RAINBOW FIRST ADDITION ~

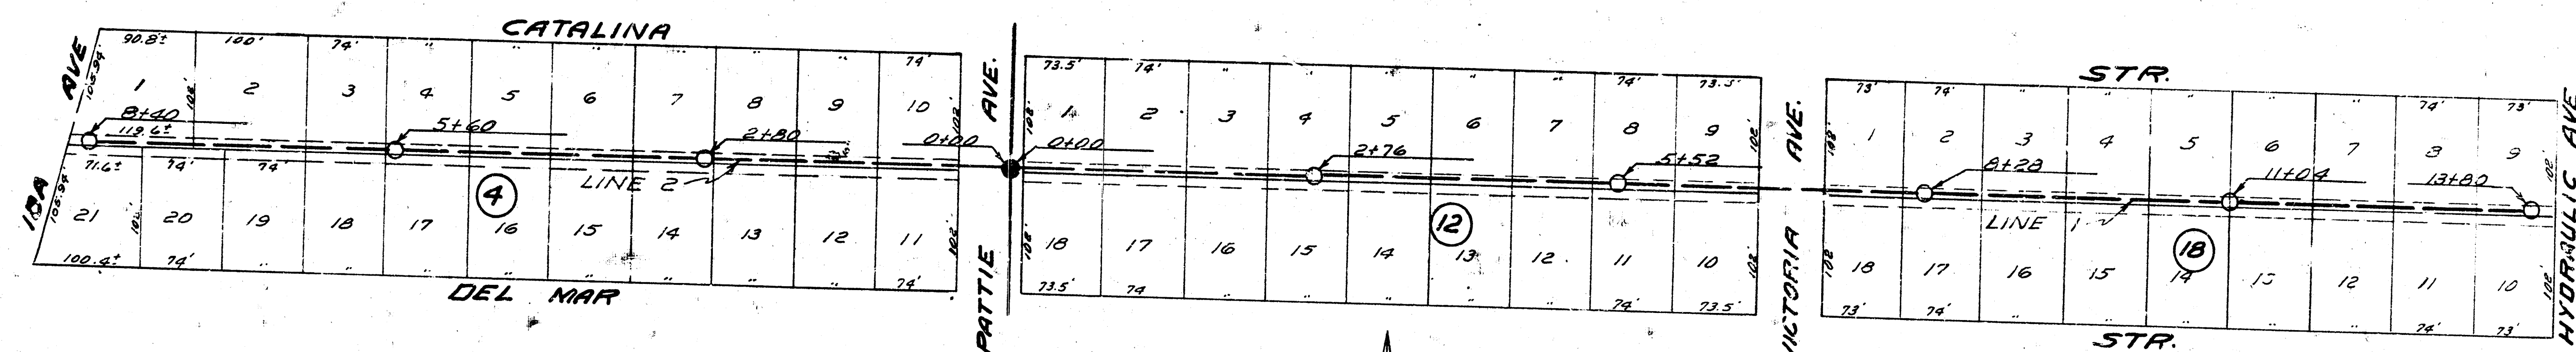

Note: Where excavated material is suitable use for backfill in place of sand and flush.

Date 8-17-54
Designed by McClain
Checked by
Approved by

LAT. 6 SUB MAIN 1 5322
CITY OF WICHITA KANSAS
BESMITH CITY ENGINEER
Proj. No. C-24-31

