



B.M. 96.30 "□" Top of Northeast concrete wingwall of bridge on 33rd Street South, West of Meridian.

B.M. 95.65 City Std. Disc 6.0 ft. East and 2.0 ft. North of the Northwest corner of Meridian and 35th Street South.

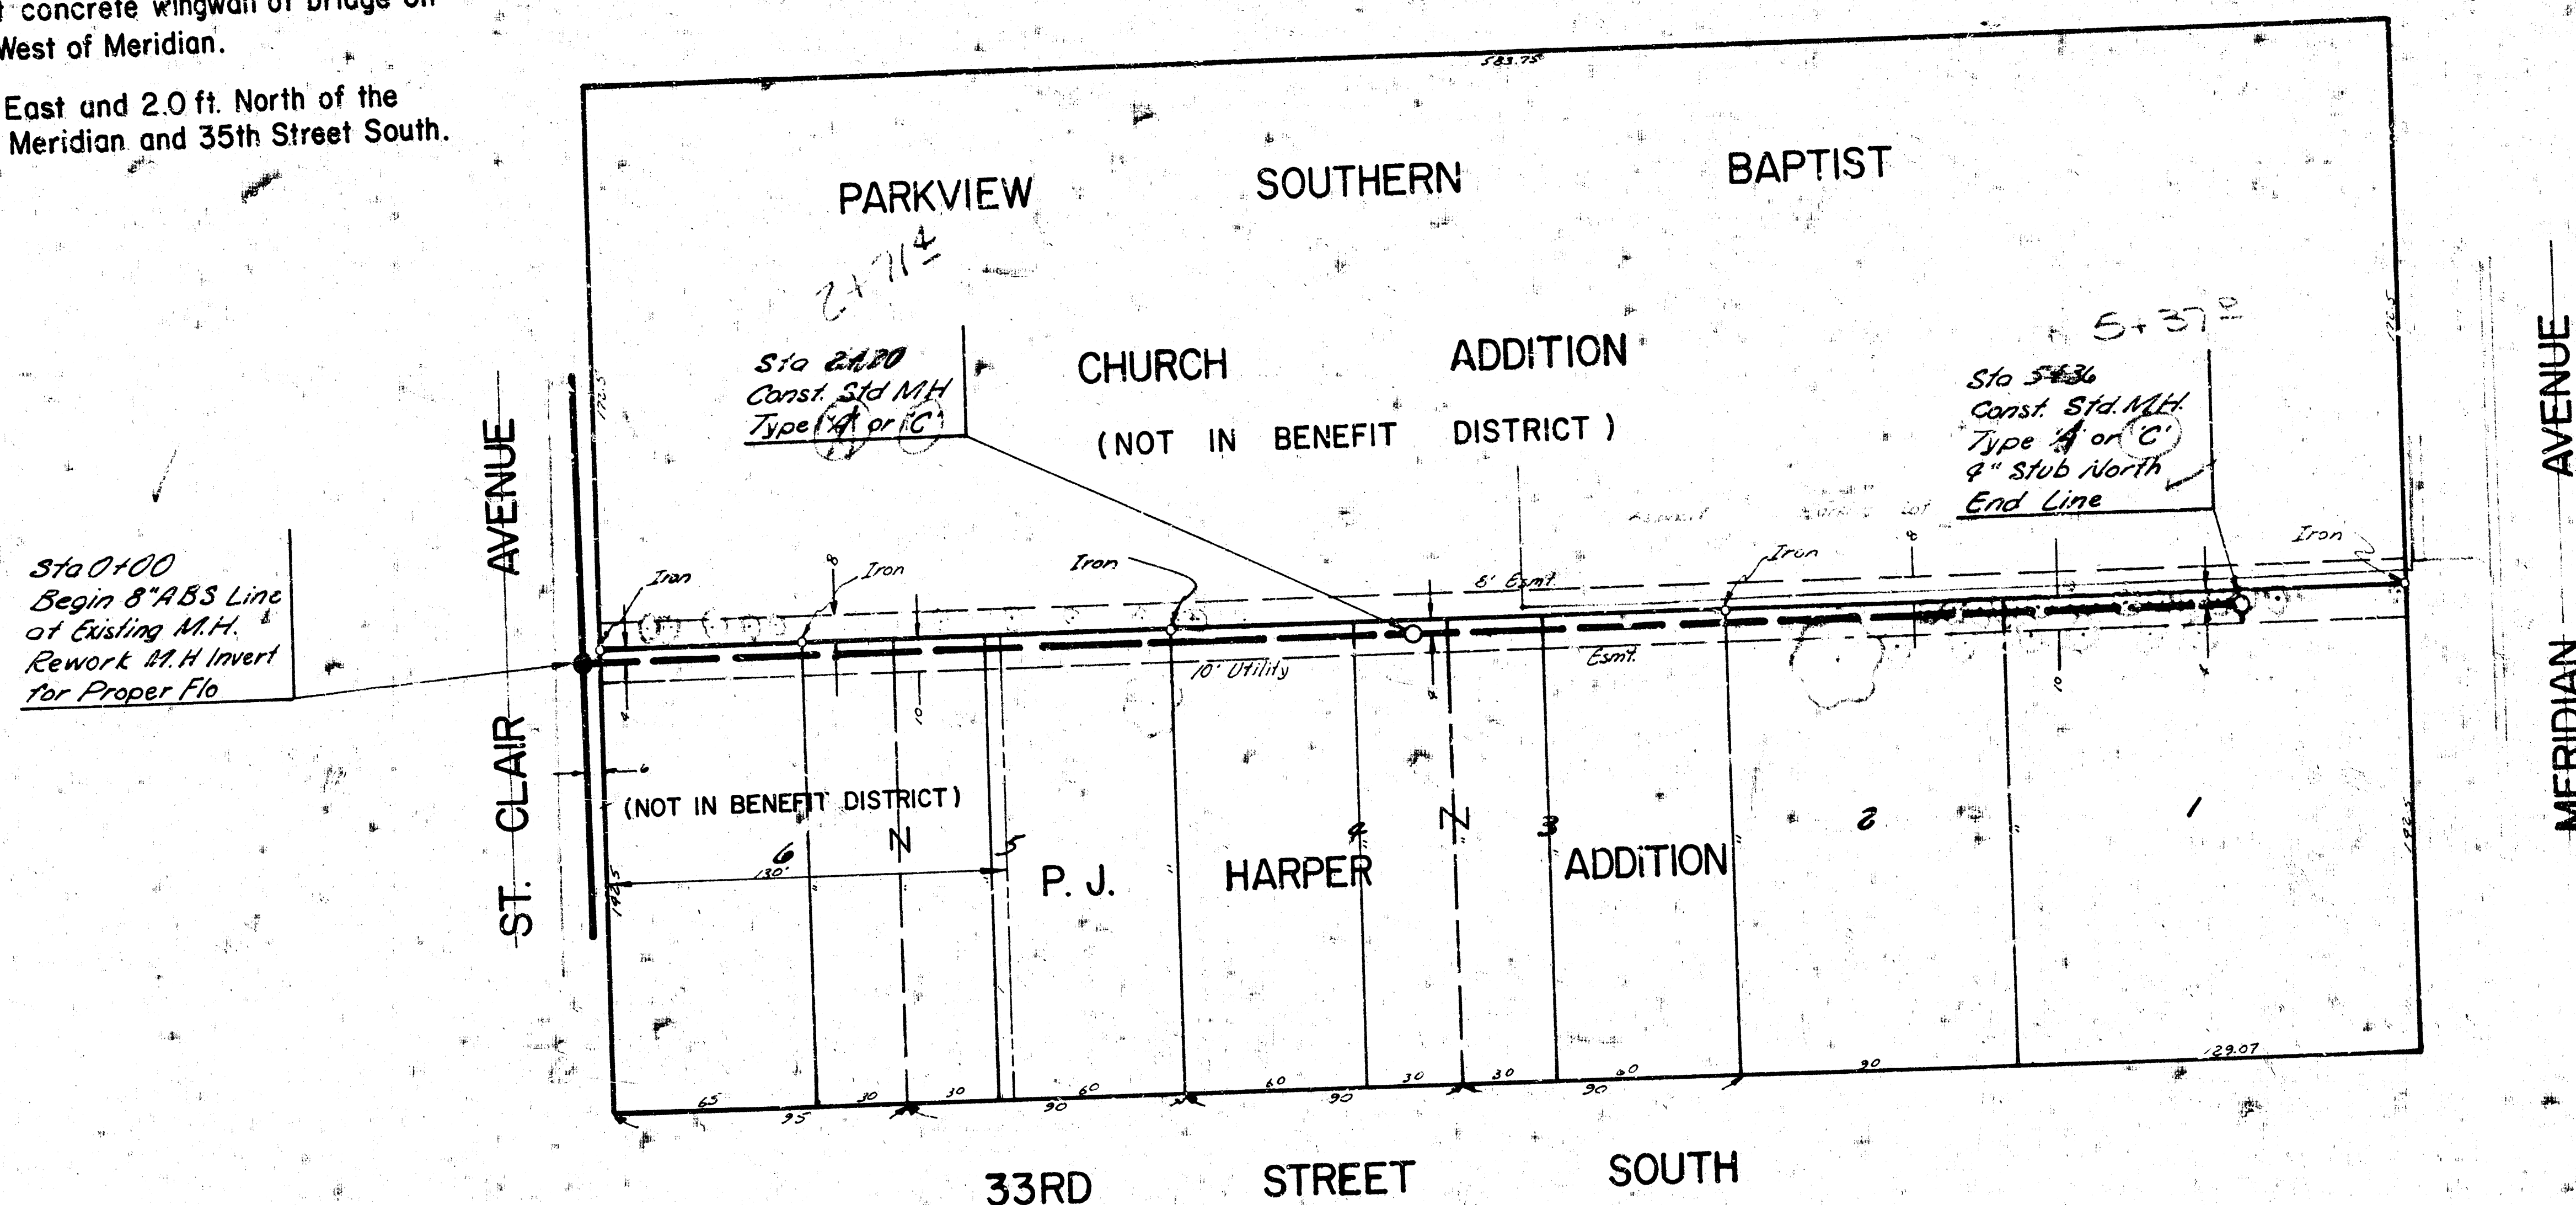

Plan Scale: 1" = 40'

Profile Scale: 1" = 40' Horiz.
1" = 5' Vert.

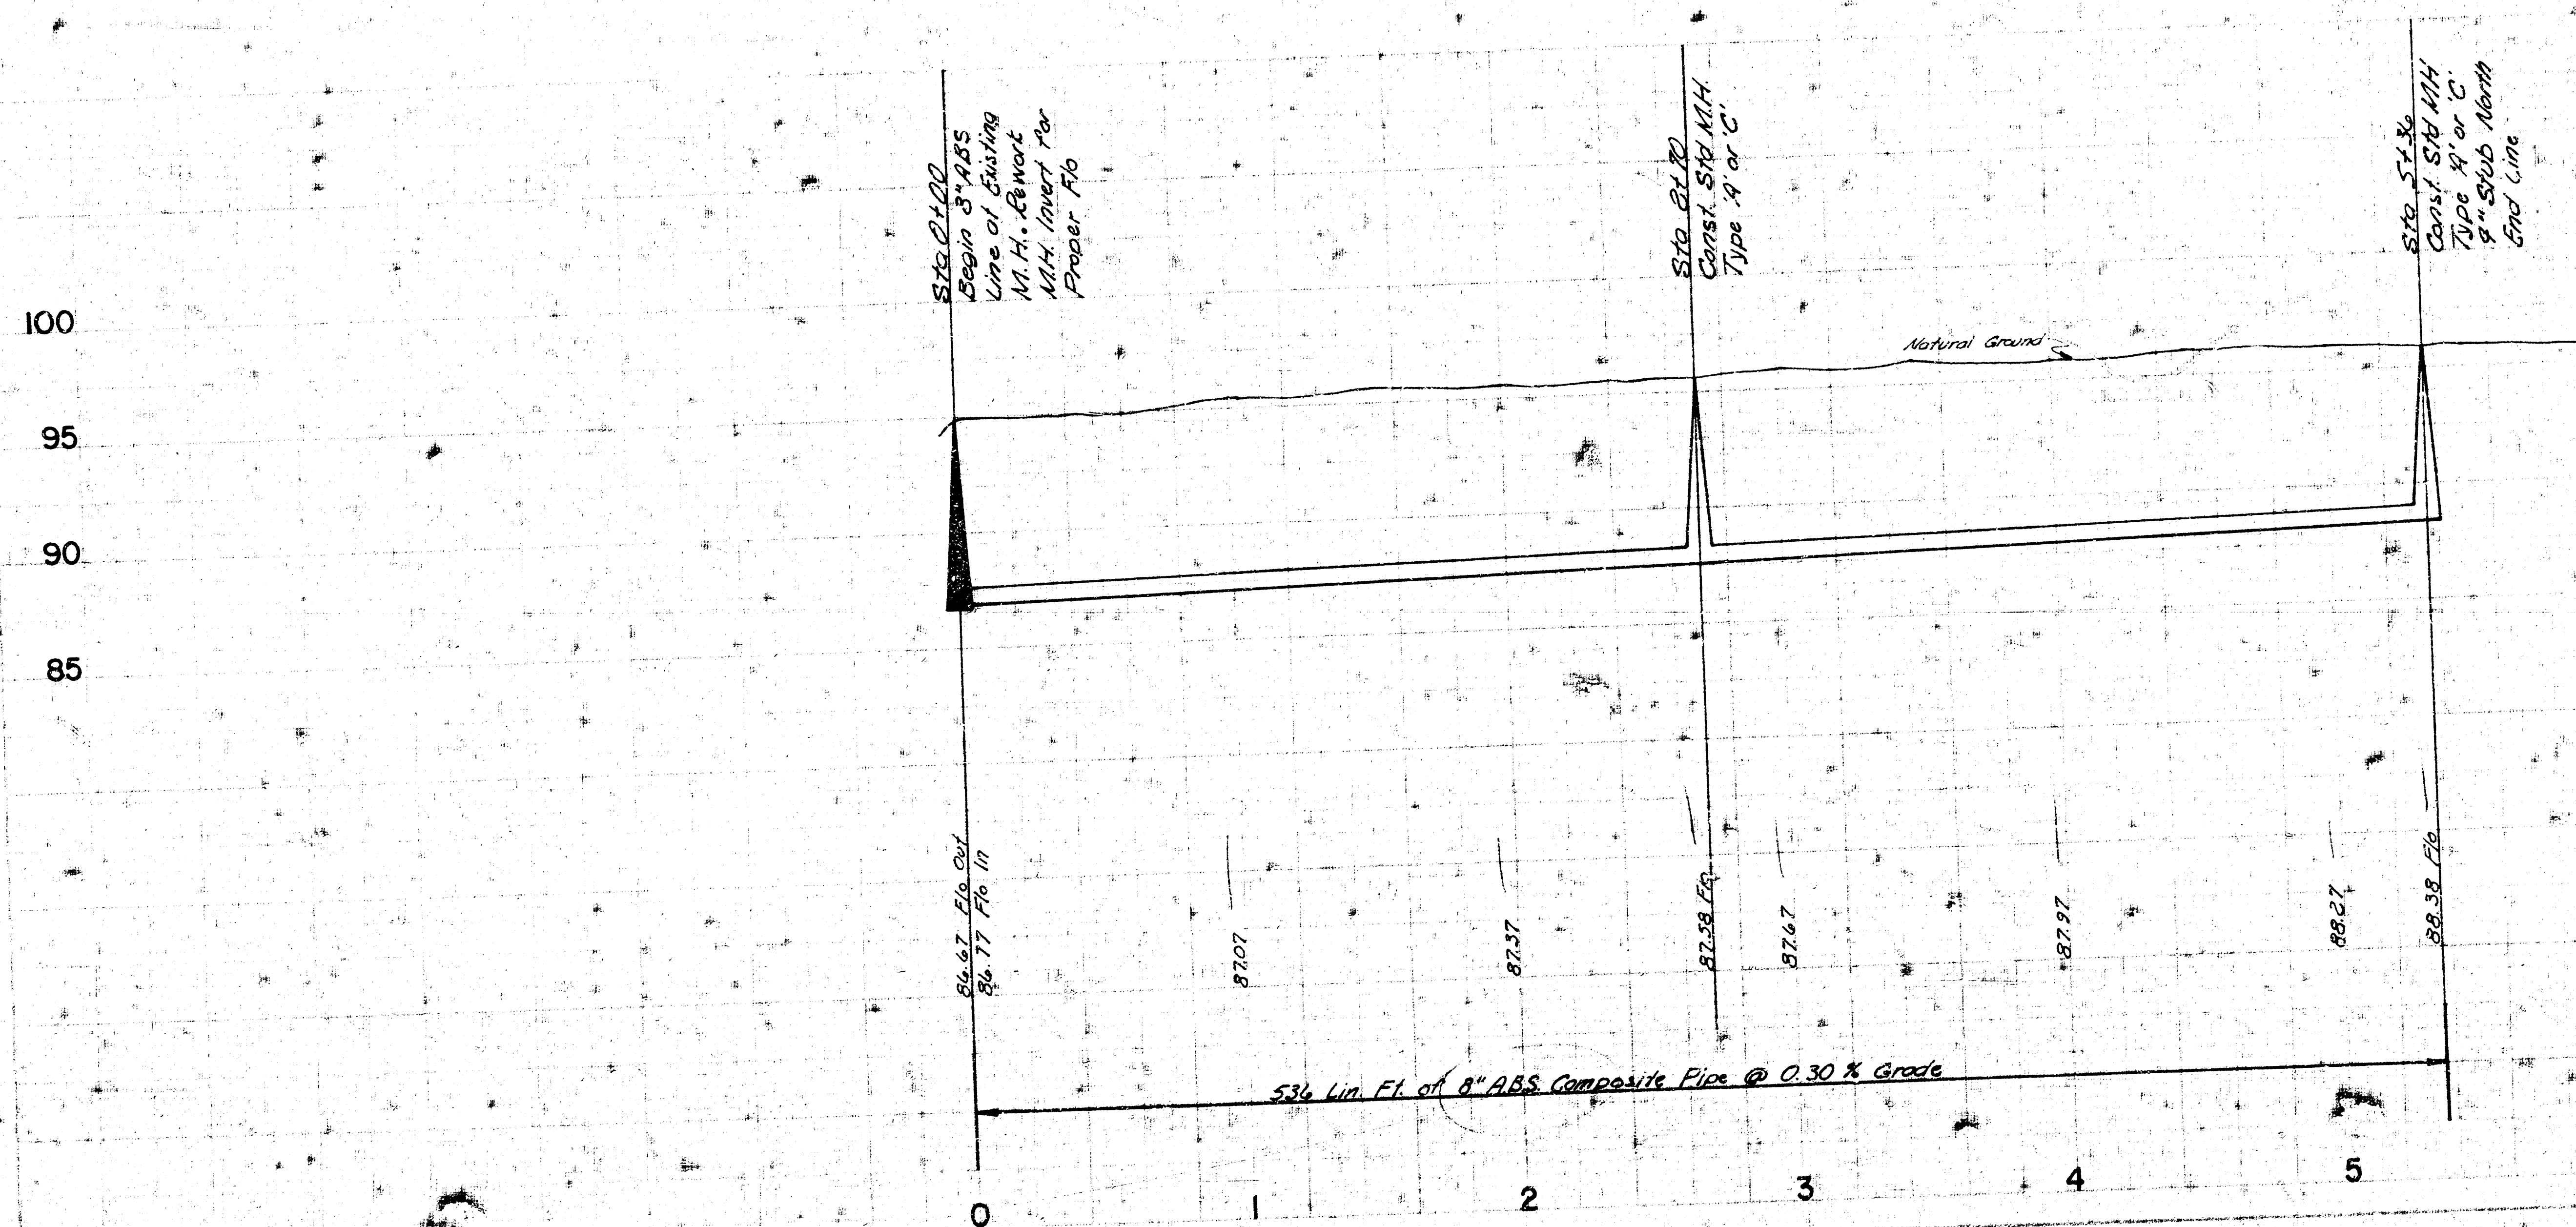

LAT 33 MAIN 3 S.S. 22

CITY OF WICHITA, KANSAS

R.W. LINN CITY ENGINEER

PROJECT NUMBER: 468-76-245-00241-000-001

DATE: 11/5/23