PRIVATE STORMWATER SEWER EXTENSION

TO SERVE

AIR CARGO FACILITY
MID-CONTINENT AIRPORT

PRIVATE PROJECT NO. _____ PPS (607861)

CITY OF WICHITA, KANSAS

JAMES L. ARMOUR, P.E. - CITY ENGINEER

INDEX OF SHEETS

SHEET NO. C201	TITLE SHEET
SHEET NO. C202	KEY MAP AND GENERAL NOTES
SHEET NO. C203	PLAN/PROFILE-SWS LINE 1
SHEET NO. C204	PLAN/PROFILE-SWS LINE 2
SHEET NO. C205	SWS DETAILS
SHEET NO. C601-C603	SOIL EROSION BMP DETAILS

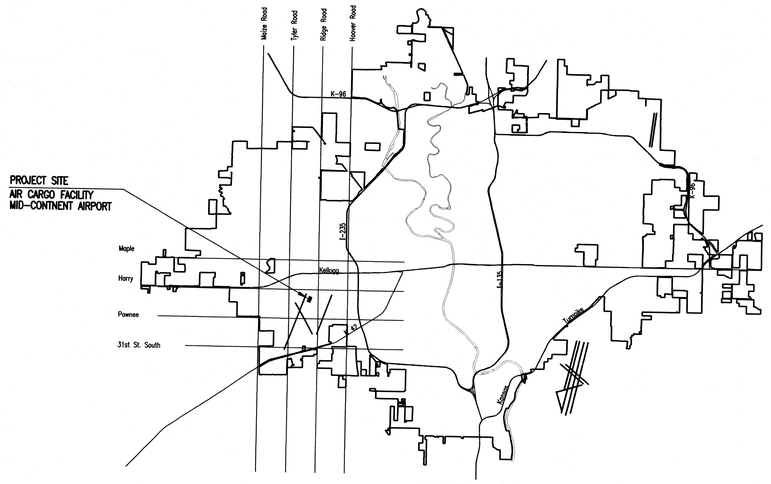

LOCATION MAP

APPROVED AS NOTED
By CITY ENGINEER OF WICHITA

Sanitary Sewers _____

Storm Sewers _____

Driveway Approaches _____

Paving _____

NOTE TO CONTRACTOR

INSPECTION AND TESTING FOR THIS PROJECT IS TO BE PROVIDED BY A LICENSED CONSULTING ENGINEERING FIRM CONTRACTED BY THE OWNER/DEVELOPER. SAID INSPECTION TO BE IN ACCORDANCE WITH THE CITY OF WICHITA STANDARD CONSTRUCTION ENGINEERING PRACTICES AND CERTIFIED BY A LICENSED PROFESSIONAL ENGINEER. NO WORK SHALL BE PERFORMED IN DEDICATED EASEMENTS OR PUBLIC RIGHT-OF-WAY BY THE CONTRACTOR UNTIL SUCH INSPECTION IS ARRANGED FOR AND REQUIRED BONDS HAVE BEEN SUBMITTED TO AND APPROVED BY THE CITY NOR SHALL ANY WORK BE COMMENCED IN DEDICATED EASEMENTS OR PUBLIC RIGHT-OF-WAY WITHOUT WRITTEN AUTHORIZATION BY THE CITY ENGINEER. IMPROVEMENTS PERFORMED UNDER THIS PROJECT SHALL NOT BE ACCEPTED BY THE CITY UNTIL ALL APPLICABLE DOCUMENTATION HAS BEEN SUBMITTED TO THE CITY ENGINEER. THIS MAY INCLUDE: RECORD DRAWINGS, INSPECTION LOGS, TEST DOCUMENTATION, TV TAPES, AND A CERTIFICATE OF COMPLETION. THE ABOVE SHALL BE PERFORMED BY THE CONSULTING FIRM CONTRACTED TO INSPECT THIS PROJECT.

AS BUILTS:

CONTRACTOR: Snodgrass & Sons
INSPECTOR: Larry Gann
COMPANY: K. E. Miller Eng.
DATE: 6/9/08

JULY 2007

PLANS PREPARED BY

PROFESSIONAL ENGINEERING CONSULTANTS, P.A.

ENGINEERS

WICHITA, KANSAS

GossenLivingston
Architecture
420 South Emporia
Wichita, KS 67202
Tel: (316) 265-9367
Fax: (316) 265-5646
Email: architects@gossenlivingston.com

2007 Gossen Livingston Associates, Inc.

All work herein is the exclusive property of Gossen Livingston Associates, Inc. and is not to be copied or used in any way without the express written consent of Gossen Livingston Associates, Inc. All drawings, specification, ideas, designs and arrangements appearing herein constitute the original and unpublished Work of:

Gossen Livingston Associates, Inc.

NORTH AIR CARGO FACILITY
MID-CONTINENT AIRPORT
Wichita, Ks.

Mark	Date:	Description

STORM SEWER
TITLE SHEET

Job No.	1049.200
Date	12/12/07
Drawn	SAW
Checked	DWH

C201

Dwg. of

Professional Engineering Consultants, P.A.
303 S. TOPEKA • WICHITA, KANSAS 67202 • 316-262-2691 • FAX 316-262-3003
www.pec1.com

Saved 12-10-2007 10:47:38 AM by CP
Plot Scale 1:1 12-10-2007 11:46:44 AM by CP
Q:\2006\06026\CONSTRUCTION DRAWINGS\06026-C201-PPStormTitle Sheet