


**MT VERNON STREET AND
DRAINAGE IMPROVEMENTS
FROM GREENWAY TO BROADWAY**

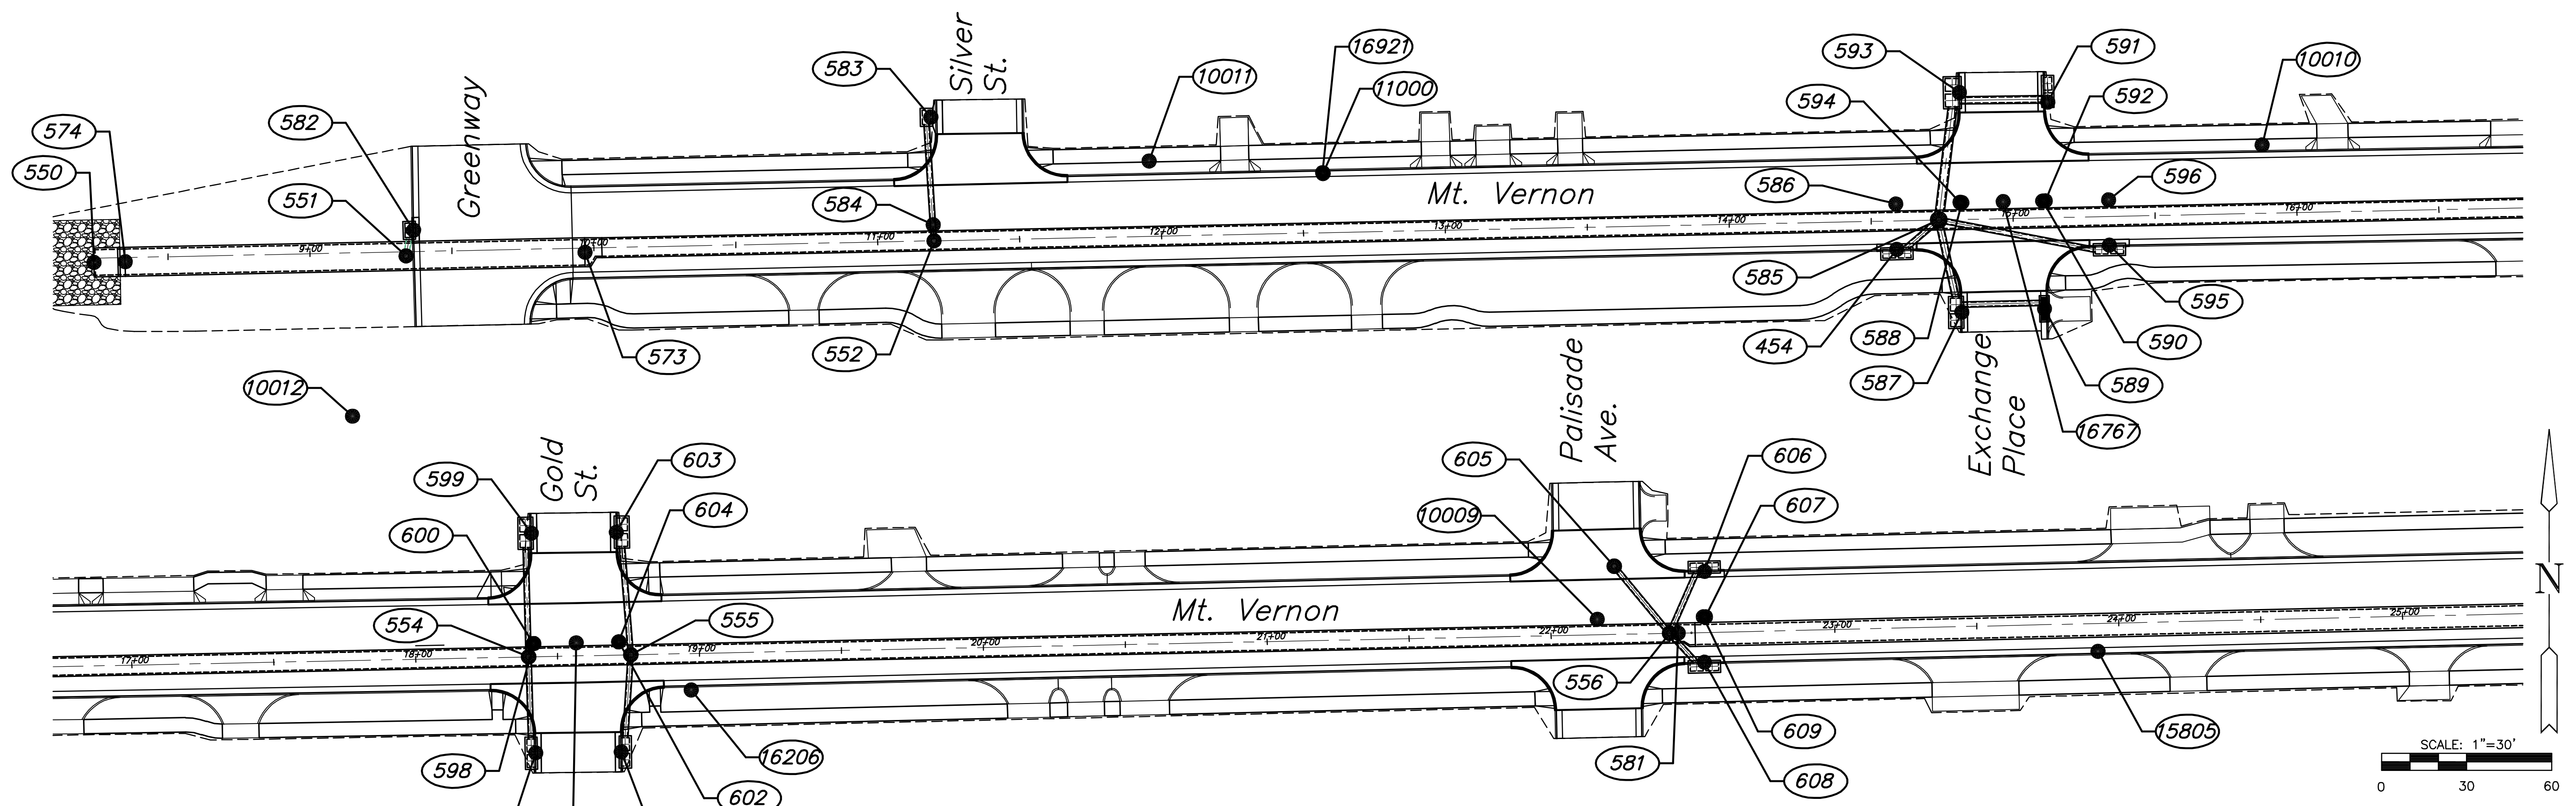

POINT NUMBER	STATION	OFFSET	NORTHING	EASTING	DESC
550			1675161.1411	1645993.0600	CastnPlace
551			1675163.4182	1646103.0364	MH
552			1675168.7682	1646288.9655	MH
553			1675176.0961	1646642.8896	MH
554			1675183.6725	1647008.8112	MH
555			1675184.4177	1647044.8035	MH
556			1675191.9940	1647410.7251	MH
573			1675164.7031	1646166.0233	Trans.
574			1675161.3688	1646004.0576	EndSecHdWall
581			1675192.0559	1647413.7149	Trans
582			1675172.4702	1646105.6556	Inlet
583			1675212.2975	1646287.8552	Inlet
584			1675174.3789	1646288.6775	BL-INLETOFFSET
585			1675165.7365	1646628.1156	INLET
586			1675181.7327	1646627.7687	BL-INLETOFFSET
587			1675143.5927	1646651.0305	INLET
588			1675182.2974	1646650.3804	BL-INLETOFFSET
589			1675144.8037	1646680.1466	INLET
590			1675182.7866	1646679.5086	BL-INLETOFFSET
591			1675221.3582	1646679.7764	INLET
592			1675182.8020	1646680.4240	BL-INLETOFFSET
593			1675220.9855	1646650.1846	INLET
594			1675182.2371	1646651.0249	BL-INLETOFFSET
595			1675167.1790	1646703.0048	INLET
596			1675183.1768	1646702.7361	BL-INLETOFFSET
597			1675149.8582	1647011.2460	INLET
598			1675188.3478	1647010.5995	BL-INLETOFFSET
599			1675227.2123	1647009.7017	INLET
600			1675188.3436	1647010.3546	BL-INLETOFFSET
601			1675150.1955	1647041.3611	INLET
602			1675188.9435	1647040.4669	BL-INLETOFFSET
603			1675227.5857	1647039.6374	INLET
604			1675188.9450	1647040.5292	BL-INLETOFFSET
605			1675215.5877	1647391.1701	MH
606			1675213.7634	1647422.9543	INLET
607			1675197.7676	1647423.3185	BL-INLETOFFSET
608			1675181.7542	1647422.9125	INLET
609			1675197.7500	1647422.5483	BL-INLETOFFSET

POINT NUMBER	STATION	OFFSET	NORTHING	EASTING	DESC
2000			1674561.8411	1649665.5065	SD
2001			1674611.9171	1649664.6144	SD
2002			1675221.6323	1649656.9505	SD
2004			1675918.7969	1649648.9996	SD
3004			1675295.7597	1650385.2486	SD
10001			1675239.4100	1649967.1500	SDMD
10002			1675272.6400	1649754.3800	SDMD
10003			1675226.9200	1649453.8000	SDMD
10004			1675243.8000	1649173.3300	+CUT
10005			1675246.7600	1648772.5600	SDMD
10006			1675243.6700	1648456.3500	SDMD
10007			1675213.8900	1648131.3300	SD 3/4"PIPE
10008			1675186.3200	1647811.7000	SDMD
10009			1675196.9000	1647385.2200	SD 1/2"BAR
10010			1675202.5100	1646756.8200	SDMD
10011			1675196.8600	1646364.7500	SDMD
10012			1675106.9500	1646084.1000	SDMD
10021			1675247.1090	1648772.6290	SDMD
11000			1675192.7800	1646425.8490	BM 2
13001			1675273.0940	1649770.0810	BM 11
13077			1675229.4540	1650004.6210	THIMBLE 3/4"PIPE
13505			1675278.9990	1649657.6180	SD 1"PIPE
13579			1675273.0830	1649770.1340	BM 11
13717			1675271.0640	1649590.1160	+CUT
13805			1675232.6910	1649587.2410	BM 10
14037			1675185.0100	1649271.8990	BM 9
14153			1675240.0920	1649255.8160	THIMBLE 1"PIPE
14515			1675231.2720	1648876.0180	THIMBLE 1"PIPE
14657			1675211.6230	1648693.3180	BM 8
14849			1675222.2990	1648496.3970	THIMBLE 1/2"PIPE
14850			1675132.7490	1648517.6190	BM 7
15279			1675197.8980	1648101.3140	BM 6
15331			1675244.4130	1648160.9040	+CUT
15658			1675353.4360	1647784.5960	BM 5
15805			1675185.6070	1647561.6010	BM 4
16206			1675171.9960	1647066.0120	BM 3
16358			1675188.5980	1647025.4880	SD 3/4"PIPE
16767			1675182.5530	1646665.5810	SPIKE
16921			1675193.0110	1646425.7320	BM 2
17229			1675320.5930	1646103.4710	BM 1

PLOTTED: Tuesday, May 27, 2008 @ 04:23PM

J:\CIVIL\05620\DWG\SWS\05620-BUBBLESW1.DWG

**PAVING
BUBBLE MAP**
SHEET TITLE 472-84289
448-90385
468-84514
PROJECT NUMBER

JRA
DESIGN BY
JSB
DRAWN BY
JRA
CHECKED BY

ISSUED
May 27, 2008
REVISED

SHEET NO.
41 of 120