


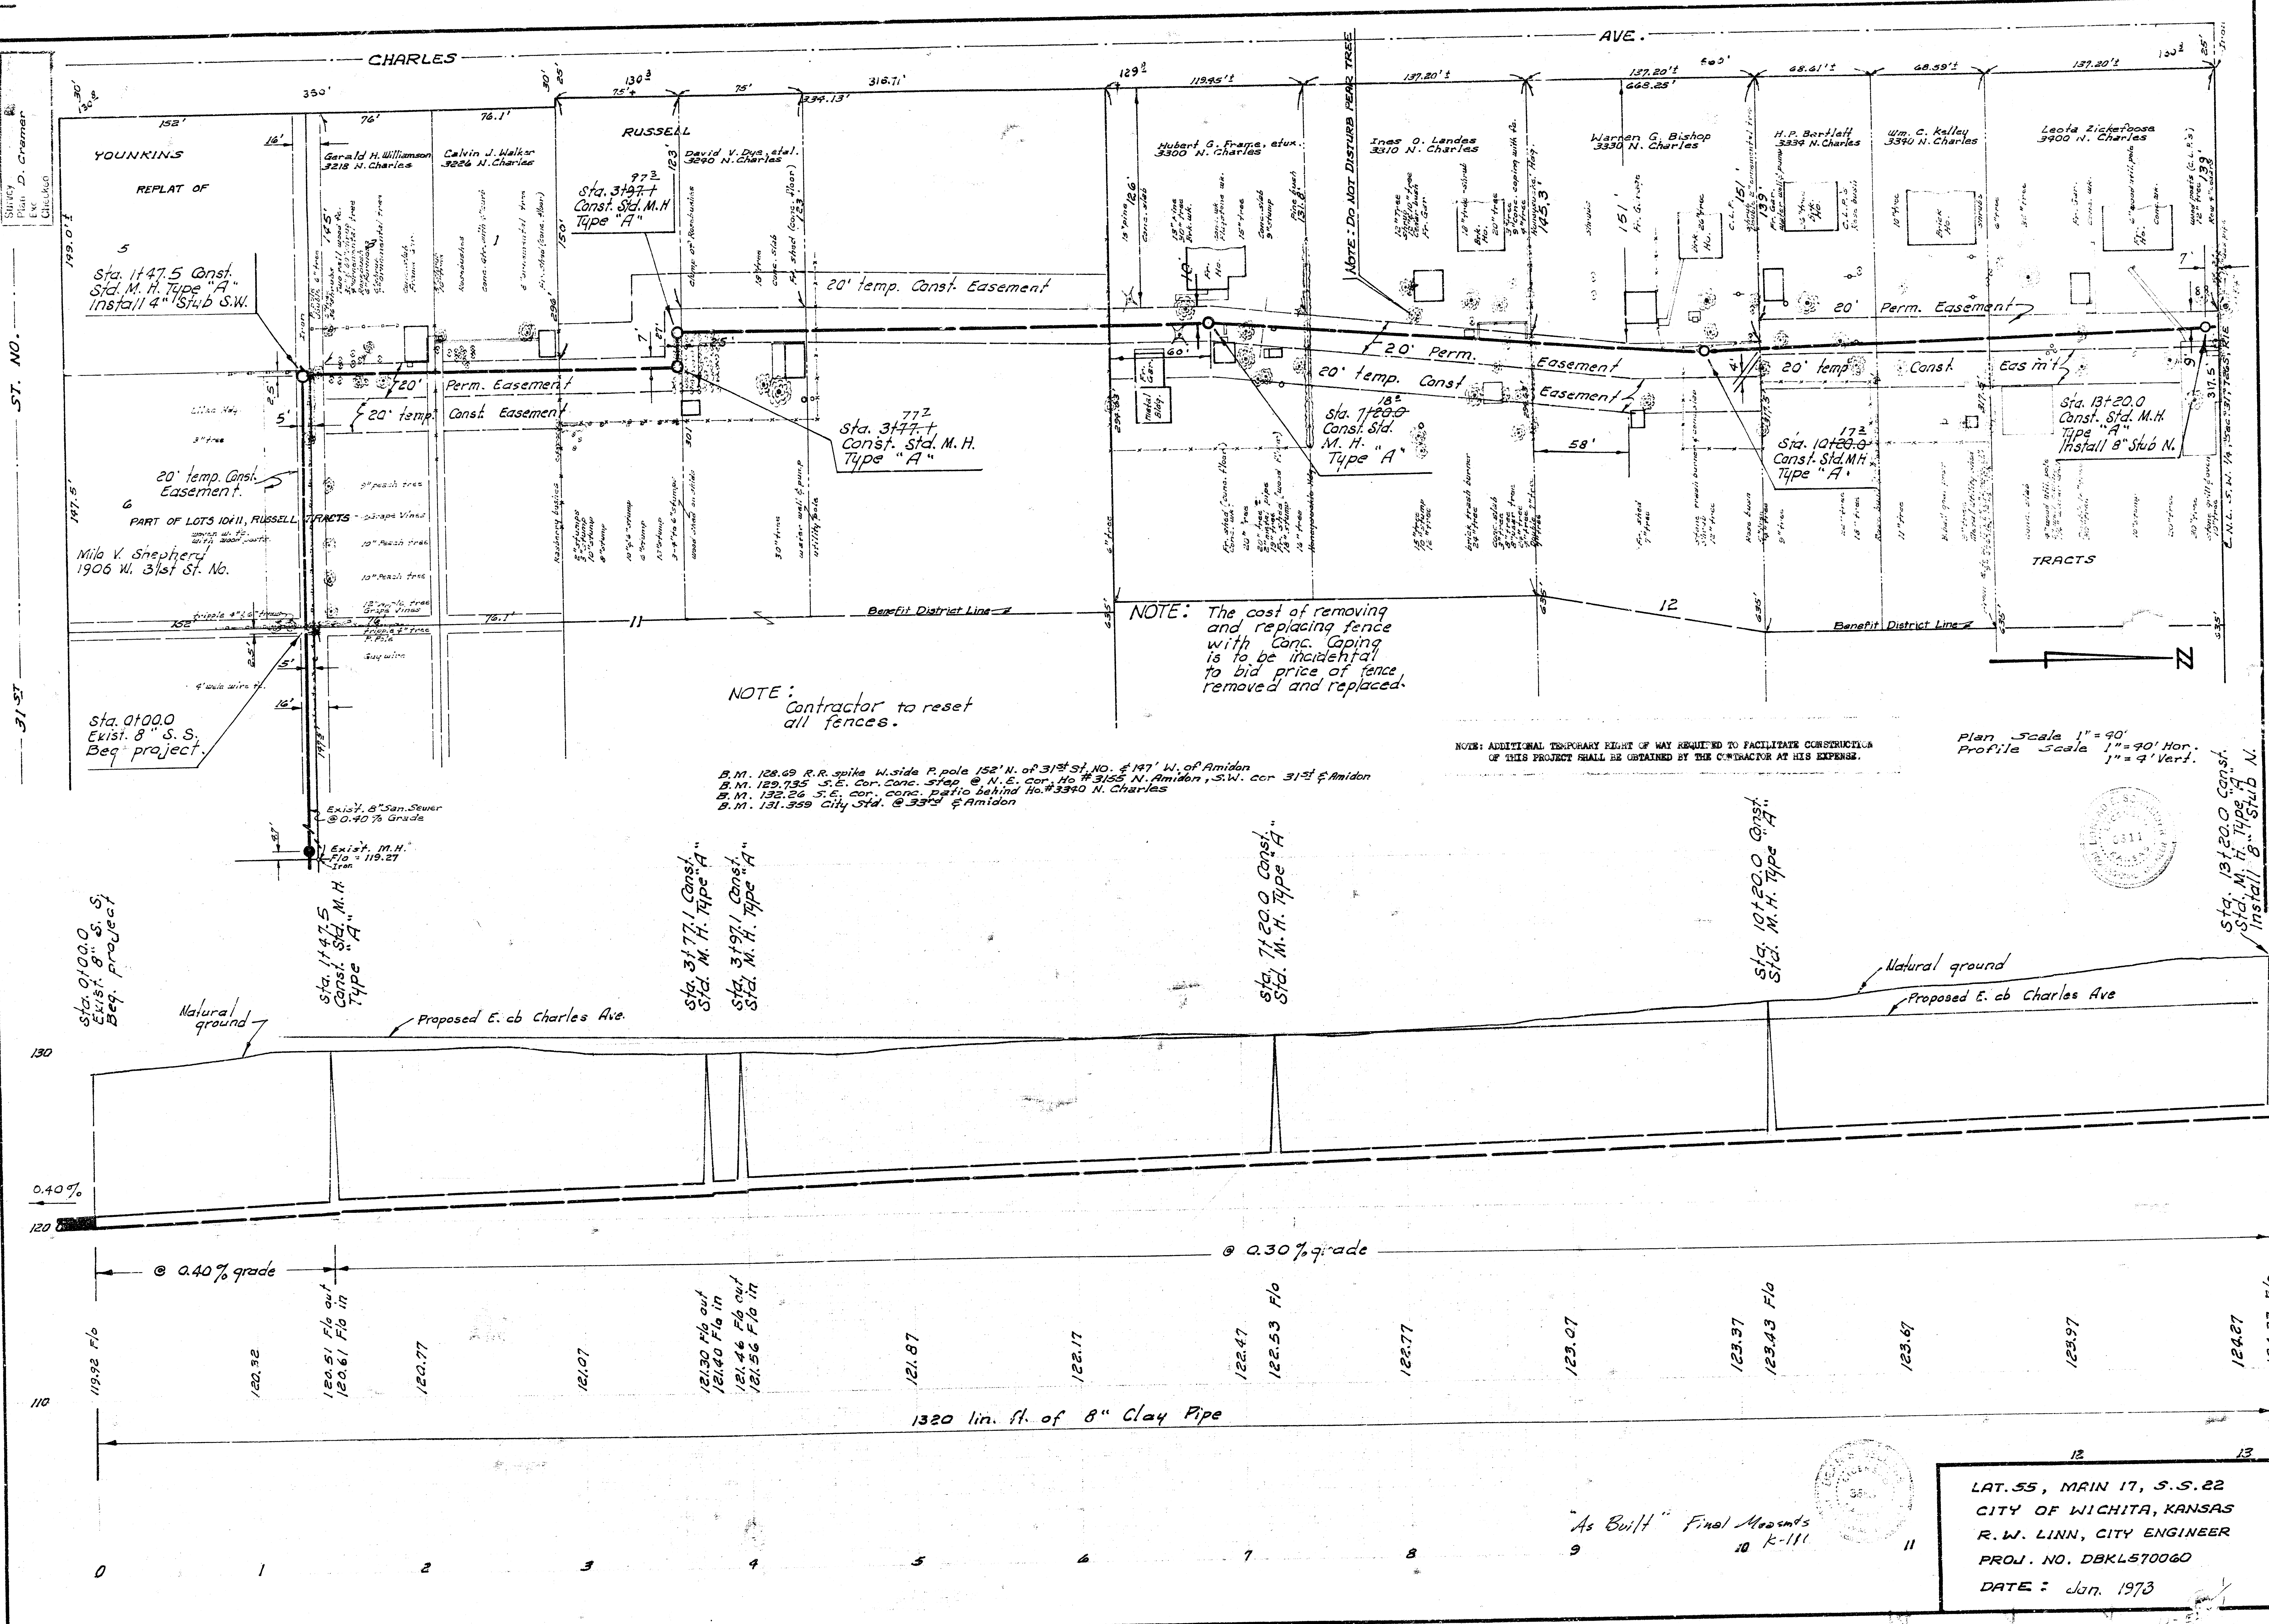

Survey
Plan
D. Cramer
Exc
Division

ST. NO.

31-57

Sta. 0+00.0
Exist. 8" S.S.
Baq. project

YOUNKINS
REPLAT OF
Sta. 1+47.5 Const.
Std. M.H. Type "A"
Install 4" Stub S.W.

Milo V. Shepherd
1906 W. 31st St. No.

Sta. 0+00.0
Exist. 8" S.S.
Baq. project

Sta. 1+47.5
Const. Std. M.H.
Type "A"

Proposed E. cb Charles Ave.

Sta. 3+77.1 Const.
Std. M.H. Type "A"

Sta. 3+97.1 Const.
Std. M.H. Type "A"

Sta. 7+77.1
Const. Std. M.H.
Type "A"

Sta. 7+20.0 Const.
Std. M.H. Type "A"

Sta. 10+20.0 Const.
Std. M.H. Type "A"

Sta. 13+20.0 Const.
Std. M.H. Type "A"
Install 8" Stub N.

NOTE:
Contractor to reset
all fences.


NOTE: The cost of removing
and replacing fence
with Conc. Capping
is to be incidental
to bid price of fence
removed and replaced.

NOTE: DO NOT DISTURB PEAR TREES

NOTE: ADDITIONAL TEMPORARY RIGHT OF WAY REQUIRED TO FACILITATE CONSTRUCTION
OF THIS PROJECT SHALL BE OBTAINED BY THE CONTRACTOR AT HIS EXPENSE.

Plan Scale 1" = 90'
Profile Scale 1" = 90' Hor.
1" = 4' Vert.

B.M. 128.69 R.R. spike W. side P. pole 152' N. of 31st St. No. 4 197' W. of Amidon
B.M. 129.735 S.E. cor. Conc. step @ N.E. cor. Ho # 3155 N. Amidon, S.W. cor 31st & Amidon
B.M. 132.26 S.E. cor. conc. patio behind Ho. # 3340 N. Charles
B.M. 131.559 City Sid. @ 33rd & Amidon

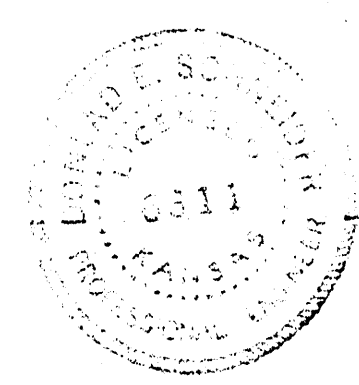

LAT. 55, MAIN 17, S.S. 22
CITY OF WICHITA, KANSAS
R.W. LINN, CITY ENGINEER
PROJ. NO. DBKL570060
DATE: Jun. 1973