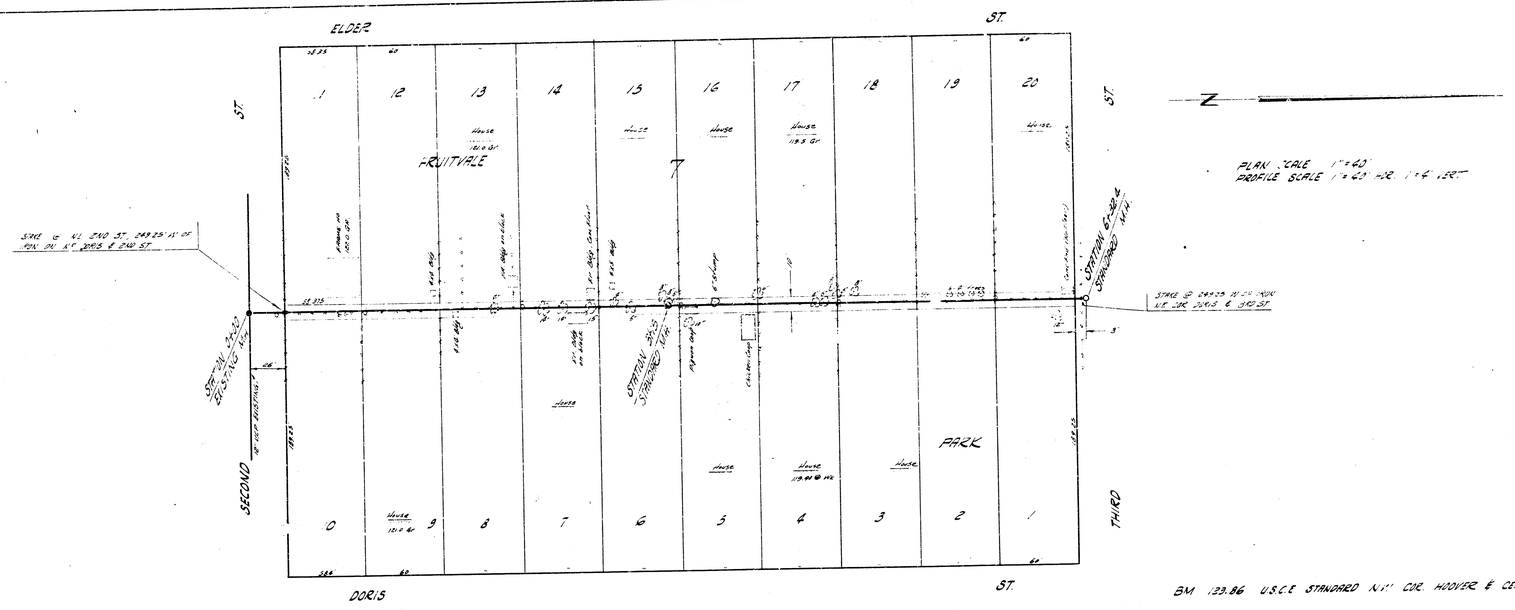
ELDER ST.
DORIS ST.
SECOND ST.
THIRD ST.
FRUITVALE
PARK
STATION 0+00 EXISTING M.H.
STATION 3+45 STANDARD M.H.
STATION 6+32.4 STANDARD M.H.
BM 123.86 U.S.C.E. STANDARD N.H. COR. HOOVER & CENTRAL
NATURAL GROUND
E.C.B. ELDER
6324 LIN. FT. 8" V.C.P. @ 0.2 % GRADE
112.05 F.L.O. IN
112.43 F.L.O.
119.31 F.L.O. OUT
8" STUB NORTH @ 119.31 F.L.O. IN
106.90 F.L.O. OUT
6324 LIN. FT. 8" V.C.P. @ 0.2% GRADE
LAT. 98 SUB. 5 S.S. 22
CITY OF WICHITA, KANSAS
B. E. SMITH, CITY ENGINEER
PROJ. NO. C 29-4 DATE MAR. 1957