B. M. 115.54 "M" in Mueller F. P.
S.E. West & McCormick

B. M. 113.25 S.W. cor. wlk S.E.
Kessler & McCormick.

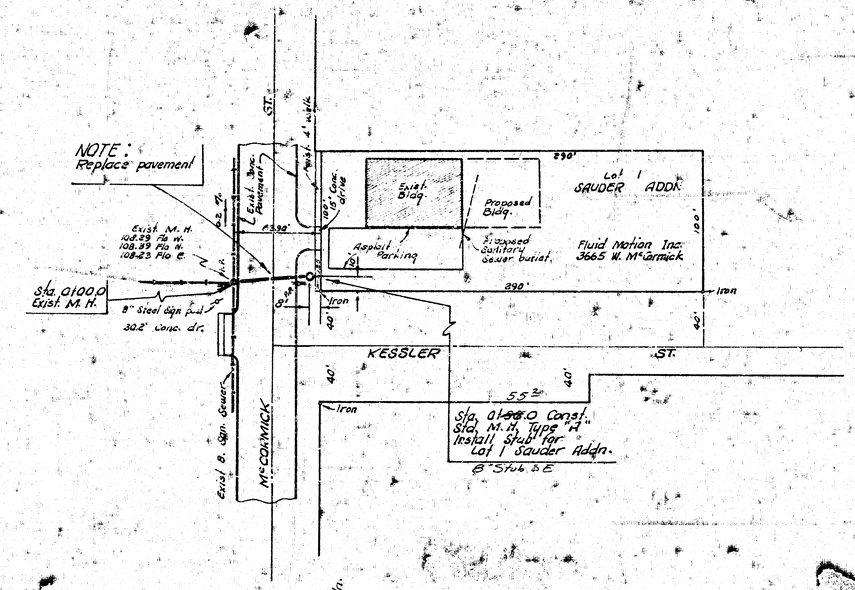

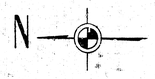

Plan Scale 1" = 40'
Profile Scale 1" = 40' Horz.
1" = 5' Vert.

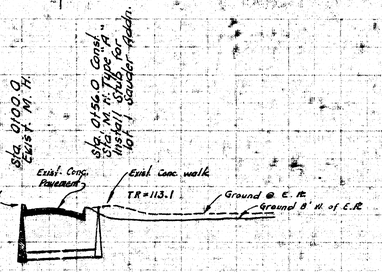

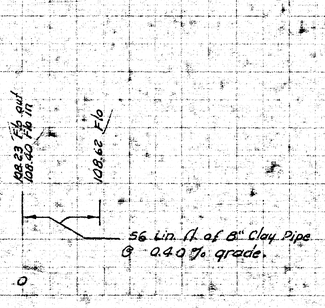

As Built Final Mrs. SS Jt. #6

LAT. 125, S. S. NO. 22
CITY OF WICHITA, KANSAS
R. W. LINN — CITY ENGINEER
MAR. 1974 PROJECT NO. DBKL574004