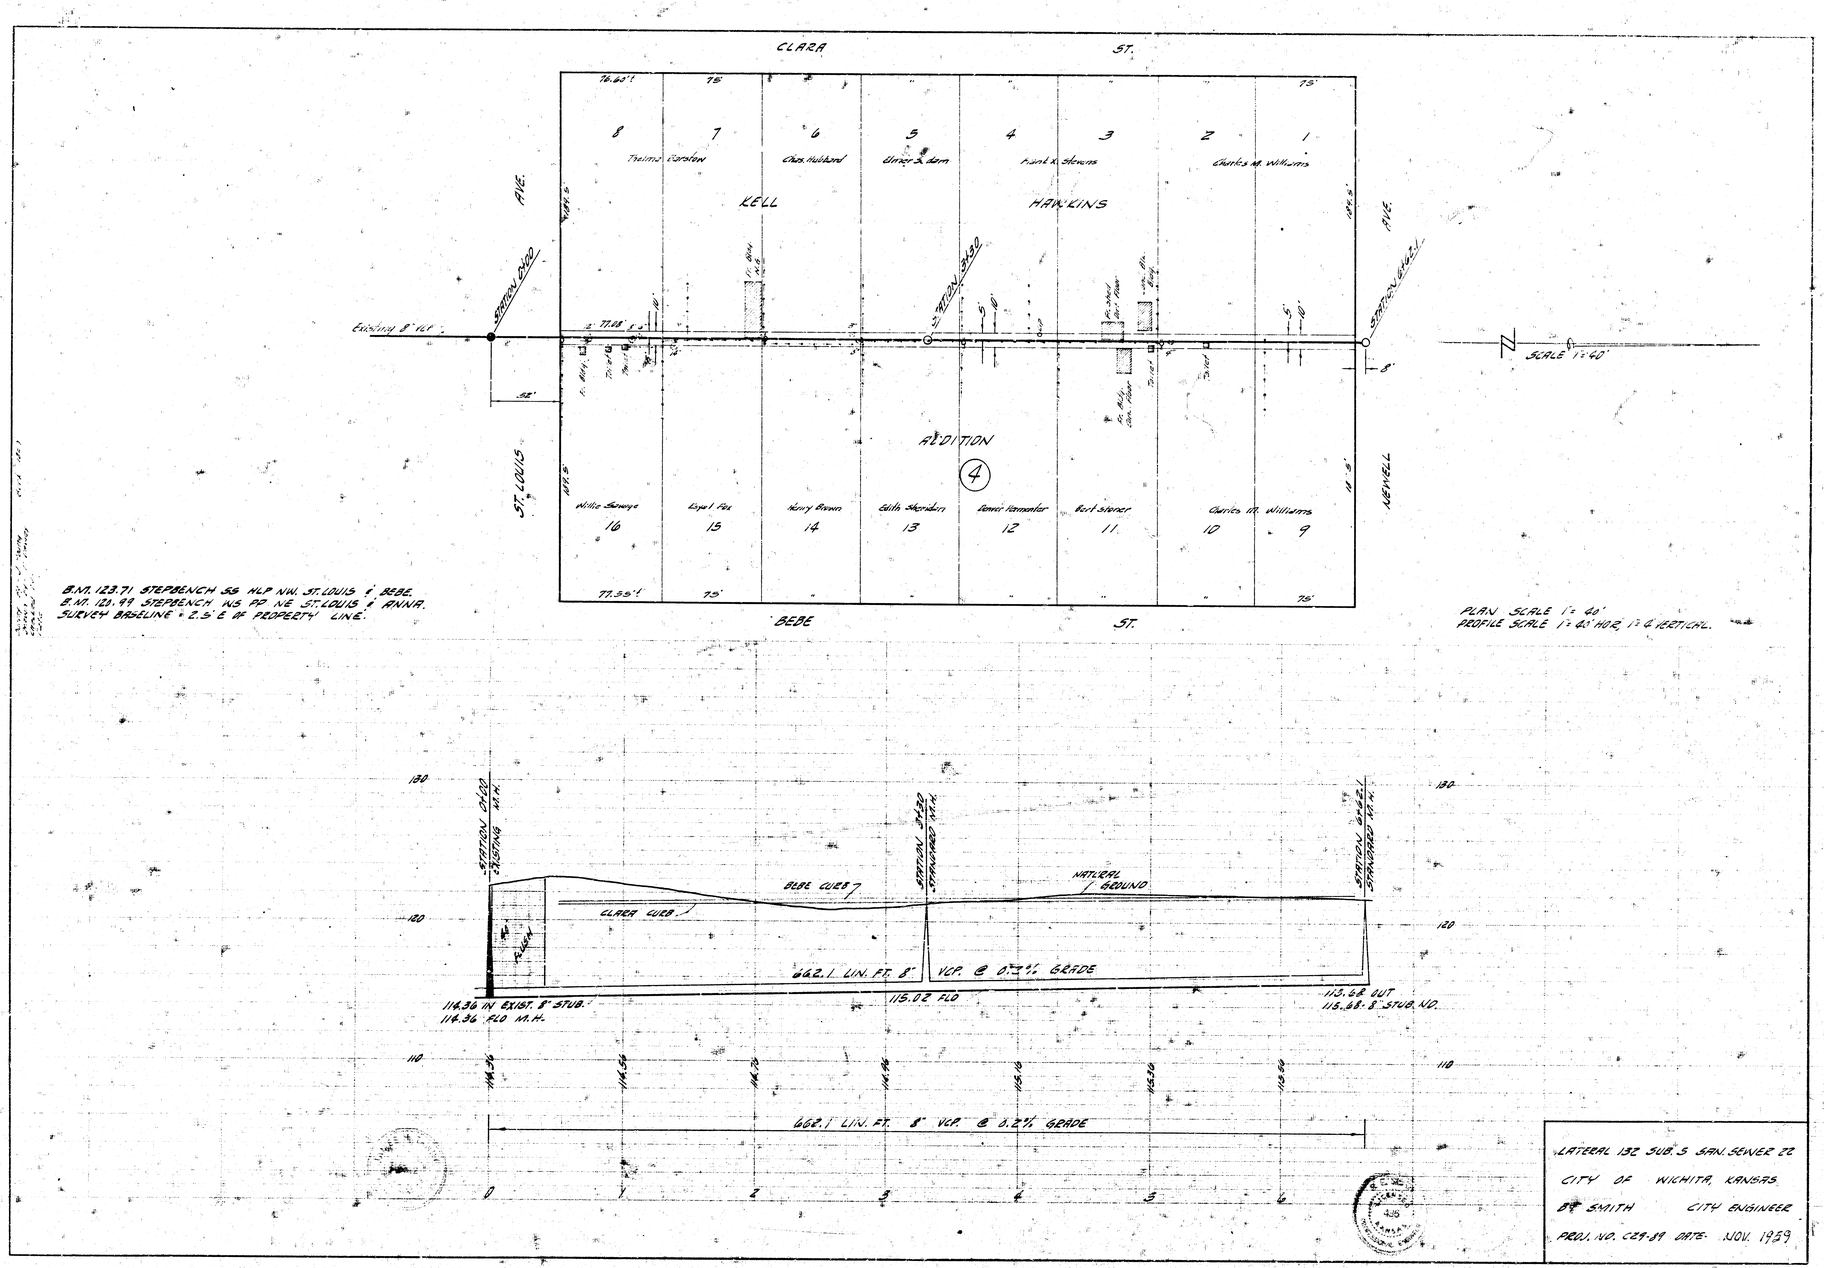
CLARA ST.
KELL
HAWKINS
ADDITION
4
AVE.
ST. LOUIS
NEWELL
BEBE ST.
Existing 8" vcp
STATION 0+00
STATION 5+32
STATION 6+62.1
SCALE 1"=60'
B.M. 123.71 STEPBENCH SS NLP NW. ST. LOUIS & BEBE
B.M. 128.99 STEPBENCH NS PP NE ST. LOUIS & ANNA.
SURVEY BASELINE = 2.5' E OF PROPERTY LINE.
PLAN SCALE 1"=40'
PROFILE SCALE 1"=40' HOR. 1"=6' VERTICAL.
STATION 0+00 EXISTING M.H.
STATION 5+32 STANDARD M.H.
STATION 6+62.1 STANDARD M.H.
BEBE CURB
CLARA CURB
NATURAL GROUND
PLAN
662.1 LIN. FT. 8" VCP @ 0.2% GRADE
114.36 IN EXIST. 8" STUB.
114.36 FLO M.H.
115.02 FLO
113.68 OUT
113.68 8" STUB. NO.
662.1 LIN. FT. 8" VCP @ 0.2% GRADE
LATERAL 132 SUB. 5 SAN. SEWER 22
CITY OF WICHITA, KANSAS
BY SMITH CITY ENGINEER
PROJ. NO. C29-89 DATE NOV. 1959

9 2 1 (12)