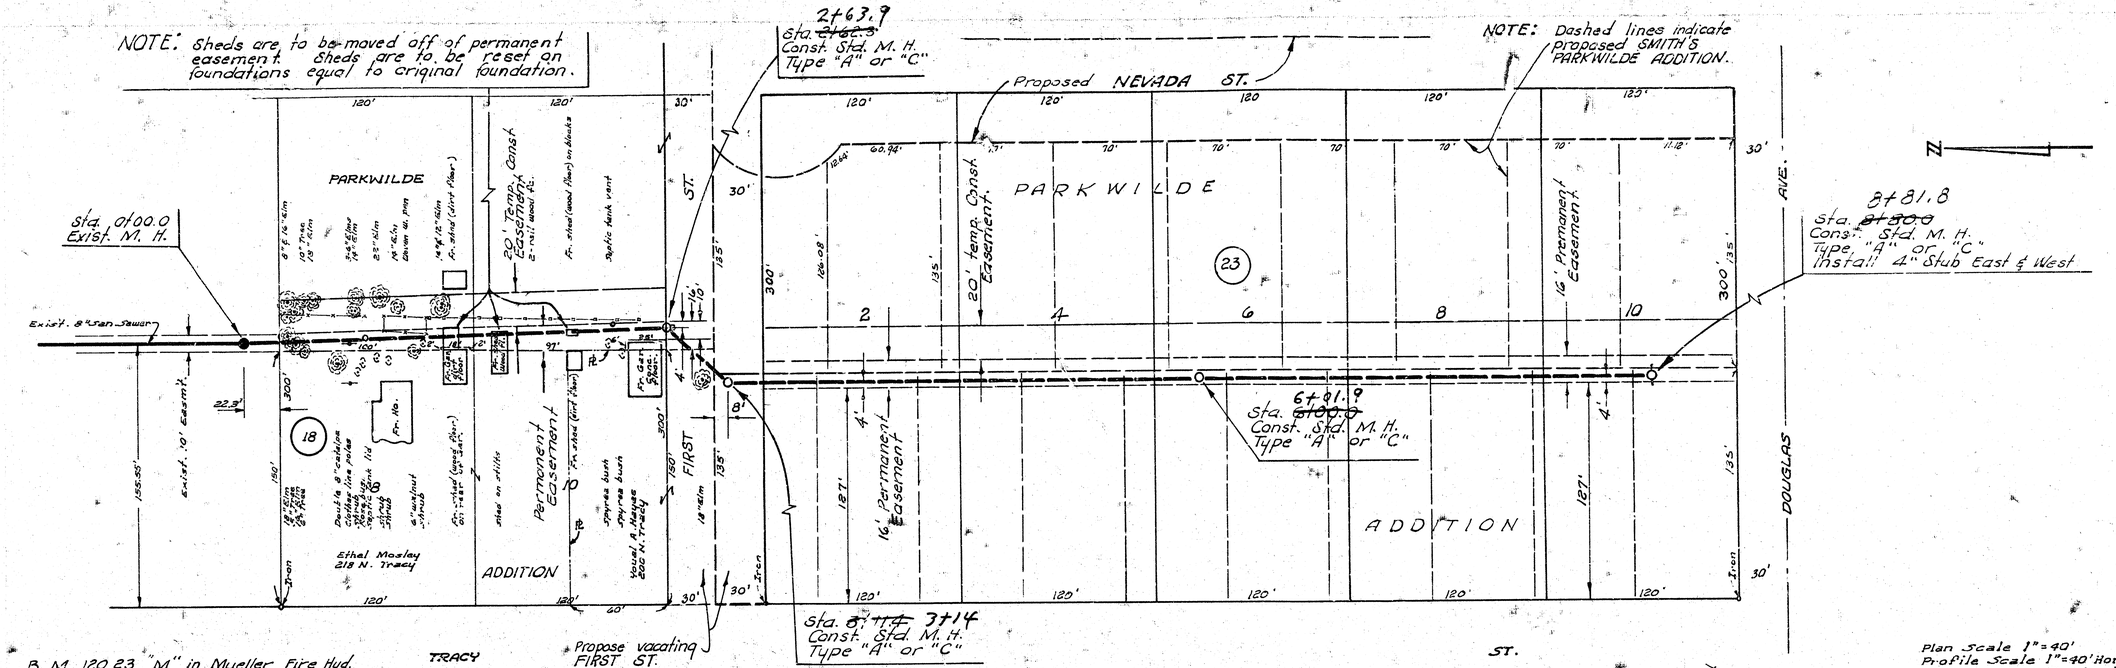

As Built 9-4-75

LAT. 208, MAIN 5, S.S. #22
CITY OF WICHITA, KANSAS
R. W. LINN, CITY ENGINEER
PROJ. NO. DBKL570062
DATE: