B.M. 1259.8 R.R. Spike on West side p. pole on ℄ DOUGHERTY & ℄ WHITEHALL Ln.
B.M. 1297 R.R. Spike on North - - - South side 13TH 615' West ℄ 13TH & BICKEL

N

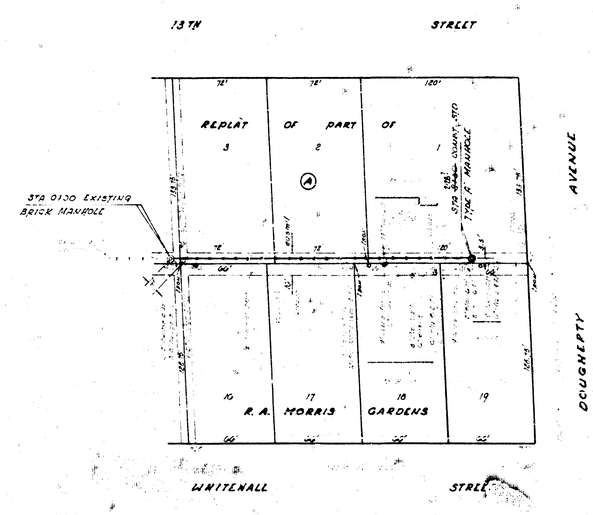

PLAN SCALE 1" = 40'
PROFILE 1" = 40' HORZ.
1" = 5' VERT

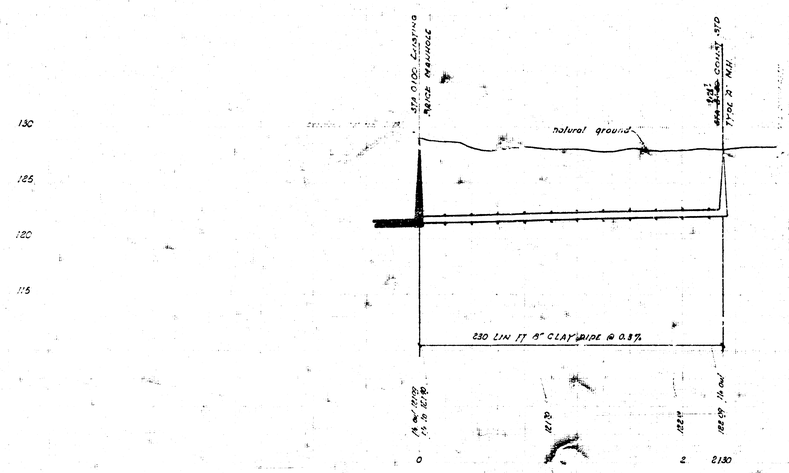

As Built 15 Sept 72 Final Measurement in S.S. Bk #5

LATERAL 213, MAIN 5, S.S. 22

CITY OF WICHITA, KANSAS

R.W. LINN CITY ENGINEER

DATE SEPT. 1972 PROJ No. DBKL 572G38