# LATERAL 235, MAIN 5

# SANITARY SEWER NO. 22

Project no. 468-76-245-81210-000-000-001

CITY OF WICHITA, KANSAS

MIKE LINDEBAK CITY ENGINEER




LOCATION MAP

As Built
J.L.L
8-84

JUNE 1984

BAUGHMAN COMPANY, P.A.
SURVEYING & ENGINEERING
316/262-7271 • 332 LAURA • WICHITA, KANSAS 67211

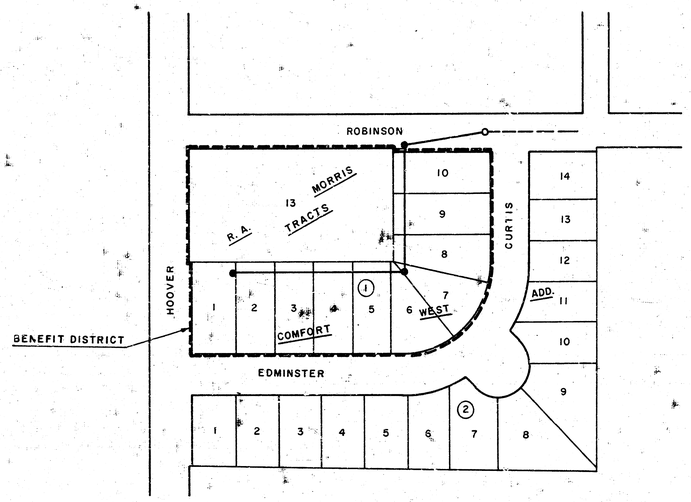


NOTE: TREE REMOVAL SHALL BE INCIDENTAL TO L.F. PIPE.

B.M. City disc 34'E. & 42'S. & Hoover & 9th Elev. 126.89




SPECIAL - MANHOLE "TYPE A"

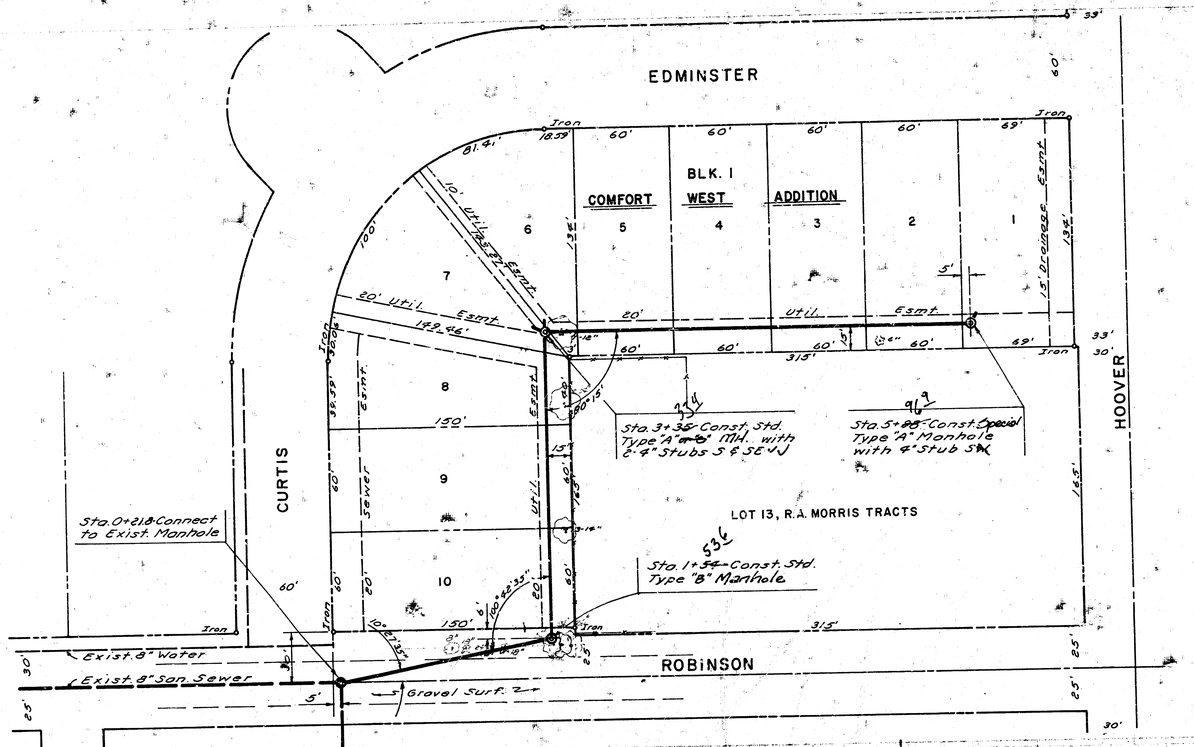


As Built
J.LL
8-84

| |
|---|
| LATERAL 235, MAIN 5<br>SANITARY SEWER NO. 22 |
| CITY OF WICHITA, KS. |
| PROJ. NO. 468-76-245-81210-000-000-001 |
| BAUGHMAN COMPANY, P.A.<br>SURVEYING & ENGINEERING<br>316/262-7271 • 330 LAURA • WICHITA, KANSAS 67211 |

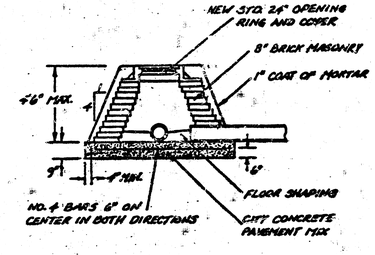W. BRENT WOOTEN LICENSED 8470 KANSAS PROFESSIONAL ENGINEER

(100)

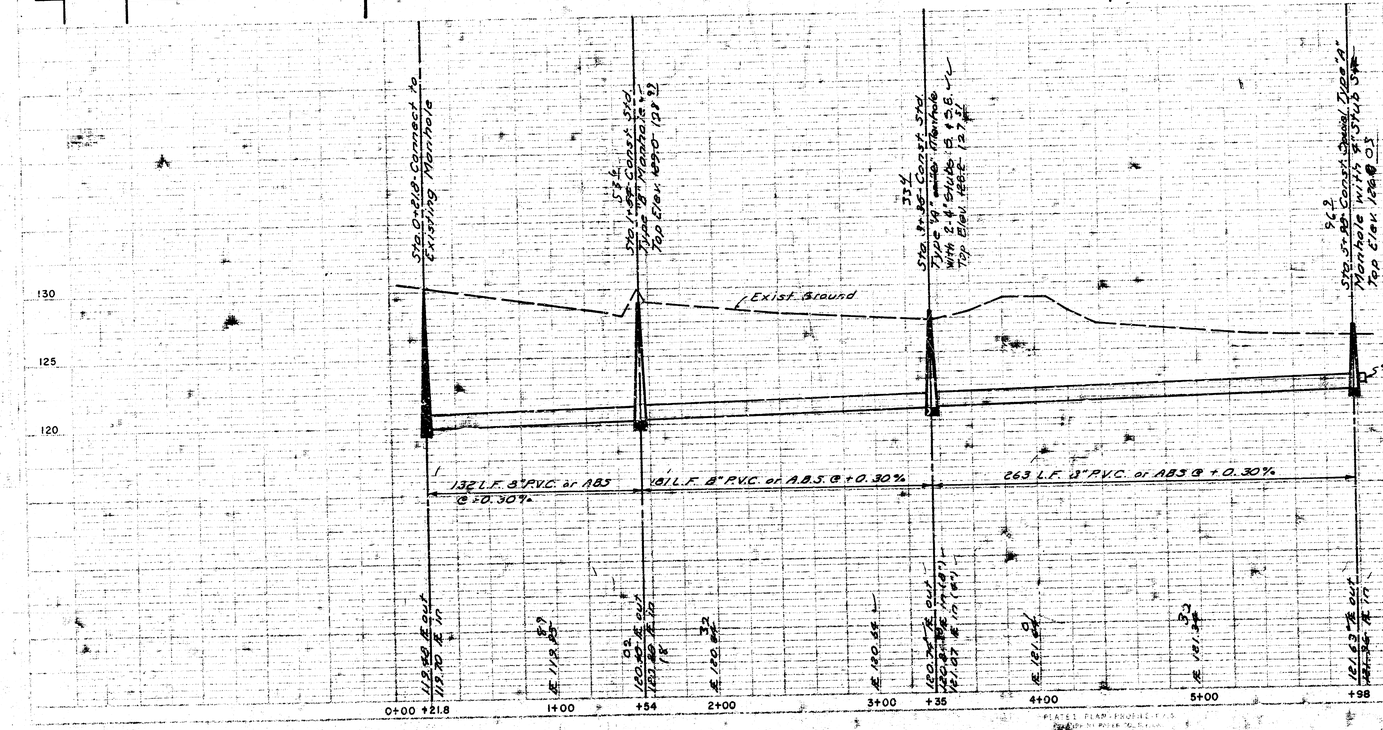J4 8 4 2

2/2