
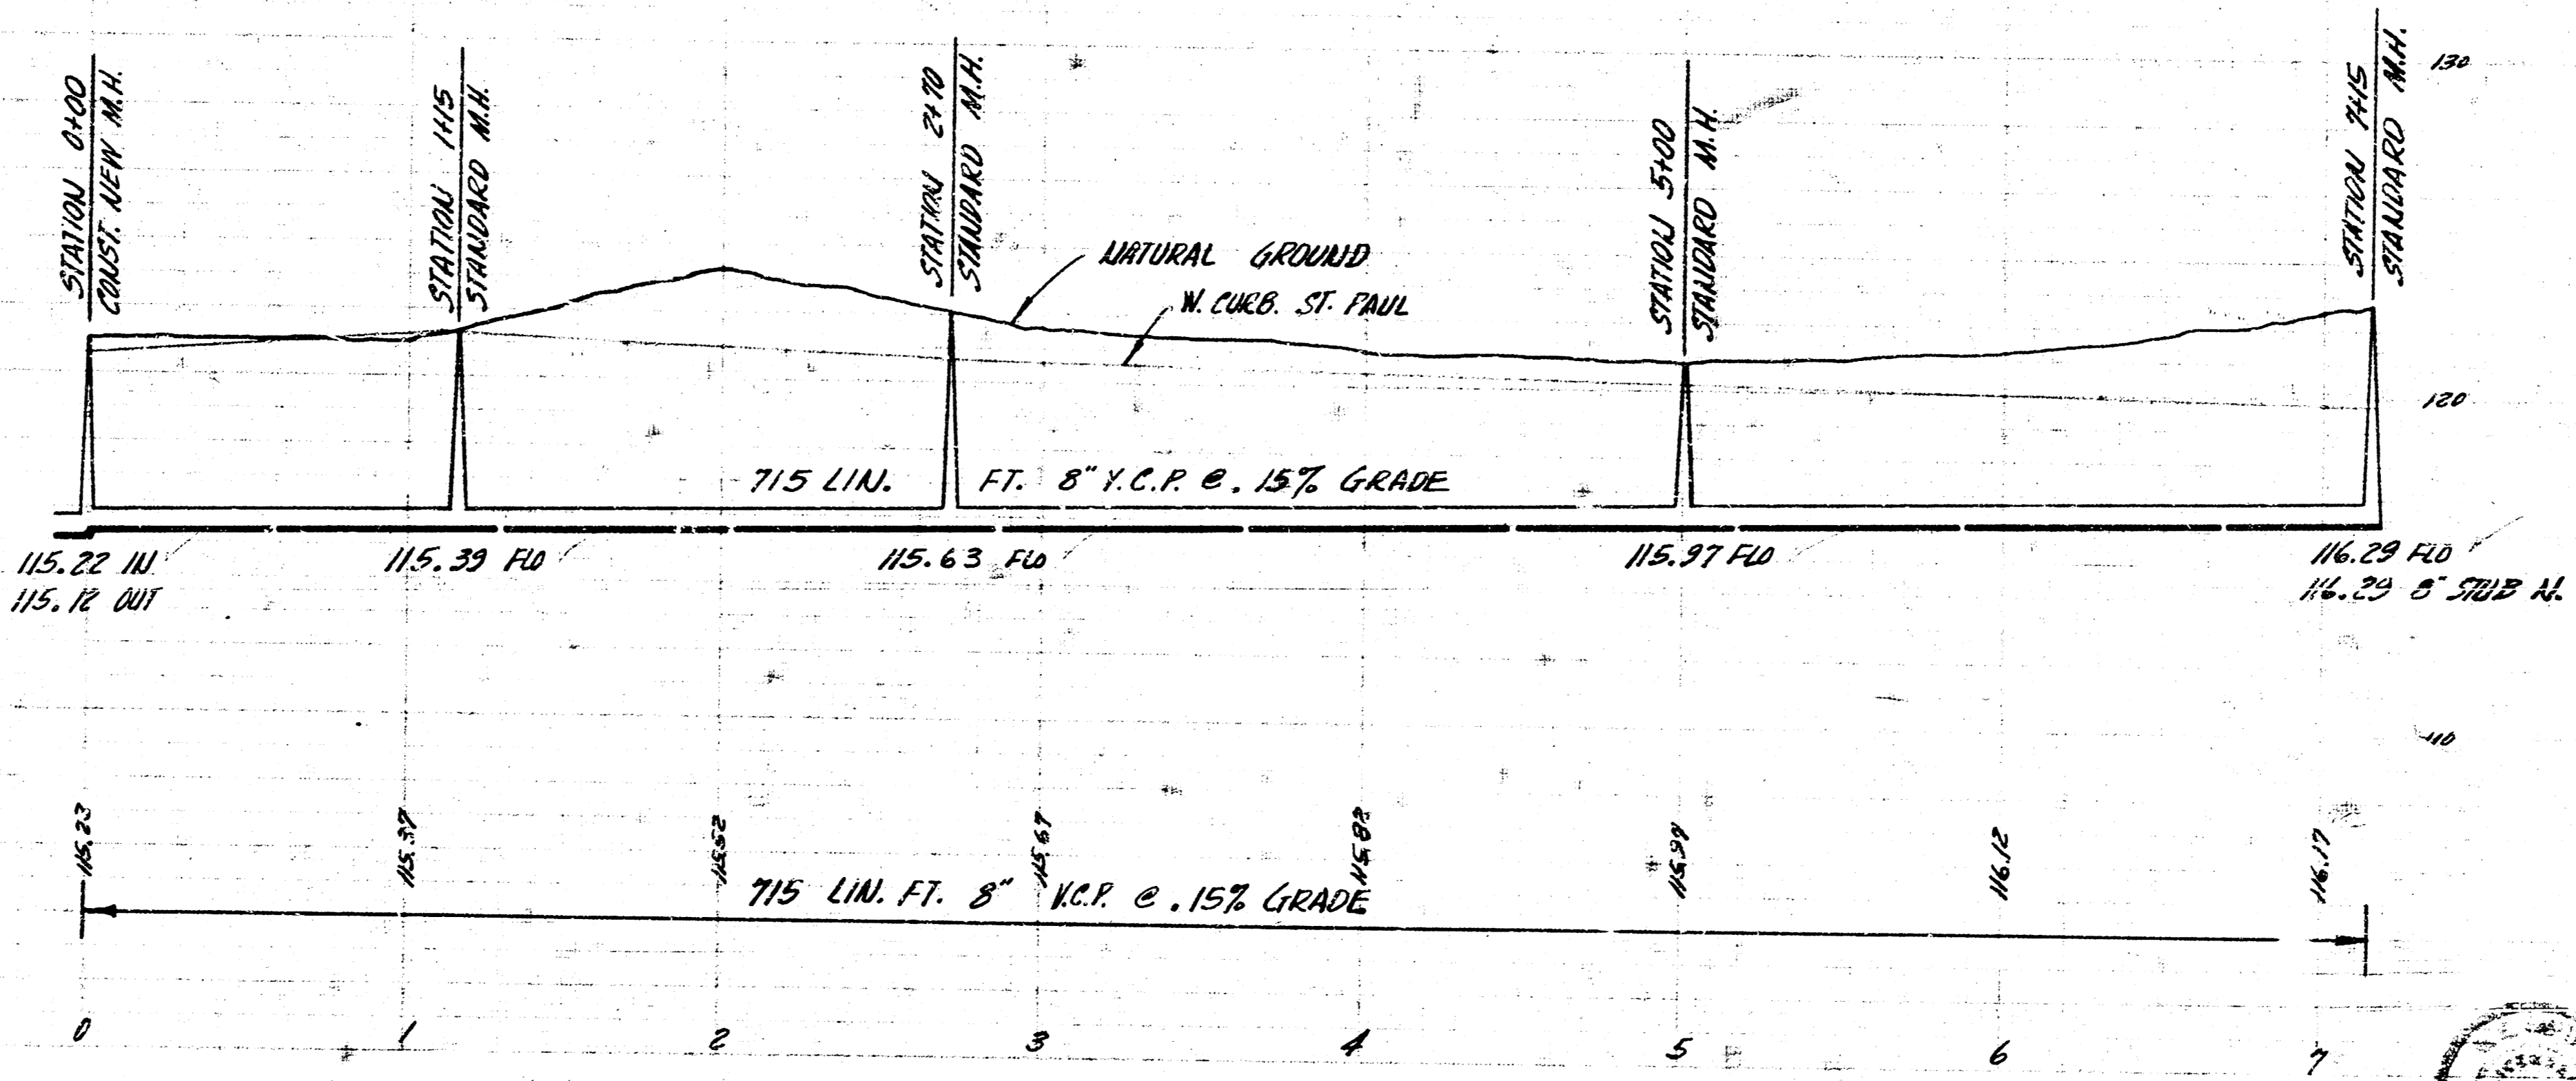


SURVEY BY - G.H. MILLS  
 DRAWN BY - WENEY  
 CHECKED BY -  
 DATE

B.M. 12081 N. 1/4 Sec. 14, T. 33 S., R. 10 W., 15th N. of 11th St. Paul  
 B.M. 12078 Public Spike S.S. 11 16 1/2, N.S. 11th 150' E of Line #1

Plan Scale 1" = 40'  
 Profile Scale 1" = 40' Vert. 1/2" = 1' Vertical

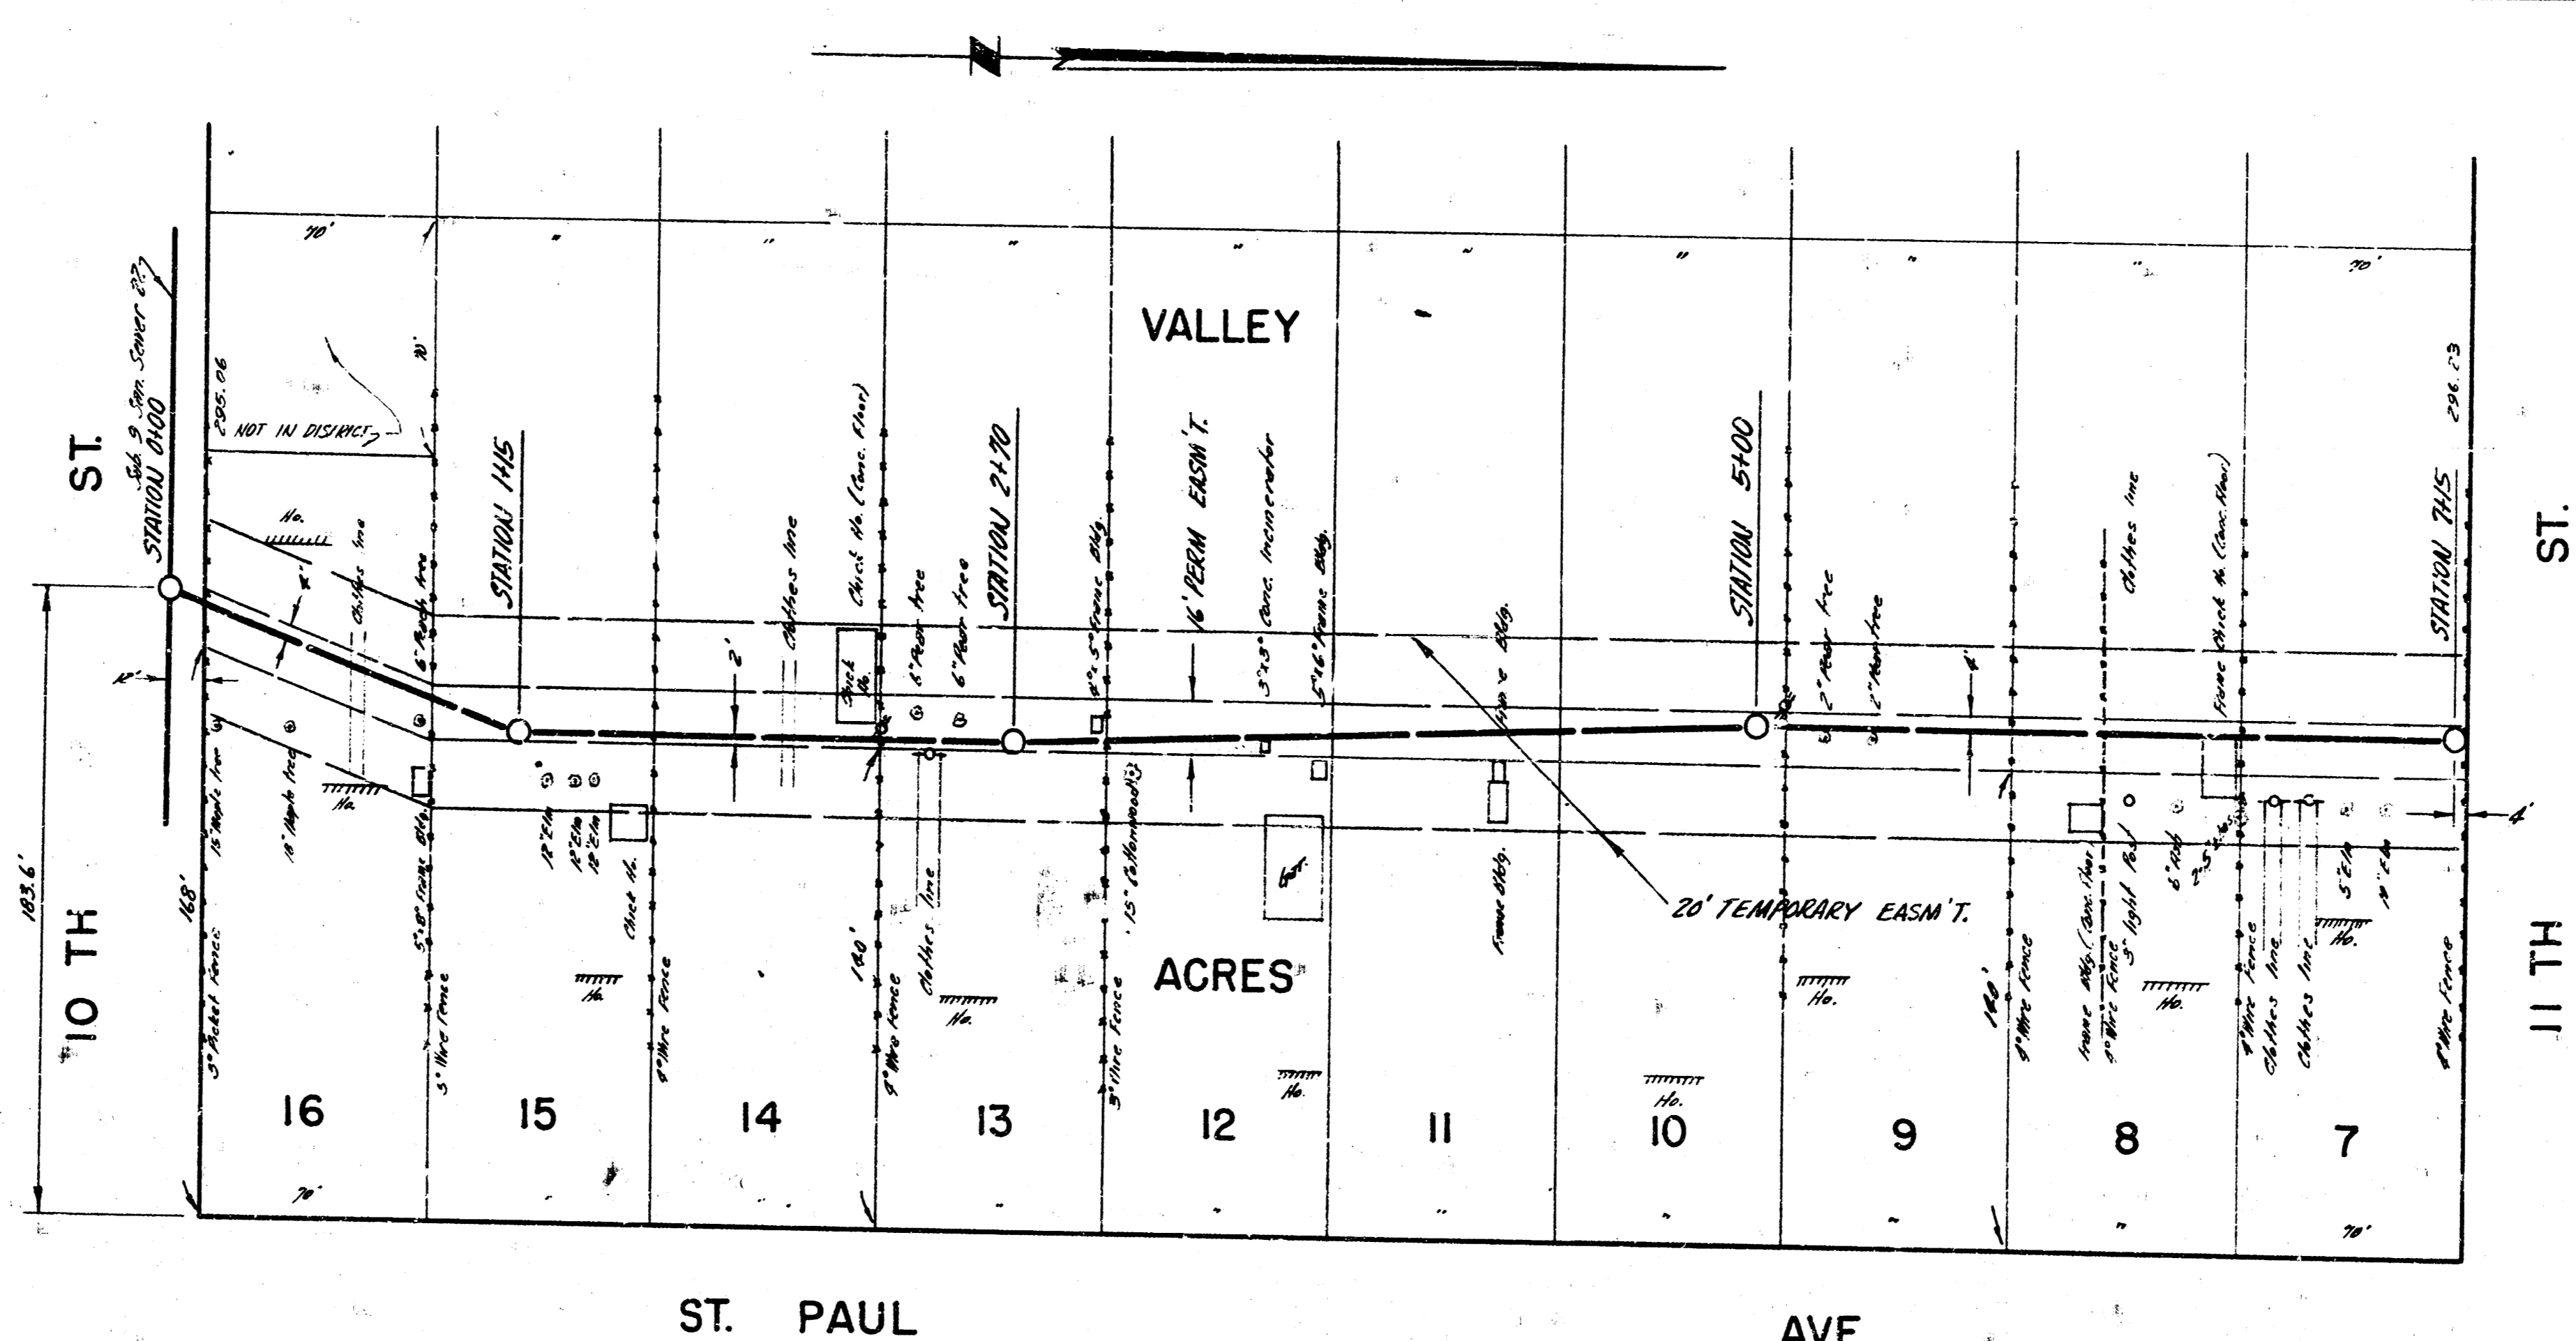

LAT. 3 SUB. 9 SAN. SEWER 22  
 CITY OF WICHITA, KANSAS  
 B.E. SMITH CITY ENGINEER  
 PROJECT NO. C26-31 DATE - FEB. 1957