
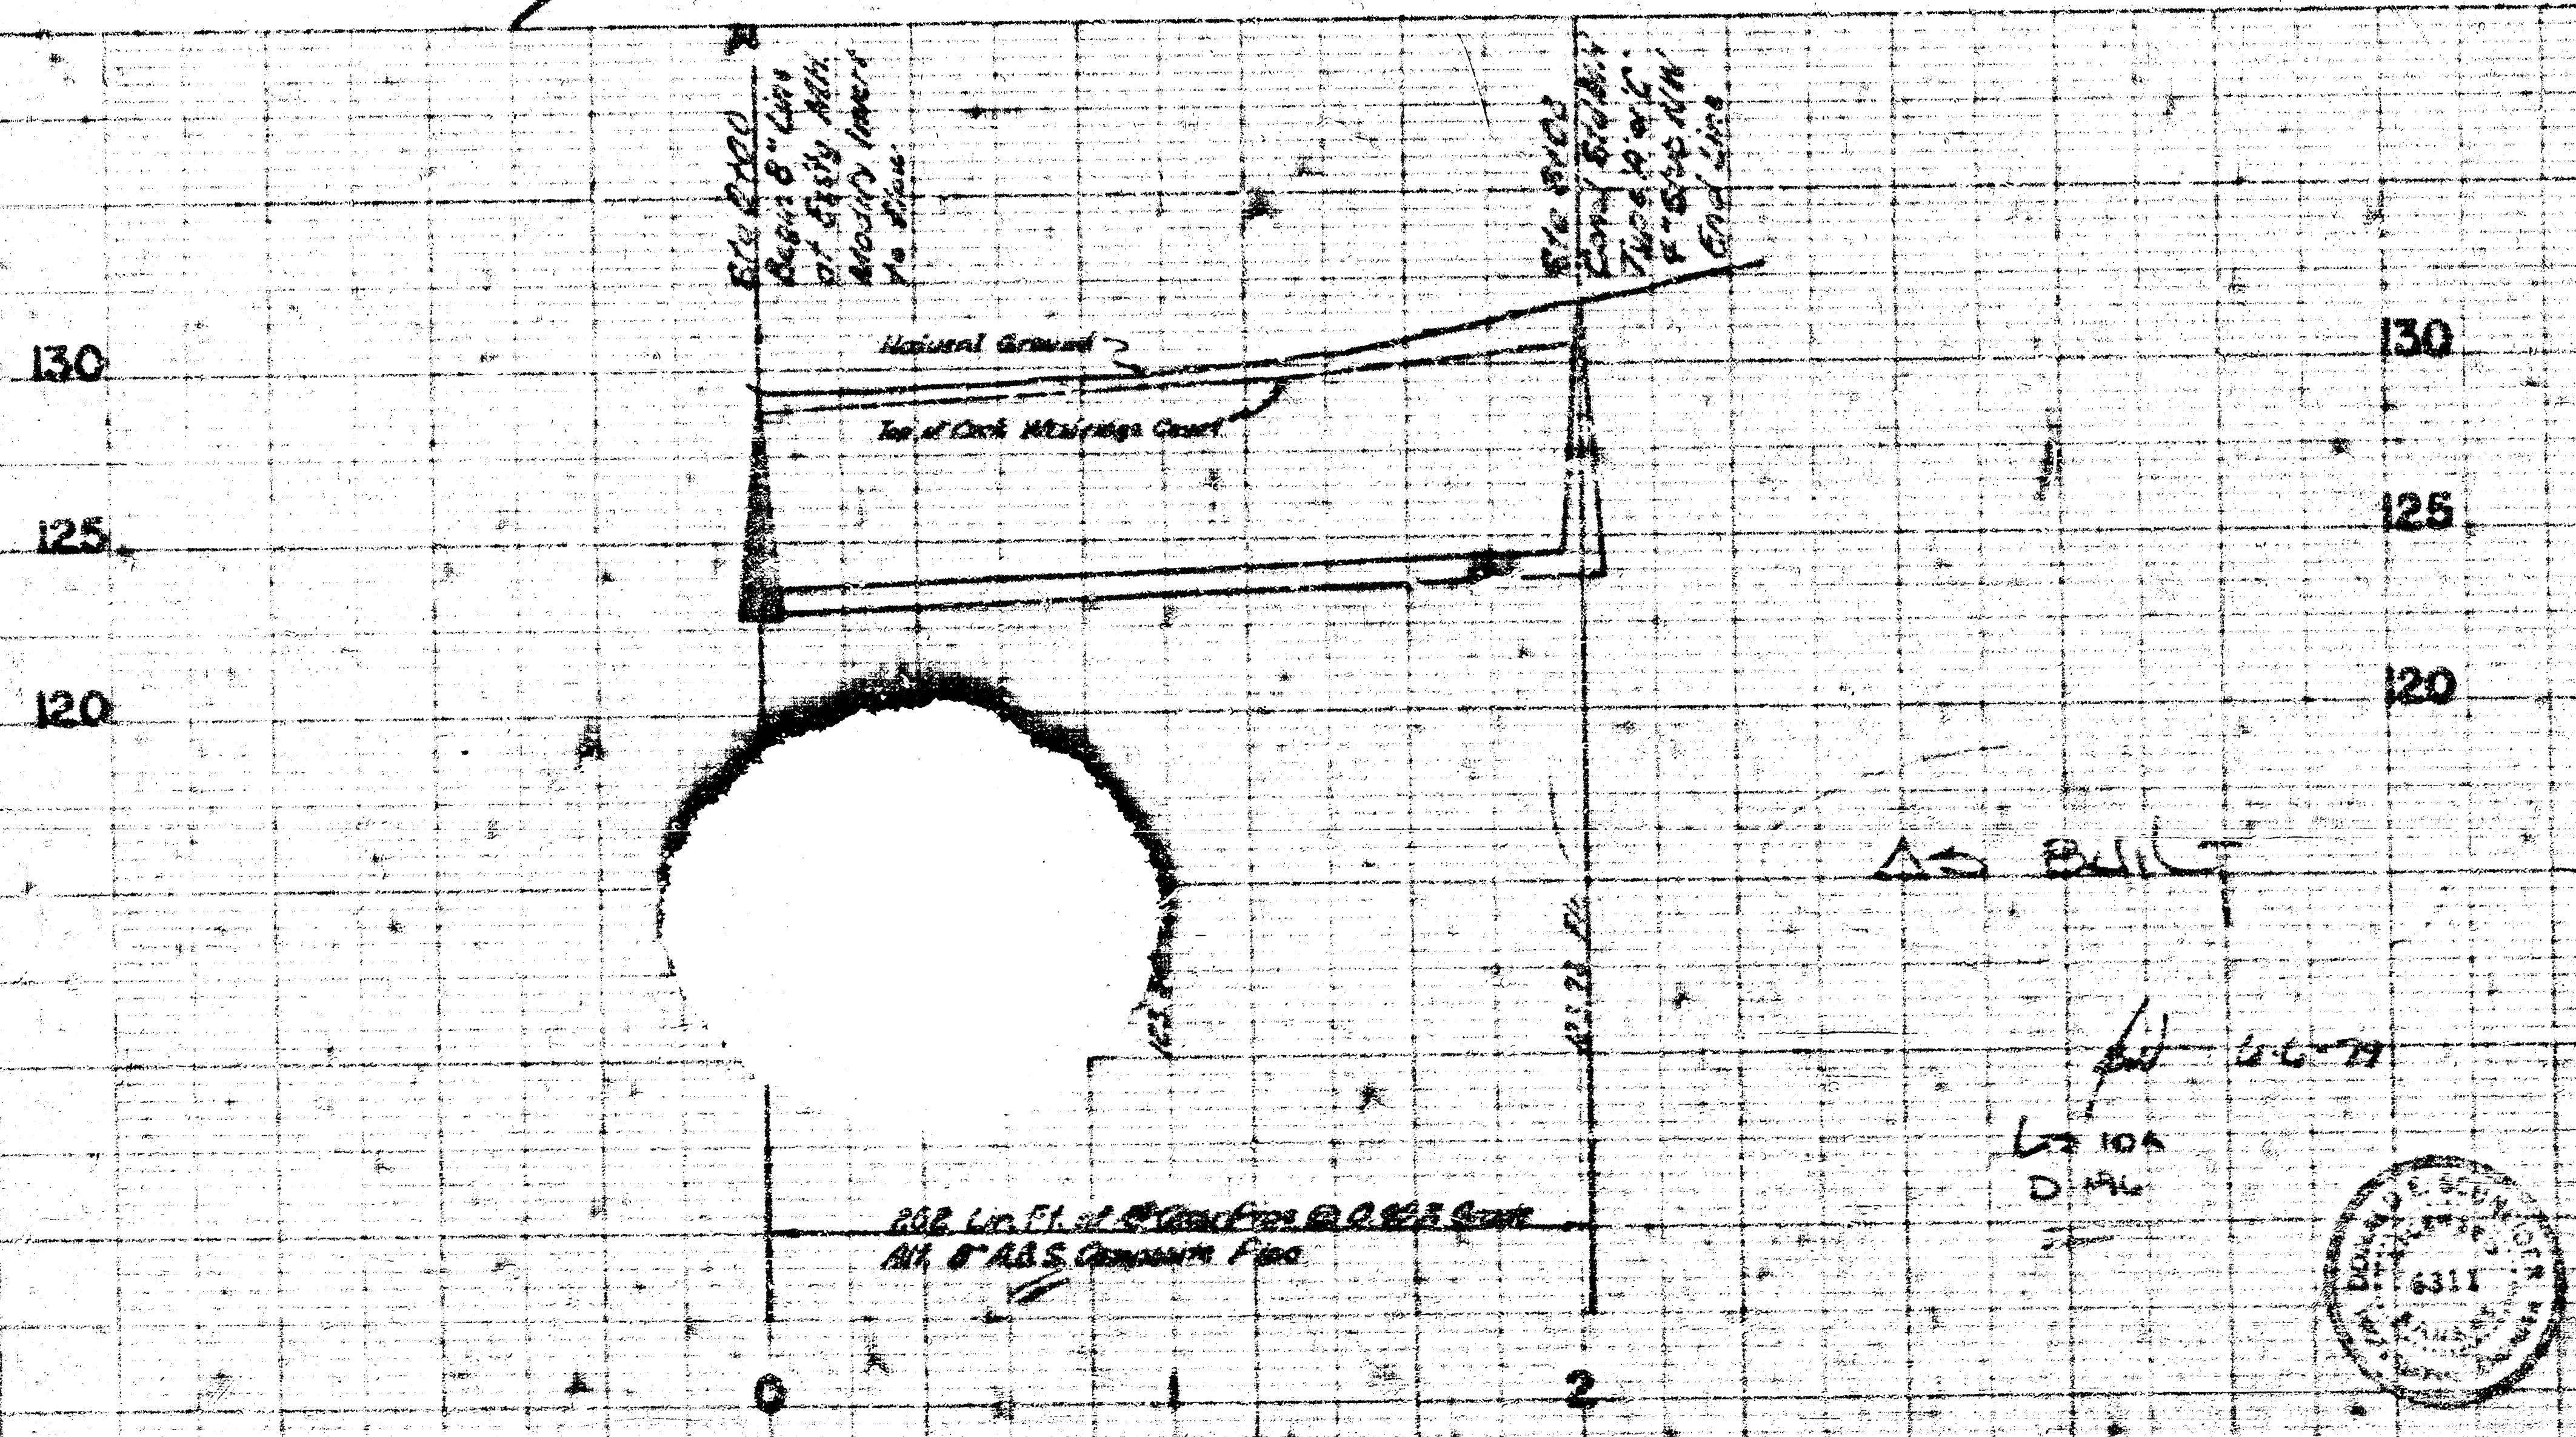


B.M. 130.45 ☐ cut in top of West curb at South Line of 19th Street North.

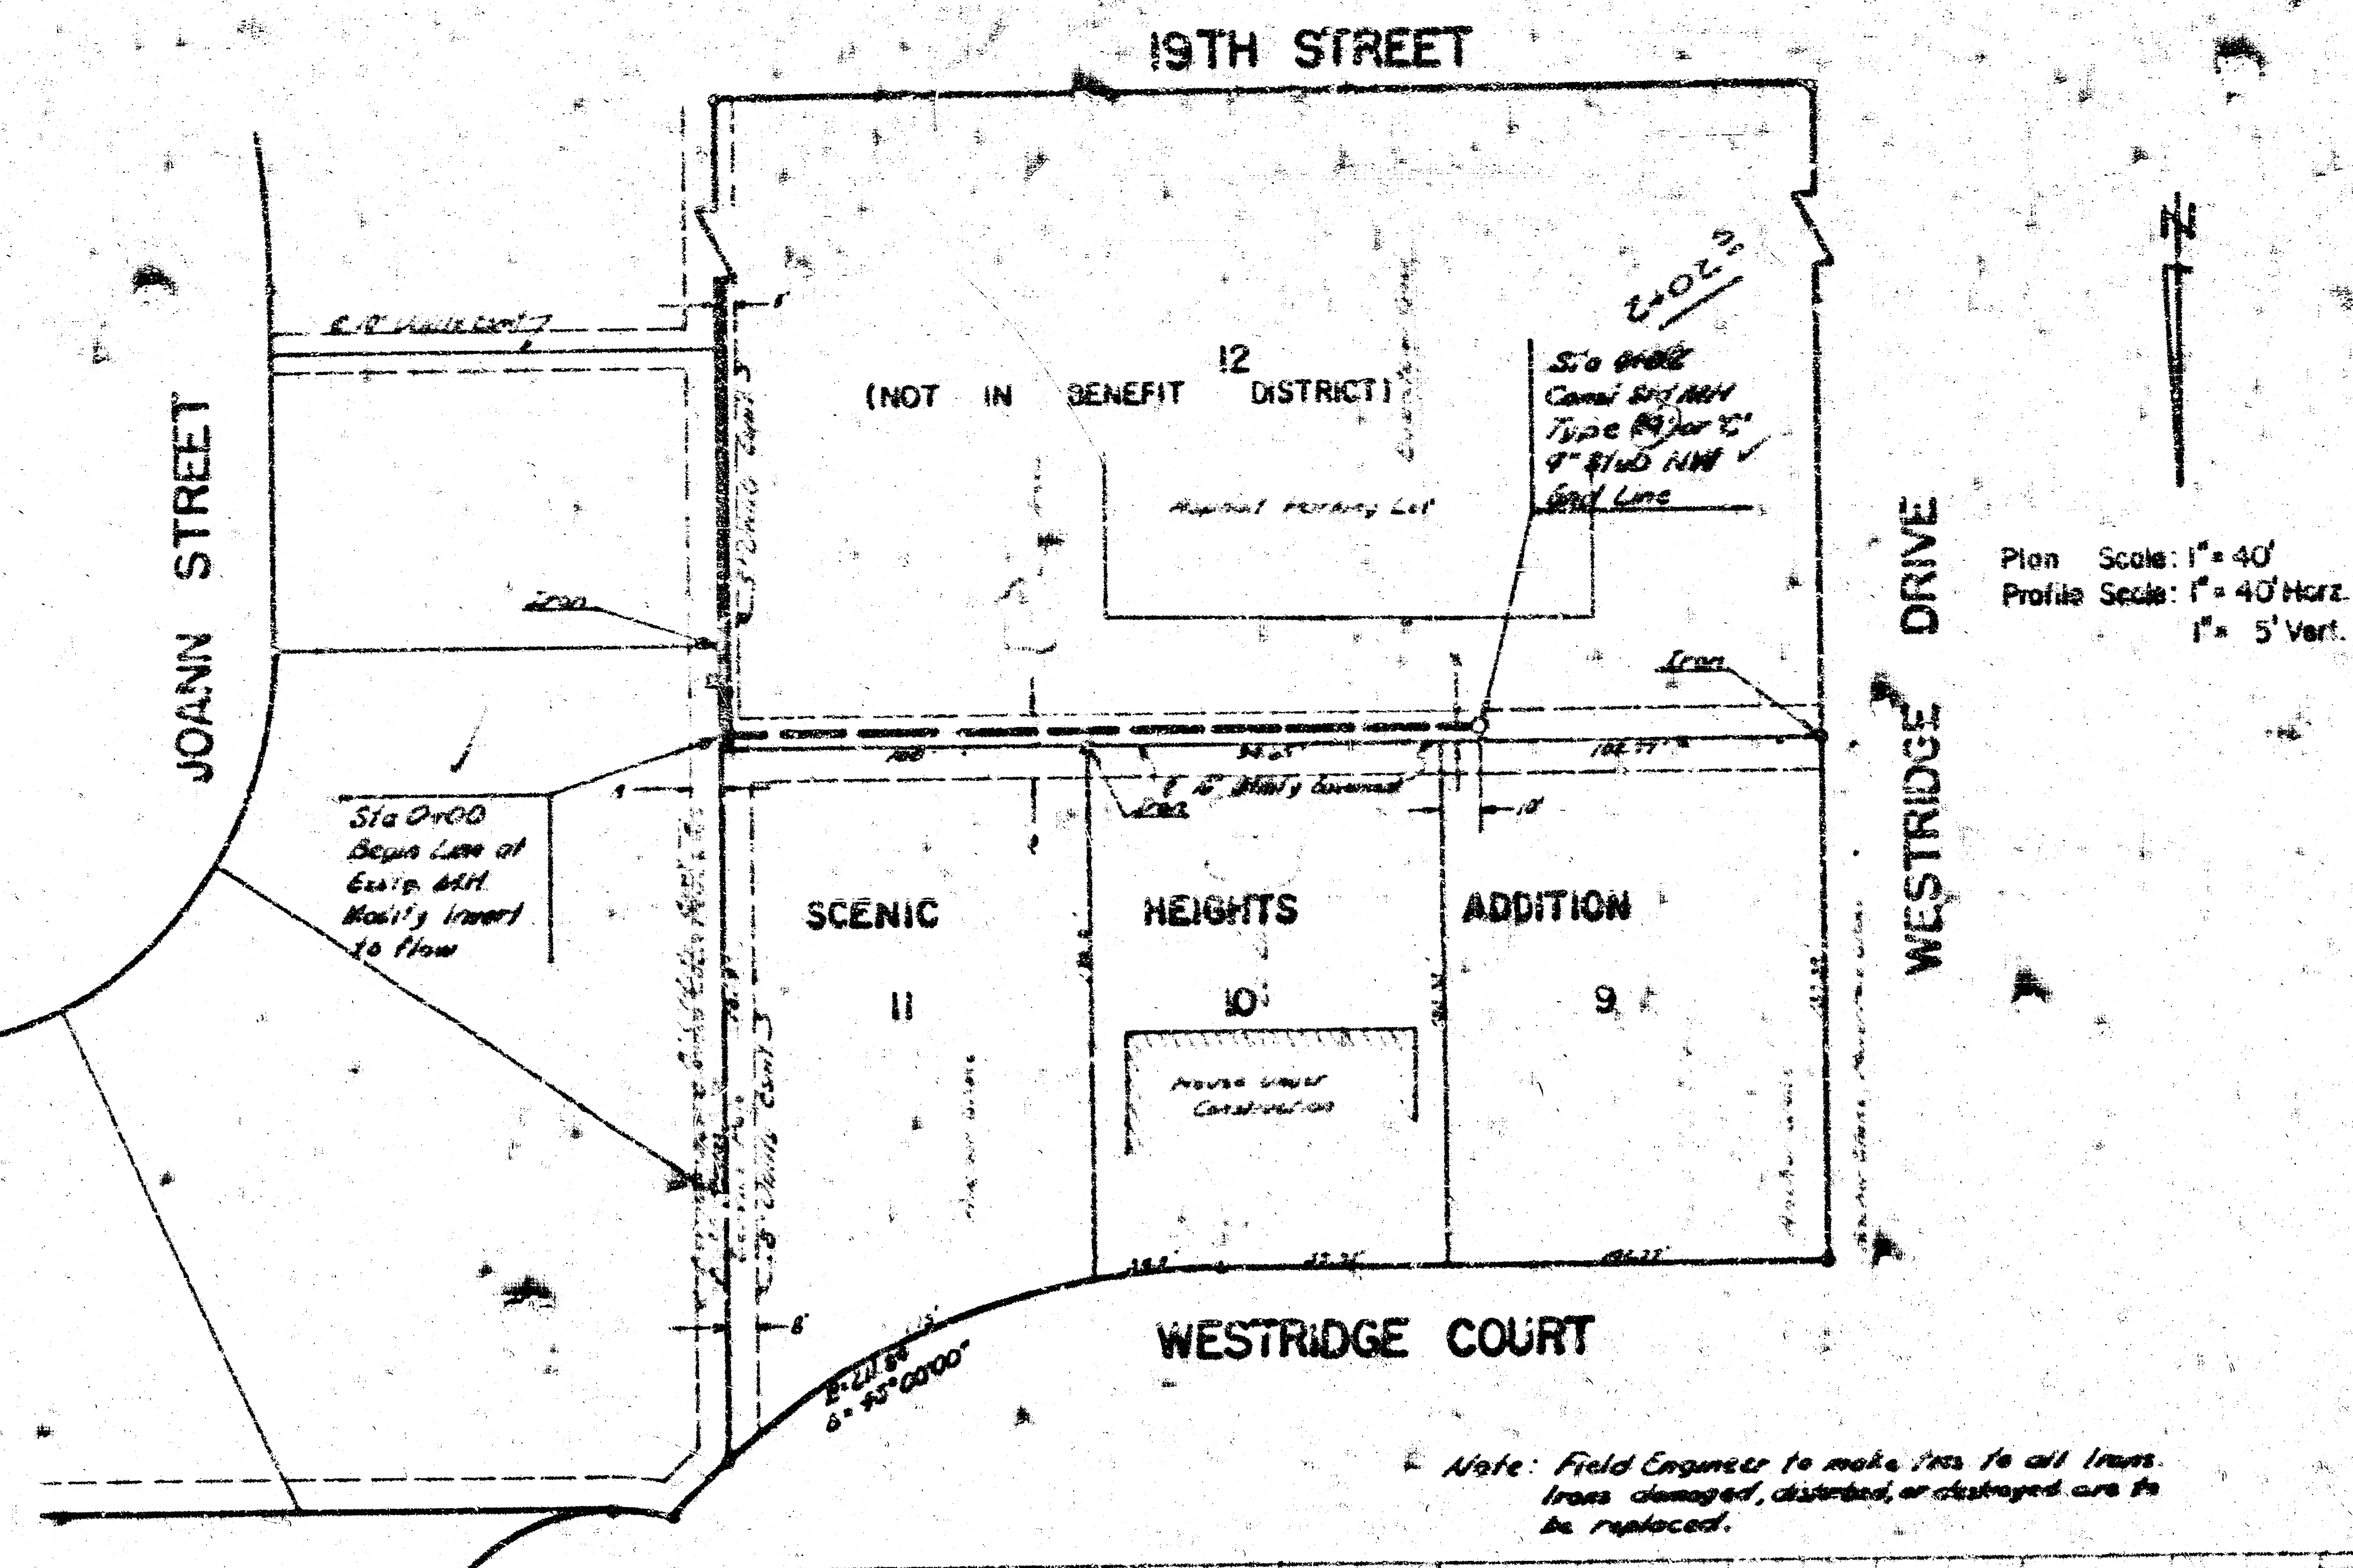

LAT 36, MAIN 10, SANITARY SEWER NO. 22
CITY OF WICHITA, KANSAS
R. W. LYN — CITY ENGINEER
DATE: _____ PROJ. NO. 46678-245-80699-000-000-000