


SEWERAGE 4.77

11-82

Dr. WESTRIDGE

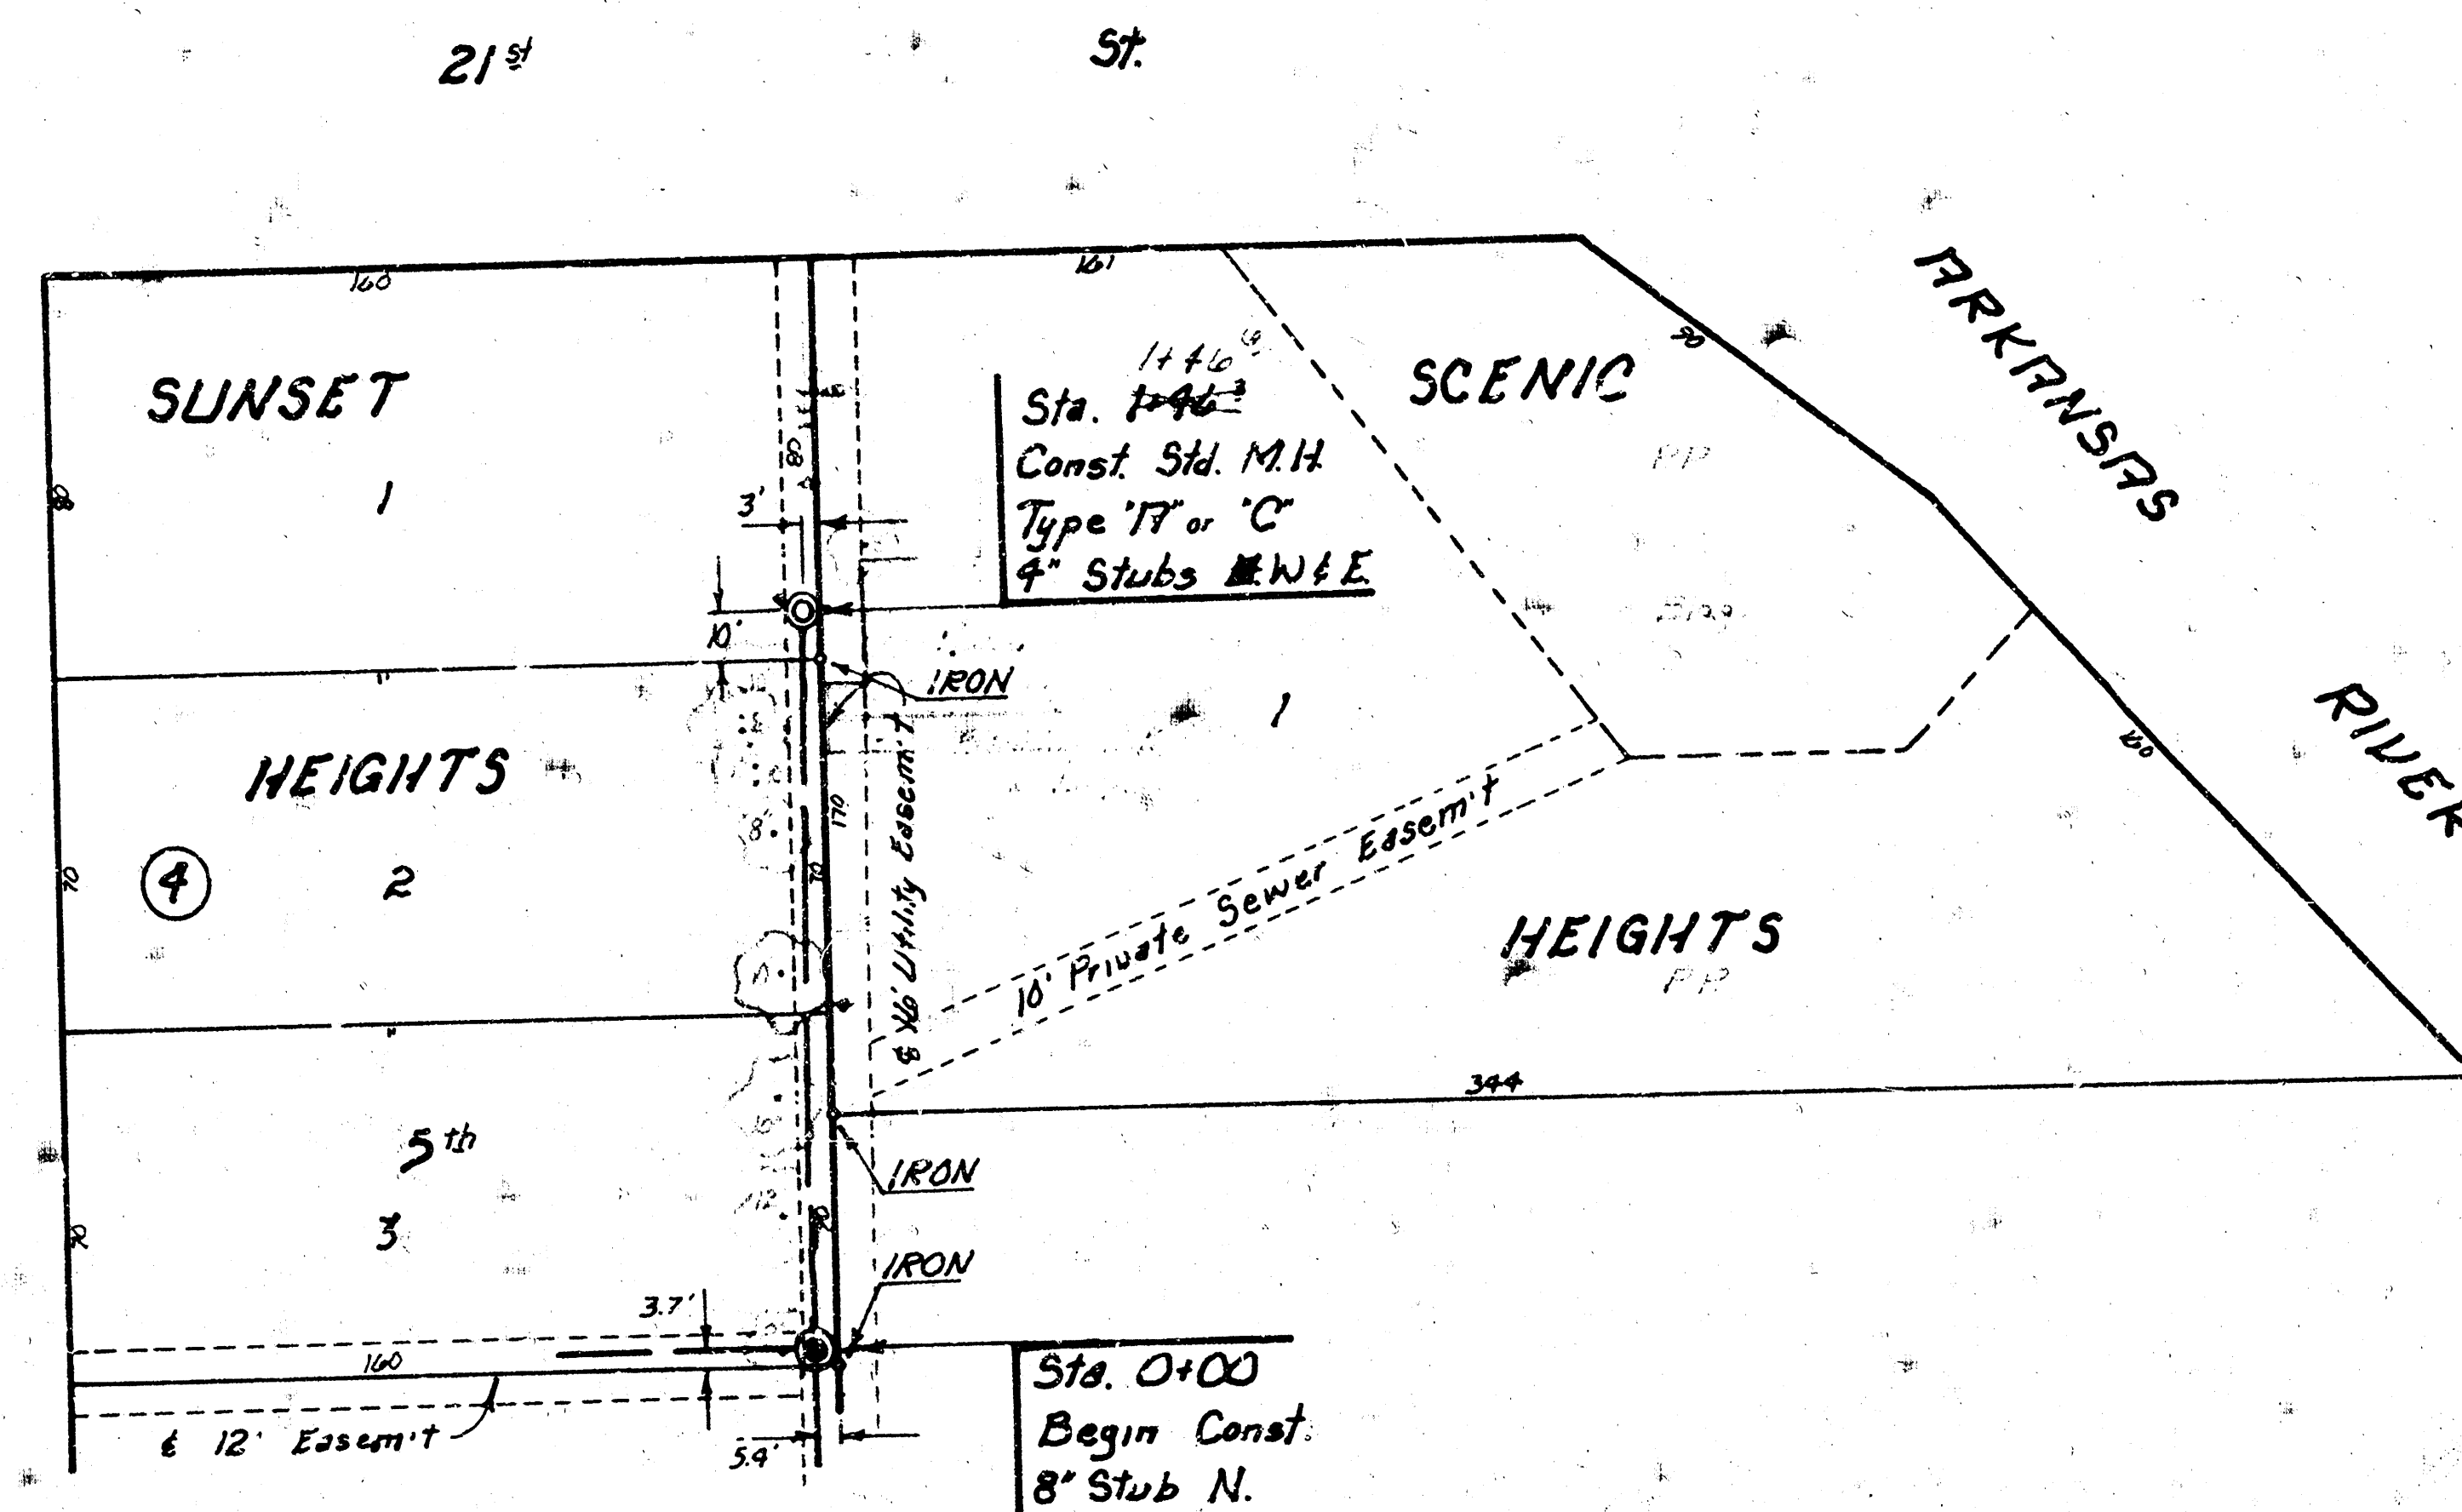


NOTE: CONTRACTORS METHODS FOR CONSTRUCTING THIS PROJECT SHALL BE SUCH THAT WILL PREVENT DAMAGE OF ANY TREES AND RETAINING WALL.

SCALE

Plan 1" = 40'
Profile 1" = 40'
Horz 1" = 40'
Vert 1" = 5'

B.M. 132.91 N.E. Cor. Can. Porch
2117 W. RIDGE Dr.


135
130
125
120

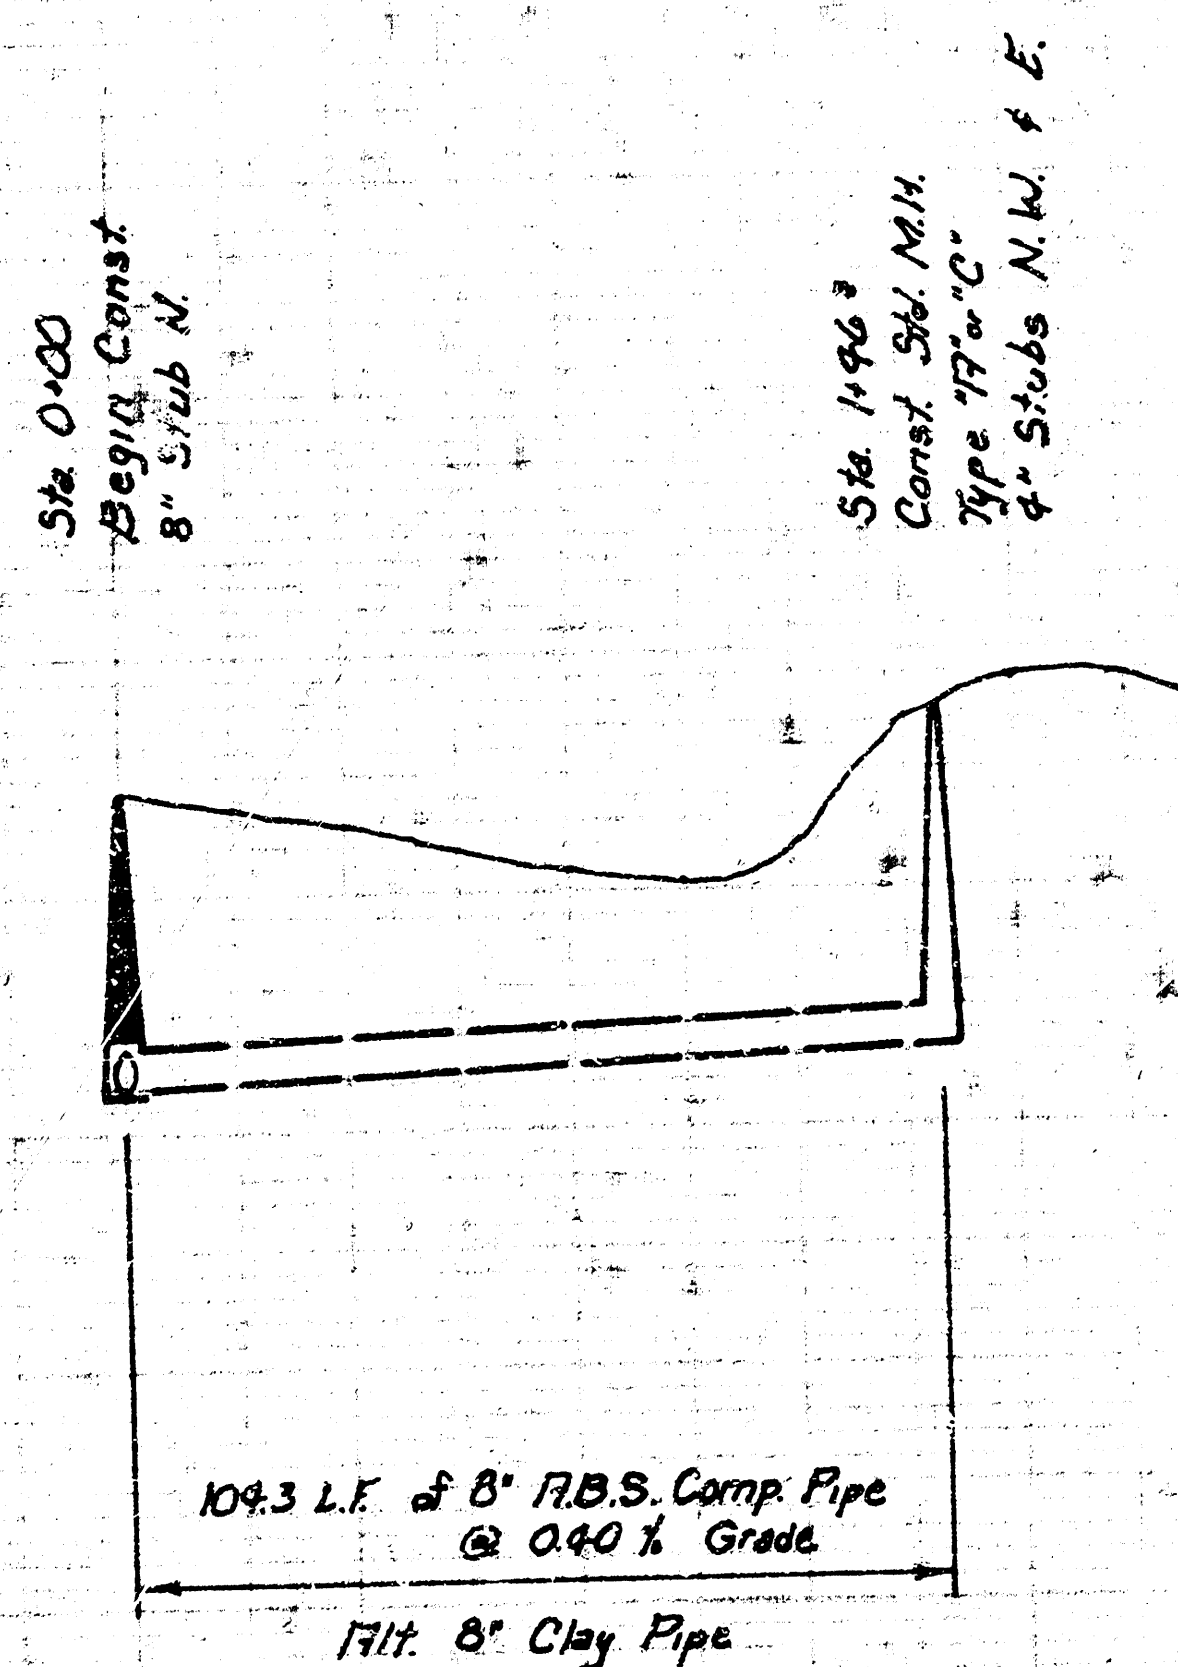

125.00 ft. Old
126.00 ft. In

120.00

126.00

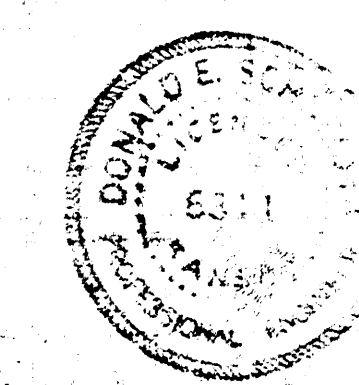

As Bldg
2/10/97

Lat. 37, Main 10, S.S. No. 22
City of WICHITA, KANSAS
R.W. LINN CITY ENGINEER
PROJ. NO. 468-76-245-80732-000-000-001
DATE: