
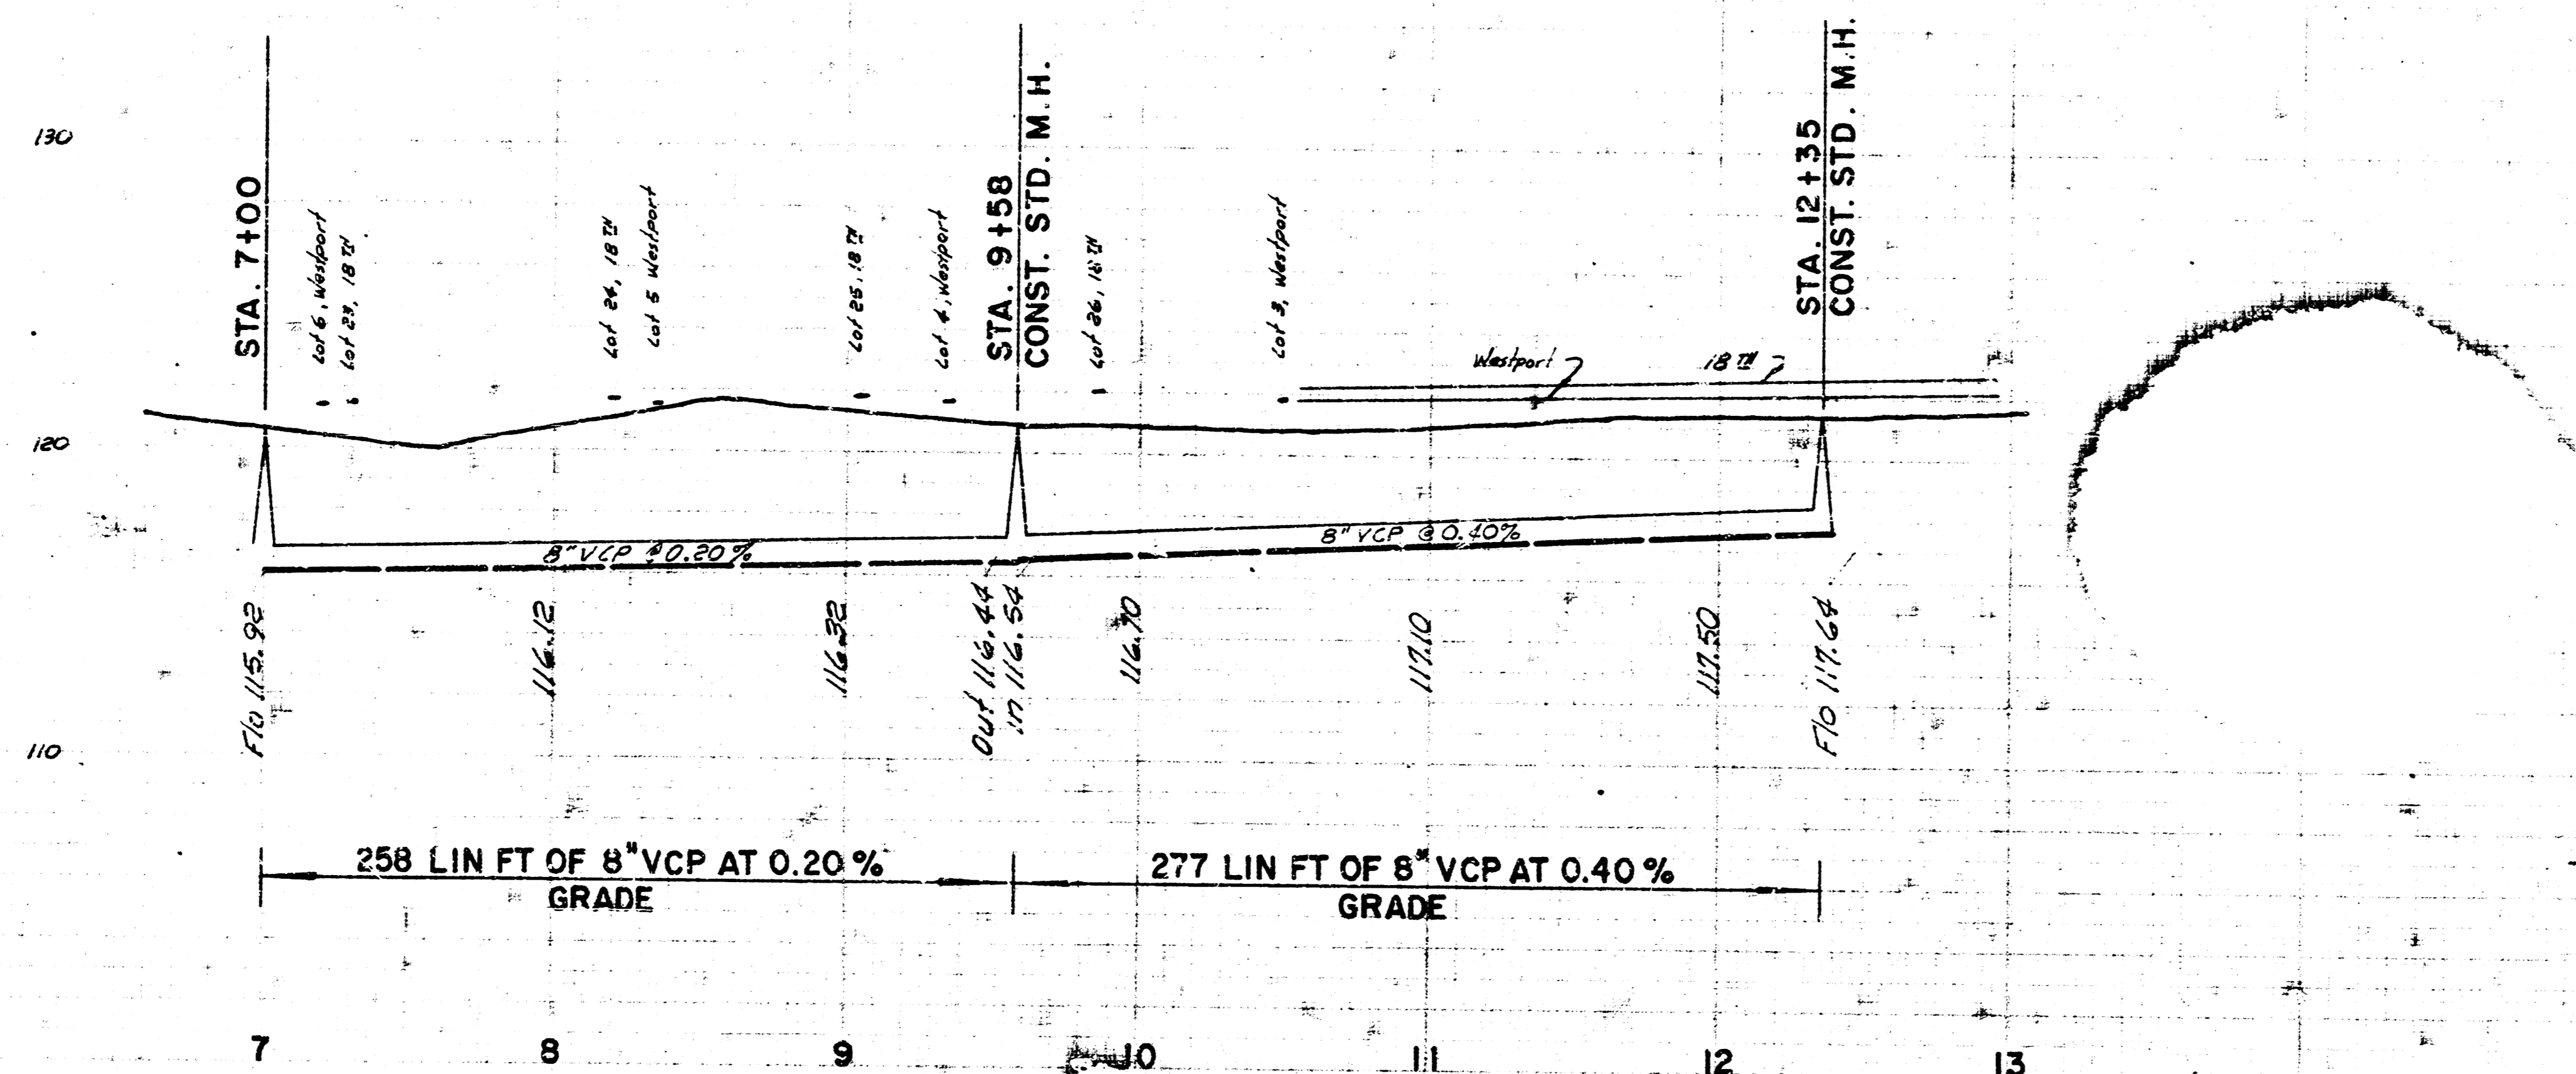


PLAN SCALE 1"=40'
 PROFILE SCALE 1"=40' HOR
 1"=4' VERT.

B.M. 122.97 "M" IN MUELLER TOP F. HYDT. S.W. COR. 17TH & CLARENCE

LAT. 22, SUB. 13, S.S. 22
 CITY OF WICHITA, KANSAS
 B.E. SMITH, CITY ENGINEER
 PROJ. NO. C23-117 DATE APR-1904

1/2

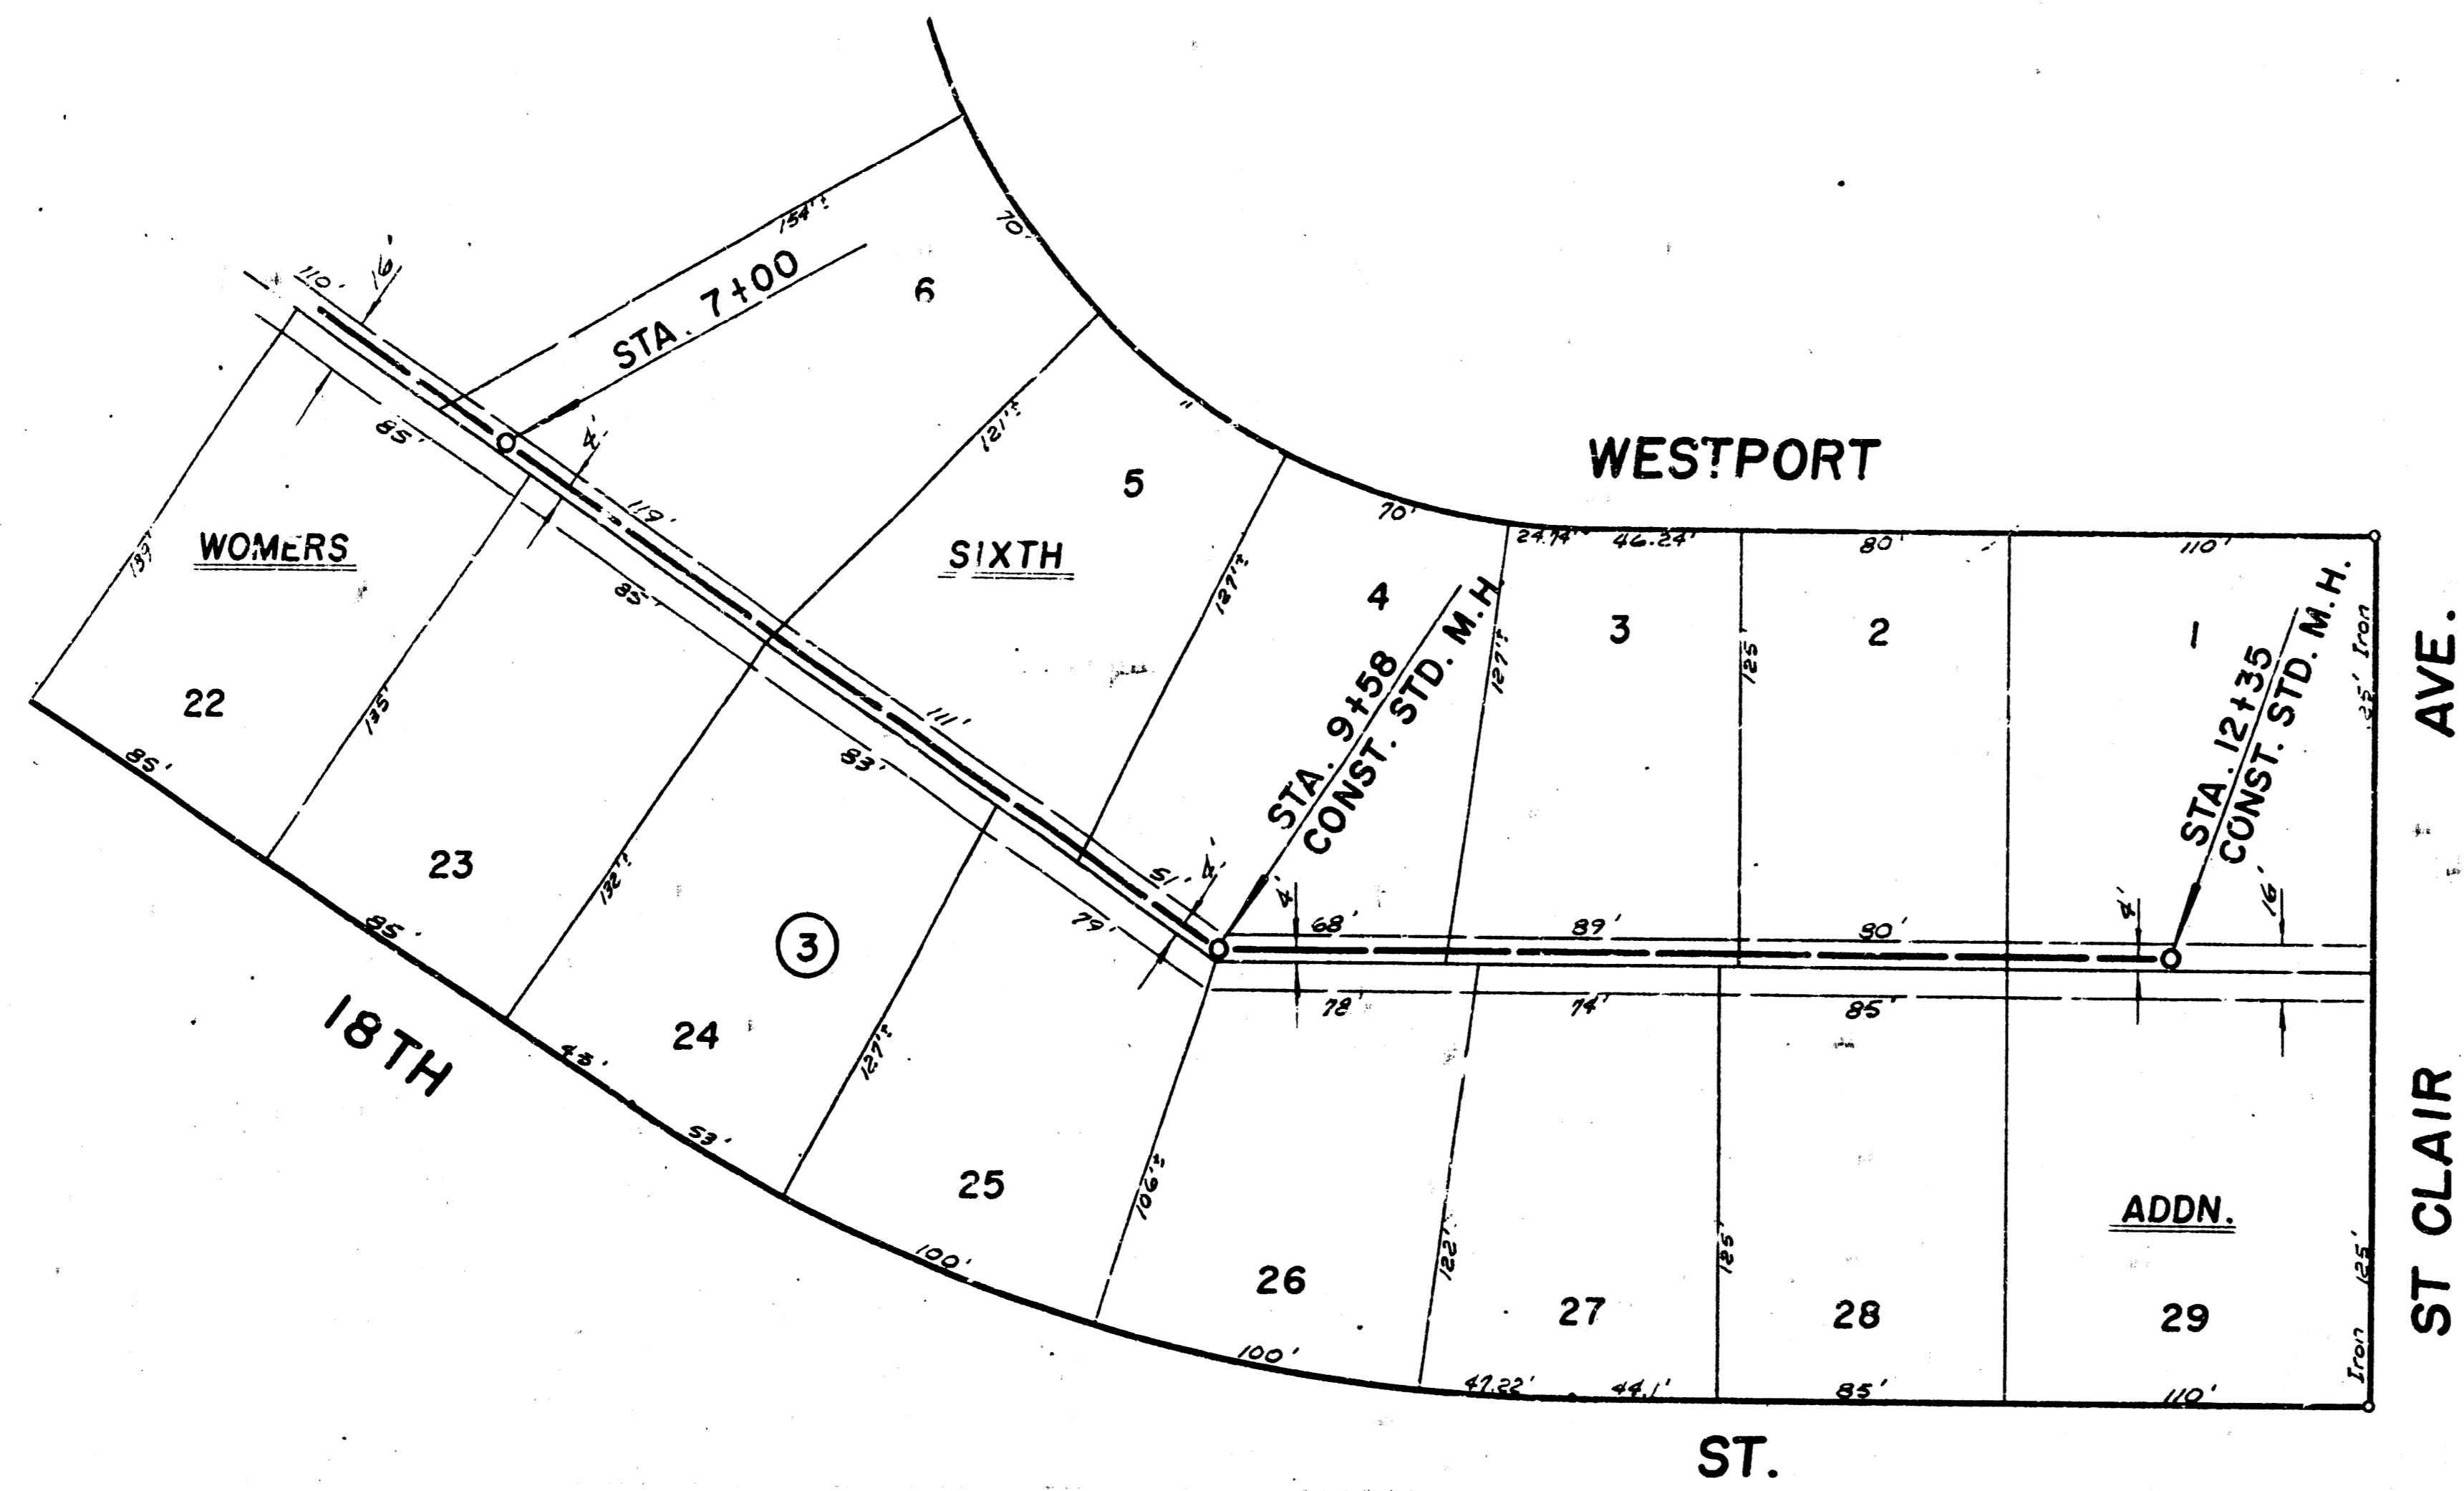

2/2

LAT. 22, SUB. 13, S.S. 22
 PROJ. NO. C23-117