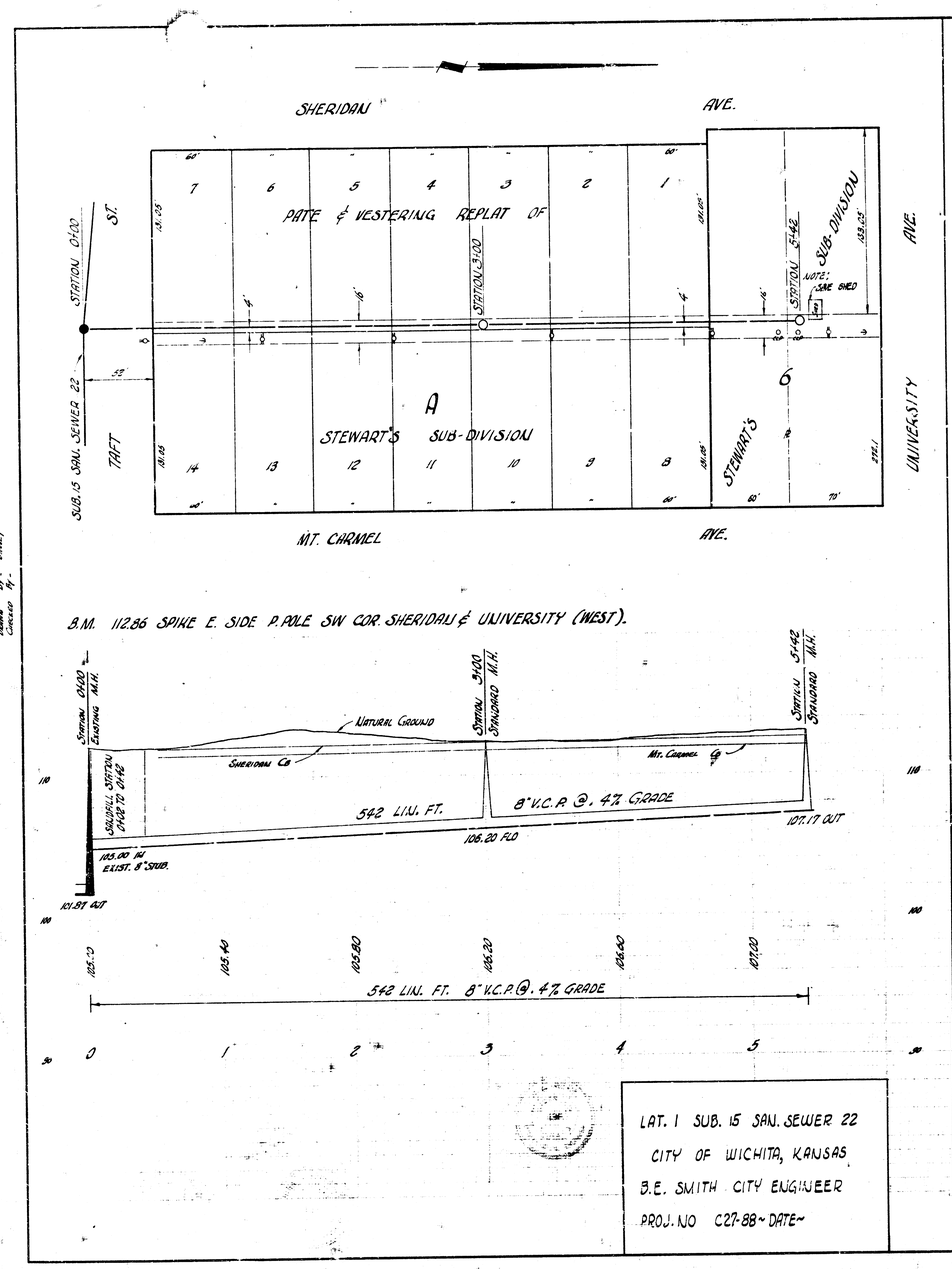
SHERIDAN AVE.
MT. CARMEL AVE.
TAFT ST.
UNIVERSITY AVE.
PATE & VESTERING REPLAT OF
STEWART'S SUB-DIVISION
A
STEWART'S SUB-DIVISION
6
STATION 0+00
STATION 3+00
STATION 5+42
NOTE: SAE SHED
SUB. 15 SAN. SEWER 22
B.M. 112.86 SPIKE E. SIDE P. POLE SW COR. SHERIDAN & UNIVERSITY (WEST).
NATURAL GROUND
SHERIDAN CB
MT. CARMEL ℄
542 LIN. FT.
8" V.C.P. @ .4% GRADE
105.00 IN
EXIST. 8" SUB.
101.87 OUT
106.20 FLO
107.17 OUT
542 LIN. FT. 8" V.C.P. @ .4% GRADE
LAT. 1 SUB. 15 SAN. SEWER 22
CITY OF WICHITA, KANSAS
B.E. SMITH CITY ENGINEER
PROJ. NO C27-88 ~ DATE ~

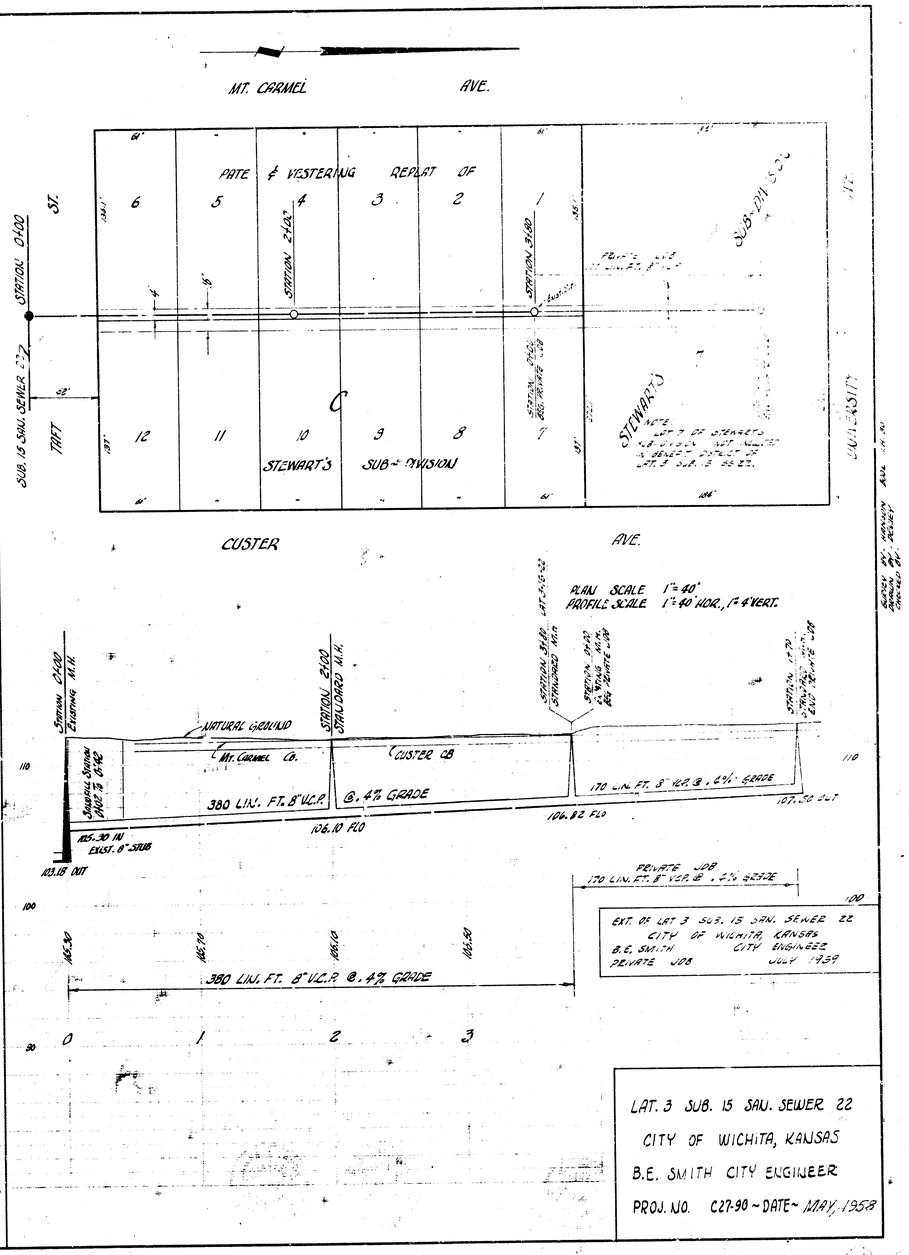
MT. CARMEL AVE.
TAFT ST.
UNIVERSITY AVE.
CUSTER AVE.
PATE & VESTERING REPLAT OF
STEWART'S SUB-DIVISION
C
STEWART'S
SUB-DIV. S 32
STATION 0+00
STATION 2+42
STATION 3+80
SUB. 15 SAN. SEWER 22
PLAN SCALE 1" = 40'
PROFILE SCALE 1" = 40' HOR., 1" = 4' VERT.
NATURAL GROUND
MT. CARMEL CB.
CUSTER CB
380 LIN. FT. 8" V.C.P.
@ .4% GRADE
170 LIN. FT. 8" V.C.P. @ .4% GRADE
105.30 IN
EXIST. 8" SUB
103.18 OUT
106.10 FLO
106.82 FLO
107.50 OUT
PRIVATE JOB
170 LIN. FT. 8" V.C.P. @ .4% GRADE
380 LIN. FT. 8" V.C.P. @ .4% GRADE
EXT. OF LAT. 3 SUB. 15 SAN. SEWER 22
CITY OF WICHITA, KANSAS
B.E. SMITH CITY ENGINEER
PRIVATE JOB JULY 1959
LAT. 3 SUB. 15 SAN. SEWER 22
CITY OF WICHITA, KANSAS
B.E. SMITH CITY ENGINEER
PROJ. NO. C27-90 ~ DATE ~ MAY, 1958