



H. K. ...
D. ...

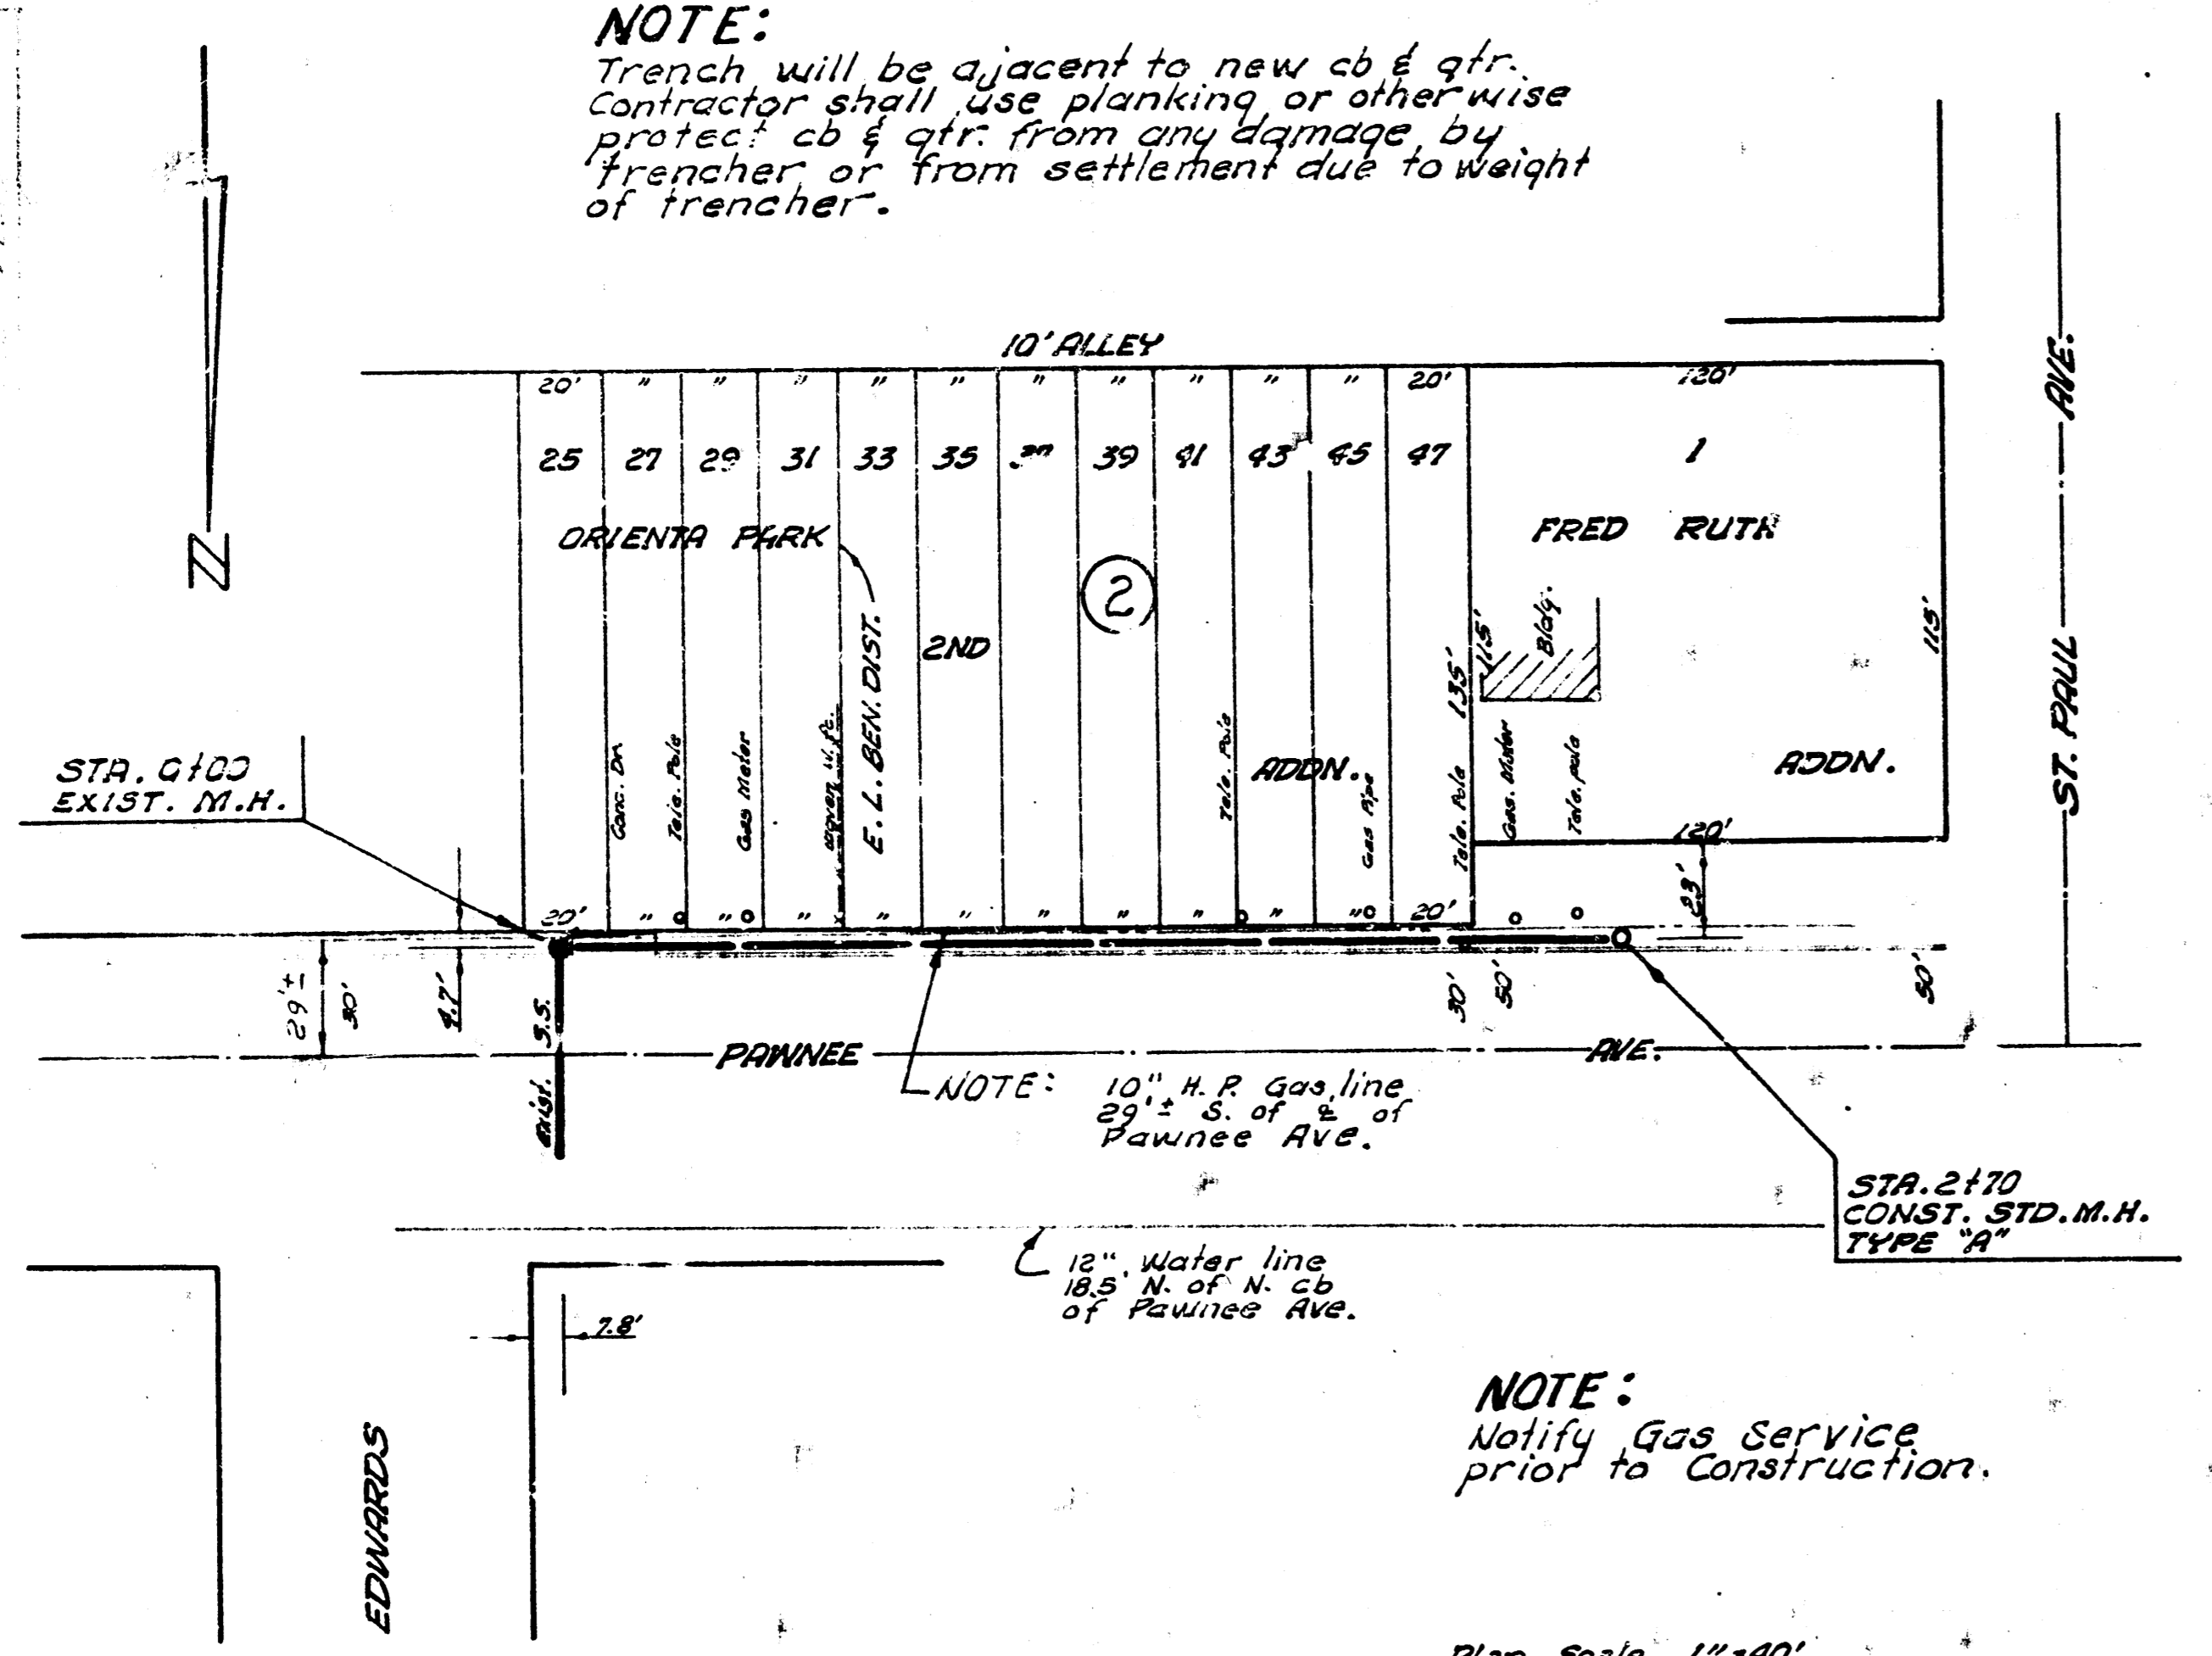

B.M. 102.07 City Standard S.E. Cor. Pawnee & Meridian


Plan Scale 1"=40'
Profile Scale 1"=40' Hor.
1"=4' Vert.

S. ...
P. ...
C. ...

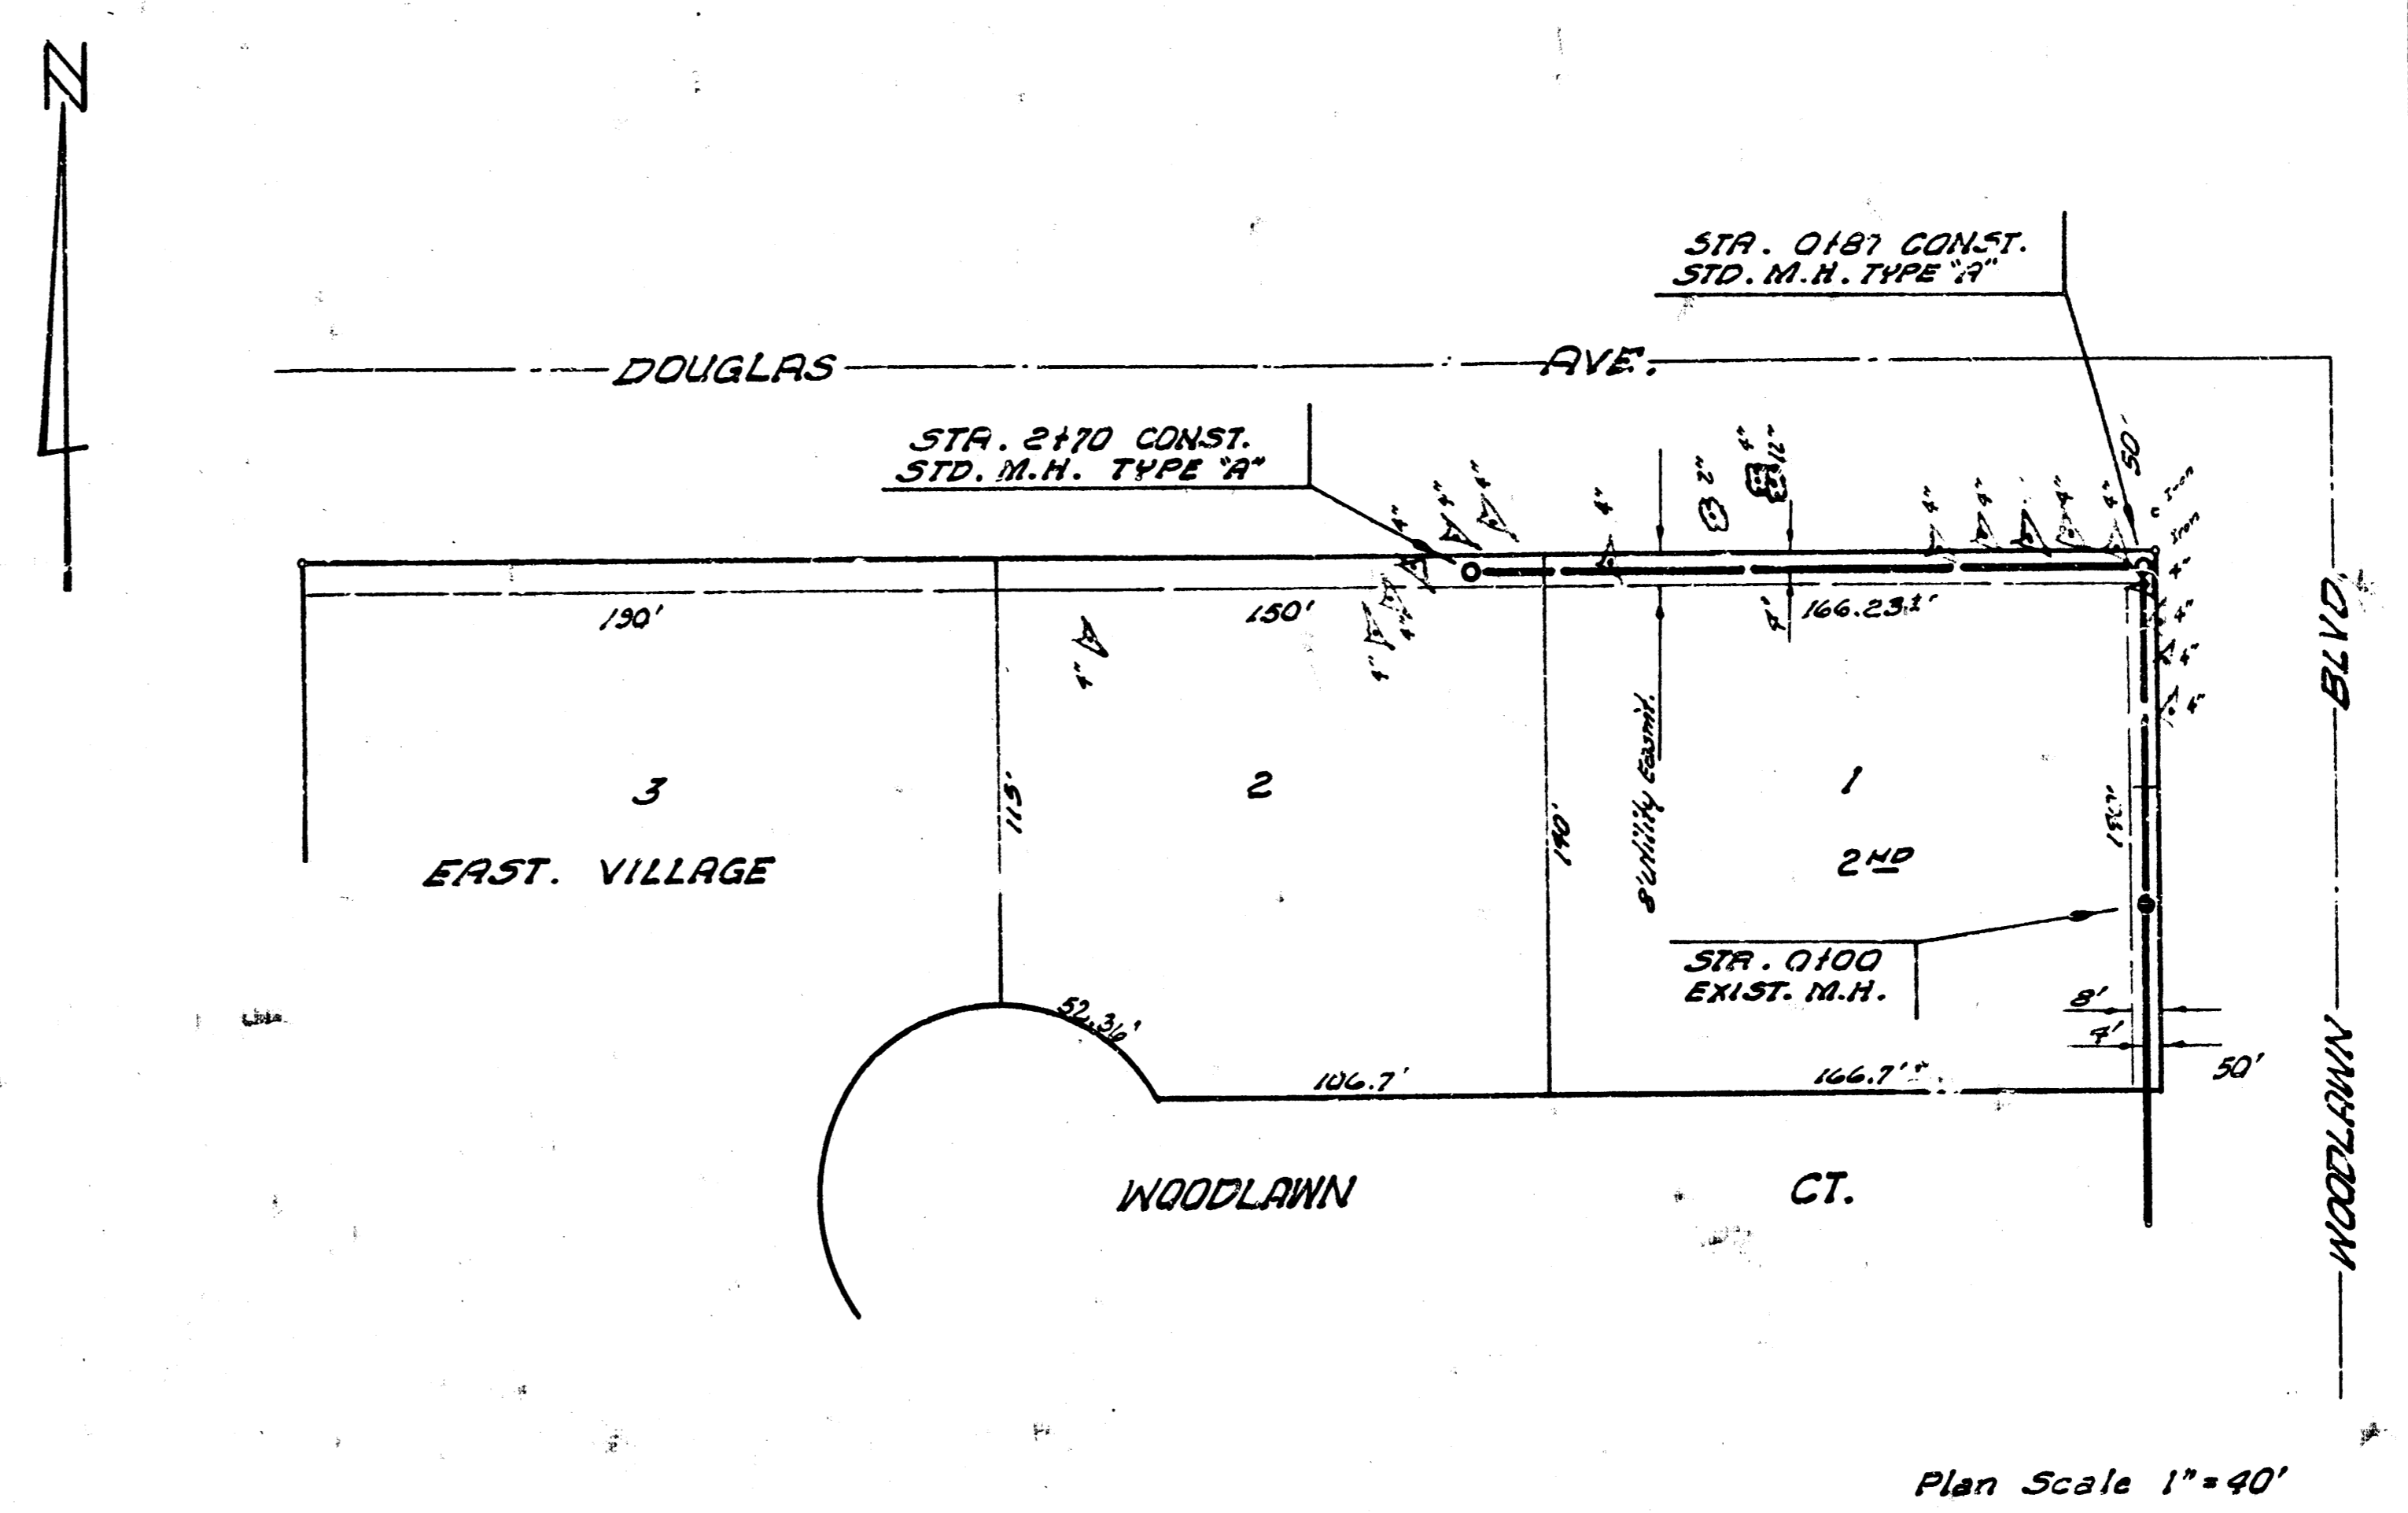


B.M. 179.46 "X" on S.W. Cor. City Concrete M.H. on S.E. Cor. Woodlawn & Douglas

Plan Scale 1"=40'
Profile Scale 1"=40' Hor.
1"=4' Vert.

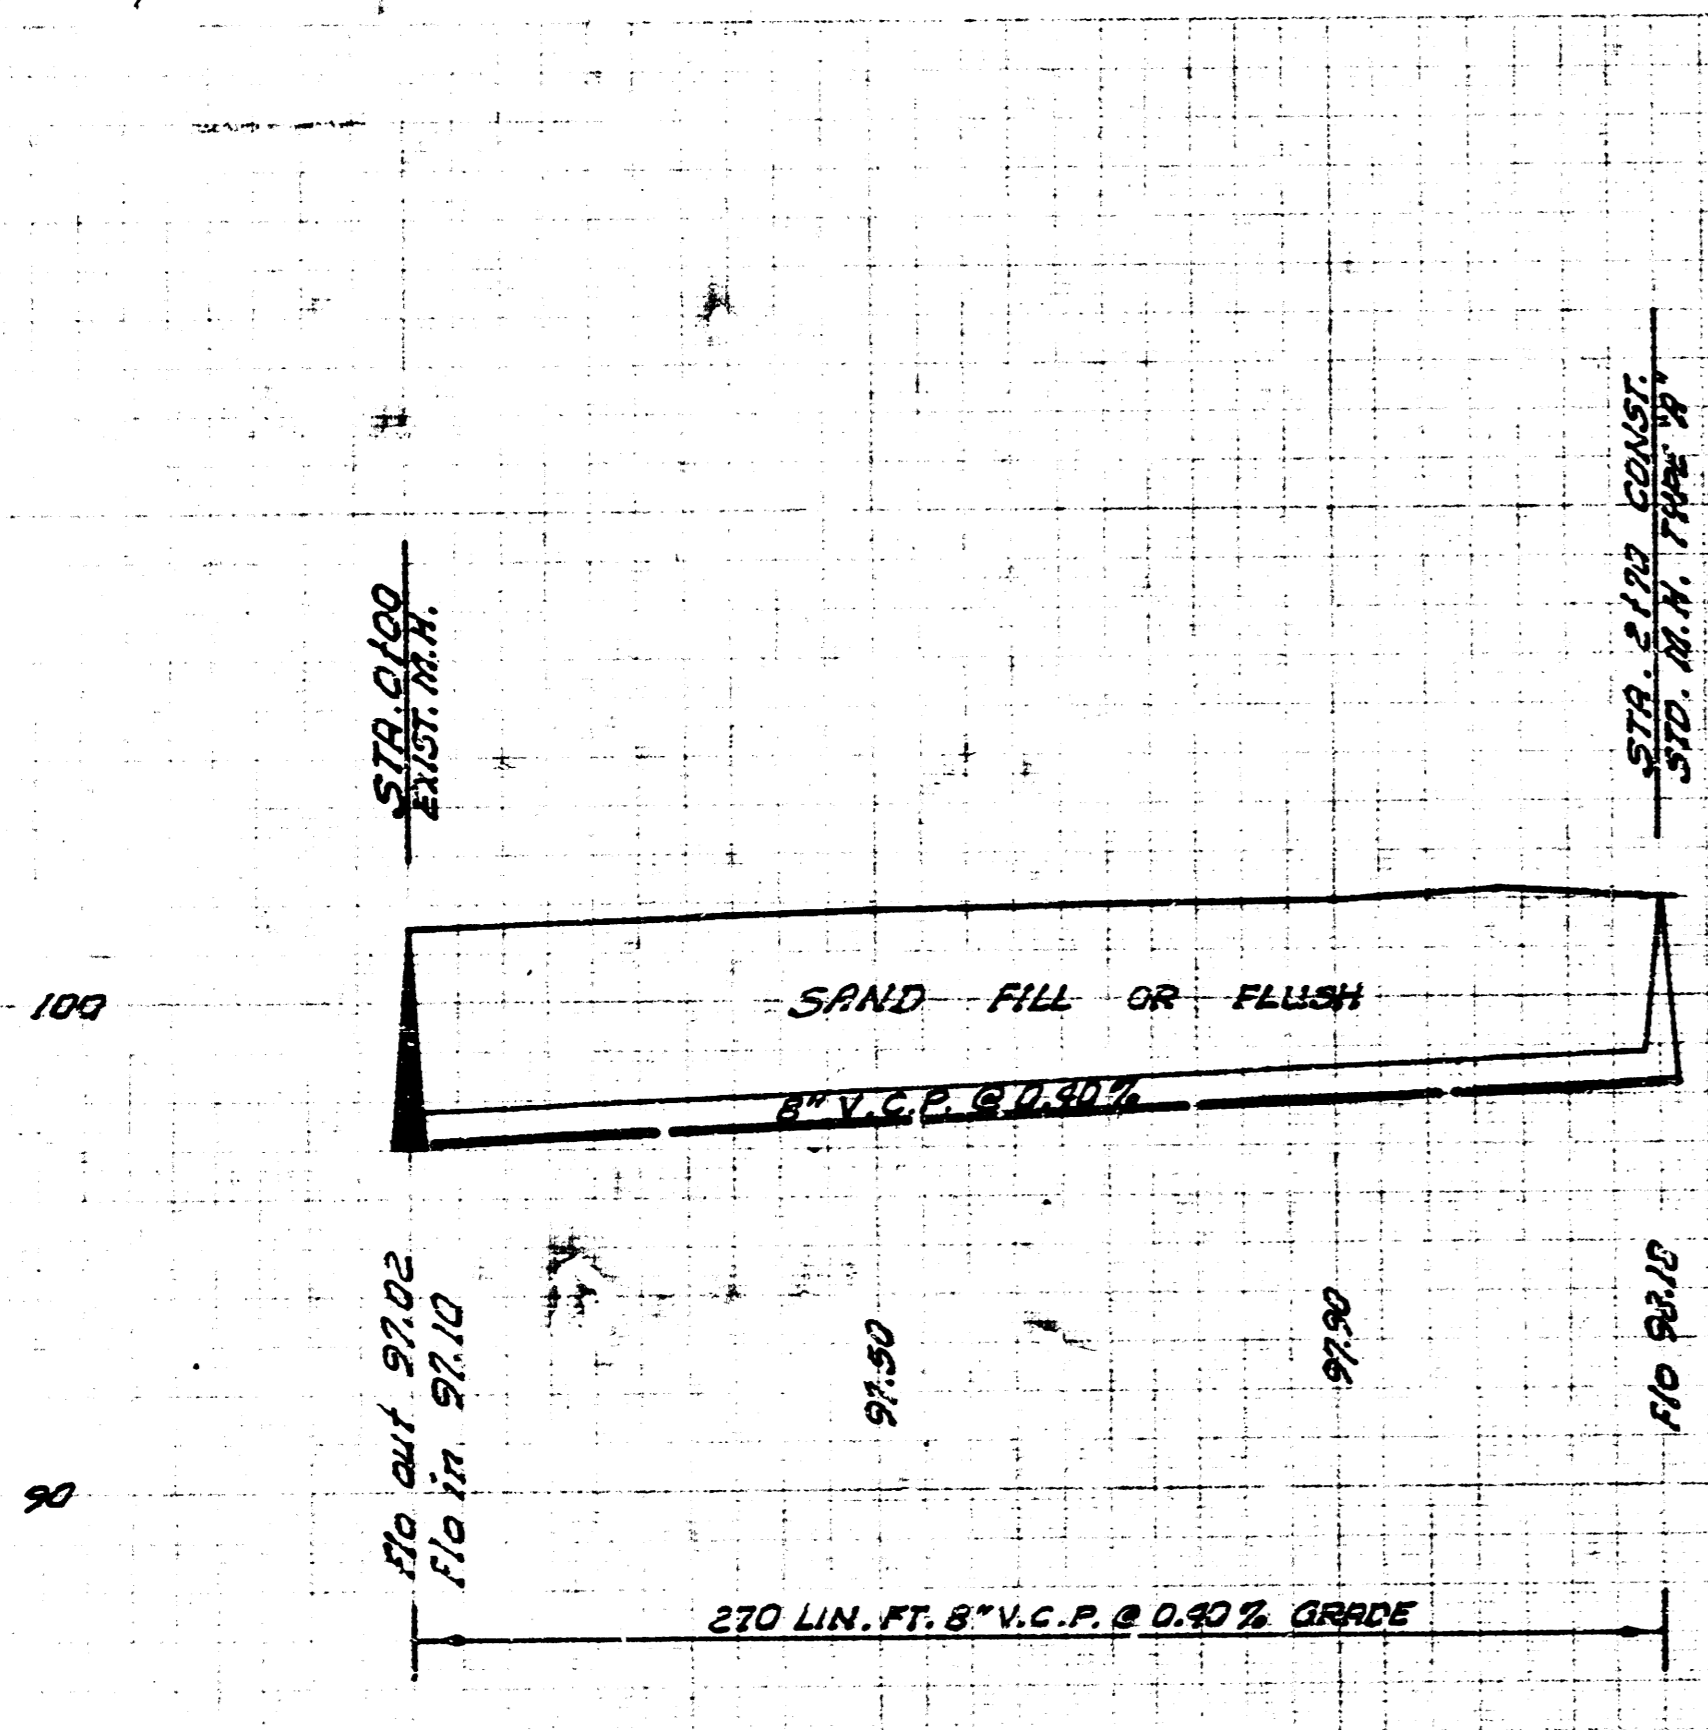

LAT. 9, SUB. 16, S. 5. NO. 22
CITY OF WICHITA, KANSAS
B. E. SMITH, CITY ENGINEER
PROJ. NO. C25-37
DATE: MAR. 1966

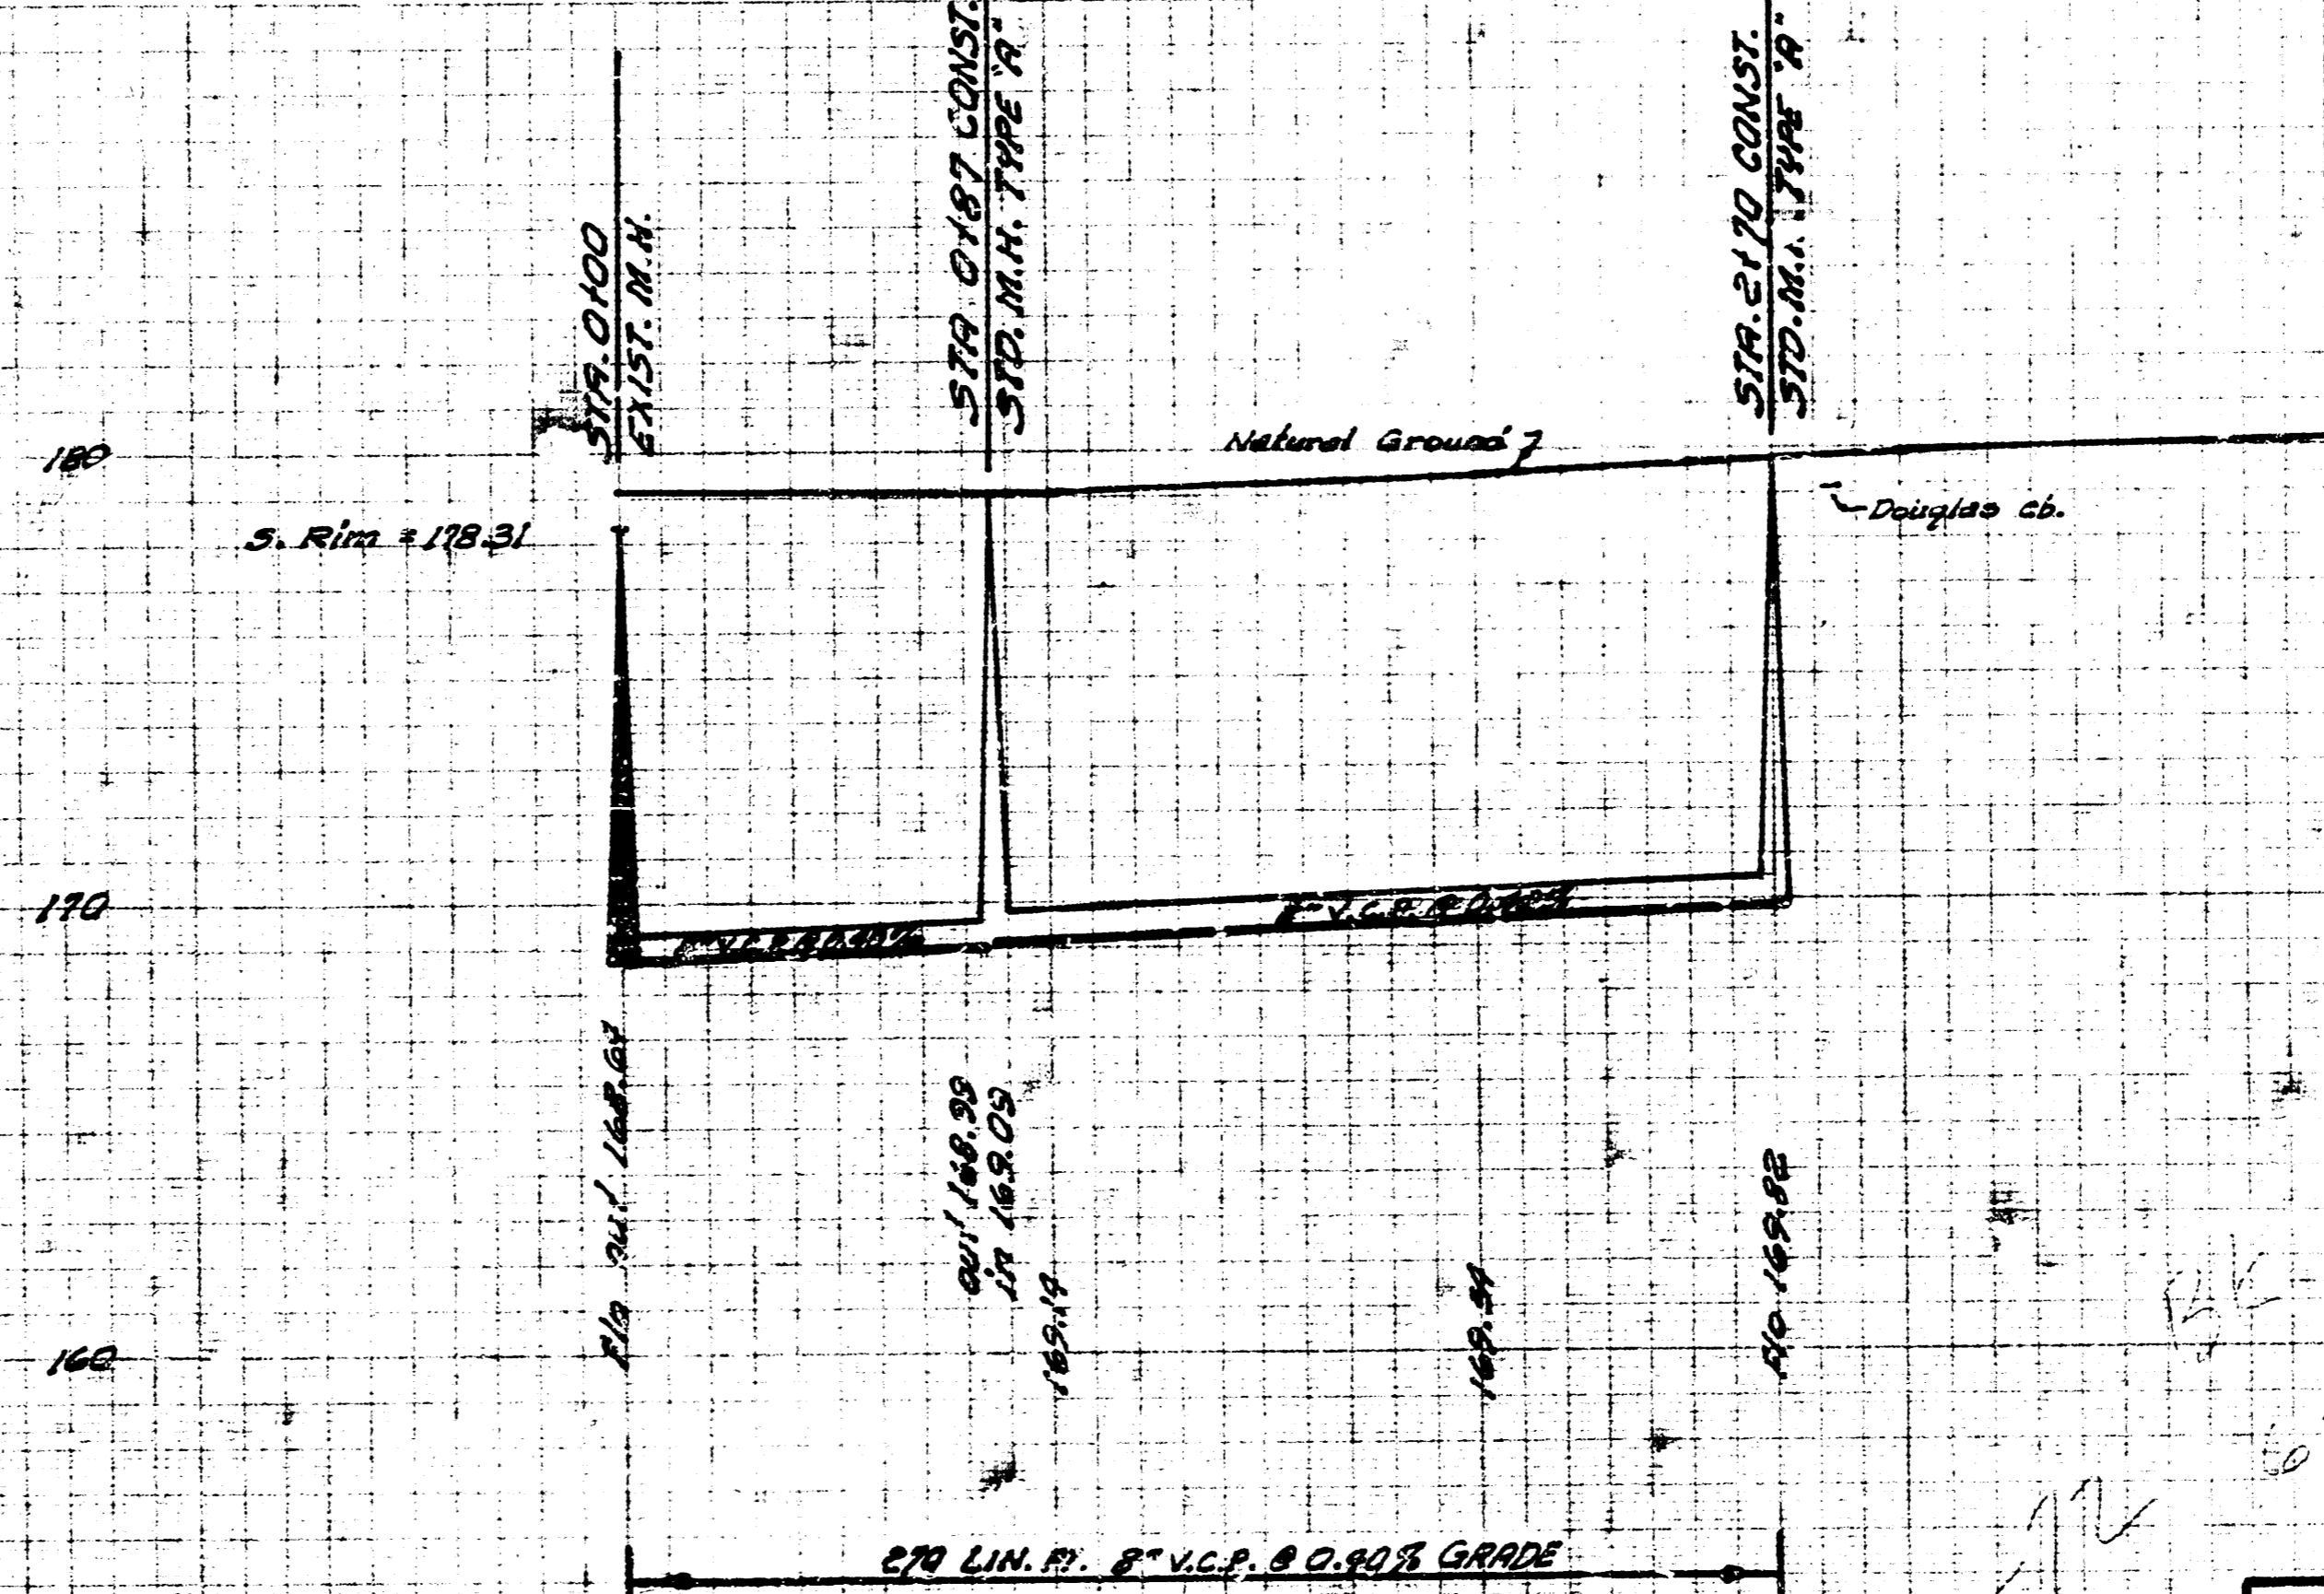

EXTENSION OF LAT. ... 2, S.S. 12
CITY OF WICHITA, KANSAS
B. E. SMITH, CITY ENGINEER
PRIVATE PROJ. DATE: