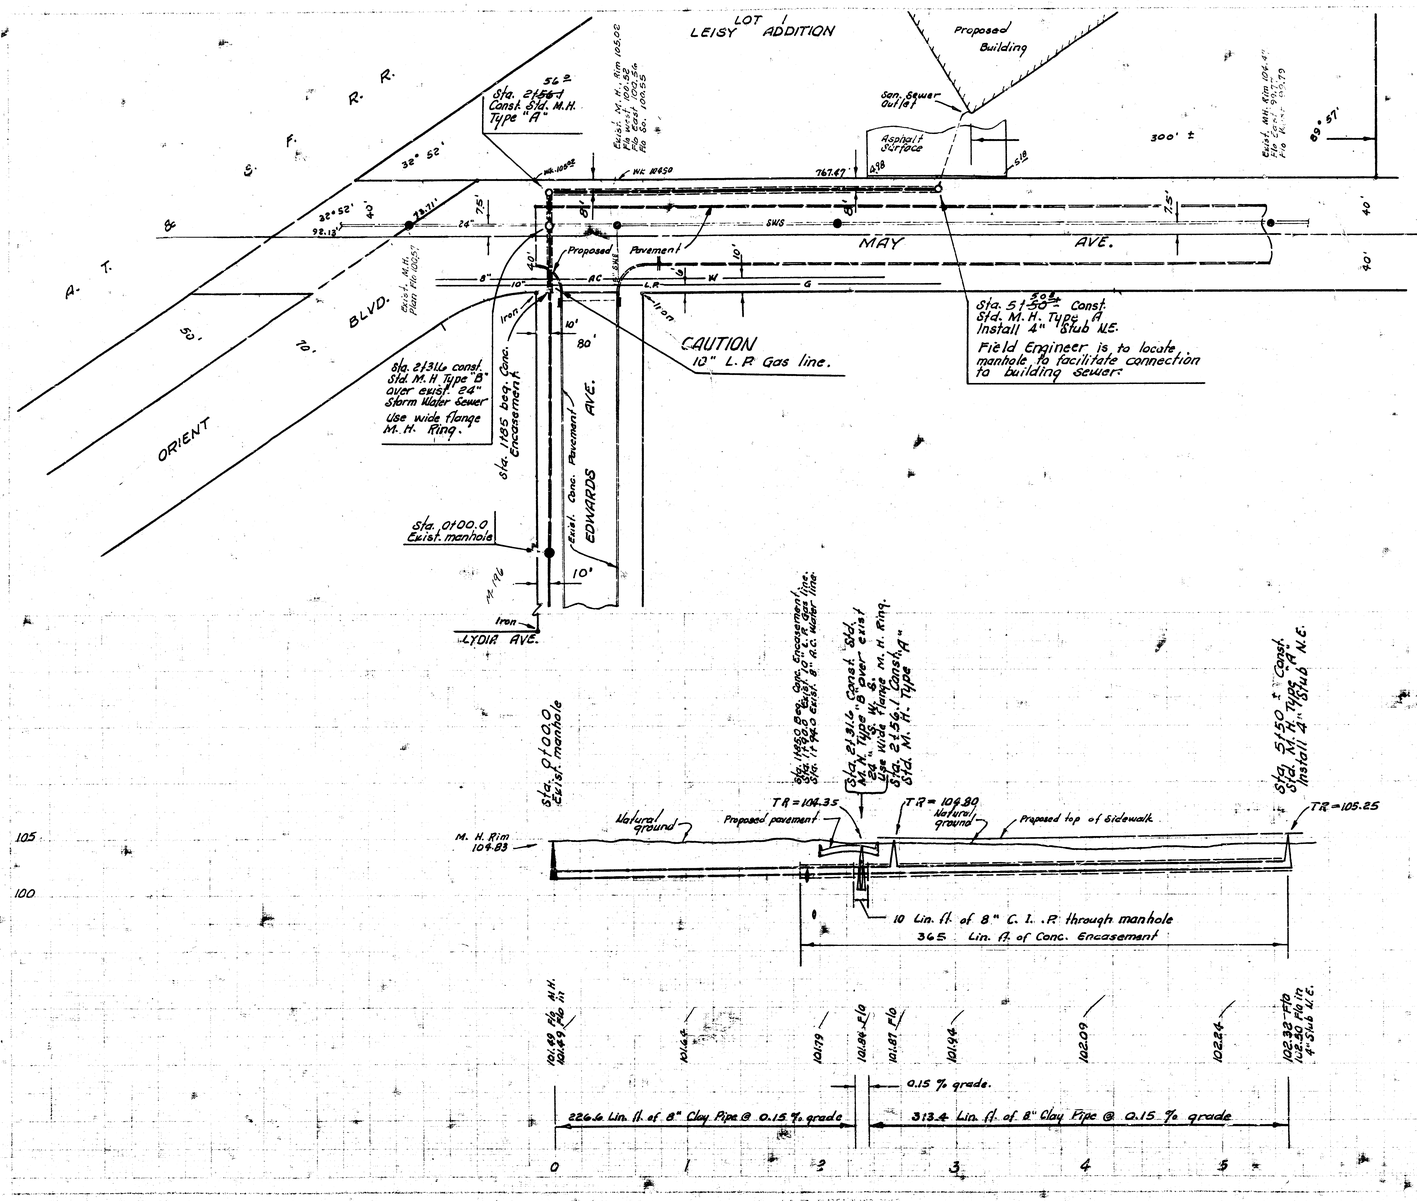

N

Plan Scale 1" = 40'
Profile Scale 1" = 40' Horz.
1" = 5' Vert.

B. M. 104.49" ± on east curb of Edwards 55± south of St. May.

As Built Final Mes. S.S. 1k #5

LAT. 6, MAIN 16, S. S. NO. 22
CITY OF WICHITA, KANSAS
R. W. LINN — CITY ENGINEER
DEC. 1973 PROJECT NO. BBKL 573053

DONALD E. SCHEIDER LICENSED 6311 KANSAS PROFESSIONAL ENGINEER

10-Engr
1-Water

FILMED FROM THE BEST