


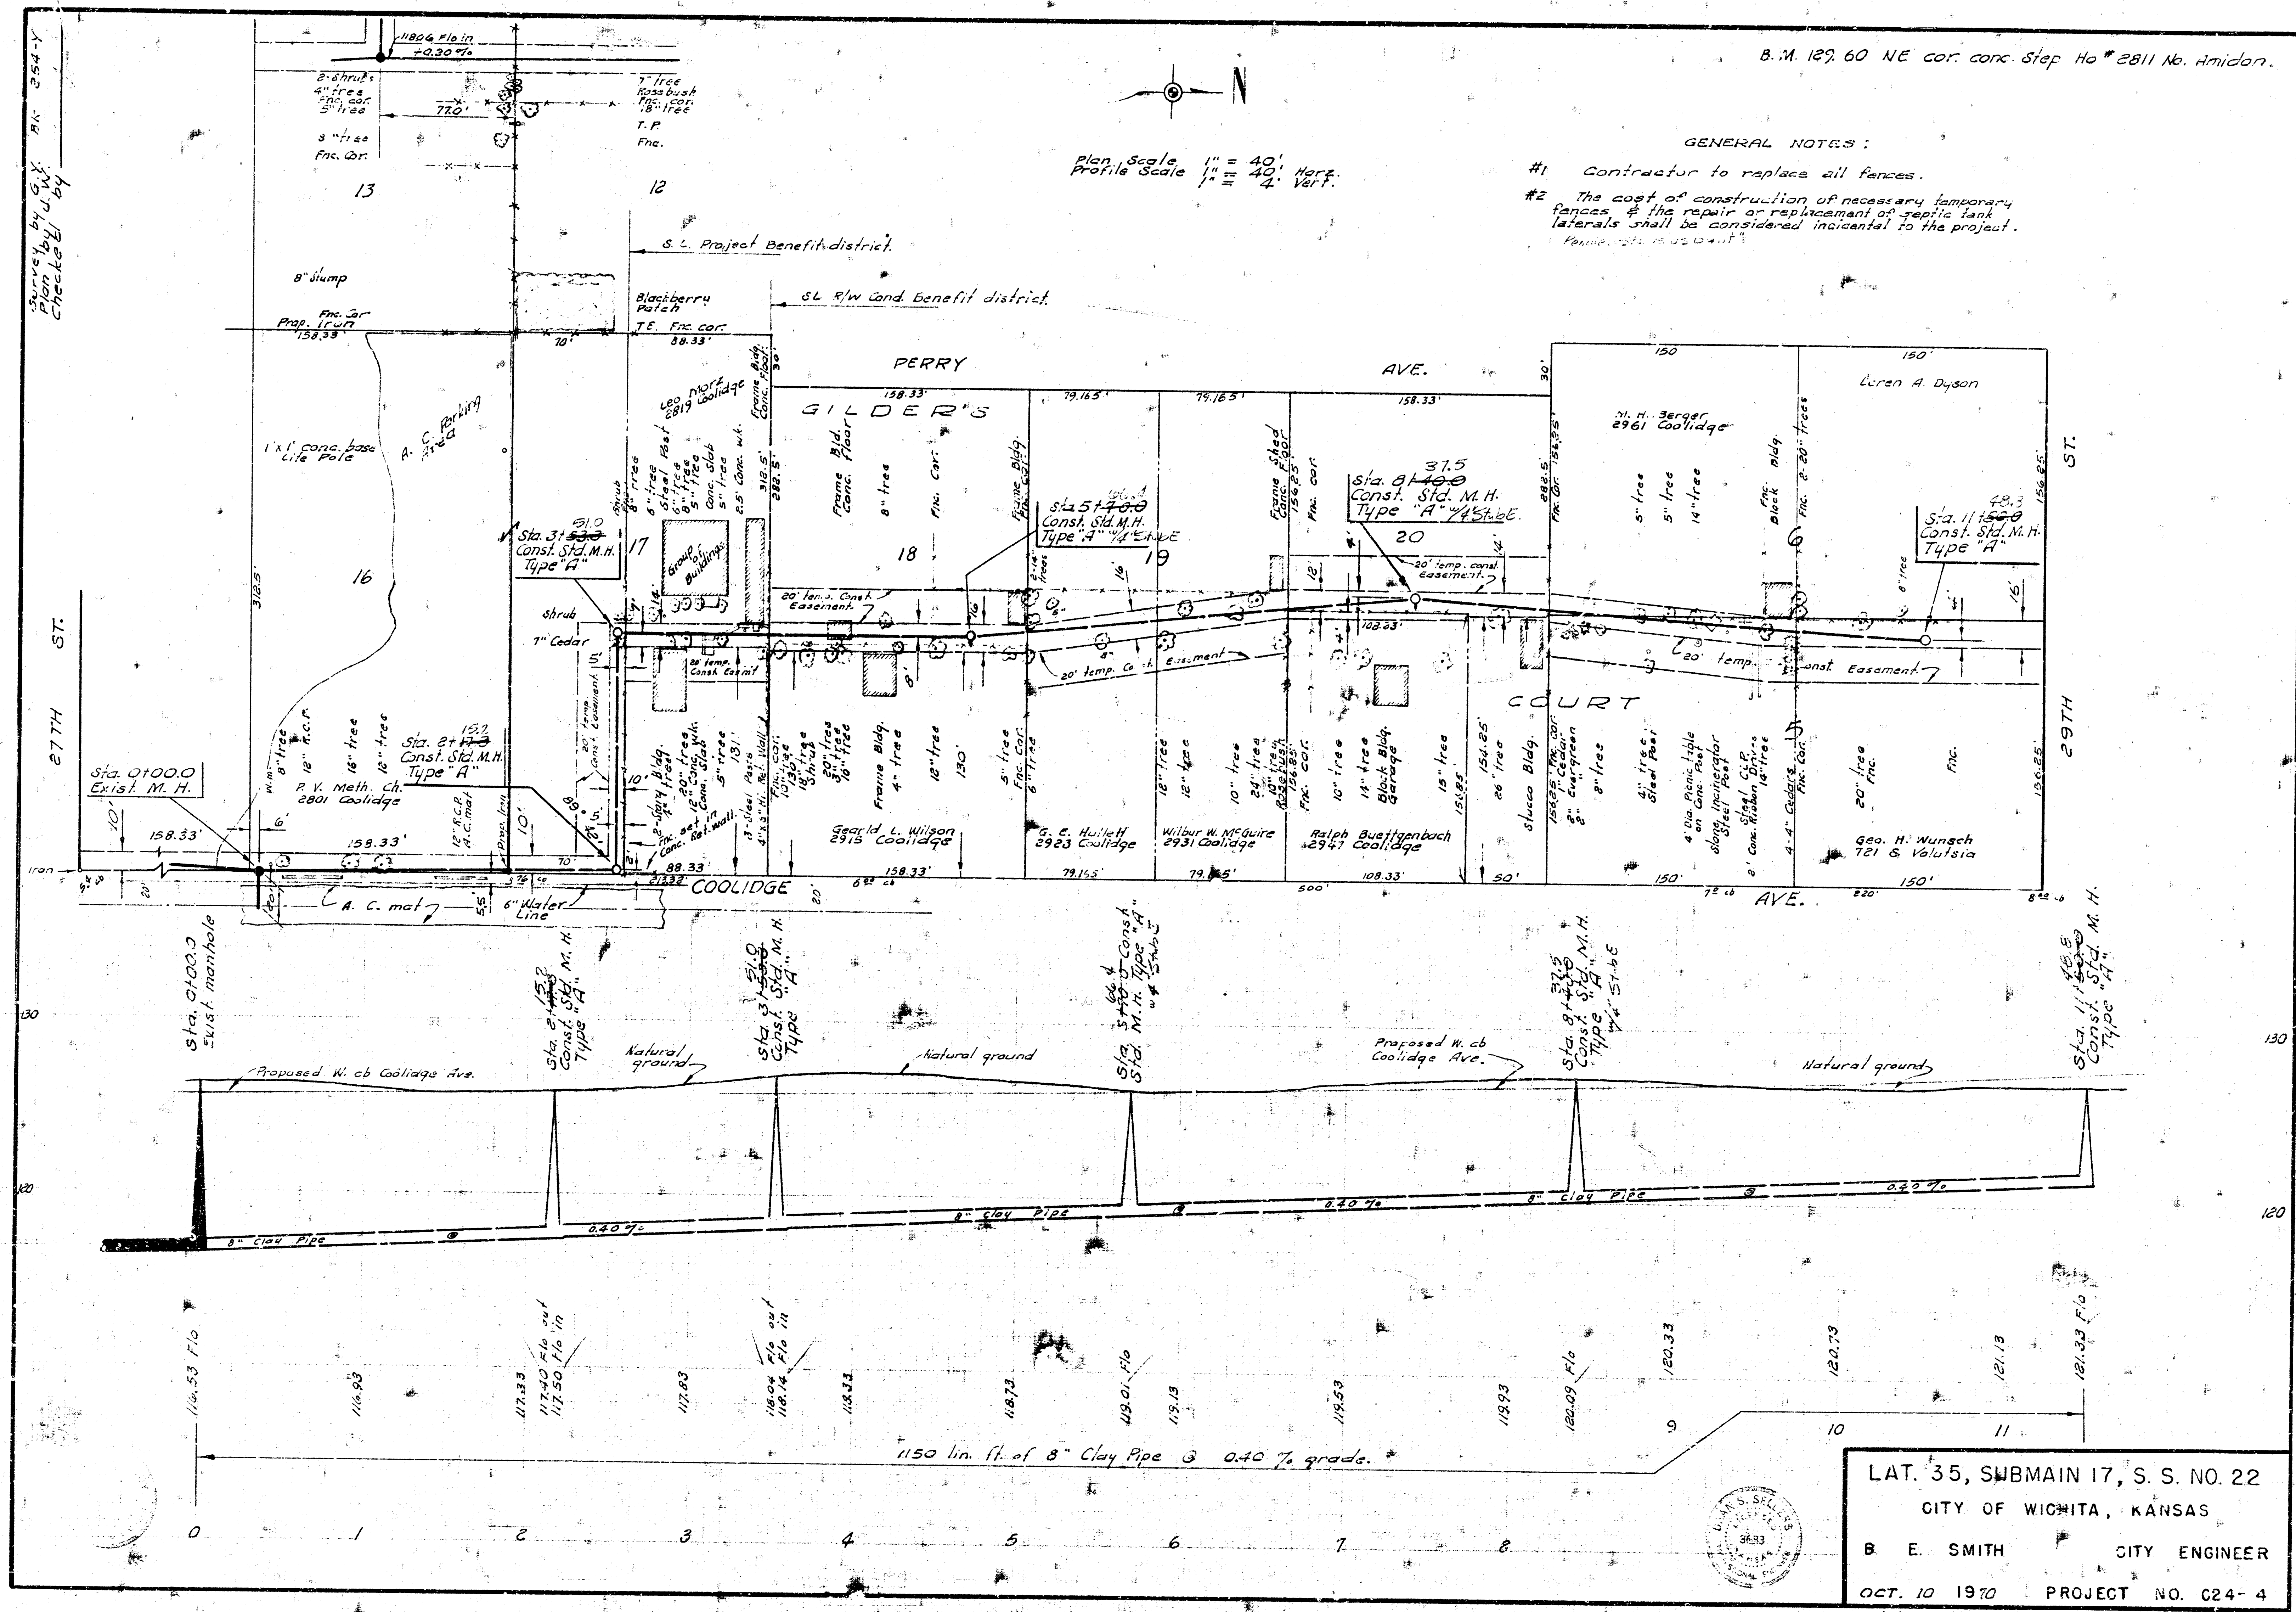

B.M. 129.60 NE cor. conc. step Ho # 2811 No. Amidon.

Plan Scale 1" = 40' Horiz.
Profile Scale 1" = 4' Vert.

GENERAL NOTES:

- #1 Contractor to replace all fences.
- #2 The cost of construction of necessary temporary fences & the repair or replacement of septic tank laterals shall be considered incidental to the project.

LAT. 35, SUBMAIN 17, S. S. NO. 22
CITY OF WICHITA, KANSAS
B. E. SMITH CITY ENGINEER
OCT. 10 1970 PROJECT NO. C24-4