

1/8" = 1' Plan
1/4" = 1' Profile


1/8" = 1' Plan
1/4" = 1' Profile

SCALE - 1" = 40' Plan
1/4" = 1' Profile

Bench Marks: 136.36 City Std. Dec. 42'E and 34' N of
E of Amidon & 33rd St. N.
128.34 TBM East Rim Existing MH, Sta. 0+00
of LAT. 66, MAIN 17, S.S. No. 22.


As Bld'g
J.L.L.
9.82

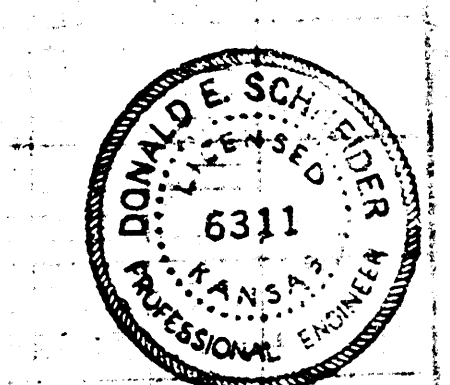

LAT. 66, MAIN 17, S.S. NO. 22
CITY OF WICHITA, KANSAS
J. W. BRUGGEMAN
DIRECTOR OF ENGINEERING / CITY ENGINEER
PROJ. NO. 488-78-245-60685-000-001

FILMED FROM THE BEST
AVAILABLE COPY

