


PLAN  
SURVEYED  
REPLAT  
NOTE: BOOK NO. 10, PAGE 100  
NO. 10

PROFILE  
SURVEYED  
REPLAT  
NOTE: BOOK NO. 10, PAGE 100  
NO. 10

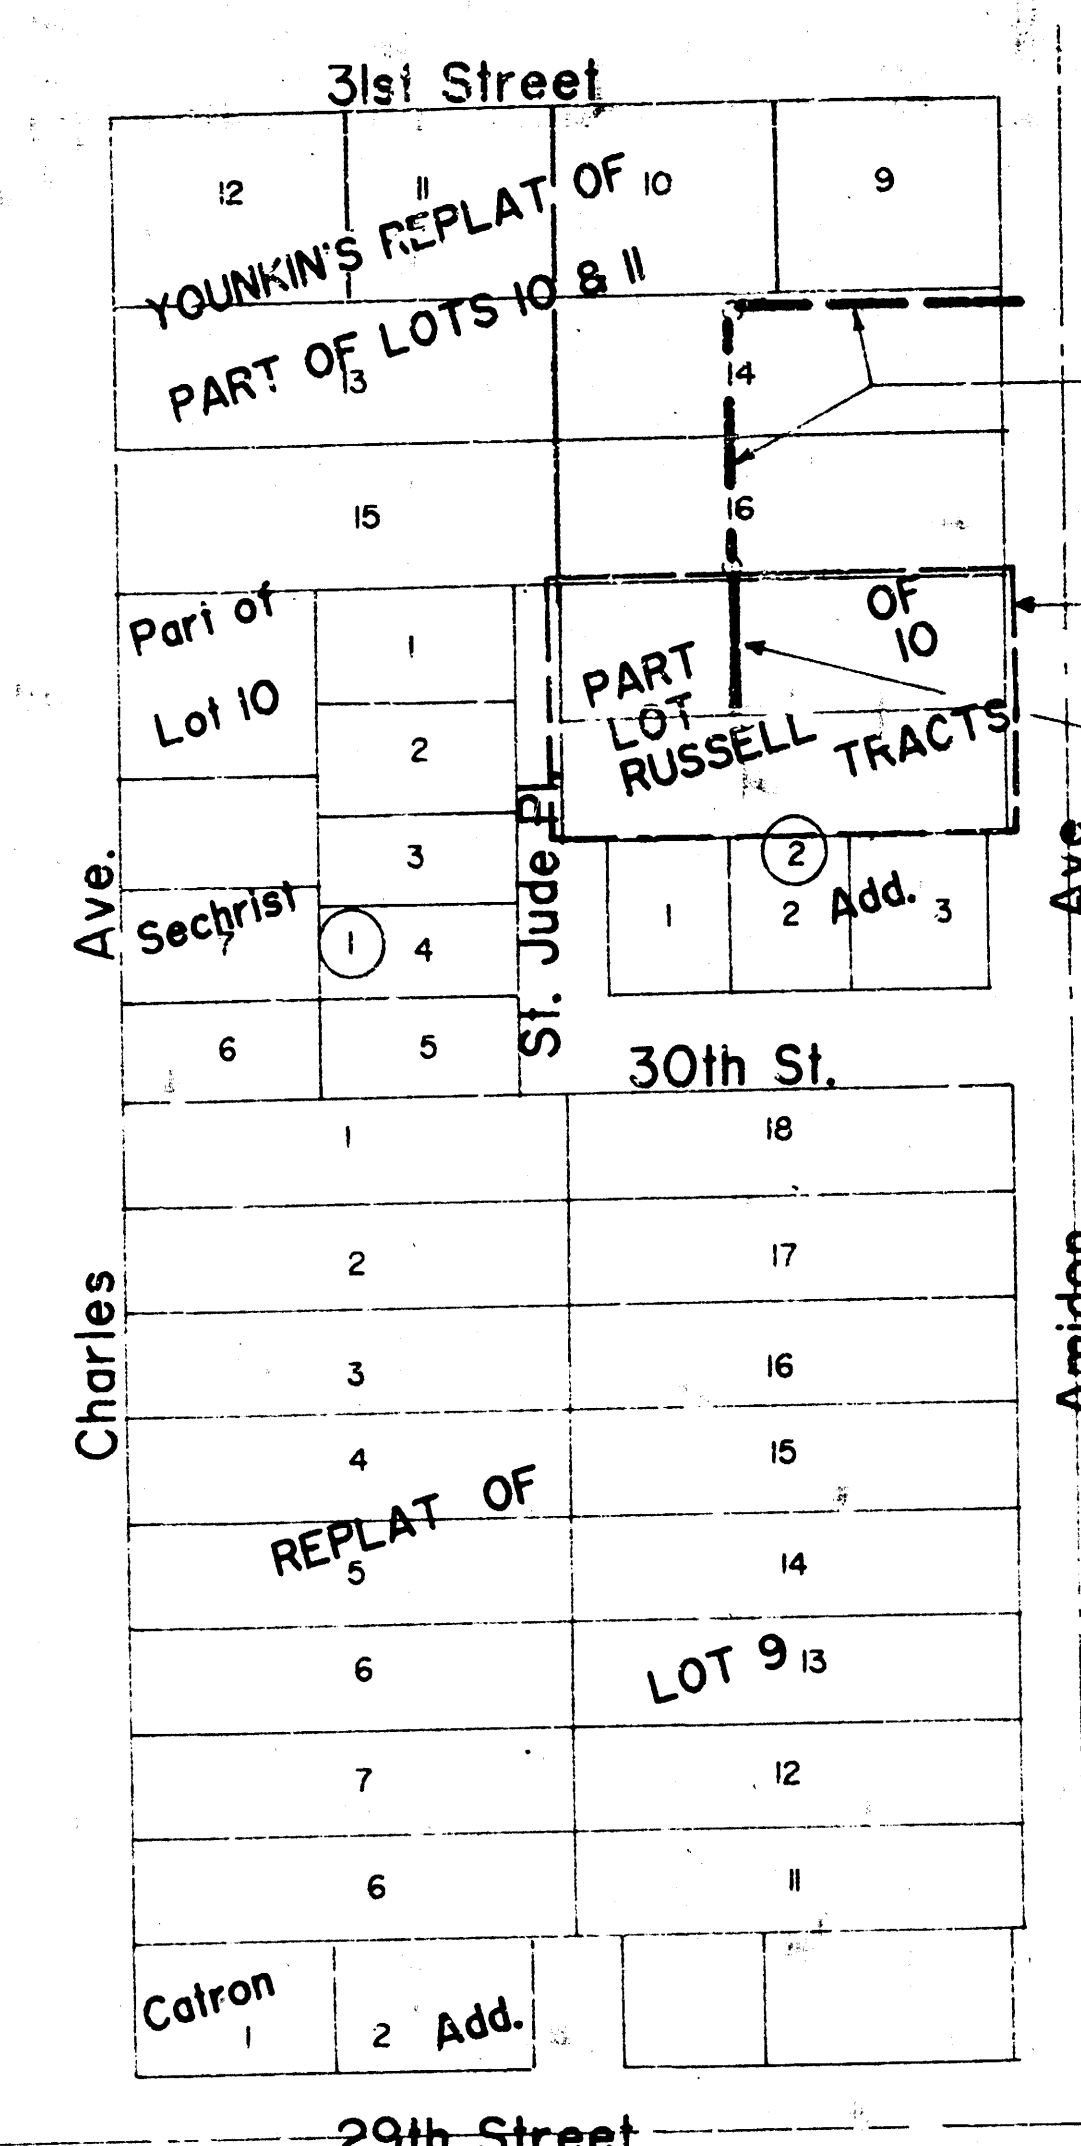


LOCATION MAP  
Scale: 1" = 150'

Existing Sanitary Sewer  
Lat. 29, Sub. 17, SS # 22

Benefit District


Project Location

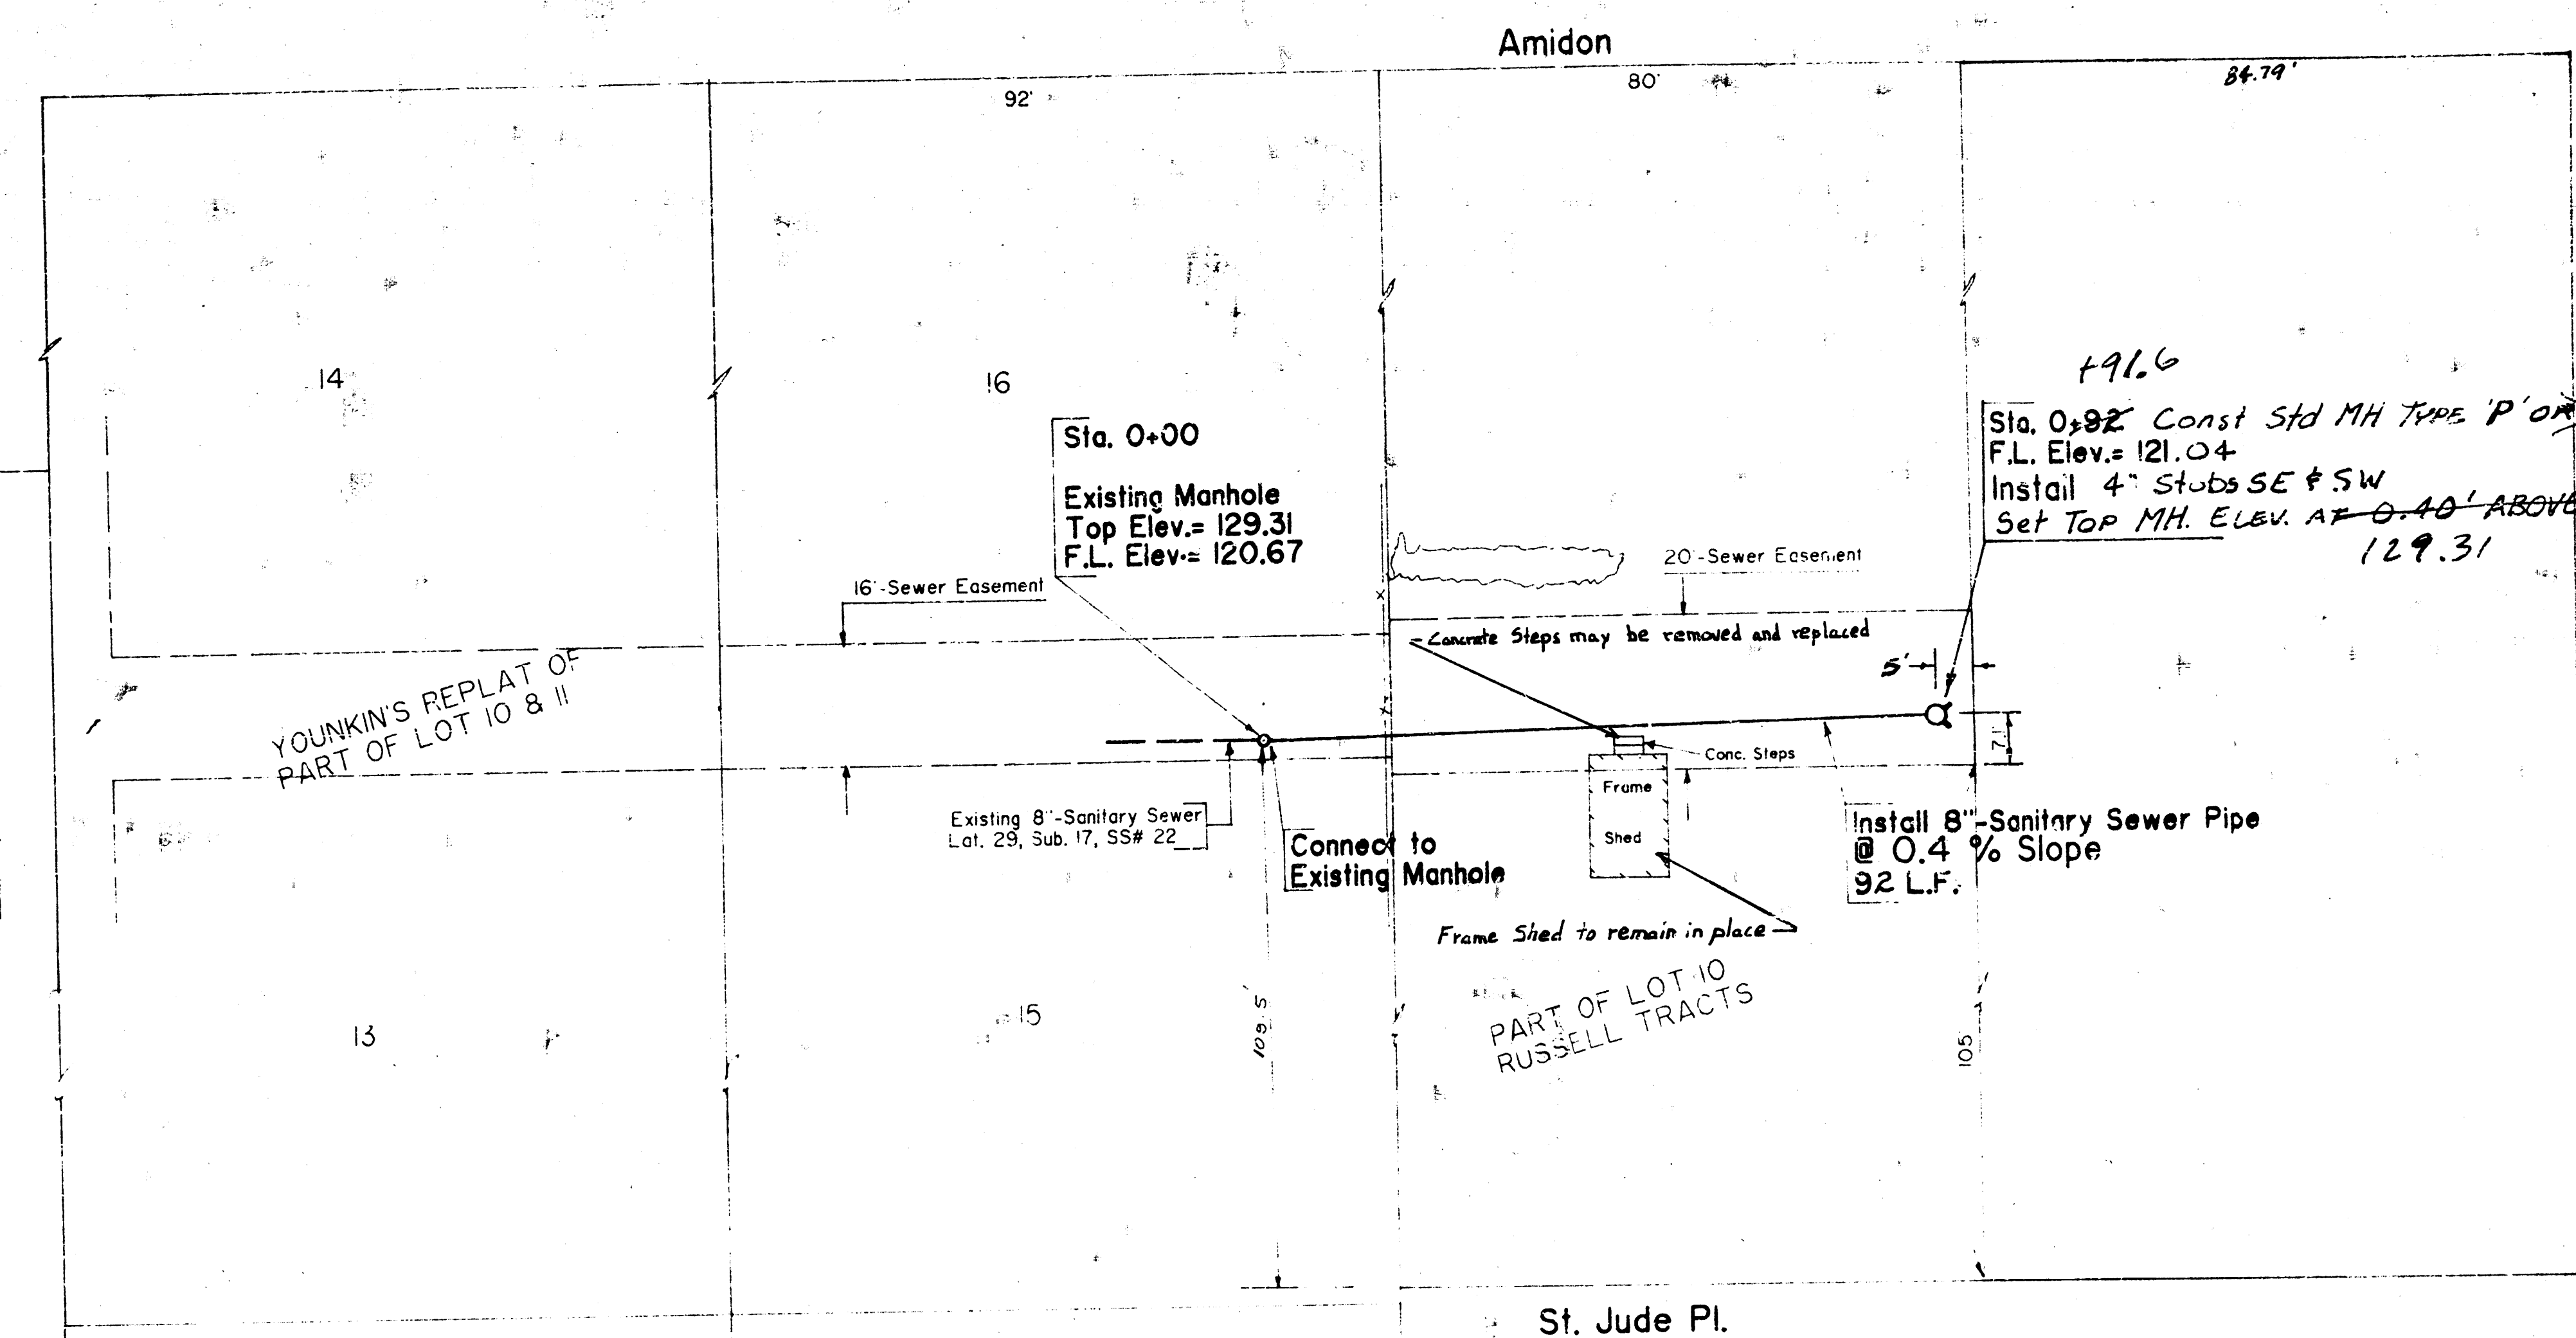

Scale: 1" = 20'  
Profile Scale:  
1" = 20' (H)  
1" = 5' (V)

ELEV. 131.66  
B.M. N.W. CORNER LOWER STEP OF W.  
GROUP STEPS FACING N. 10°21'01" W. 31st ST. N.

B.M. : Top of Manhole @ Sta. 0+00,  
(South Rim), Elev. = 129.31

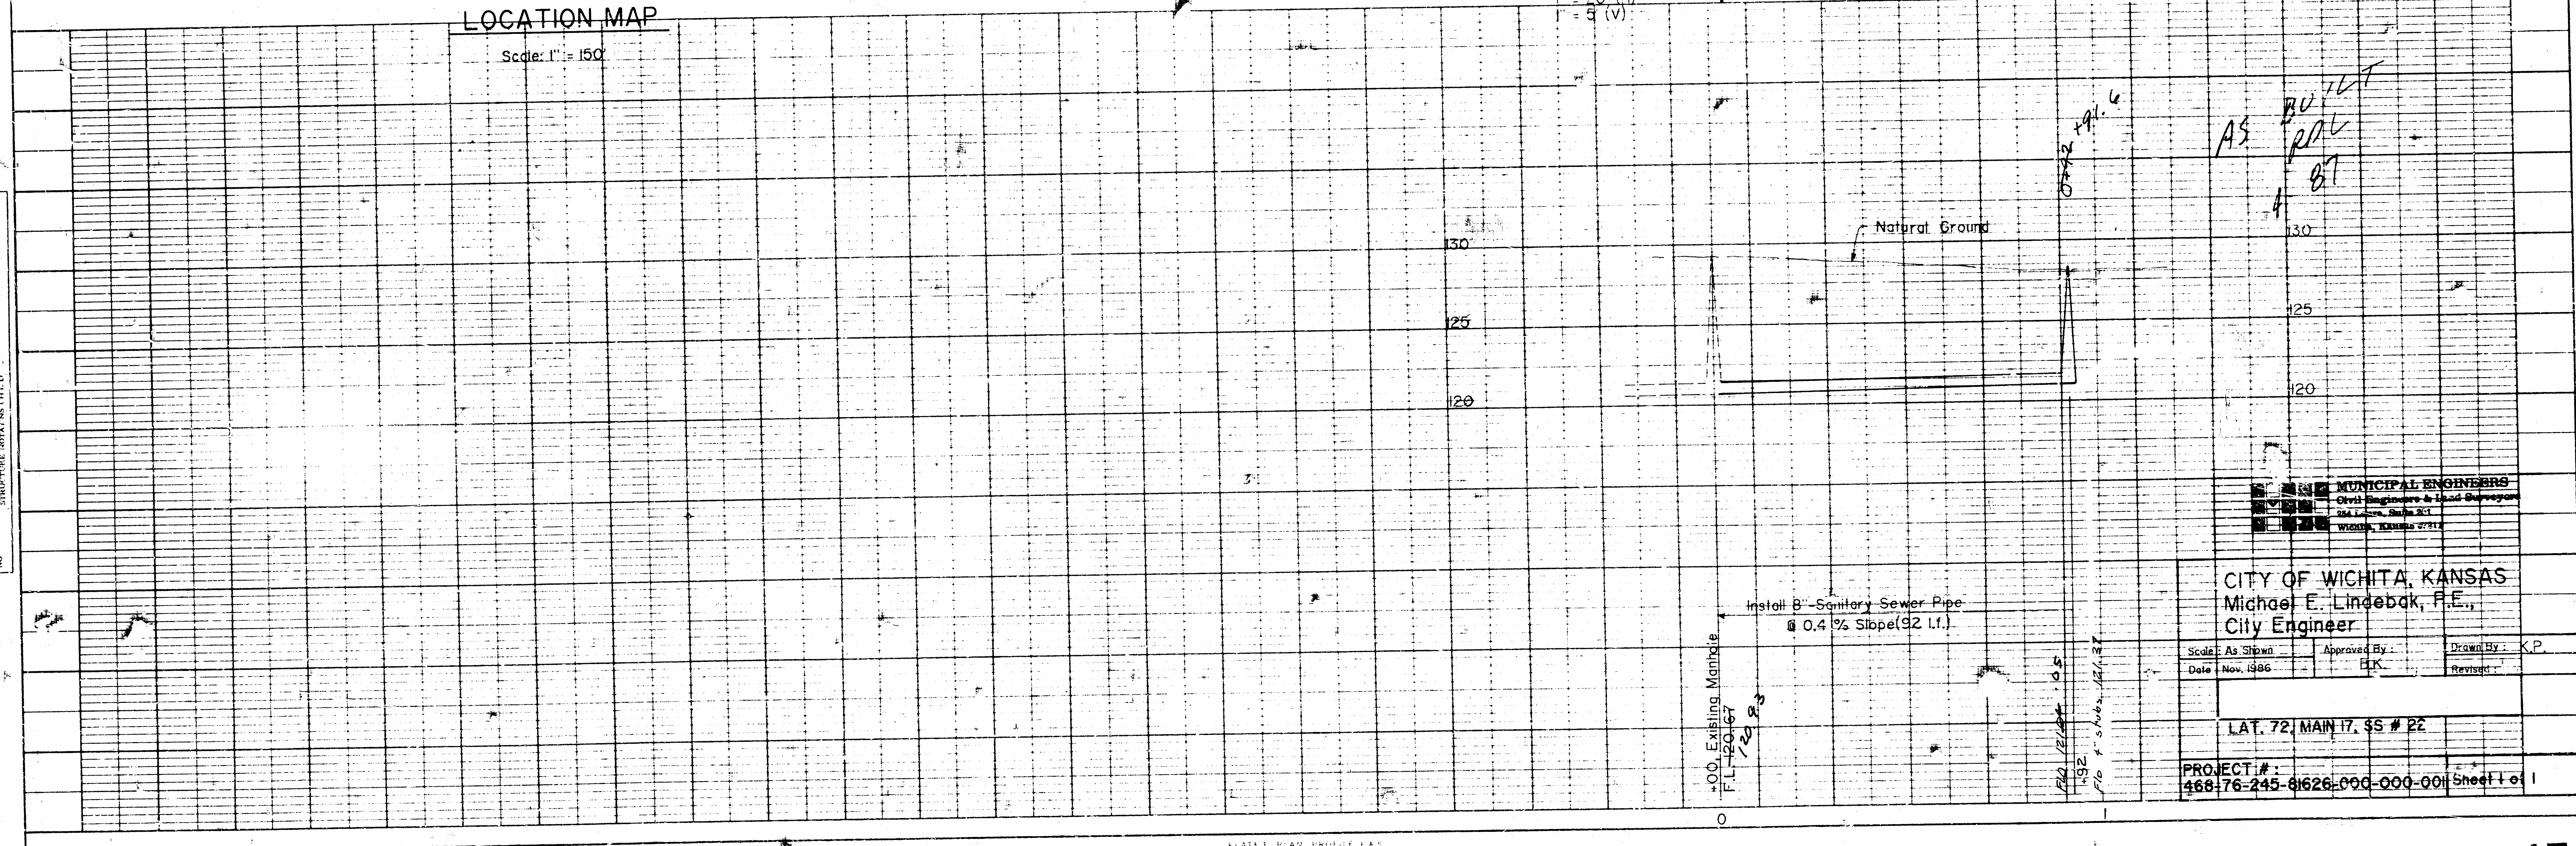

MUNICIPAL ENGINEERS  
Civil Engineering & Land Surveying  
Wichita, Kansas 67211

CITY OF WICHITA, KANSAS  
Michael E. Lingebak, P.E.,  
City Engineer

Scale: As Shown  
Date: Nov. 1986  
Approved By: [Signature]  
Drawn By: K.P.  
Revised:

LAT. 72, MAIN 17, SS # 22

PROJECT #:  
468-76-245-81626-000-000-001 Sheet 1 of 1

ST 3 2 1

FILED FROM THE BEST  
AVAILABLE COPY ....