



B.M. 101.64 R.R. Spike in the East face of the Power Pole on the Southwest corner of Richmond and Crawford.
 B.M. 103.28 Southeast corner of bottom step of Mennonite Church on the Northeast corner of Crawford and Meridian.

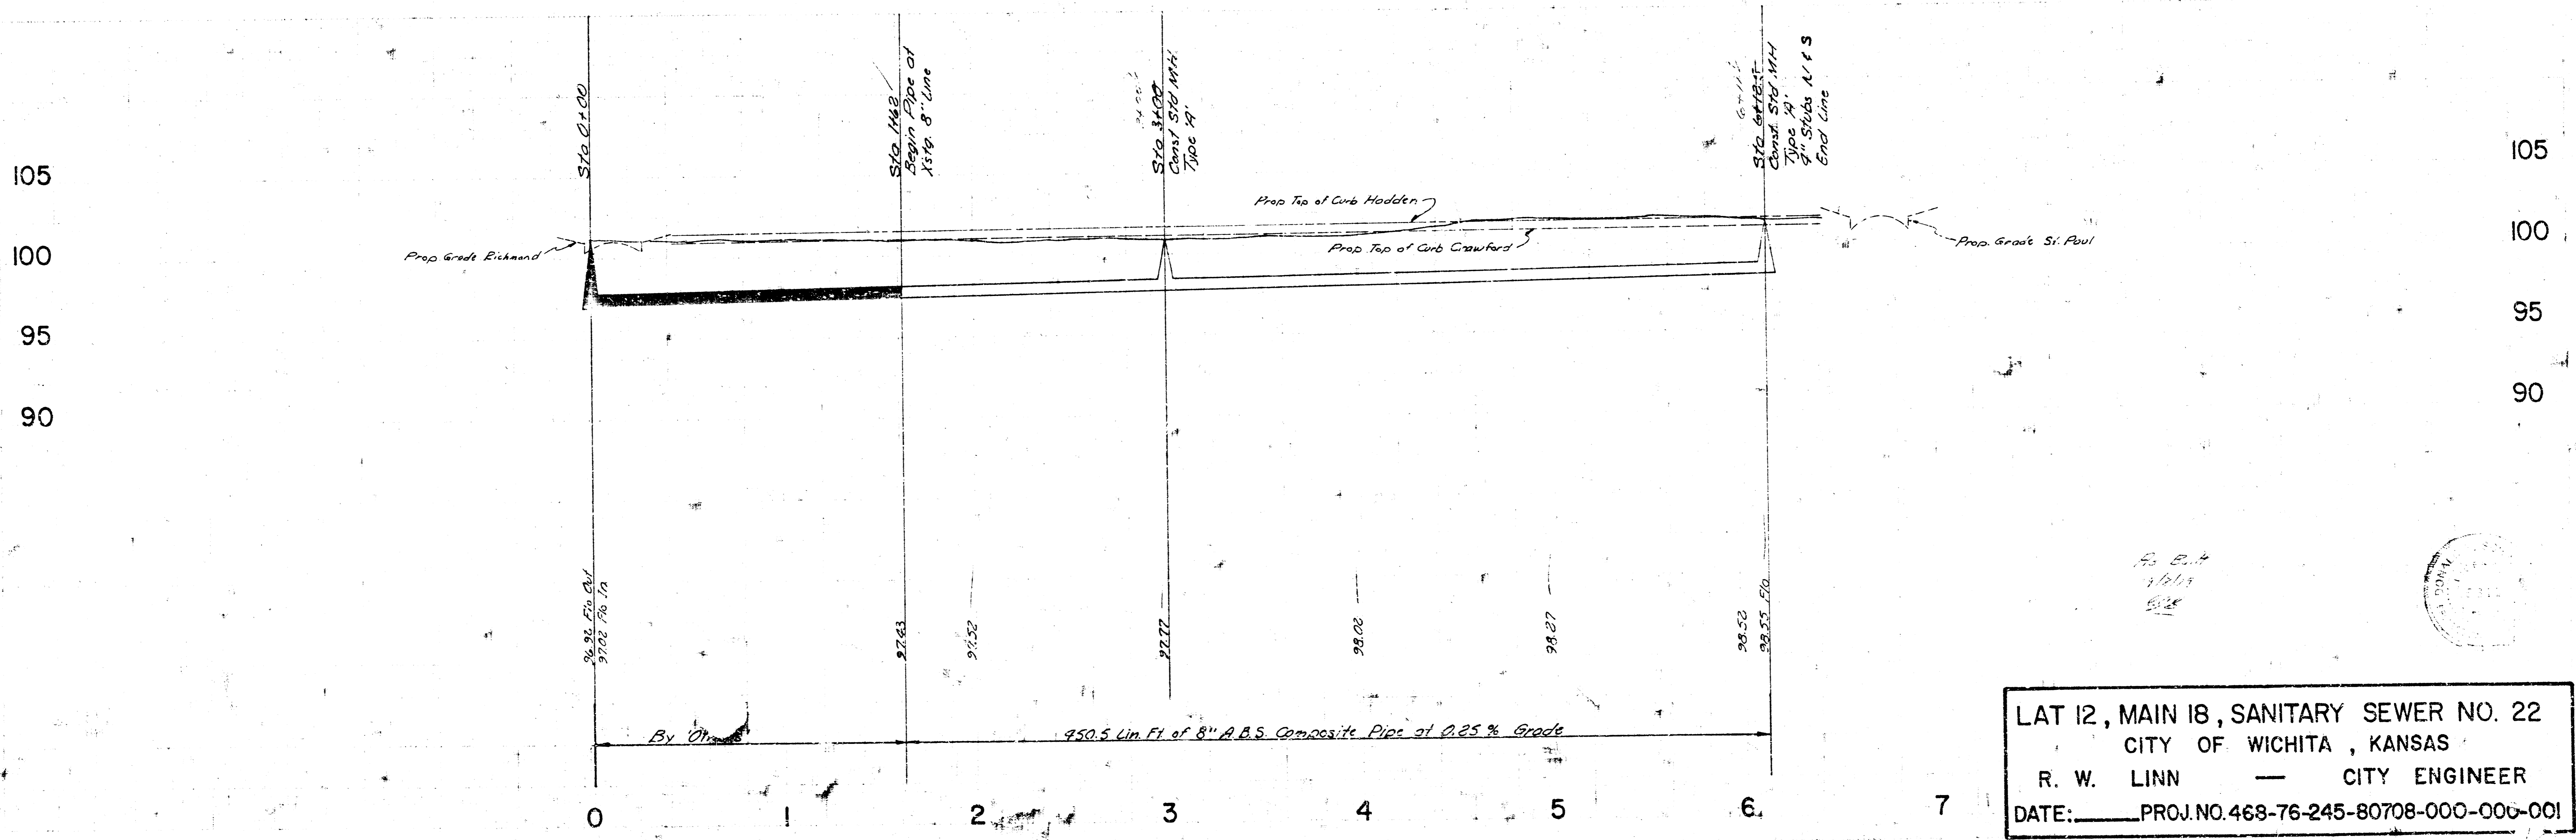

Plan Scale: 1" = 40'
 Profile Scale: 1" = 40' Horz.
 1" = 5' Vert.

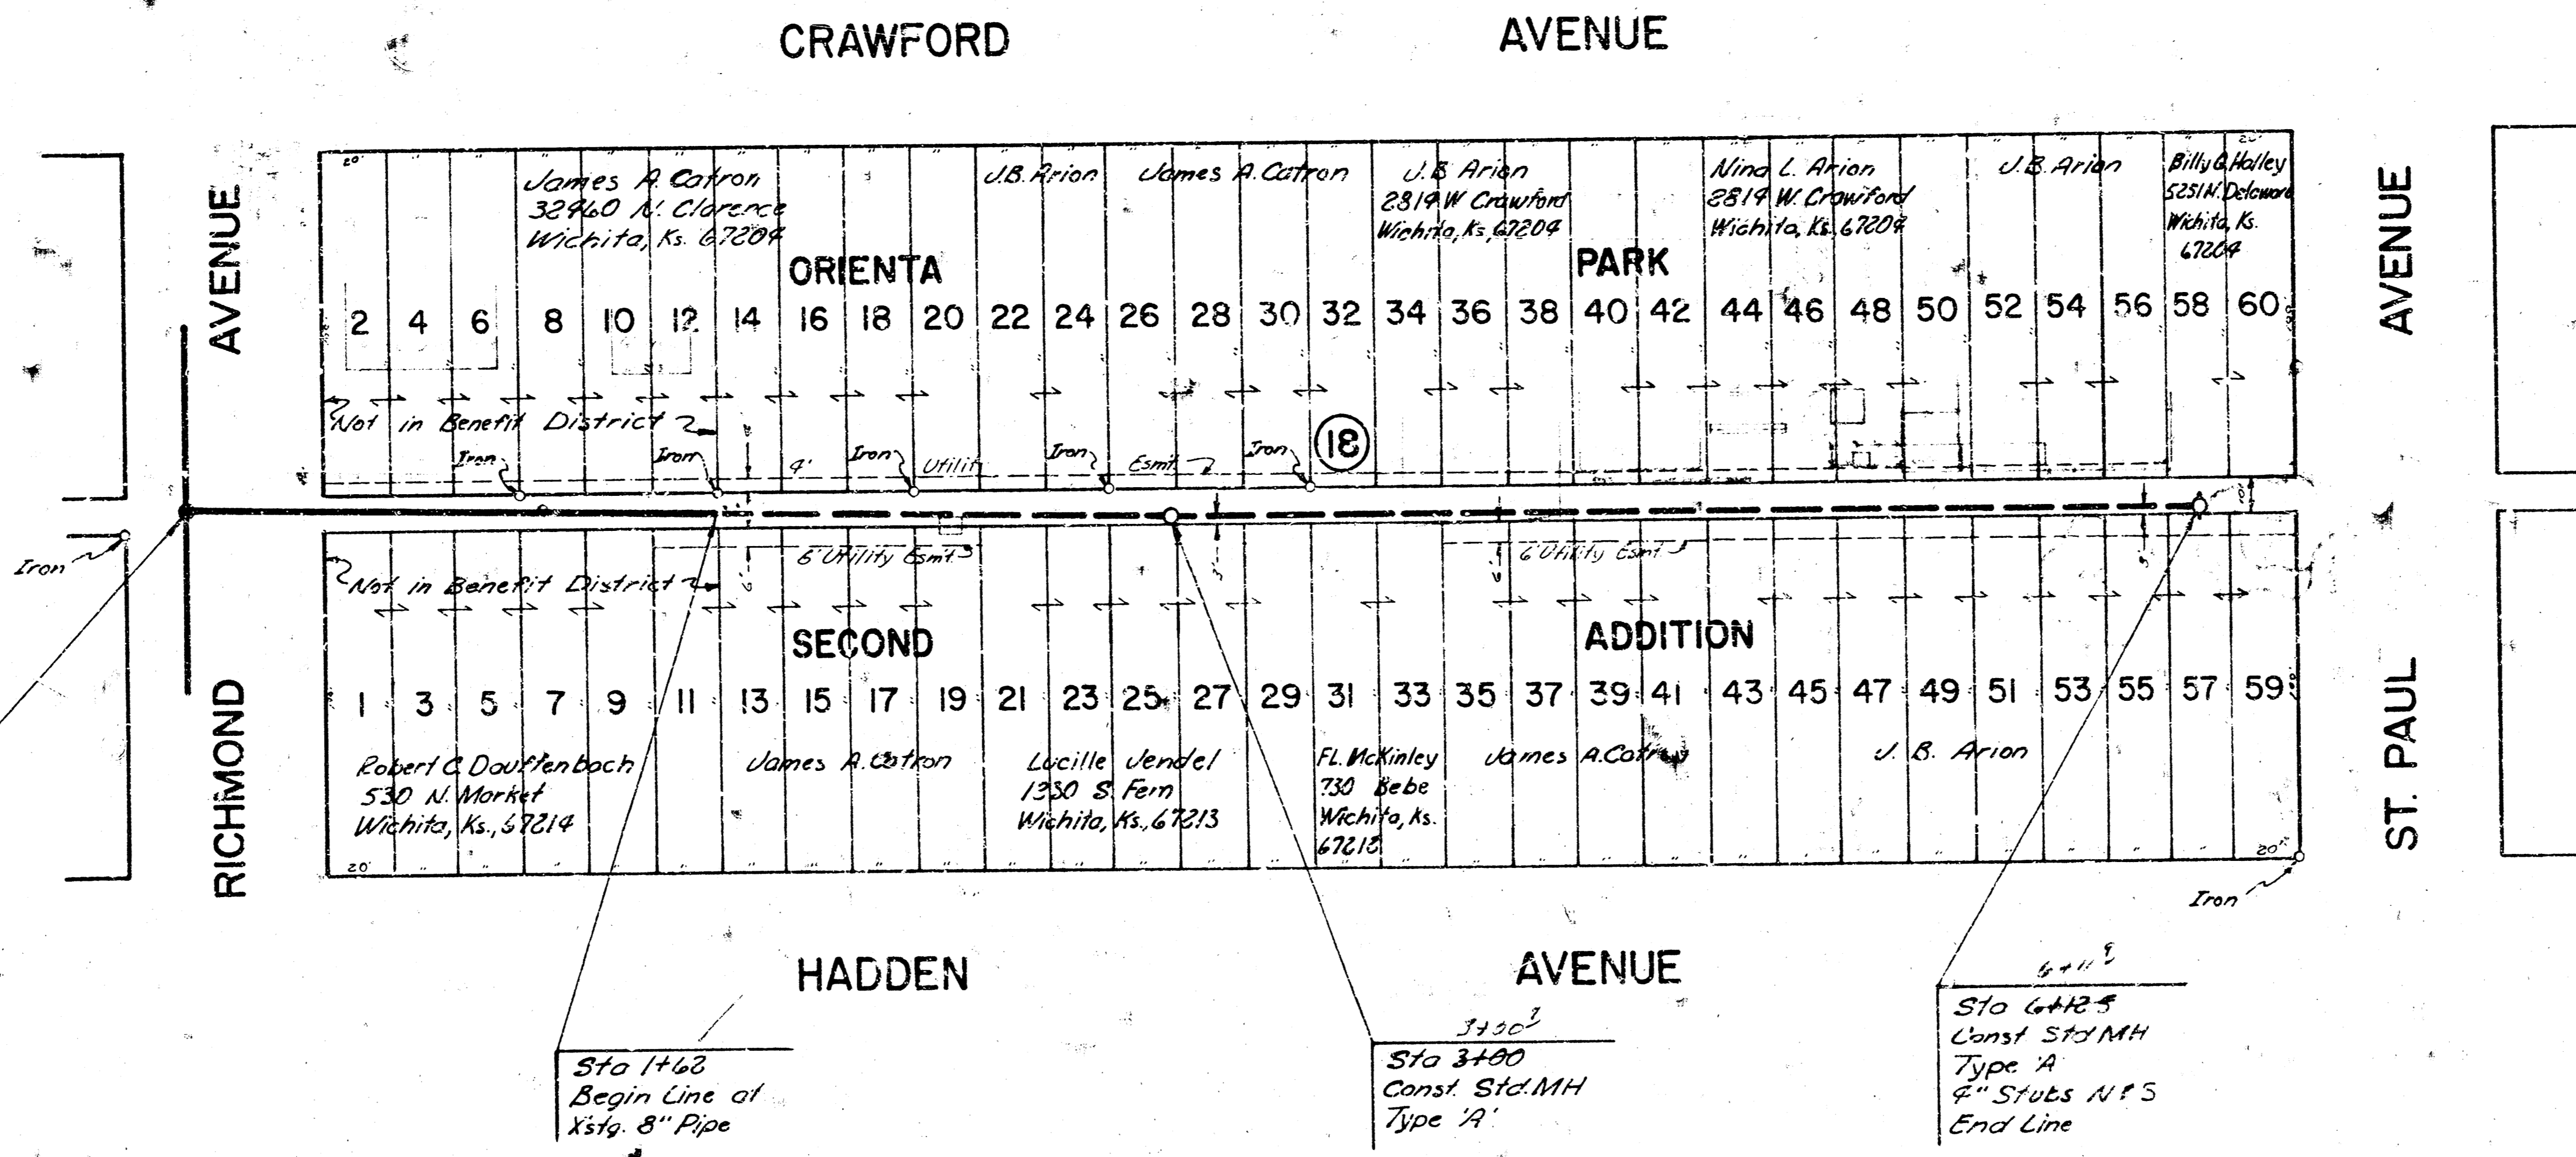

LAT 12, MAIN 18, SANITARY SEWER NO. 22
 CITY OF WICHITA, KANSAS
 R. W. LINN — CITY ENGINEER
 DATE: _____ PROJ. NO. 468-76-245-80708-000-000-001

14 8 4 e