

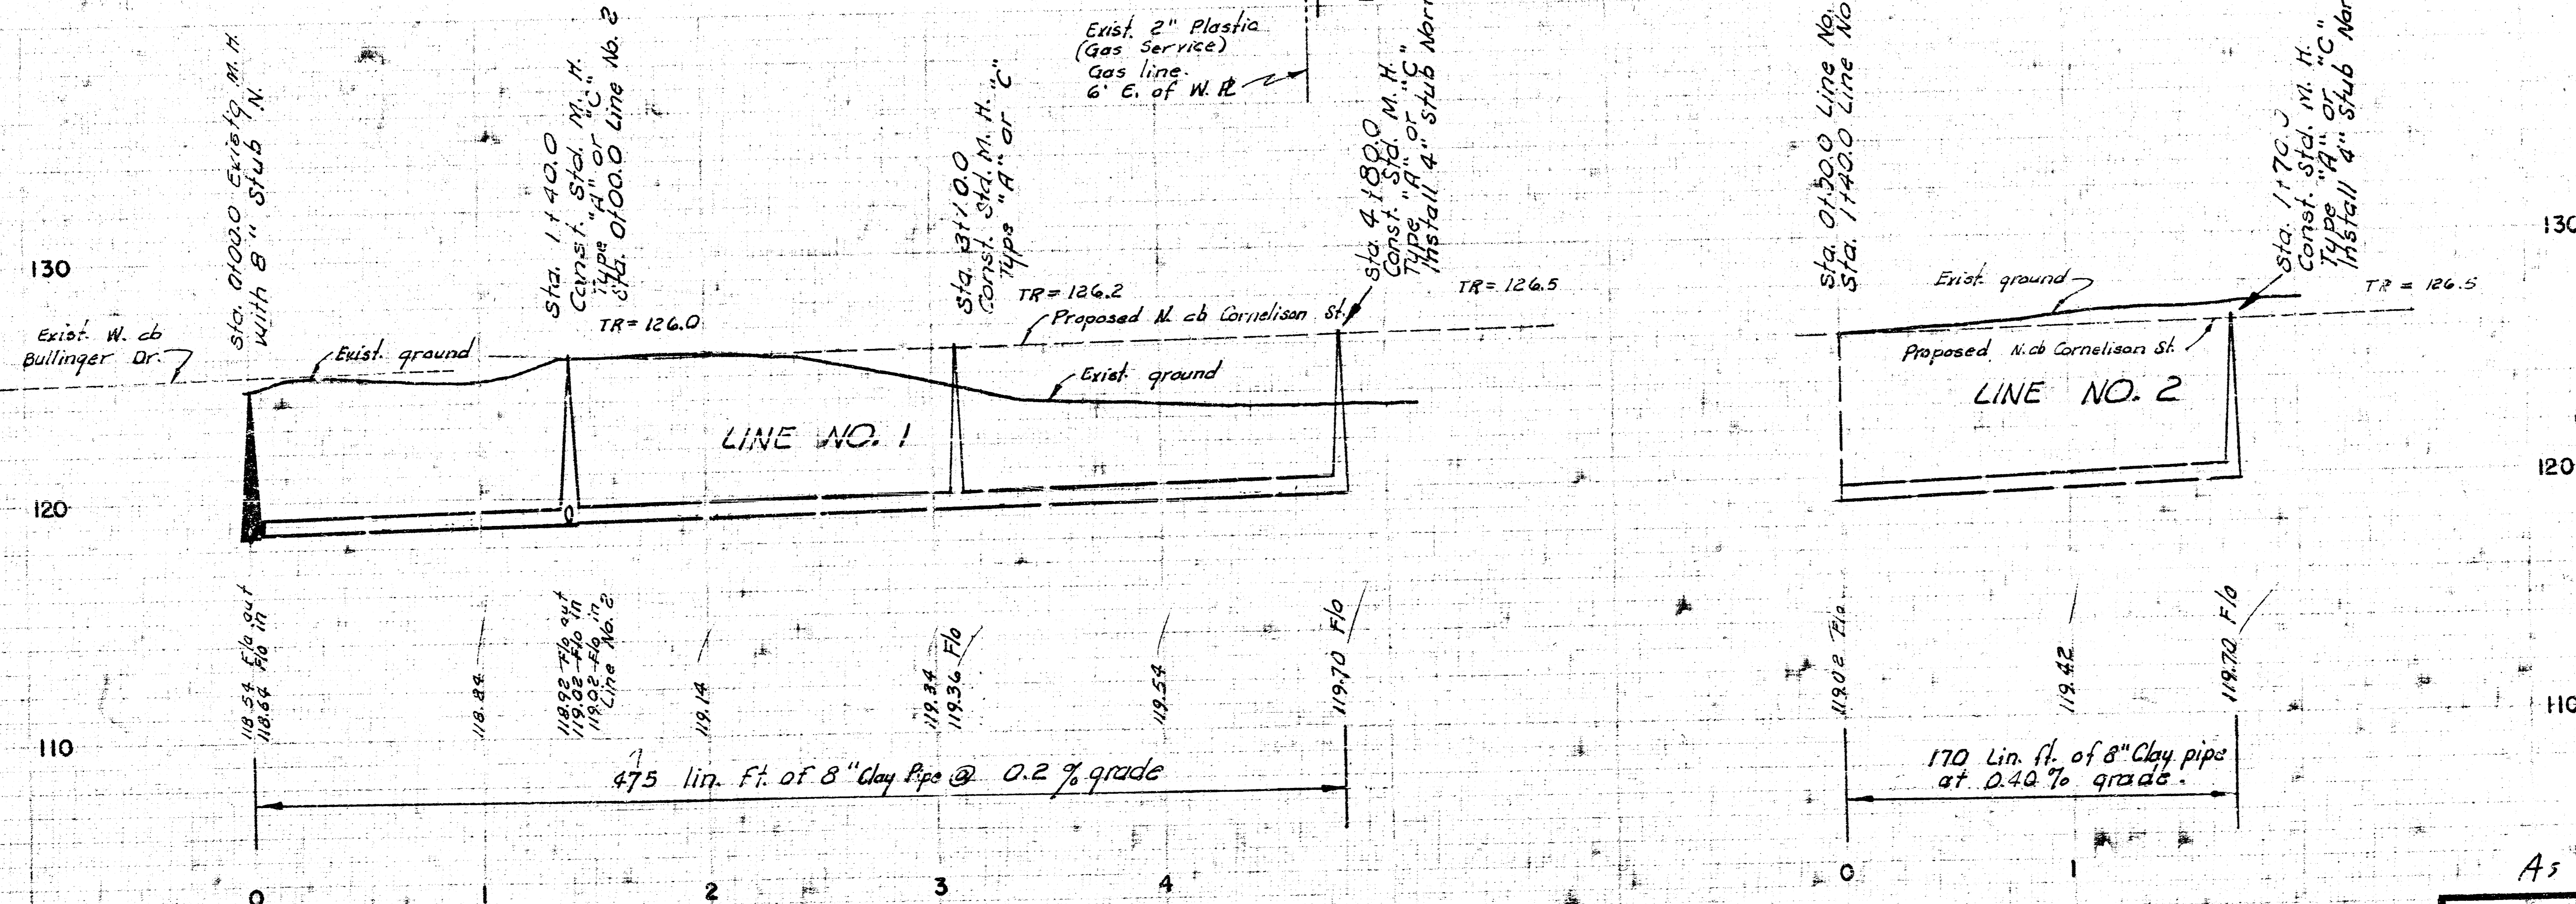


- B. M. 126.73 R.R. Spike on S. side P. Pole on N. side 21st. St. at E. Line River Park Addn.
- B. M. 128.97 R.R. Spike on S. side P. Pole on N.W. cor. 21st St. and Hyacinth Lane.
- B. M. 126.15 "a" cut top E. curb Hyacinth at S. L. Cornelison
- B. M. 124.20 "a" cut top S. curb River Park Dr. 2' E. of W. L. Bullinger Dr.

Survey by J.F.G. Book No. J.F.G. 109
 Plan by J.W. Checked by
 Date

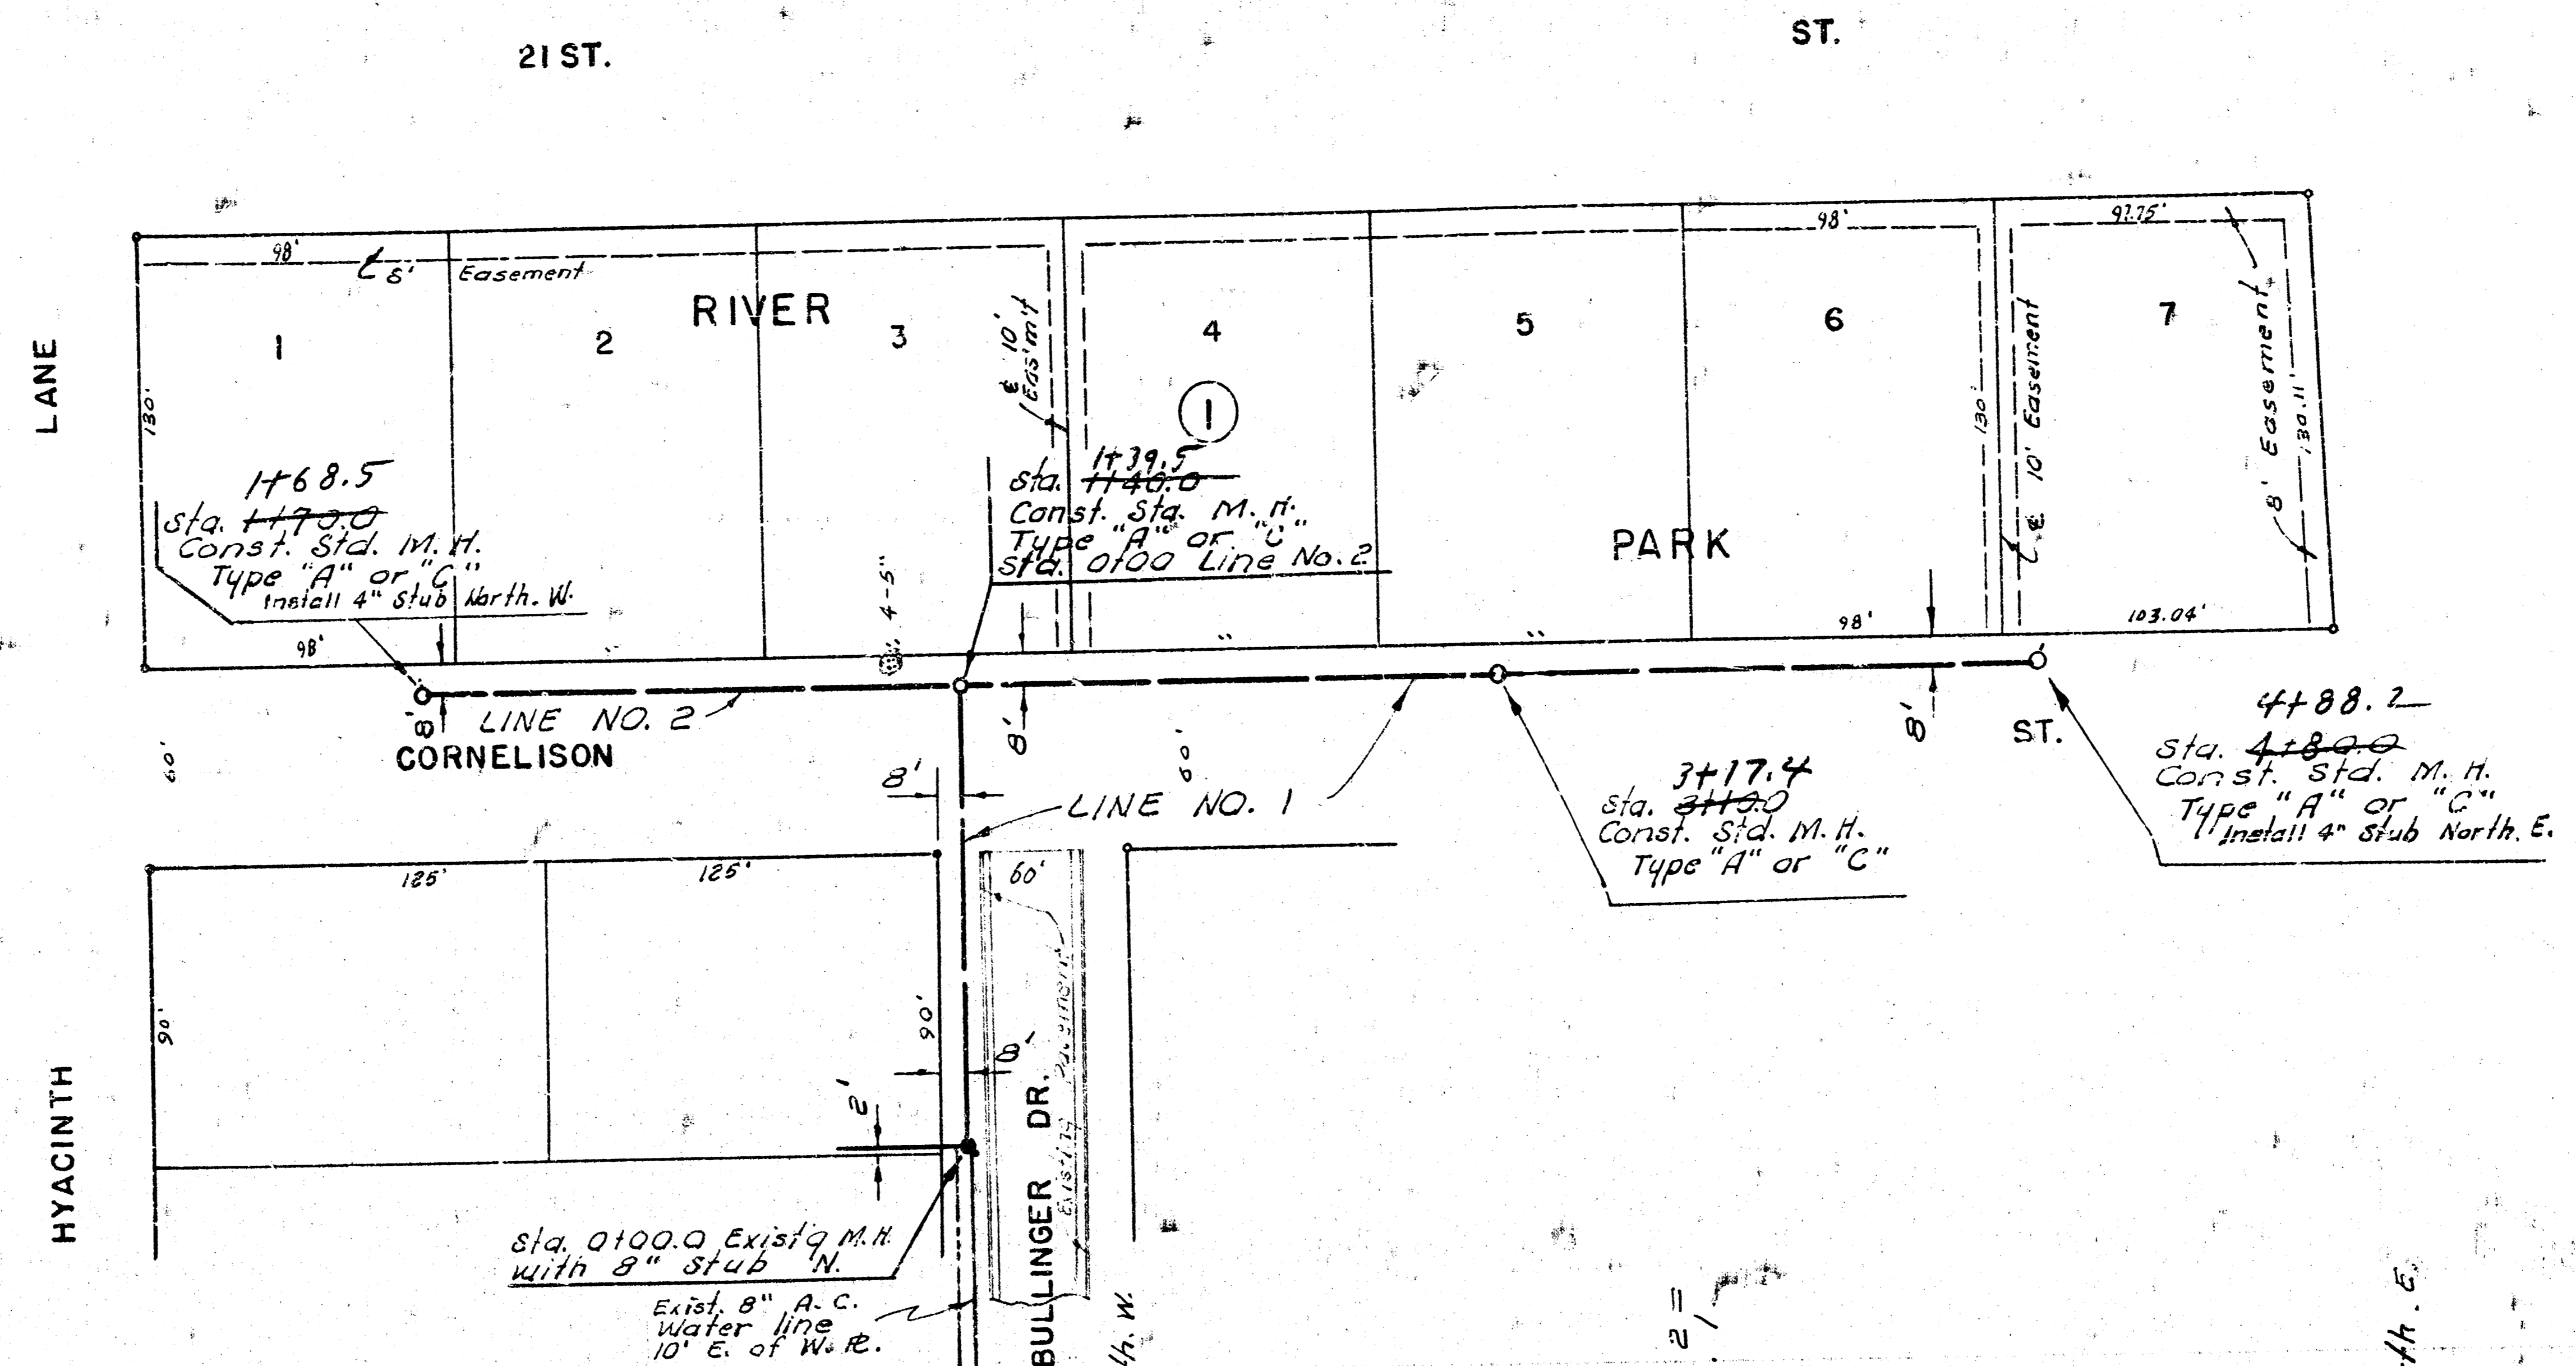

Plan Scale 1" = 40'
 Profile Scale 1" = 40' vert.

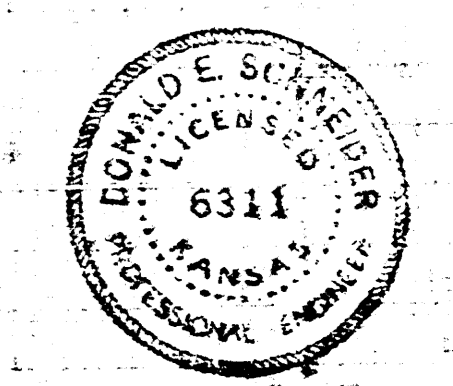

As Per 17 9-9-75
 LAT. 6, MAIN 19, S. S. NO. 22
 CITY OF WICHITA, KANSAS
 R. W. LINN — CITY ENGINEER
 1975 PROJECT NO. DBKL564016