Survey G. Vaughan 230-F
Plan D. Cramer
Exc.
Check

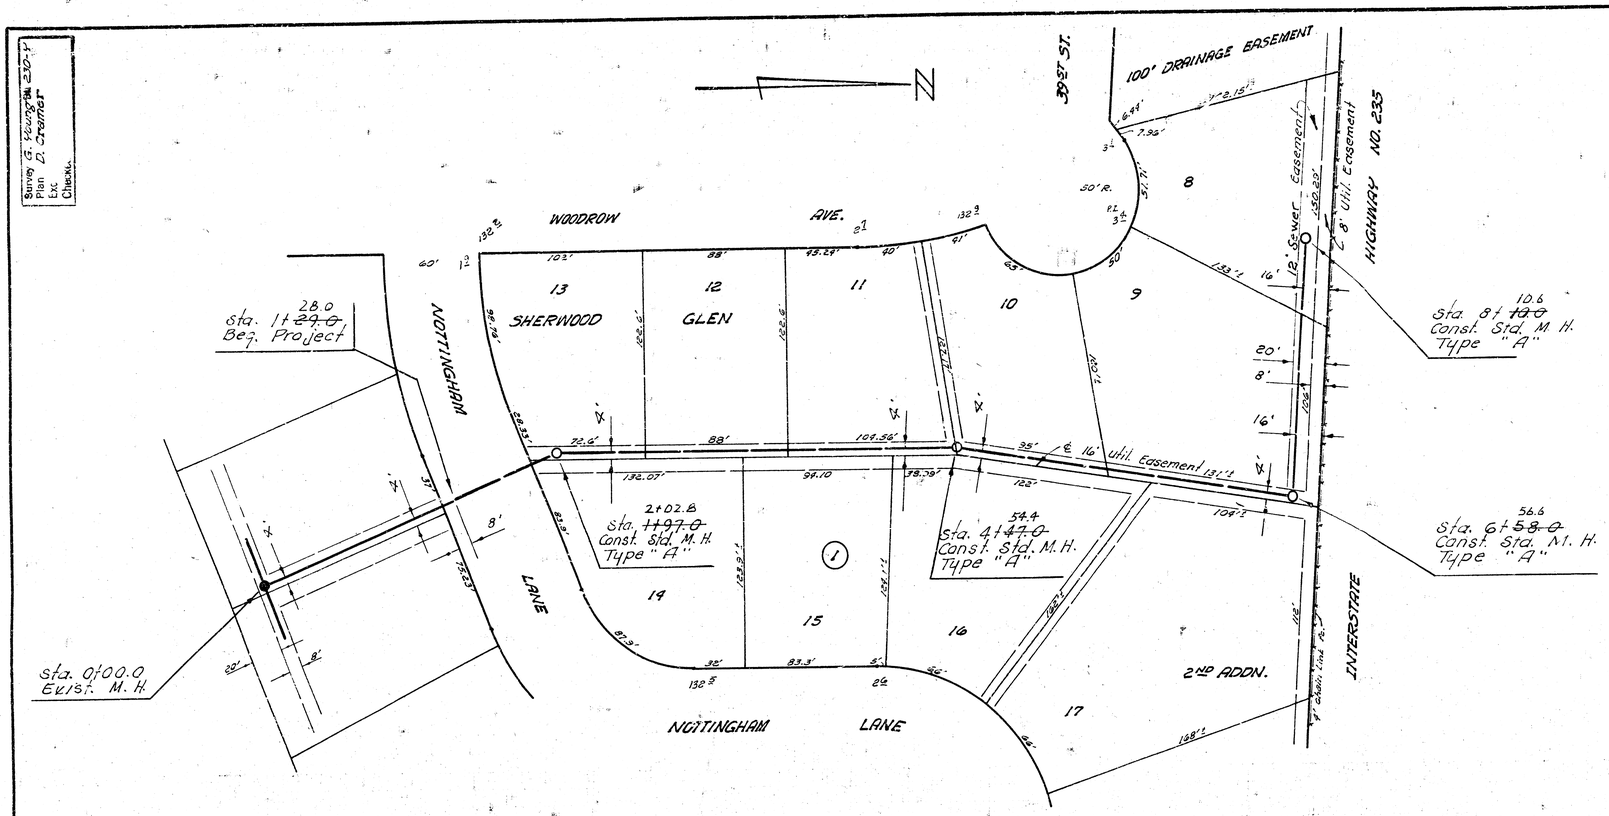

B. M. 135.03. 60# Spike E. S. R. R. W. S. Amidon @ S.L. 39th St. No. east.

B. M. 135.33 SE cor. Step No. # 3841 Friar Lane.

B. M. 131.95 N. Rim M. H. in Woodrow Ave. North Side of 37th St. North.

NOTE:
Contractor to construct fill over sewer as required to maintain a minimum of 30 inches of cover. All work necessary to provide a minimum of 30 inches of cover shall be considered as subsidiary.

Plan Scale 1" = 40'
Profile Scale 1" = 40' Hor.
1" = 4' Vert.

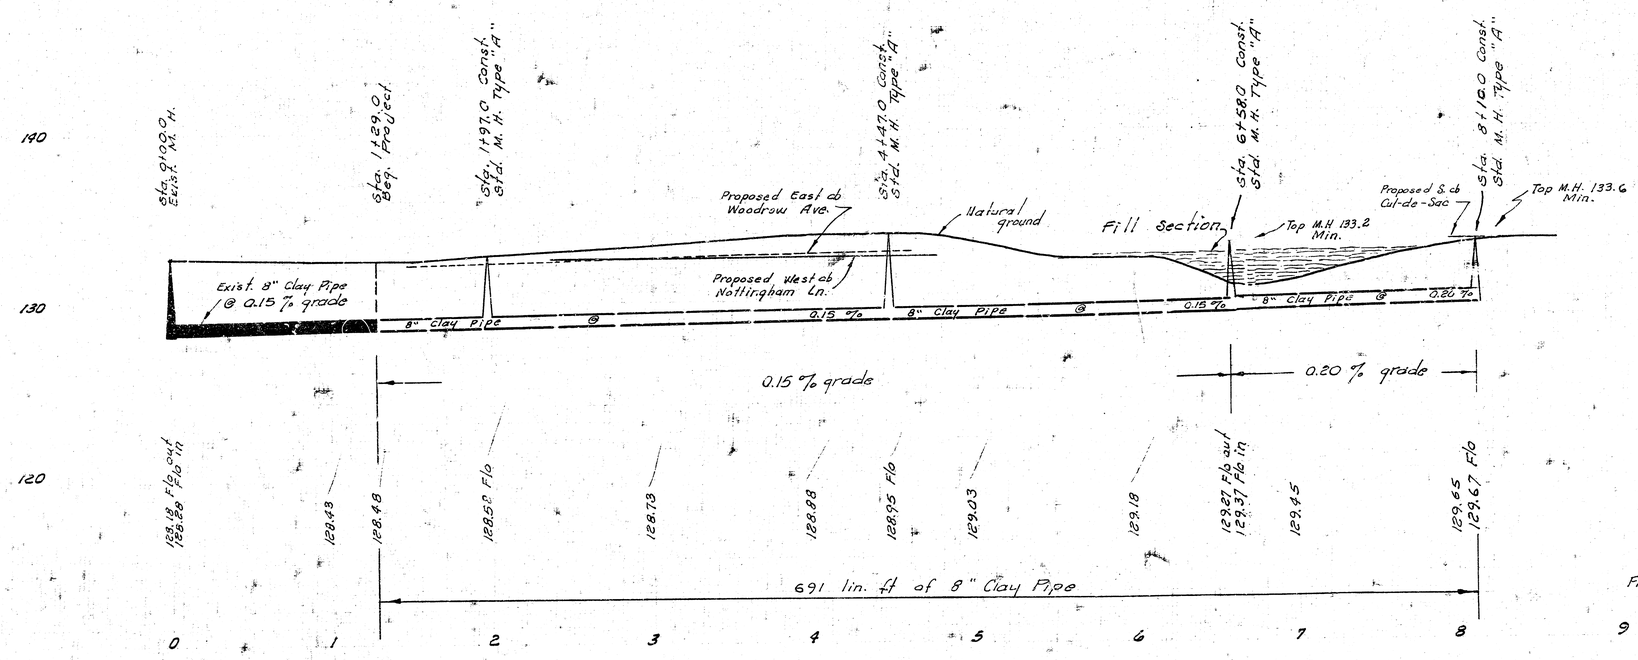

"As Built"
FINAL MEASUREMENTS
SS JK 9

LATERAL 23, MAIN 21, S.S. NO. 22
CITY OF WICHITA, KANSAS
B.E. SMITH, CITY ENGINEER
PROJ. NO. DBKL571015
DATE: NOV. 1972

FILMED FROM THE BEST AVAILABLE COPY ....