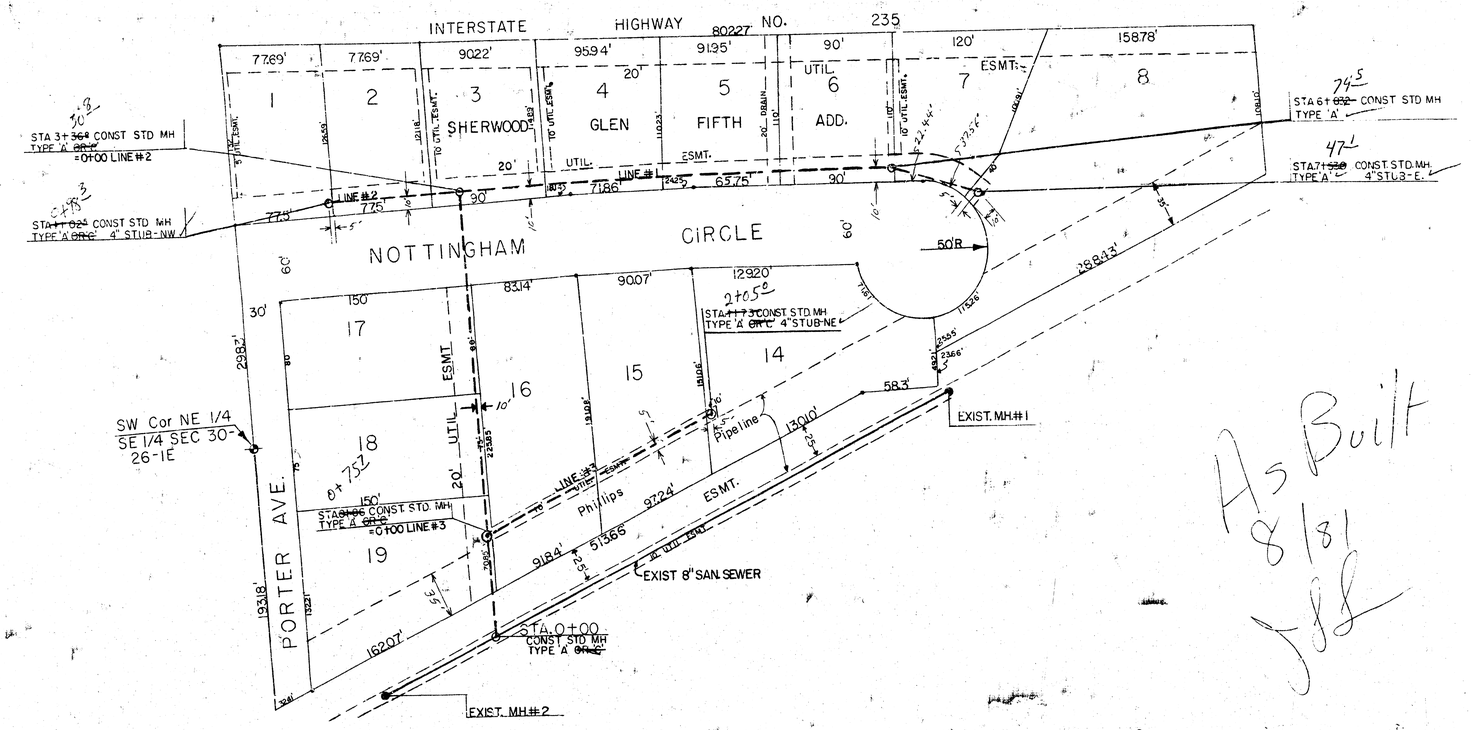

PLAN SCALE 1" = 50
PROFILE SCALE 1" = 50 HORZ
1" = 5 VERT

As Built 8/81

BM 13.570 "M" in Muller E. Side water hydrant at SW cor Nottingham & Porter.

BM 13.468 "+" Top of W curb of Garland Cir approx 2' S of SL Sherwood Glen 5th Add'n.

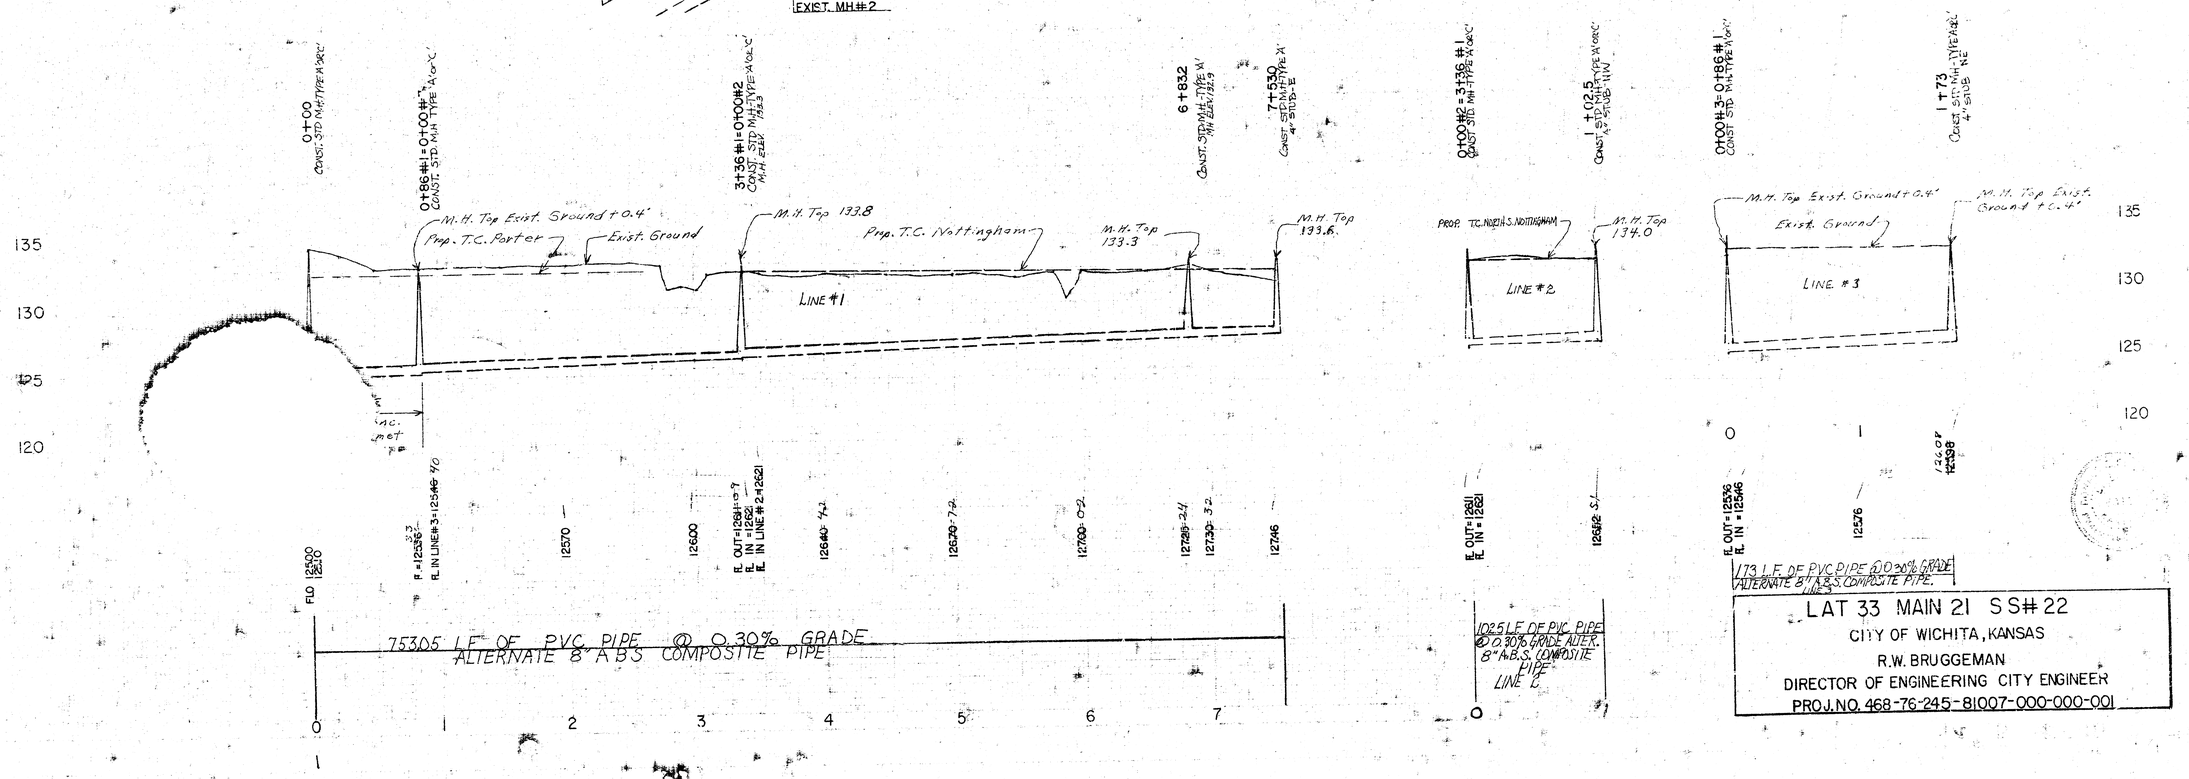

LAT 33 MAIN 21 SS#22
CITY OF WICHITA, KANSAS
R.W. BRUGGEMAN
DIRECTOR OF ENGINEERING CITY ENGINEER
PROJ. NO. 468-76-245-81007-000-000-001

FILMED FROM THE BEST